

32001 32nd Avenue South, Suite 100
Federal Way, Washington 98001
253-835-6400

Stormwater Site Plan
City of Issaquah
SPAR Booster Pump Station

22 February 2021

Applicant and Property Owner:

City of Issaquah
1775 12th Ave NW
Issaquah, WA 98027

KJ Project No. 1397005*00

Table of Contents

<i>List of Figures.....</i>	<i>i</i>
<i>List of Appendices.....</i>	<i>i</i>
<i>Acronyms and Abbreviations</i>	<i>iii</i>
Section 1: Project Overview	1
Section 2: Existing Conditions Summary	4
Section 3: Offsite Analysis	7
Section 4: Permanent Stormwater Control Plan	9
Section 5: Construction SWPPP and Source Control	10
Section 6: Special Reports and Studies	11
Section 7: Other Permits	12
Section 8: Operations and Maintenance	13
<i>References.....</i>	<i>14</i>

List of Figures

- Figure 1: Project Location
Figure 2: Project Vicinity Map and Components

List of Appendices

- A Flow Chart for Determining Requirements for Redevelopment
- B Operations and Maintenance Manual
- C 90% Design Drawings
- D Western Washington Hydrology Model Output
- E Drainage Plan

Acronyms and Abbreviations

%	percent
BMP	best management practice
cfs	cubic feet per second
COI	City of Issaquah
Ecology	Washington State Department of Ecology
LID	Low Impact Development
Manual	2017 Stormwater Design Manual
NAVD-88	North American Vertical Datum of 1988
O&M	operation and maintenance
PGIS	Pollution-Generating Impervious Surface
Project	South SPAR Booster Pump Station
sf	square feet
SSP	Stormwater Site Plan
SWMMWW	Stormwater Management Manual Western Washington
SWPPP	Stormwater Pollution Prevention Plan
WQ	water quality
WSDOT	Washington State Department of Transportation
WWHM	Western Washington Hydrology Model

Section 1: Project Overview

Kennedy/Jenks Consultants, Inc. (Kennedy Jenks) has developed this Stormwater Site Plan (SSP) on behalf of the City of Issaquah (COI) for the South SPAR Booster Pump Station and Transmission Main Project (Project) that will serve the Highlands Central Park 742 Zone.

The Project entails approximately 0.57 acres of land disturbing activities to install a new booster pump station and new paved access road. This Project includes the following items:

- Installation of 7,300 lineal feet of 12-inch diameter water main
- Installation of a booster pump station and 1,200 square foot associated building.
- Installation of a maintenance access road with approximately 18,500 square feet of new asphalt pavement.

This SSP intends to satisfy COI Minimum Requirements for Stormwater Mitigation for greater than 5,000 square feet of new or replaced impervious surface. As defined in COI's 2017 Stormwater Design Manual (Manual) (Manual; 2017) published in 2016, evaluation of Minimum Requirements #1 through # 9 is required. Figure 2.3 – Flow Chart for Determining Requirements for New Development from the Manual is included as Appendix A.

This SSP follows requirements in the Manual stating that SSPs shall be prepared in accordance with the Washington State Department of Ecology (Ecology) Stormwater Management Manual for Western Washington (SWMMWW) (Ecology 2014), and the Manual. This SSP has been prepared based on a thorough evaluation of these two documents. The nine minimum requirements include:

Minimum Requirement #1: Preparation of Stormwater Site Plans (SSP). SSPs shall be prepared in accordance with the current editions of the Ecology Manual, and the Manual.

This document meets Minimum Requirement #1.

Minimum Requirement #2: Construction Stormwater Pollution Prevention Plan (construction SWPPP). All new development and redevelopment shall comply with construction SWPPP Elements No. 1 through No. 13 as outlined in the Ecology Manual.

A construction SWPPP will be prepared by others as a stand-alone document.

Minimum Requirement #3: Source Control of Pollution. Source control best management practices (BMPs) shall be selected, designed, and maintained according to the Ecology Manual.

The proposed improvements do not create pollution generating impervious surfaces (PGIS). PGIS are defined in the Manual as impervious surfaces considered as significant sources of

pollutants in stormwater runoff. Such surfaces include those that are subject to vehicular use or storage of erodible or leachable materials, wastes or chemicals. Impervious surfaces not regularly used by motor vehicles, including infrequently used maintenance access roads, are not considered PGIS. The access road and access areas around the SPAR Pump Station are considered “infrequency used maintenance access roads”.

PGIS also include untreated metal roofs that have the potential to leach pollutants. The SPAR Pump Station’s metal roof will be coated to prevent pollutant leaching and therefore, is not considered a PGIS.

Minimum Requirement #4: Preservation of Natural Drainage Systems and Outfalls. Natural drainage patterns shall be maintained, and discharges from the project site shall occur at the natural location, to the maximum extent practicable.

This is addressed in Section 4 of the SSP.

Minimum Requirement #5: Onsite Stormwater Management. Onsite stormwater management BMPs are required to be constructed to infiltrate, disperse, and retain stormwater runoff onsite to the extent feasible without causing flooding or erosion impacts.

This is addressed in Section 4 of the SSP.

Minimum Requirement #6: Runoff Treatment. Projects shall utilize onsite stormwater BMPs for the treatment of runoff. Treatment facilities and BMPs shall be designed, sized, and provided for in accordance with the Ecology Manual.

The new and replaced hard surfaces associated with this project are non-pollution-generating impervious surfaces. This requirement does not apply.

As discussed in Minimum Requirement #3, the completed project elements will not include PGIS as the access road and access areas around the SPAR Pump Station are considered “infrequency used maintenance access roads” and the SPAR Pump Station’s metal roof will be coated to prevent pollutant leaching.

Minimum Requirement #7: Flow Control. Projects must provide flow control to reduce the impacts of stormwater runoff from hard surfaces and land cover conversions.

Standard flow control is not required based on the thresholds defined in section 2.4.7.2 of the Manual. Further discussion is provided in Section 4 of the SSP.

Minimum Requirement #8: Wetland Protection. Stormwater flows will discharge into onsite wetlands, either directly or indirectly, through a conveyance system to address minimum Requirements #4, #5, and #7.

Minimum Requirement #9: Operation and Maintenance. An operation and maintenance (O&M) manual that is consistent with the provisions within the Ecology Manual shall be provided for all proposed stormwater facilities and BMPs, and the party (or parties) responsible for maintenance and operation shall be identified.

This requirement is addressed in Section 8 and Appendix B.

This SSP has been organized into sections corresponding to guidance found in Chapter 3.1.7 of Volume I of the Ecology Manual. The sections address the above COI minimum requirements for stormwater mitigation for the Project, as identified in the descriptions below:

Section 1: Project Overview – This section introduces the Project and defines this document as the SSP; therefore, satisfying Minimum Requirement #1.

Section 2: Existing Conditions Summary – This section summarizes the existing conditions and addresses Minimum Requirement #8.

Section 3: Offsite Analysis – This section qualitatively assesses the potential offsite water quality, erosion, slope stability, and drainage impacts associated with the Project and proposed mitigation of those impacts.

Section 4: Permanent Stormwater Control Plan – This section describes the onsite stormwater control BMPs for flow control and treatment that will serve the Project in its developed condition. This section addresses Minimum Requirements #4, #5, #7, and #8.

Section 5: Construction SWPPP and Source Control – This section discusses the Project construction SWPPP and addresses Minimum Requirement #2.

Section 6: Special Reports and Studies – This section summarizes pertinent special reports and studies conducted to prepare this SSP.

Section 7: Other Permits – This section lists other necessary permits and approvals as required by other regulatory agencies that affect the drainage plan or contain more restrictive drainage-related requirements.

Section 8: Operations and Maintenance – This section discusses O&M for the Project and addresses Minimum Requirement #9.

Cited references are provided at the end of the report.

Section 2: Existing Conditions Summary

COI acquired a Washington State Department of Transportation (WSDOT) parcel (Parcel 2724069126) as the pump station site as shown on Figure 1.

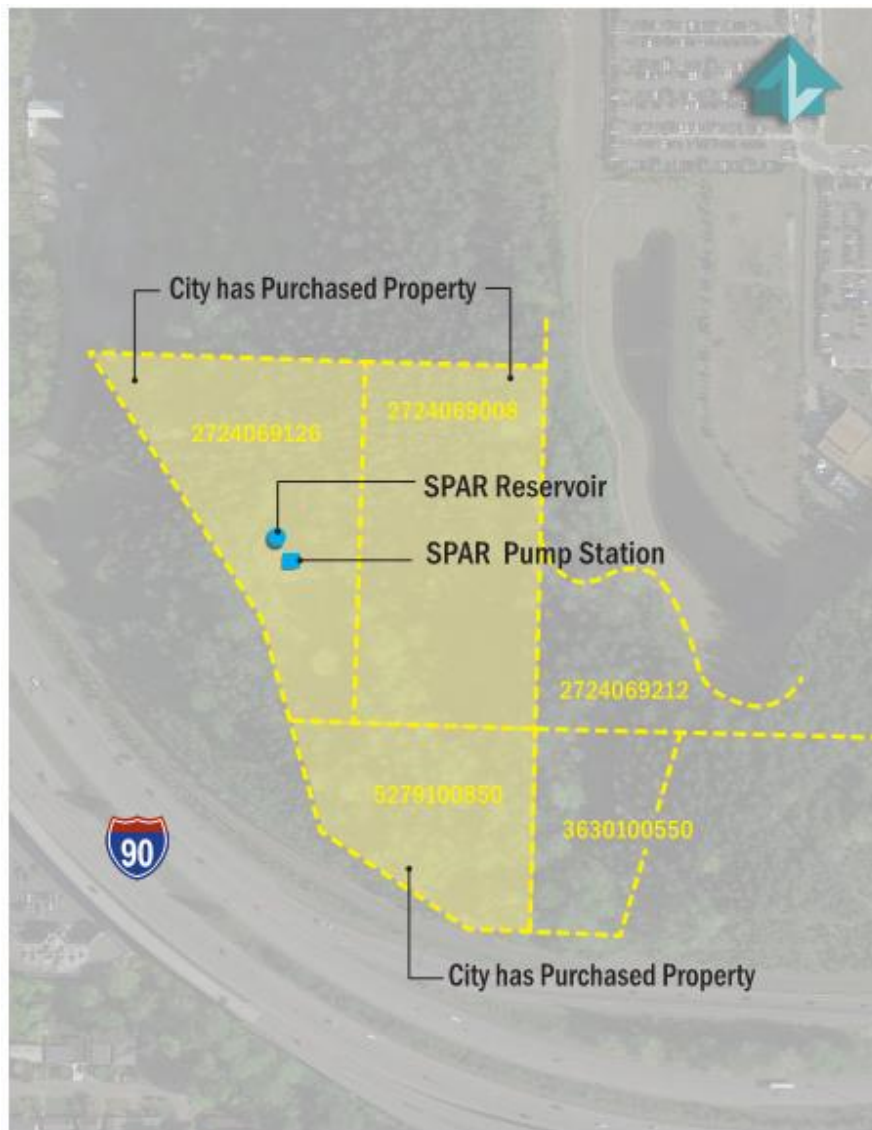


Figure 1: Project Location

The parcel is located adjacent to the northern side of I-90, immediately west of the Sunset Interchange (I-90 Exit 18). The parcel will provide space for the SPAR Pump Station and Reservoir, and currently has a relatively flat benched area with an approximate ground elevation of 260 feet. See Figure 2 for an overview of the 7.3-acre project site.

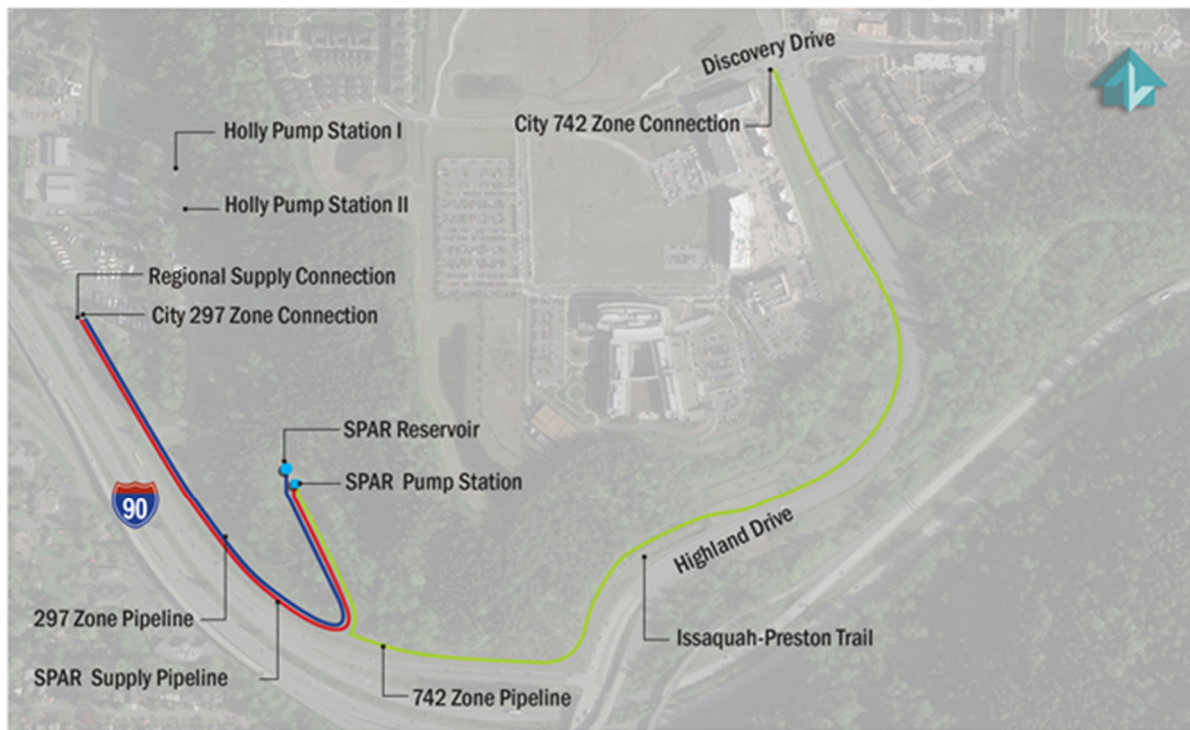


Figure 2: Project Vicinity Map and Components

Access to the site will be along the alignment of an existing gravel access road from the Issaquah-Preston Trail off 1st Avenue NE. A nearly 180-degree turn is required to follow the access road from the trail. A pull-in area will be provided to allow longer vehicles to make a multi-point turn to access the road.

The existing conditions of the Project, are as follows and as shown in the Design Drawings (see Appendix C):

1. An existing flat benched area located near the central part of the project area, is to be regraded and resurfaced prior to installation of the new pump station and future reservoir. Stormwater will be conveyed via sheet flow and through ditches to dispersion BMPs overland flow to rock pads for treatment.
2. An existing maintenance access road will be regraded and resurfaced to provide access to the proposed pump station and future reservoir.

The existing topography at the proposed pump station site consists of shallow surface slopes that range from 1 to 3% and adjacent slopes above and below the project site that range from 5 to 30+%.

The existing site is largely in forested condition. A tree survey was performed and impact to existing vegetation was considered during Project design and will be reduced to the greatest extent practicable.

Wetlands exist onsite and stormwater will be managed to discharge into the existing wetlands with the goal of maintaining their existing hydrologic function.

Section 3: Offsite Analysis

Offsite flow impacts to the Project area, in terms of water quality, erosion, slope stability, and drainage, have not been observed based on numerous site inspections performed by Kennedy Jenks. Site inspections were performed in May 2014, April 2015, June 2015, and July 2015. Site topography survey was also collected.

Based on results of site inspections and survey evaluation, flows from areas from the western portion of the Project area are directed via sheet flow towards the slope above the Issaquah-Preston Trail. Stormwater flows from the eastern side of the Project area sheet flow through native vegetation and either drain to existing site wetlands, sheet flow across the project site and, to a lesser extent, drain down the existing maintenance access road towards the Issaquah-Preston Trail and ultimately into existing catch basins and storm drainage infrastructure.

Regarding Issaquah Code language (IMC 18.10.590) that defines alteration of critical area, is as follows:

“Alteration: Any human-induced action which adversely impacts the existing condition of a critical area. Alterations include, but are not limited to, grading; filling; dredging; draining; channeling; cutting, pruning, limbing or topping, clearing, relocating or **removing vegetation**; applying herbicides or pesticides or any hazardous or toxic substance; **discharging pollutants (excluding treated storm water)**; grazing domestic animals; paving (including construction and application of gravel); modifying for surface water management purposes; or any other human activity that adversely impacts the existing **vegetation, hydrology**, wildlife or wildlife habitat. Alteration does not include walking, passive recreation, fishing or other similar activities.”

Based on the code, the only potential for alterations to a wetland/stream buffer is from the highlighted elements above. Although the project will have permanent impacts on 23,659SF of wetland/stream buffer impacts and of temporary buffer impacts of 9,593 SF, compensatory mitigation is being provided at a greater than 1:1 ratio and will include 23,982 SF of wetland and stream buffer enhancements within the existing buffers of Wetlands B and C and Stream 3, consisting of the planting of native tree and shrub species. All temporarily impacted wetland/stream buffer areas will be fully revegetated, as well. The document *South Spar Booster Pump Station - Critical Areas Report and Mitigation Plan* (ESA, 2019) has further details on critical areas impacts and proposed mitigation measures. In addition, the project plan bid set includes complete mitigation plans, plant quantities, and specifications for all stream and buffer mitigation, as well as for mitigation of significant trees.

Although the project does not involve clearing or grading of any wetland or stream, stormwater from 9,800 sf of the upper (northern) drainage basin will follow the existing natural drainage path and flow into the buffer of Wetland B. Some amount of the flow would likely enter Wetland B, which in turn has a hydrologic connection to Stream 2 and Wetland C. Issaquah code on facilities allowed in wetland buffers (18.10.610.B.4) states:

“Surface water discharge to a wetland from a stormwater facility or other surface water management activity or facility may be allowed if the discharge enhances the wetland and/or

does not increase the rate of flow, change the plant composition in a forested wetland, or decrease the water quality of the wetland”

The discharge of stormwater into the Wetland B buffer will not increase the rate of flow, change the plant composition, or decrease the water quality within Wetland B or its buffer, for the following reasons.

- The new paved roadway replaces a compacted gravel access road, which is effectively impervious surface. Under existing conditions, stormwater falling on the access road sheet flows to the west, entering the buffer of Wetland B. The project will not alter existing flow paths or result in a substantial increase in the amount of effective impervious surface draining to the wetland buffer.
- As with existing conditions, much of the stormwater entering the buffer of Wetland B, will be intercepted by vegetation or infiltrated into native soils. The quantity and quality of vegetation in the buffer will be enhanced through compensatory mitigation in these areas, maintaining, or very likely enhancing infiltration and interception efficiencies in the buffer.
- Although paved, the new access road is not considered pollution generating impervious surface (PGIS), based on the infrequent use. As the new paved and gated access road will have a traffic volume of one trip per week, it is considered an “infrequency used maintenance access road”. With such low vehicle usage, the potential for the impervious area to measurably add to the amount of suspended sediment, or total or dissolved metals, or other potentially harmful stormwater constituents conveyed to the wetland and wetland buffer is discountable. No negative effects on water quality are expected within Wetland B, its buffer, or downstream areas.
- Hydrology in Wetland B is supported by a high groundwater table and precipitation, with portions of the wetland seasonally inundated. The wetland serves as the headwaters for Stream 2. Compared to existing conditions, no significant changes in wetland hydrology are expected from the sheet flow of stormwater from the paved access road into the wetland buffer. Even if there was a very slight increase in the quantity of water delivered, it would be insignificant in comparison to the groundwater inputs the wetland receives under existing conditions.

Based on the project elements, as proposed (including the proposed stormwater element), the project will not negatively affect the structure or function of Wetland B or any other hydrologically connected wetlands and streams, thereby meeting all requirements of IMC 18.10.

Section 4: Permanent Stormwater Control Plan

The permanent stormwater control plan was developed with the goal of maintaining natural drainage patterns and discharges from the project site. Runoff discharged from the project site is not anticipated to cause significant adverse impact to the downstream receiving waters and down gradient properties.

Two TDAs have been identified as Area 1 and Area 2 on the Drainage Plan included as Appendix E.

Area 1 consists of the pump station roof and surrounding impervious surfaces and will drain to existing wetlands. The effective impervious surface within Area 2 is approximately 9,800 square feet (sf). Flows will be dispersed at the impervious surface edge in accordance with BMP T5.12 Sheet Flow Dispersion. The transition zone will consist of an extension of the subgrade material.

Guide Sheets #1 through #3 in Appendix I-C of the SWMMWW were reviewed to address Minimum Requirement #8. It was found that the criteria under sections I-C.2, I-C.3 a hydrologic evaluation was not necessary because the Threshold Discharge Area (TDA) is less than 10,000 sf.

Area 2 consists of the lower portion of the maintenance access road and turn around area adjacent to the Issaquah-Preston Trail. The effective impervious surface within Area 2 is approximately 8,700 sf.

Flows will be managed from Area 2 such that discharges will not exceed an increase of 0.15 cubic feet per second (cfs) when comparing post-project runoff to the existing condition runoff as estimated using the Western Washington Hydrology Model (WWHM) using 15-minute time steps. The estimated flow increase from WWHM is 0.10 cfs. WWHM output reports are provided as Appendix D.

Because the thresholds in Section 2.4.7.2 of the Manual were not met for both TDAs, Standard Flow Control as defined in Section 2.4.7.3 of the manual is not required. Consequently, compliance with the Low Impact Development (LID) performance standard is also not applicable (Ecology 2014).

The proposed regrading and resurfacing improvements and implementation of the proposed BMPs address Minimum Requirements #4, #5, #7, and #8.

See Appendix E for further detail regarding existing and proposed drainage basins and associated characteristics.

Section 5: Construction SWPPP and Source Control

A construction SWPPP (Minimum Requirement #2) meeting the Ecology Manual and the Manual requirements will be prepared by others and provided under separate cover.

Section 6: Special Reports and Studies

This SSP and associated Design Drawings (Appendix C) were prepared using Icicle Creek Engineer's geotechnical engineering design recommendations, including the following related to stormwater:

- Icicle Creek Report dated 28 February 2017 states "alterations shall minimize disturbance to the landslide hazard area, slope and vegetation unless necessary for slope stabilization; and the proposed alteration will not decrease slope stability on contiguous properties; and the risk of property damage or injury resulting from landsliding is eliminated or minimized". Landslide areas are as identified in Figure 6 (Critical Areas Map) and Figure 7 (Topographic Plan), and stormwater has been routed to avoid these areas. Refer to Project Drawings G11-G13, EC01-EC08, and C2-C9.
- Icicle Creek Report Addendum dated 11 October 2019 includes an updated Critical Areas Map (Attachment D).
- Icicle Creek Report Addendum dated 21 January 2021 includes an updated Site Plan and Critical Areas Map (Attachment A) and Pump Station Plan.

No known formally adopted and Ecology-approved basin and/or watershed plans exist for the Project area.

Section 7: Other Permits

As indicated in Section 1: Project Overview, this SSP is intended to satisfy the COI Stormwater Permit Submittal Requirements.

Section 8: Operations and Maintenance

An O&M manual for BMP T5.12 meeting Minimum Requirement #9 can be found in Appendix B.


References

- City of Issaquah. (Manual 2016). 2017 Stormwater Design Manual Addendum 07 November 2016. <https://www.issaquahwa.gov/DocumentCenter/View/4458>.
- Icicle Creek Engineers, Inc. (Icicle Creek Engineers). 2017. Report Geotechnical Engineering Services and Critical Areas Evaluation South SPAR Zone 297 Reservoir, Booster Pump Station and Water Line Issaquah, Washington, Prepared for Kennedy/Jenks Consultants. No. 0101-013. 28 February 2017.
- Icicle Creek Engineers, Inc. (Icicle Creek Engineers). 2019. Report Addendum, Geotechnical Engineering Services, Proposed South SPAR Booster Pump Station, Interstate 90 Sunset Interchange Area, Issaquah, Washington. No. 0101-013. 11 October 2019.
- Icicle Creek Engineers, Inc. (Icicle Creek Engineers). 2021. Report Addendum, Critical Areas Evaluation, Proposed South SPAR Booster Pump Station and 297/520 Zone and 742 Zone Water Lines, Interstate 90 Sunset Interchange Area, Issaquah, Washington. No. 0101-013. 22 January 2021.
- Washington State Department of Ecology. 2014. Stormwater Management Manual for Western Washington. Washington State Department of Ecology Water Quality Program. Publication Number 14-10-055. December.

Appendix A

Flow Chart for Determining Requirements for Redevelopment

Figure 2.3. Flow Chart for Determining Requirements for New Development

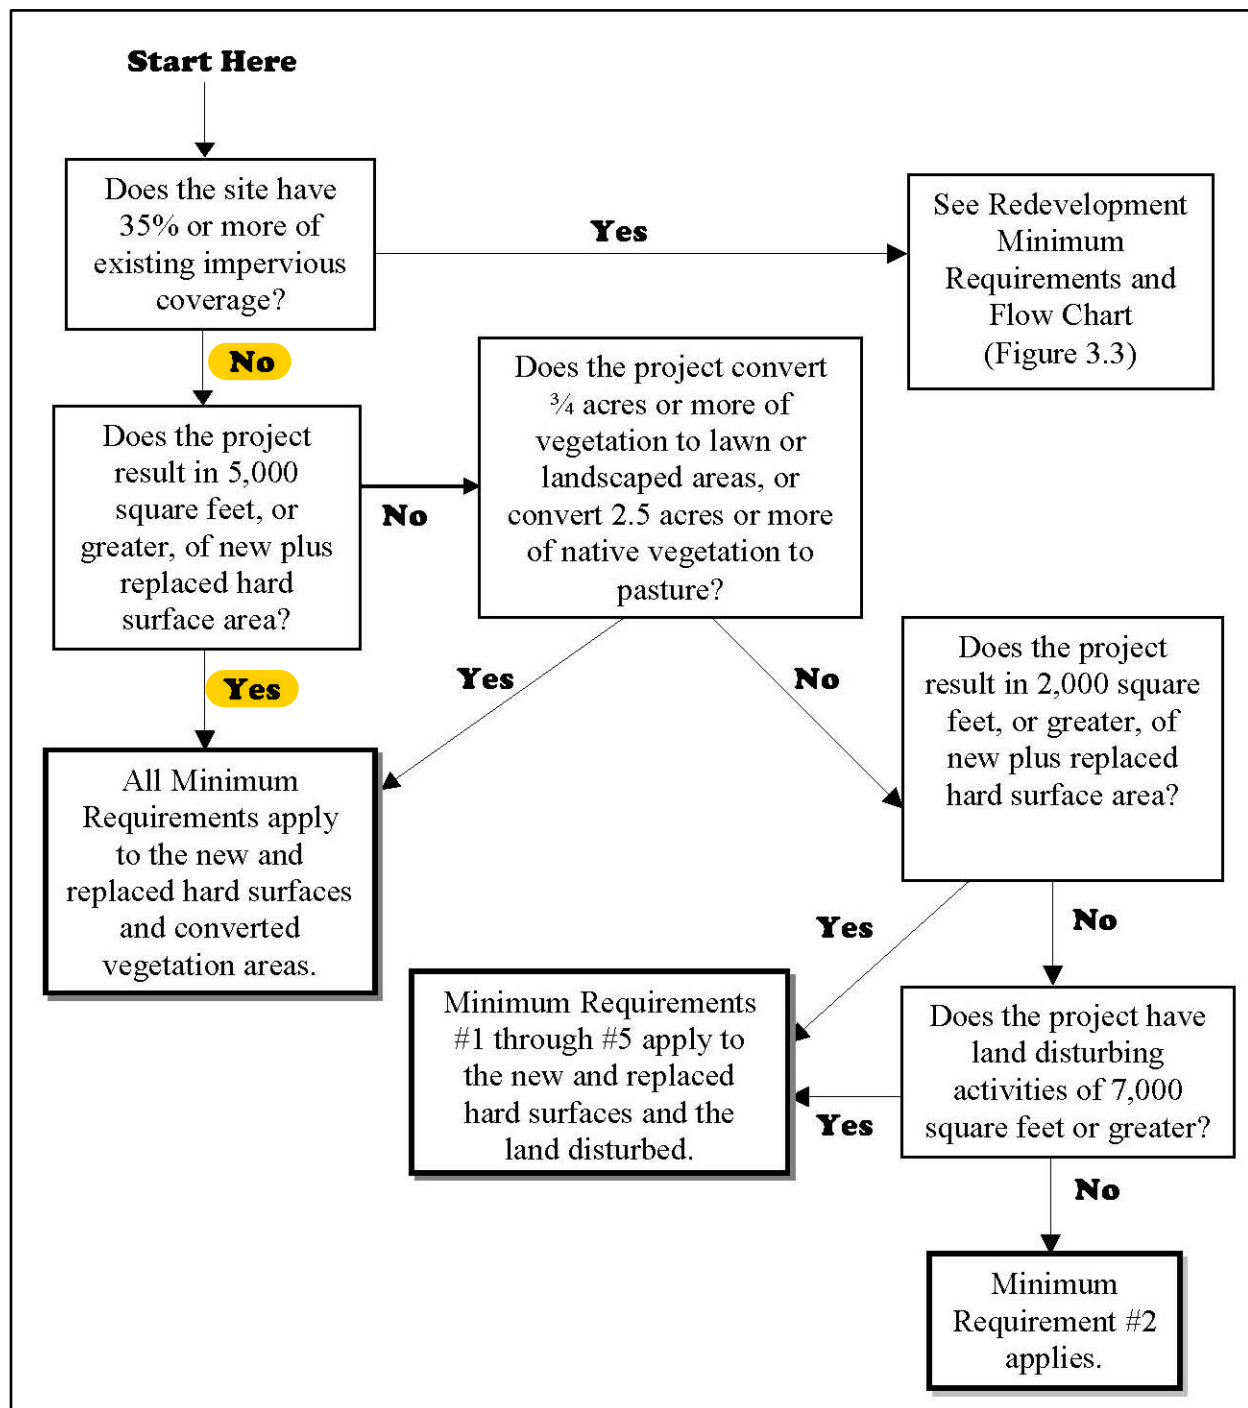

Appendix B

Operations and Maintenance Manual



Kennedy Jenks

32001 32nd Avenue South, Suite 100
Federal Way, Washington 98001
253-835-6400

Operations and Maintenance Manual

City of Issaquah
SPAR Booster Pump Station

30 November 2020

Prepared for

City of Issaquah
1775 12th Ave NW
Issaquah, WA 98027

KJ Project No. 1397005*00

Table of Contents

<i>List of Attachments.....</i>	<i>i</i>
Section 1: Facility Description	1
Section 2: Maintenance Activities	2
Section 3: Responsible Parties.....	3
<i>References.....</i>	<i>4</i>

List of Attachments

A Maintenance Activity Log

Section 1: Facility Description

Kennedy/Jenks Consultants, Inc. (Kennedy Jenks) has developed this Operations and Maintenance (O&M) Manual on behalf of the City of Issaquah (COI) for the SPAR Booster Pump Station (SPAR Pump Station) and Transmission Main that will serve the Highlands Central Park 742 Zone.

The SPAR Pump Station will use BMP T5.12: Sheet Flow Dispersion to meet stormwater treatment requirements in accordance with the Stormwater Management Manual for Western Washington (SWMMWW) (Ecology, 2014).

Sheet flow dispersion will be accomplished by diverting flows from hard surfaces to a 2-foot-wide transition zone and ultimately into on-site wetlands. The transition zone will consist of roadbed material (crushed rock).

This O&M Manual will be made available for inspection by local government, as needed, and kept at the following location:

City of Issaquah
670 1st Avenue NE
Issaquah, Washington 98027

Section 2: Maintenance Activities

Maintenance of the sheet flow dispersion systems is vital to the longevity and the expected treatment performance of the systems. The Maintenance Activity Log describing the recommended maintenance tasks and the frequency of each task in accordance to standards established in the Ecology Manual can be found in Attachment A.

Section 3: Responsible Parties

The responsible party for ensuring proper maintenance of the sheet flow dispersion systems is listed below. In the event the responsible party is altered, a revised O&M Manual indicating the new responsible party will be provided.

Robert York, P.E.
Utilities Engineering Manager
City of Issaquah
roberty@issaquahwa.gov
425-837-3449

References

Washington State Department of Ecology. 2014. Stormwater Management Manual for Western Washington. Washington State Department of Ecology Water Quality Program. Publication Number 14-10-055. December.

Attachment A

Maintenance Activity Log

**SPAR Pump Station - Sheet Flow Dispersion Systems
Maintenance Activity Log**

Frequency	System Component	Defect	Condition Triggering Maintenance	Maintenance Activities and Resulting Conditions	Inspection Date and Weather	Condition Observed	Action Taken and Observed Result
Sheet Flow Dispersion							
Annually	Transition Zone	Erosion	Adjacent soil erosion; uneven surface creating concentrated flow discharge; or less than 2 feet of width.	Repair/replace transition zone to meet design criteria and eliminate concentrated flows.			
Dispersal Area							
Biannually and After Major Storm Events	Dispersal area (general)	Erosion	Erosion (gullies/rills) greater than 2 inches deep in dispersal area.	Eliminate cause of erosion and stabilize damaged area (regrade, rock, revegetate).			
Biannually and After Major Storm Events	Dispersal area (general)	Erosion	Accumulated sediment or debris to extent that blocks or channelizes flowpath.	Remove excess sediment or debris. Identify and control the sediment source (if feasible).			

Appendix C

90% Design Drawings



CITY OF ISSAQUAH


ISSAQUAH, WASHINGTON

SOUTH SPAR BOOSTER PUMP STATION

THIS SUBMITTAL ADDRESSES COMMENTS FROM THE CITY OF ISSAQUAH PLANNING DEPARTMENT ON THE PERMIT SUBMITTAL DRAWING SET DATED 11/30/2020. SELECTED DRAWINGS HAVE BEEN UPDATED AS REQUIRED TO ADDRESS THESE COMMENTS, DRAWINGS DIRECTLY ADDRESSING THE REVIEW COMMENTS INCLUDE:


- G2 - UPDATED SHEET LIST TO INCLUDE ADDITIONAL DRAWINGS
- G12 - ADDED NEW DRAWING "DRAINAGE PLAN" WHICH DEPICTS STORMWATER INFORMATION REQUESTED IN COMMENTS FROM CITY REVIEW.
- G13 - ADDED NEW DRAWING "CRITICAL AREAS MAP" IN RESPONSE TO COMMENT 4 BY WOOD E&IS
- S1 - UPDATED TO NOTE 2015 BUILDING CODE PER COMMENT FROM DOUGLAS BECK
- S2 - UPDATED TO NOTE 2015 BUILDING CODE PER COMMENT FROM DOUGLAS BECK
- S6 - UPDATED ROOF DESIGN PER COMMENTNS FROM DOUGLAS BECK
- S7 - UPDATED ROOF DESIGN PER COMMENTS FROM DOUGLAS BECK

REVISIONS TO THE CURRENT SET ARE CLOUDED IN RED

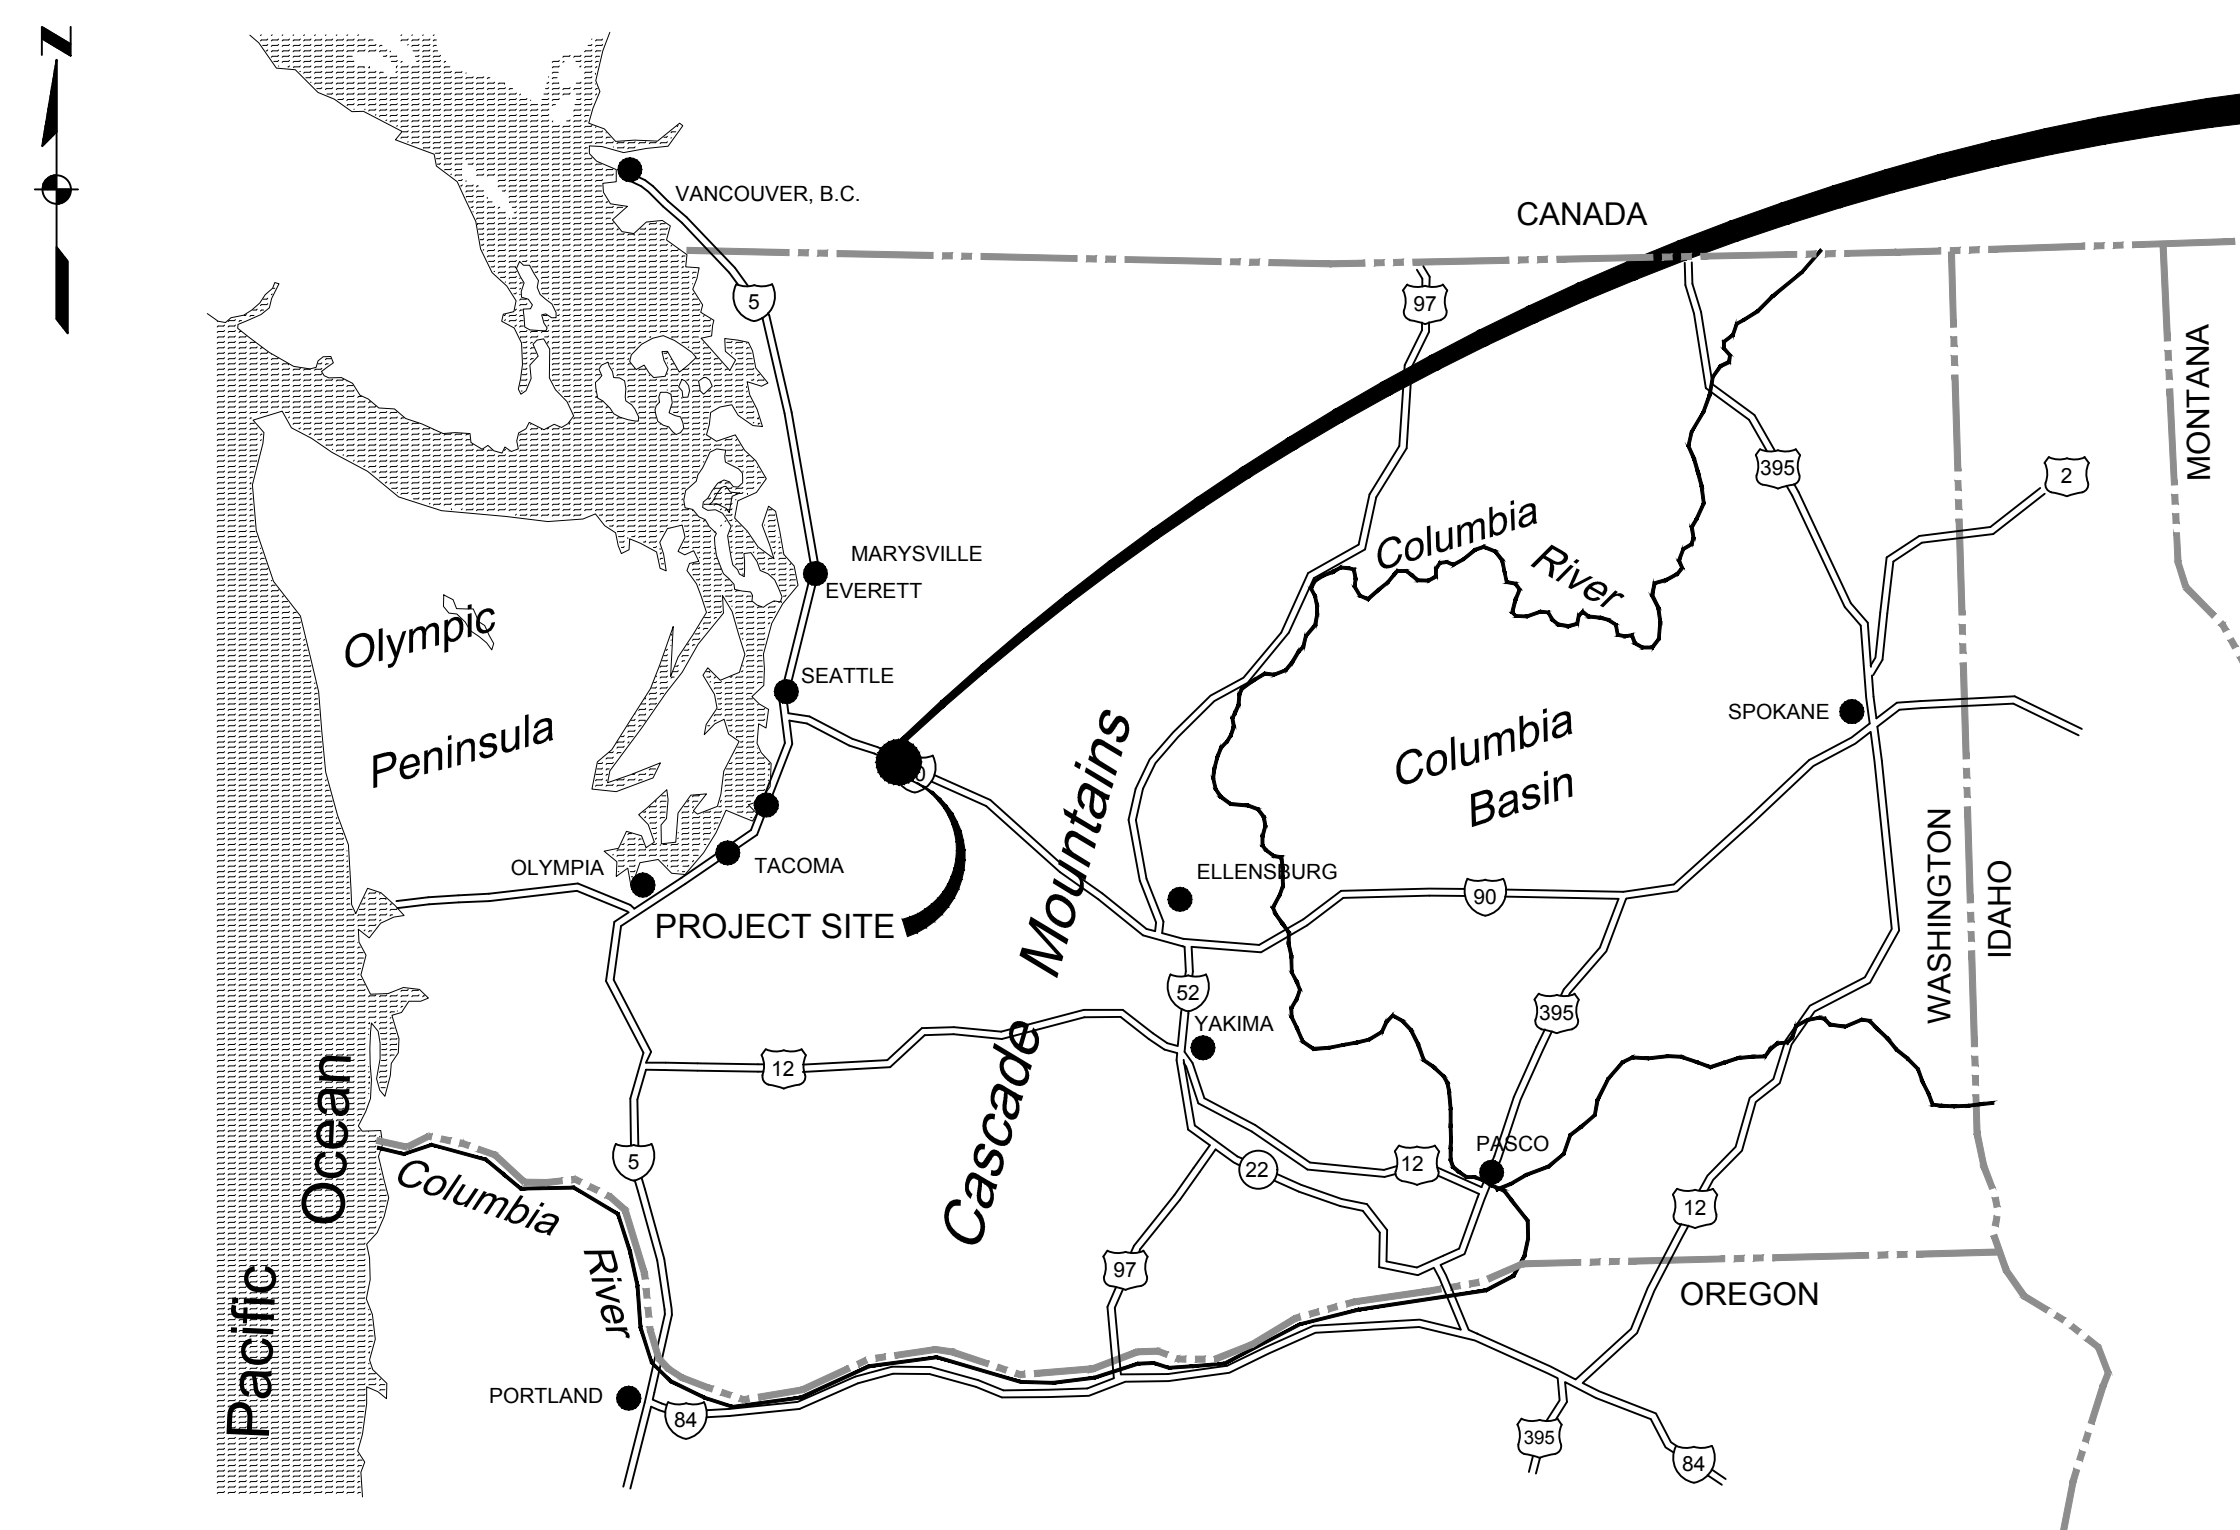

REGIONAL MAP

WSDOT I-90 ROW: BEGIN PROJECT AT MILE POST 17.61 AND END AT MILE POST 17.61

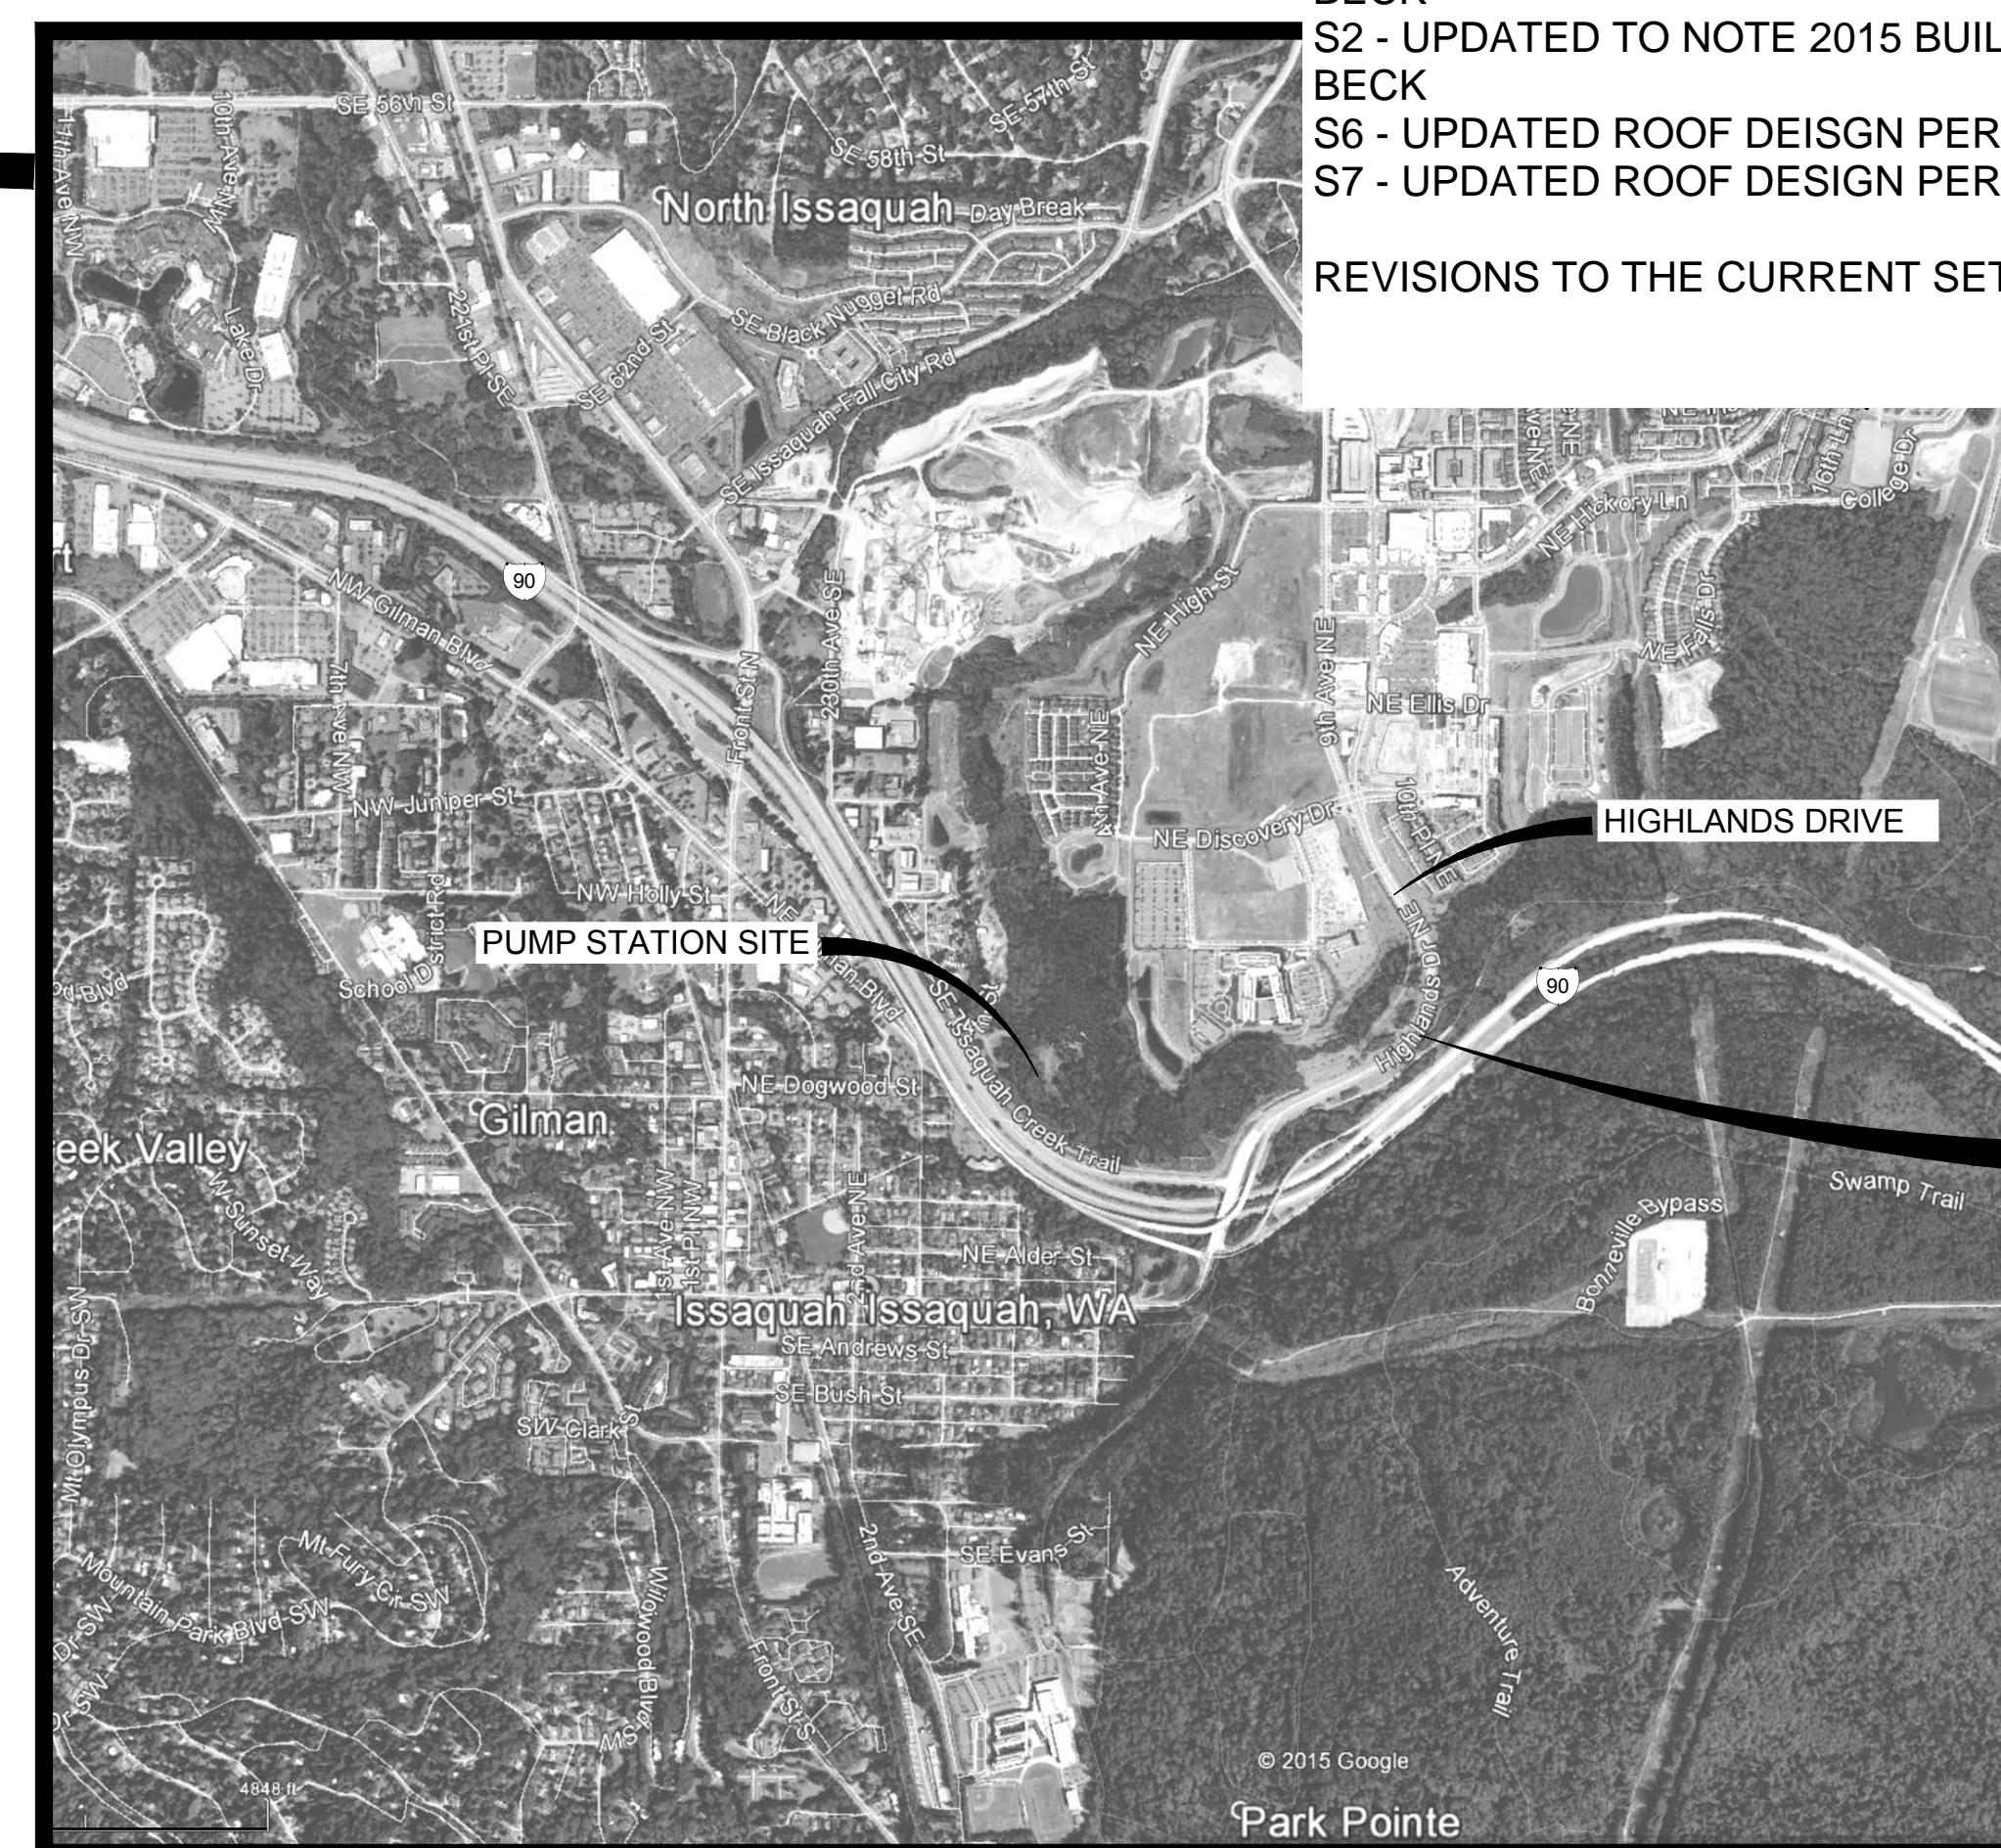


VICINITY MAP

Kennedy/Jenks Consultants


32001 32ND AVENUE SOUTH, SUITE 100
FEDERAL WAY, WASHINGTON 98001
253.835.6400

1397005*00

REVISED SUBMITTAL 02/23/2021

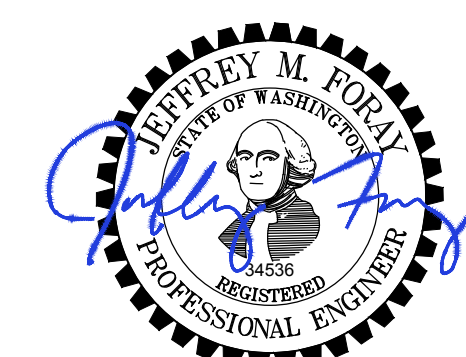

P:\CAD\131\1397005.00_City_of_Issaquah\139700500-G002.dwg
MIKEMARX 2/23/2021 4:29 PM

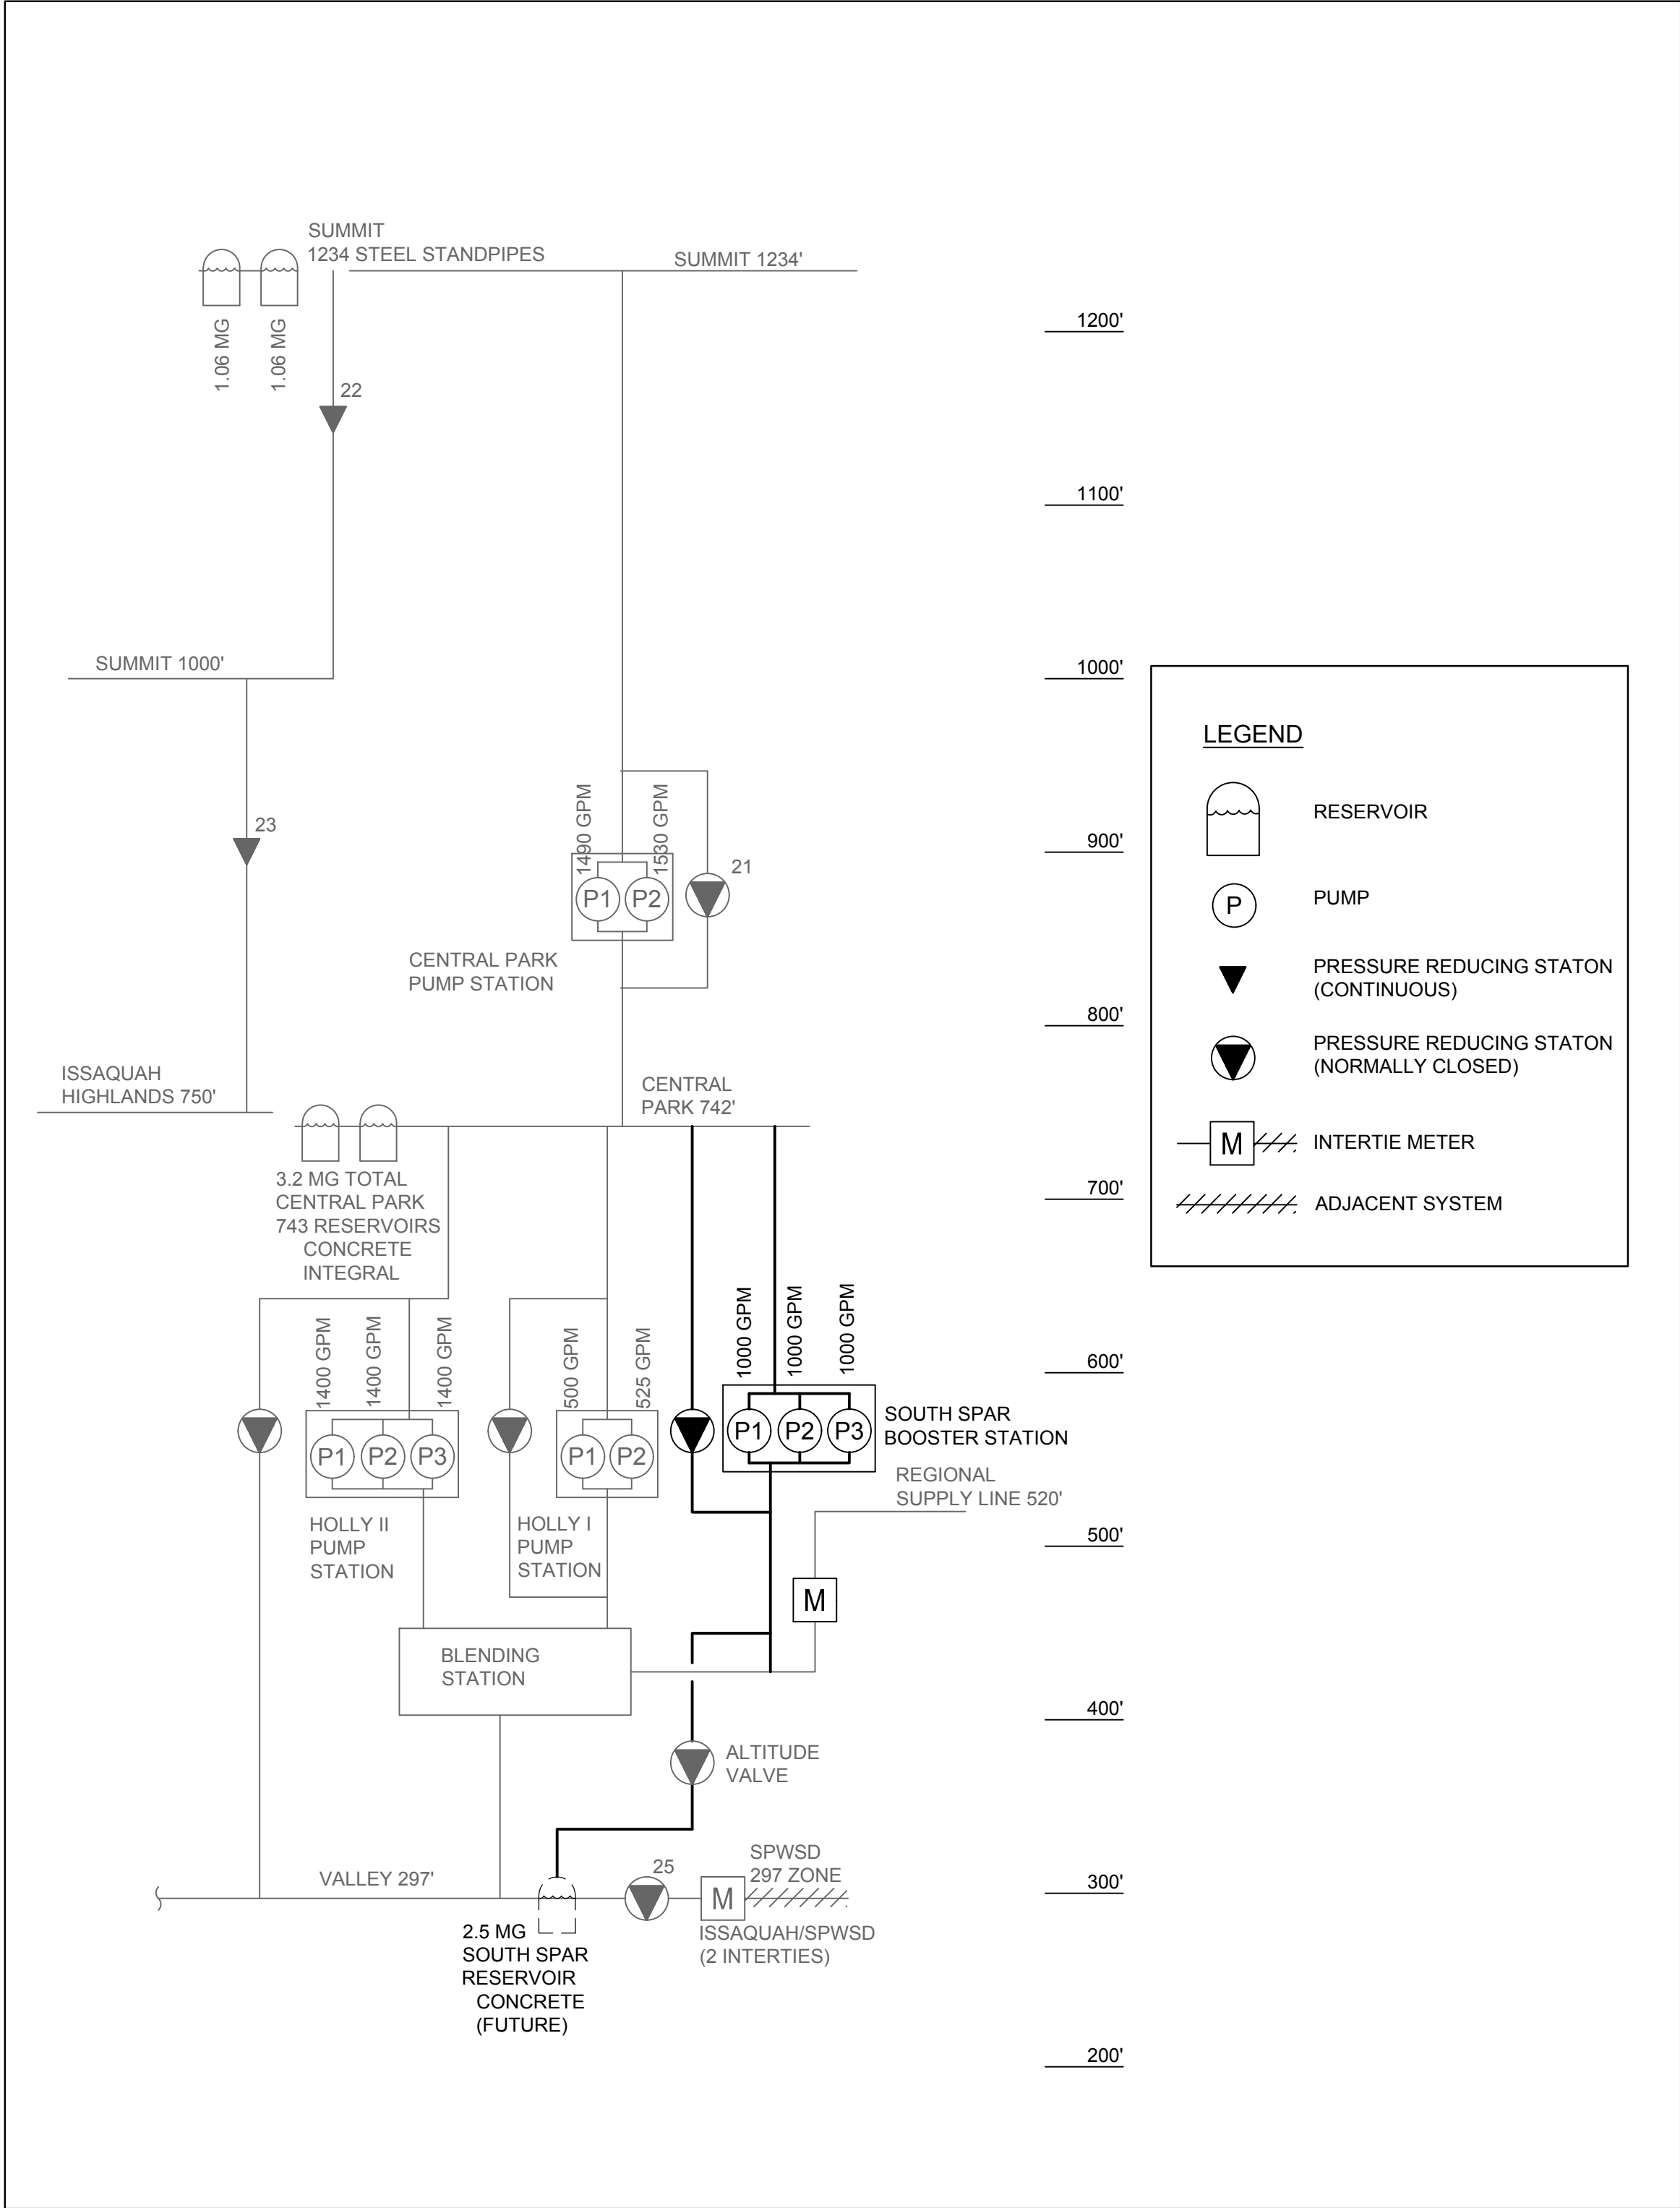

PARTIAL HYDRAULIC PROFILE

BASIS OF DESIGN

DESCRIPTION	UNIT	VALUE
BOOSTER PUMPS		
PUMP TYPE	VERTICAL TURBINE PUMP	
NUMBER OF PUMPS	EACH	3
FIRM CAPACITY (2 PUMPS)	GPM	2000
297 ZONE		
TDH	FT	550
MOTOR	HP	200
520 ZONE		
TDH	FT	330
MOTOR	HP	125

NOTE: CURRENT INSTALLATION PROVIDES ONE PUMP SIZED TO PUMP FROM 297 ZONE, AND TWO PUMPS SIZED TO PUMP FROM 520 ZONE. 520 ZONE PUMPS CAN BE UPGRADED IN THE FUTURE.

SITE INFORMATION:

ADDRESS	614 SE 74TH STREET, ISSAQUAH, WA 98027
DEVELOPABLE SITE AREA	2.7 AC
GROSS SITE AREA	7.3 AC
PARCEL NUMBER	272406-9126 AND 527910-0850
ZONING	CF-F AND CF-OS
EXISTING IMPERVIOUS AREA	0.01 AC
PROPOSED IMPERVIOUS AREA	0.47 AC

DRAWING COUNT	DRAWING NUMBER	DRAWING TITLE
1	G1	TITLE, REGIONAL MAP AND VICINITY MAP
2	G2	SHEET LIST, BASIS OF DESIGN, PARTIAL HYDRAULIC PROFILE, AND SURVEY INFORMATION
3	G3	ABBREVIATIONS
4	G4	CIVIL GENERAL SYMBOLS AND NOTES
5	G5	PIPING SYMBOLS, NOTES, AND SCHEDULE
6	G6	CITY STANDARD DETAILS
7	G7	CITY STANDARD DETAILS
8	G8	WSDOT STANDARD DETAILS
9	G9	WSDOT STANDARD DETAILS
10	G10	WSDOT STANDARD DETAILS
11	G11	OVERALL SITE PLAN
11A	G12	DRAINAGE PLAN
11B	G13	CRITICAL AREAS MAP
12	TP1	TRAFFIC CONTROL PLAN (LANE CLOSURE)
13	TP2	TRAFFIC CONTROL PLAN
14	TP3	TRAFFIC CONTROL PLAN
15	EC1	EROSION AND SEDIMENTATION CONTROL GENERAL NOTES
16	EC2	SITE EROSION CONTROL PLAN
17	EC3	SITE EROSION CONTROL PLAN
18	EC4	SITE EROSION CONTROL PLAN
19	EC5	SITE EROSION CONTROL PLAN
20	EC6	SITE EROSION CONTROL PLAN
21	EC7	SITE EROSION CONTROL PLAN
22	EC8	SITE EROSION CONTROL DETAILS
23	C1	SITE AND YARD PIPING PLAN
24	C2	SITE GRADING AND PAVING PLAN
25	C3	ACCESS ROAD PLAN AND PROFILE
26	C4	ACCESS ROAD PLAN AND PROFILE STA. 14+25 TO STA. 17+80
27	C5	SECTIONS AND DETAILS
28	C6	CIVIL DETAILS - 1
29	C7	CIVIL DETAILS - 2
30	C8	PUMP STATION GRADING PARTIAL PLAN
31	C9	ACCESS ROAD GATE AND FENCE PLAN
32	L1	BUFFER IMPACTS PLAN
33	L2	BUFFER MITIGATION PLAN
34	L3	BUFFER MITIGATION DETAILS
35	L4	TREE IMPACTS PLAN
36	L5	TREE MITIGATION PLAN
37	CP1	297/520 ZONE PIPELINES PLAN AND PROFILE STA. 1+00 TO STA. 11+00
38	CP2	297/520 ZONE PIPELINES PLAN AND PROFILE STA. 11+00 TO STA. 19+88.60
39	CP3	297/520 ZONE AND 742 ZONE PIPELINES PLAN AND PROFILE STA. 19+88.60 TO STA. 25+34.25
40	CP4	742 ZONE PIPELINE PLAN AND PROFILE STA. 50+00 TO STA. 58+00
41	CP5	742 ZONE PIPELINE PLAN AND PROFILE STA. 58+00 TO STA. 67+00
42	CP6	742 ZONE PIPELINE PLAN AND PROFILE STA. 67+00 TO STA. 75+50
43	CP7	742 ZONE PIPELINE PLAN AND PROFILE STA. 75+50 TO STA. 84+50
44	CP8	742 ZONE PIPELINE PLAN AND PROFILE STA. 84+50 TO STA. 91+00
45	CP20	PIPELINE SECTIONS - 1
46	CP21	PIPELINE SECTIONS - 2
47	CP22	PIPELINE SECTIONS - 3
48	CP23	PIPELINE SECTIONS - 4
49	CP24	PIPELINE SECTIONS - 5
50	CP25	PIPELINE SECTIONS - 6
51	CP26	PIPELINE SECTIONS - 7
52	CP30	PIPELINE DETAILS - 1
53	CP31	PIPELINE DETAILS - 2
54	CP32	PIPELINE DETAILS - 3
55	CP33	PIPELINE DETAILS - 4
56	CP34	PIPELINE DETAILS - 5
57	A1	PUMP STATION FLOOR PLAN AND CODE SUMMARY
58	A2	PUMP STATION EXTERIOR ELEVATIONS, PUMP STATION SECTIONS, AND DETAILS
59	A3	PUMP STATION DOOR SCHEDULE, FINISH SCHEDULES, AND DETAILS
60	A4	PUMP STATION BUILDING SECTION AND DETAILS
61	S1	STRUCTURAL GENERAL NOTES AND ABBREVIATIONS
62	S2	STRUCTURAL STANDARD DETAILS - 1
63	S3	STRUCTURAL STANDARD DETAILS - 2
64	S4	STRUCTURAL CMU NOTES AND STANDARD DETAILS
65	S5	SPECIAL INSPECTION REQUIREMENTS
66	S6	PUMP STATION FOUNDATION PLAN AND ROOF PLAN
67	S7	PUMP STATION SECTIONS AND DETAILS
68	M1	PUMP STATION PLAN AND HVAC SCHEDULES
69	M2	PUMP STATION SECTIONS - 1
70	M3	PUMP STATION SECTIONS - 2
71	M4	STANDARD MECHANICAL DETAILS - 1
72	M5	STANDARD MECHANICAL DETAILS - 2
73	E1	ELECTRICAL ABBREVIATIONS AND SYMBOLS
74	E2	SINGLE LINE DIAGRAM
75	E3	SWITCHBOARD, MCC-1 AND VFD ELEVATION
76	E4	PUMP STATION POWER AND SIGNAL PLAN
77	E5	PUMP STATION LIGHTING, VIDEO AND GROUNDING PLAN
78	E6	CONDUIT AND WIRE, LUMINAIRE AND PANEL SCHEDULES
79	E7	STANDARD ELECTRICAL DETAILS AND WIRING DIAGRAMS
80	I1	PROCESS & INSTRUMENTATION DIAGRAM LEGEND
81	I2	PROCESS & INSTRUMENTATION DIAGRAM BOOSTER PUMP STATION
82	I3	PROCESS & INSTRUMENTATION DIAGRAM AIR COMPRESSOR AND SURGE TANK

USE OF DOCUMENTS

THIS DOCUMENT, INCLUDING THE INCORPORATED DESIGNS, IS AN INSTRUMENT OF SERVICE FOR THIS PROJECT AND SHALL NOT BE USED FOR ANY OTHER PROJECT WITHOUT THE WRITTEN AUTHORIZATION OF KENNEDY/JENKS CONSULTANTS.

NO.

REVISION

DATE

BY

SCALES



IF THIS BAR IS NOT DIMENSION SHOWN, ADJUST SCALES ACCORDINGLY.



DESIGNED

JMF

DRAWN

LMM

CHECKED

MDL



CITY OF ISSAQUAH

ISSAQUAH, WASHINGTON

SOUTH SPAR BOOSTER PUMP STATION

Kennedy/Jenks Consultants

FEDERAL WAY, WASHINGTON

SHEET LIST, BASIS OF DESIGN, PARTIAL HYDRAULIC PROFILE, AND SURVEY INFORMATION

FILE NAME

139700500-G002.DWG

JOB NO.

1397005*00

DATE

FEBRUARY 2021

SHEET

OF

G2

6/24/2020 10:22 AM

MIKE/MARY

P:\CAD\131\1397005_00_City_of_Issaquah\139700500-G003.dwg

01234

ABBREVIATIONS

&	AND	CCWR	CLOSED-LOOP COOLING WATER RETURN	EFFL, EFF	EFFLUENT	H	HIGH	MH	MANHOLE	PROJ	PROJECT(-ION)	STOR	STORAGE
∠	ANGLE	CCWS	CLOSED-LOOP COOLING WATER SUPPLY	e.g.	FOR EXAMPLE	HB	HOSEBIBB	MIL(S)	1/1000 INCH	PROP.	PROPERTY	STRUCT	STRUCTUR(-E, -AL)
±	APPROXIMATELY	CEM	CEMENT	EGL	ENERGY GRADE LINE	HC	HEAT CONSERVATION	MIN	MINIMUM; MINUTE	PROT	PROTECTOR	SUB	SUBNATANT
@	AT	CEN	CENTRAL	E.L.	EPOXY LINED	HDPE	HIGH DENSITY POLYETHYLENE	MISC	MISCELLANEOUS	PRS	PRESSURE SNUBBER	SUBM	SUBMISSION (SUBMIT)
⊕	CENTERLINE	CF	CUBIC FEET	EL, ELEV.	ELEVATION	HGL	HYDRAULIC GRADE LINE	MJ	MECHANICAL JOINT	PRV	PRESSURE REDUCING VALVE	SUP	SUPERNATANT
Δ	DEFLECTION	CFM	CUBIC FEET PER MINUTE	ELB, ELL	ELBOW	HGR	HANGER	ML	MILLILITER(-S)	PS	PUMP STATION, PIPE SUPPORT	SUPP	SUPPORT(-S)
°	DEGREE	CFS	CUBIC FEET PER SECOND	EL&C	EPOXY LINED & COATED	HGT, HT	HEIGHT	MM	MILLIMETER(-S)	PSF	POUNDS PER SQUARE FEET	SURF.	SURFACE
=	EQUALS	CH	CHAMBER	ELEC	ELECTRIC (-AL)	HM	HOLLOW METAL	MODIF	MODIFICATION(-S)	PSI	POUNDS PER SQUARE INCH	SUSP	SUSPEND(-ED)
'	FOOT	CHAN	CHANNEL	ELEM	ELEMENTARY	HORIZ	HORIZONTAL	MON	MONUMENT	PSIA	POUNDS PER SQUARE INCH ABSOLUTE	SV	SOLENOID VALVE
>	GREATER THAN	CHEM	CHEMI (-CAL,-STRY)	EMERG	EMERGENCY	HP	HORSEPOWER	MPH	MILES PER HOUR		(PRESSURE ABOVE VACUUM)	SW	SOUTHWEST; SWITCH
"	INCH	CHK'D	CHECKED	ENCL	ENCLOSURE	HPC	HIGH PRESSURE CONDENSATE	MT	MOUNT	PSIG	POUNDS PER SQUARE INCH-GAUGE	SWBD	SWITCHBOARD
Ø	PHASE	CHKR	CHECKERED	ENGR	ENGINEER	HPS	HIGH PRESSURE STEAM	MTD	MOUNTED		(PRESSURE ABOVE ATMOSPHERE)	S/W	SIDEWALK
<	LESS THAN	CI	CAST IRON	ENTR	ENTRANCE	HPT, H.P.	HIGH POINT	MTG	MOUNTING	P.SL	PIPE SLEEVE	S/WGR	SWITCHGEAR
#	NUMBER	CIP	CAST IRON PIPE	EP, EOP	EDGE OF PAVEMENT	HR	HOUR	MTR	MOTOR	P.STA.	PUMP STATION	SYM	SYMMETRICAL
%	PERCENT	CIRC	CIRCULA(-R,-TION)	EPA	ENVIRONMENTAL PROTECTION AGENCY	HRL	HANDRAIL	MUL	MULLION	P. SW.	PRESSURE SWITCH	T	TIMER, TIME, THERMOSTAT
A	AREA	CIRCUM	CIRCUMFERENCE	EQ	EQUAL (-LY)	HT	HEIGHT	MV	MUD VALVE	PT	POINT	T/	TOP OF
AB	ANCHOR BOLT(-S)	CISP	CAST IRON SOIL PIPE	EQUAL., EQ.	EQUALIZATION	HTR	HEATER	MX	MIXER	PV	PLUG VALVE	TAN.	TANGENT(-HAL)
ABAN	ABANDON (-ED)	CJ	CONSTRUCTION JOINT	EQUIP	EQUIPMENT	HVAC	HEATING, VENTILATING & AIR CONDITIONING	N	NORTH	P.V.C.	POINT OF VERTICAL CURVE	TB	THRUST BLOCK
ABS	ABSOLUTE	CKT	CIRCUIT	EST	ESTIMATE (-D)	HVY	HEAVY	(N)	NEW	PVC	POLYVINYL CHLORIDE	TBM	TEMPORARY BENCH MARK
A.B.S.	ACRYLONITRILE-BUTADIENE-STYRENE	CL	PIPE CLASS	ETC	ET CETERA	HW	HOT WATER	N/A	NOT APPLICABLE	PVI	POINT OF VERTICAL INTERSECTION	T & B	TOP & BOTTOM
AC	ACRE, ASPHALTIC CONCRETE	CL	CENTERLINE	EUC	EUCALYPTUS	HWD, HDWD	HARDWOOD	NAT G, NG	NATURAL GAS	PVT	POINT OF VERTICAL TANGENCY	TC	TOP OF CURB
A.C.	ASBESTOS CEMENT	CL2	CHLORINE	EXC	EXCAVATE	HWL	HIGH WATER LEVEL	N.C., NC	NORMALLY CLOSED	PWWF	PEAK WET WEATHER FLOW	TBM	TEMPORARY BENCH MARK
A/C	ASPHALT CONCRETE	CLASS.	CLASSIFICATION	EXH	EXHAUSTER (-S)	HWY	HIGHWAY	NE	NORTHEAST	PVMT	PAVEMENT	TCE	TRICHLOROETHYLENE
ACOUS	ACOUSTICAL	CLG	CEILING	EXIST., (E)	EXISTING	HYD	HYDRAULIC	NEUT	NEUTRAL	PW	PLANT WATER, POTABLE WATER	TCV	TWIN ELEMENT CHECK VALVE
ACT.	ACTIVATE	CLOS	CLOSET	EXP	EXPANSION	HZ	HERTZ	NF	NEAR FACE	PWR	POWER	TDH	TOTAL DYNAMIC HEAD
ADDL, ADDIT	ADDITIONAL	CLR	CLEAR (-ANCE)	EXP JT	EXPANSION JOINT	I & C	INSTRUMENTATION AND CONTROLS	NG	NATURAL GAS	Q	FLOW OR DISCHARGE	TEL, TELE	TELEPHONE
ADJ	ADJUST(-ED,-MENT,-ABLE)	CM 3	CUBIC CENTIMETER	EXT	EXTERIOR, EXTENSION	ID	INSIDE DIAMETER	NGVD	NATIONAL GEODETIC VERTICAL DATUM	R	RISER	TEMP	TEMPERATURE, TEMPORARY
ADJT	ADJACENT	CM 2	SQUARE CENTIMETER	EVC	END OF VERTICAL CURVE	IE	INVERT ELEVATION	NIC, N.I.C.	NOT IN CONTRACT	R, RAD	RADIUS	TERM.	TERMINAL; TERMINATION
ADWF	AVERAGE DRY WEATHER FLOW	CM	CENTIMETER	EW	EACH WAY	I.F.	INSIDE FACE	N.O., NO	NORMALLY OPEN	RC	REINFORCED CONCRETE	TEL	TELEPHONE
AF	ACRE-FEET	CMC	CEMENT MORTAR COATED	EWEF	EACH WAY EACH FACE	IN 3	CUBIC INCHES	NO.	NUMBER	RCP	REINFORCED CONCRETE PIPE	TGE	TOP OF GRATING ELEVATION
AFD	ADJUSTABLE FREQUENCY DRIVE	CML	CEMENT MORTAR LINED	E.W.S.	EYEWASH/SHOWER	IN 2	SQUARE INCHES	NOM	NOMINAL	RD	ROAD	T & G	TONGUE & GROOVE
AGG	AGGREGATE	CML&C	CEMENT MORTAR LINED & COATED	F	FUTURE	IN	INCH (-ES)	NORM	NORMAL	REC	RECEIVING	THK	THICK(-ENED, -ENER, -NESS)
AHU	AIR HANDLING UNIT	CMP	CORRUGATED METAL PIPE	*F	DEGREE FAHRENHEIT	INFL, INF	INFLUENT	NPW	NON-POTABLE WATER	RECIRC	RECIRCULAT(-E, -ION)	TOD	TOP OF CONCRETE
AIR-CON	AIR CONDITION (-ER,-ING)	CMU	CONCRETE MASONRY UNIT(-S)	FT	FEET, FOOT	INSTR	INSTRUMENT	NRS	NON-RISING STEM (VALVE)	RED.	REDUCE(-R)	TOD	TOTAL OXYGEN DEMAND
AIRVAC	AIR AND VACUUM VALVE	CNTR	COUNTER	FA	FIRE ALARM	INSUL	INSULAT(-E,-ION)	NST	NATIONAL STANDARD THREAD	REF	REFERENCE	TOS	TOP OF STEEL
AL, ALUM.	ALUMINUM	CNTRSK	COUNTERSUNK	FAB	FABRICATE(-D)	INT	INTERIOR	NT	NORMALLY THROTTLED	REFR	REFRIGERATOR	T.O.P.	TOP OF PAVEMENT
ALT	ALTERNAT(-E,-IVE)	CO	CLEANOUT	FAC	FACTORY	INV	INVERT	NTS	NOT TO SCALE	REG	REGULAT(-E, -OR, -ION, -ING)	TOPO	TOPOGRAPHY
ALTD	ALTITUDE	CO2	CARBON DIOXIDE	FACIL	FACILITY (-IES)	IPS	INTERNATIONAL PIPE STANDARD	NV	NEEDLE VALVE	REINF	REINFORC(-E, -ED, -ING, -MENT)	TOS	TOP OF STEEL; TOP OF SLAB
ANC, ANCH	ANCHOR	C.O.D.	CHEMICAL OXYGEN DEMAND	REL	FRESH AIR INTAKE	IW	INDUSTRIAL WASTES	NW	NORTHWEST	REL	RELATIVE	T.O.W.	TOP OF WALL
ANSI	AMERICAN NATIONAL STANDARD INSTITUTE	COL	COLUMN	FB	FLAT BAR	JAN	JANITOR	NWL	NORMAL WATER LEVEL	REQD	REQUIRED	T___S	TYPE ___ SUPPORT
APPROX	APPROXIMAT(-E,-LY)	COMM	COMMUNICATION	FC	FLEXIBLE COUPLING	JB, J-BOX	JUNCTION BOX	OA	OVERALL	REQT	REQUIREMENT	T___P	TYPE ___ PIPE
APWA	AMERICAN PUBLIC WORKS	COMP	COMPRESSOR	FCA	FLANGED COUPLING ADAPTER	JST	JOIST	OBD	OPOSED BLADE DAMPER	RES, RSVR	RESERVOIR	TYP	TYPICAL
	ASSOCIATION	CONC	CONCRETE	FCO	FLOOR CLEANOUT	JT	JOINT	OC	ON CENTER	RESIL	RESILIENT	TURB	TURBIDITY
ARCH.	ARCHITECT (-URAL)	COND	CONDENSATE	FCV	FLOW CONTROL VALVE	KG	KILOGRAM; KNIFE GATE	O/C	OPEN/CLOSE SERVICE	REV	REVISION	TS, T'STAT	THERMOSTAT
ARV	AIR RELEASE/RELIEF VALVE	CONN	CONNECT (-S,-ION)	FD	FLOOR DRAIN	KIP	ONE THOUSAND POUNDS	OD	OUTSIDE DIAMETER	RH	RIGHT HAND	TRTMT	TREATMENT
ASB	ASBESTOS	CONST	CONSTRUCT (-ION)	FDC	FIRE DEPARTMENT CONNECTION	Km	KILOMETER	OF	OUTSIDE FACE	RM	ROOM	TRANSV	TRANSVERSE
ASHRAE	AMERICAN SOCIETY OF HEATING, REFRIGERATING & AIR CONDITIONING ENGINEERS	CONST JT, CJ	CONSTRUCTION JOINT	FDR	FEEDER	KV	KILOVOLTS	O.F., OF	OVERFLOW	RWD	REDWOOD	T-R	THROUGH ROOF
		CONT	CONTINU (-ED,-OUS,-ATION)	FDN	FOUNDATION	KVA	KILOVOLT-AMPERES	OFF.	OFFICE	R/W	RIGHT-OF-WAY	TR	TREAD(-S)
ASPH	ASPHALT	CONTR	CONTRACTOR	FE	FIRE EXTINGUISHER	KW	KILOWATT	OFF.	OFFICE	RTN	RETURN	TP	TELEPHONE POLE
ASST	ASSISTANT	COORD	COORDINATE	FF	FAR FACE, FINISH FLOOR	L	LENGTH; LITER	OFS	OUTSIDE FACE OF STUD	RTE	ROUTE	UG	UNDERGROUND
ASTM	AMERICAN SOCIETY FOR TESTING AND MATERIALS	COR	CORNER	FG	FLAP GATE	LAB	LABORATORY	O.H.	OVERHEAD	RT	RIGHT	UGE	UNDERGROUND ELECTRIC
		CORR	CORRUGATED	FH	FIRE HYDRANT, FLAT HEAD	LAM	LAMINATE	OL	OVERLOAD	RR	RAILROAD	UH	UNIT HEATER
ATM	ATMOSPHERE (14.7 LB/IN SQ)	FIG.	FIGURE	FIG.	FIGURE	LAT	LATERAL	OPNG	OPENING	RPS	REVOLUTIONS PER SECOND	UNO	UNLESS NOTED OTHERWISE
ATS	AUTOMATIC TRANSFER SWITCH	FILT	FILTER	FIN.	FINISH(-ED)	LAV	LAVATORY	OPER	OPERATOR	RPM	REVOLUTIONS PER MINUTE	UPR	UPPER
AWG	AMERICAN WIRE GAUGE	FIN. GD	FINISH GRADE	FIN.	FINISH(-ED)	LB	POUND(-S)	OPP	OPPOSITE	RND	ROUND	V	VOLT
AWWA	AMERICAN WATER WORKS ASSOCIATION	FL	FLOW LINE	FIN. GD	FINISH GRADE	L/D	LITERS PER DAY	ORIG	ORIGINAL	OS&Y	OUTSIDE SCREW & YOKE (RISING STEM-VALVE)	VAC	VACUUM
AUX	AUXILIARY	FLASH.	FLASHING	FL	FLOW LINE	LDG	LANDING	OSHA	OCCUPATIONAL SAFETY & HEALTH ADMINISTRATION	SAN	SANITARY	VAR	VARIABLE
AVE	AVENUE	FLX	FLEXIBLE	FL	FLOW LINE	LE	LIFTING EYE	OZ	OUNCE(-S)	SARV	SEWAGE AIR RELIEF VALVE	V.A.T.	VINYL ASBESTOS TILE
AVG	AVERAGE	FLG, FL	FLANGE(-D)	FL	FLOW LINE	LEL	LOWER EXPLOSION LIMIT	P	PIPE	SAVV	SEWAGE AIR/VACUUM RELIEF VALVE	VC	VERTICAL CURVE
AVV	AIR AND VACUUM RELIEF VALVE	CT	COURT	FL	FLOW LINE	LE	LOWER EXPLOSION LIMIT	PC	PIECE	SCAV	SEWAGE COMBINATION AIR VALVE	VCP	VITRIFIED CLAY PIPE
		CTR	CENTER	FLR	FLOOR	LEL	LOWER EXPLOSION LIMIT	PC	PIECE	SCFM	STANDARD CUBIC FEET PER MINUTE	VEL	VELOCITY
BARM	BARMINUTOR	FLUOR	FLUORESCENT	FM	FLOW METER, FORCE MAIN	LF	LINEAR FEET	P.C.	POINT OF HORIZONTAL CURVE	SCHED, SCH	SCHEDULE	VERT	VERTICAL
BC	BEGINNING OF HORIZONTAL CURVE	LG	LONG	FM	FLOW METER, FORCE MAIN	LG	LONG	PCC	POINT OF COMPOUND CURVE	SD	STORM DRAIN	VERTS	VERTICAL BARS
BCV	BALL CHECK VALVE	LGT	LIGHT	FOB	FLAT ON BOTTOM	LH	LEFT HAND	PCF	POUNDS PER CUBIC FEET	SDR	STANDARD DIMENSION RATIO	VEST.	VESTIBULE
BD	BOARD	LIQ	LIQUID	FOS	FACE OF STUD	LIQ	LIQUID	PCO	PRESSURE CLEANOUT	SE	SOUTHEAST	VOL	VOLUME
BF, B.F.	BLIND FLANGE	LL	LIVE LOAD	FOT	FLAT ON TOP	LL	LIVE LOAD	PDV	PLUG DRAIN VALVE	SEC	SECOND(-S, -ARTY)	VPI	VERTICAL POINT OF INTERSECTION
BFP	BACKFLOW PREVENTER	LLV	LONG LEG VERTICAL	FRC	FLEXIBLE RUBBER COUPLING	LL	LIVE LOAD	P.E., PE	PLAIN END	SECT	SECTION(-S)	V/S, VS	VARIABLE SPEED
BFV	BUTTERFLY VALVE	FRQ	FREQUENCY	FRP	FIBERGLASS REINFORCED PLASTIC	LO	LIVE OAK	PE, POLY	POLYETHYLENE	SED	SEDIMENTATION	VT	VENT
BHP	BRAKE HORSEPOWER	LOC	LOCATION	DBL	DOUBLE	LOC	LOCATION	PERIM	PERIMETER	SEW., SEW	SEWER	VTR, V.T.R.	VENT TO ROOF
BIO	BIOFILTER	LONG.	LONGITUDINAL	DEG	DEGREE(-S)	LP	LOW POINT	PEN.	PENETRATION	SG	SLUICE GATE	W	WIDTH; WIDE; WEST
BIOL	BIOLOGICAL	LP	LOW POINT	DEMO, (D)	DEMOLISH	LP	LOW POINT	PERF	PERFORAT(-E, -ED, -ES, -ATION)	SHT, SH	SHEET	W/	WITH
BITUM	BITUMINOUS	FT 3	CUBIC FEET	DET, DTL	DETAIL(-S)	LPC	LOW PRESSURE CONDENSATE	PF	PROFILE	SI	SIDEWALK INLET	WC	WATER CLOSET
BL	BUILDING LINE	FT 2	SQUARE FEET	BLDG	BUILDING	LPG	LIQUIFIED PETROLEUM GAS (PROPANE OR BUTANE AS NOTED)	PG	PRESSURE GAUGE	SIG	SIGNAL	WC	WATER CLOSET
BLDG	BUILDING	FTG	FOOTING	BLK	BLOCK(-S)	LPS	LOW PRESSURE STEAM	PH	PIPE HANGER	SIM	SIMILAR	W CL	WATER COLUMN
BLK	BLOCK(-S)	FURN	FURNACE	BLKG	BLOCKING	LS	LIMIT SWITCH	PHMS	PAN HEAD MACHINE SCREW	SL	SLUDGE	WD	WOOD
BM	BEAM, BENCHMARK	FURR	FURRING	BM	BEAM, BENCHMARK	LT	LEFT	P.I.	POINT OF HORIZONTAL INTERSECTION	SMH	SANITARY SEWER MANHOLE	WH	WATER HEATER
B.M.	BENCH MARK	FUT, (F)	FUTURE	DIAG	DIAGONAL(-S)	LT.WT.	LIGHT WEIGHT	P & ID	PROCESS (OR PIPING) & INSTRUMENTATION	SO 2	SULFUR DIOXIDE	WM, W.M.	WATER METER
BO	BLOWOFF	FWD	FORWARD	DIAPH	DIAPHRAGM	LT	LEFT			SP	STATIC PRESSURE	W/O	WITHOUT
BOD 5	BIOCHEMICAL OXYGEN DEMAND (5 DAY)	G	GAS	DIM.	DIMENSION(-S)	LTG	LIGHTING	PIV	POST INDICATOR VALVE	SP, GR.	SPECIFIC GRAVITY	WP	WEATHERPROOF
BOS	BOTTOM OF STEEL	GAL	GALLON (-S)	D.I.P., DIP	DUCTILE IRON PIPE	LWG	LOW WATER	PIP	PLASTIC IRRIGATION PIPE	SPCD	SPACED	WS	WELDED STEEL, WATER SURFACE
BOT	BOTTOM	GASO	GASOLINE	DIR	DIRECTION	LWL	LOW WATER LEVEL	P.L., P/L	PROPERTY LINE	SPCNG	SPACING	WSDOT	WASHINGTON STATE DEPARTMENT OF TRANSPORTATION
BRG	BEARING	GALV	GALVANIZE(-D)	DISCH	DISCHARGE			PL, P	PLATE	SPCS	SPACES	WST	WATERSTOP
BS	BLACK STEEL	GC	GROOVED COUPLING	DIST	DISTRIBUTION			PLAS	PLASTER	SPEC	SPECIFICATIONS	WSS	WASHINGTON STATE STANDARD
BSMT	BASEMENT	GDL	GROUND LEVEL	DN	DOWN			PLCS	PLACES	SQ	SQUARE		WSDOT/APWA STANDARD
BTU	BRITISH THERMAL UNIT	GEN	GENERATOR	D.O.	DISSOLVED OXYGEN			PLY.	PLYWOOD	SQ FT, SF	SQUARE FEET		SPECIFICATIONS FOR ROAD, BRIDGE, AND MUNICIPAL CONSTRUCTION
BTWN	BETWEEN	GENL	GENERAL	DR	DOOR			PNL	PANEL	SQ IN	SQUARE INCHES		
BV	BALL VALVE	GL	GLASS	DRG	DOUBLE RUBBER GASKET JOINT			P.O.C.	POINT OF CONNECTION	SRG	SINGLE RUBBER GASKET JOINT	WT	WEIGHT
BVC	BEGINNING OF VERTICAL CURVE	GLV	GLOBE VALVE	DS	DOWN SPOUT			P.O.T	POINT OF TANGENCY	SS	SANITARY SEWER	WTR	WATER
B&S	BALL AND SOCKET	GLL	GLASS LINED	DUP	DUPLEX			PP	PAGES, PERSONEL PROTECTION	SS 304	STAINLESS STEEL TYPE 304	WTP	WATER TREATMENT PLANT
°C	DEGREES CELSIUS (CENTIGRADE)	GND	GROUND	DWG(S)	DRAWING(-S)			P.P.	POWER POLE	SS 316	STAINLESS STEEL TYPE 316	WW	WATER WASTE
C	CONDUIT	GPD	GALLONS PER DAY	E	ELECTRIC, EAST			PPB	PARTS PER BILLION	ST	STREET	WWF	WELDED WIRE FABRIC
CAB.	CABINET	GPH	GALLONS PER HOUR	EA	EACH			PPM	PARTS PER MILLION	STA	STATION	WWM	WELDED WIRE MESH
CAV	COMBINATION AIR VALVE	GPM	GALLONS PER MINUTE	EC	END OF HORIZONTAL CURVE			PR	PAIR	STD	STANDARD	WWTP	WASTEWATER TREATMENT PLANT
CB	CATCH BASIN	GR	GRADE, GROUND, GRAM	ECC	ECCENTRIC			P.R.	PULL RING	STIFF	STIFFEN (-ER)	YD 3	CUBIC YARD
CC	CENTER TO CENTER	GRL	GRADE, GROUND, GRAM	ECD	EPOXY COATED			PRESS.	PRESSURE	STL	STEEL	YD 2	SQUARE YARD
CCP	CONCRETE CYLINDER PIPE	GS	GALVANIZED STEEL	EF	EACH FACE; EXHAUST FAN			PRFV	PRESSURE RELIEF VALVE	STM	STEAM	YD	YARD
		GV	GATE VALVE	EFFIC	EFFICIENCY			PRI	PRIMARY	STN	STAINLESS	YR	YEAR
		GYP BD	GYPSUM BOARD									XFMR	TRANSFORMER

USE OF DOCUMENTS

THIS DOCUMENT, INCLUDING THE INCORPORATED DESIGNS, IS AN INSTRUMENT OF SERVICE FOR THIS PROJECT AND SHALL NOT BE USED FOR ANY OTHER PROJECT WITHOUT THE WRITTEN AUTHORIZATION OF KENNEDY/JENKS CONSULTANTS.

NO.

REVISION

DATE

BY

SCALES

0 1" 0 25mm

IF THIS BAR IS NOT DIMENSION SHOWN, ADJUST SCALES ACCORDINGLY.

JEFFREY M. FORNY

STATE OF WASHINGTON

REGISTERED PROFESSIONAL ENGINEER

34536

DESIGNED

JMF

DRAWN

LMM

CHECKED

MDL

CITY OF ISSAQUAH

ISSAQUAH, WASHINGTON

SOUTH SPAR BOOSTER PUMP STATION

Kennedy/Jenks Consultants

FEDERAL WAY, WASHINGTON

ABBREVIATIONS

90% SUBMITTAL (REVISED 7/1/2020)

FILE NAME

139700500-G003.DWG

JOB NO.

1397005'00

DATE

JUNE 2020

SHEET 3 OF 83

G3

8/10/2020 2:46 PM
NICOLASLOZANOORDONEZ

\\jc.local\KUC-Rodrik-Office\FW\CAD\CAD131\397005.00_City_of_Issaquah\139700500-G004.dwg

CIVIL/GENERAL SYMBOLS



FIBER OPTIC (EXISTING)	FO
FIRE PROTECTION WATER (EXISTING)	FW
SEWER (EXISTING)	SS
STORM DRAIN (EXISTING)	SD
WATER LINE (EXISTING)	W
RECLAIMED WATER (EXISTING)	RW
GAS LINE (EXISTING)	G
TELEPHONE LINE (EXISTING)	T
ELECTRICAL LINE (EXISTING)	E
OVERHEAD POWER (EXISTING)	OH
PUBLIC UTILITY DISTRICT (EXISTING)	PUD
CABLE TV (EXISTING)	CTV
CROSSING UTILITIES (EXISTING)	
FENCE	X
PROPERTY LINE	
RIGHT-OF-WAY	ROW
CONTRACTORS WORK AREA LIMITS	WA
CENTERLINE	
CULVERT WITH END SECTIONS	
HANDRAIL OR GUARDRAIL	
WATER SURFACE	
GRADE CHANGE LINE	
RIDGE LINE	
FLOW LINE	
GRADED SLOPE	TOP TOE
DITCH OR SWALE	
CONTOUR MAJOR (NEW)	110
CONTOUR MINOR (NEW)	
CONTOUR MAJOR (EXIST)	110
CONTOUR MINOR (EXIST)	

BENCH MARK	BM
SOIL BORING, IDENTIFICATION NUMBER	B-10
SOIL TEST PIT, IDENTIFICATION NUMBER	TP-10
SPOT ELEVATION	10.35
ELECTROLYSIS TEST STATION	ETS
WATER METER	WM
FIRE DEPT. CONNECTION	
FIRE HYDRANT	
UTILITY BOX (AS LABELED)	
POWER POLE	
STREET LIGHT	
STREET LIGHT AND TRAFFIC SIGNAL	
YARD LIGHT	
TRAFFIC SIGNAL	
TELEPHONE RISER	T RISER
GUY ANCHOR	
CATCH BASIN	CB
DROP INLET	DI
CLEAN OUT	CO
DRIVEWAY	
HANDICAP ACCESS RAMP	
CURVE NO.	14
SURVEY PANEL	
MONUMENT OR SURVEY POINT	
SECTION CORNER	
ELEVATION MARK (REFERENCE)	
ELEVATION MARK (DESIGN)	
FLAG NOTE	1
WATER GATE VALVE	

STRUCTURE OR PIPE (NEW)	
STRUCTURE OR PIPE	
DEMOLITION	
CONCRETE IN SECTION	
STEEL IN SECTION	
WOOD IN SECTION	
GRATING IN PLAN	
CHECKERED PLATE IN PLAN	
GRAVELED AREA IN PLAN OR SECTION	
SAND	
BRICK OR CONCRETE BLOCK IN SECTION	
GRADE	
FILL	
ASPHALT CONCRETE (IN PLAN)	
ASPHALT CONCRETE (IN SECTION)	

- NOTES:
- THIS IS A GENERALIZED LEGEND SHEET. THIS CONTRACT MAY NOT USE ALL INFORMATION SHOWN.
 - INFORMATION SHOWN MAY NOT BE ALL INCLUSIVE. SEE ALSO ABBREVIATIONS, G-3.
 - STRUCTURAL FILL OR COMPACTED FILL, WHERE CALLED OUT ON THE DRAWINGS, SHALL REFER TO MATERIAL COMPACT TO AT LEAST 95% OF ASTM D 1557 TEST METHOD.

SECTION OR DETAIL REFERENCE

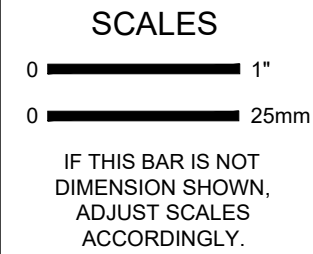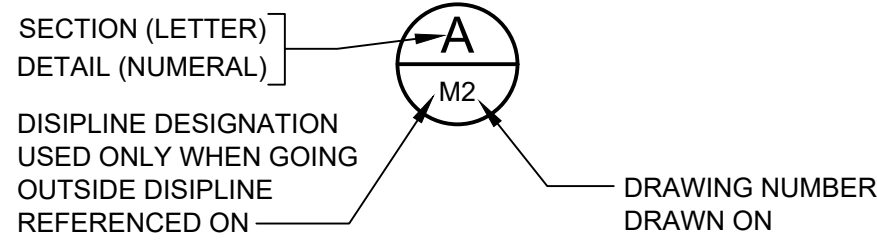

DESIGNED	JMF
DRAWN	LMM
CHECKED	MDL



CITY OF ISSAQUAH
ISSAQUAH, WASHINGTON

SOUTH SPAR BOOSTER PUMP STATION

Kennedy/Jenks Consultants
FEDERAL WAY, WASHINGTON

CIVIL GENERAL SYMBOLS AND NOTES

90% SUBMITTAL (REVISED 11/30/2020)


FILE NAME	139700500-G004.DWG
JOB NO.	1397005*00
DATE	NOVEMBER 2020
SHEET	OF
	G4

6/24/2020 10:22 AM MIKE/MARY P:\CAD\131\1397005_00_City_of_Issaquah\139700500-G005.dwg


GENERAL PIPING NOTES

- ALL PIPING, VALVES AND APPURTENANCES FOR ENTIRE PROJECT SHALL BE RESTRAINED USING APPROVED RESTRAINED-JOINT SYSTEM.
- INFORMATION PROVIDED ON THIS SHEET ARE MINIMUM REQUIREMENTS. REFER TO THE SPECIFICATIONS FOR ADDITIONAL REQUIREMENTS.
- LAY PIPE TO UNIFORM GRADE BETWEEN INDICATED ELEVATION POINTS. MINIMUM COVER SHALL BE 3'-0" UNLESS OTHERWISE SHOWN.
- SIZE OF FITTINGS SHOWN ON DRAWINGS SHALL CORRESPOND TO ADJACENT STRAIGHT RUN OF PIPE, UNLESS OTHERWISE INDICATED. TYPE OF JOINT AND FITTING MATERIAL SHALL BE THE SAME AS SHOWN FOR ADJACENT STRAIGHT RUN OF PIPE.
- NUMBER OF PIPE HANGERS AND PIPE SUPPORTS SHOWN IS ONLY APPROXIMATE. FINAL SUPPORT REQUIREMENTS SHALL BE DETERMINED IN THE FIELD AND APPROVED BY THE ENGINEER PRIOR TO INSTALLATION. MAXIMUM SPACING SHALL BE SPECIFIED.
- APPROPRIATE STANDARD WALL PIPE DETAIL SHALL BE USED WHEREVER PIPING PASSES FROM A STRUCTURE TO BACKFILL.
- ALL FLEXIBLE CONNECTORS OR FLANGED COUPLING ADAPTERS SHALL BE PROVIDED WITH THRUST TIES, BLOCKS, OR ANCHORS, UNLESS OTHERWISE NOTED. THRUST PROTECTION SHALL BE ADEQUATE FOR TEST PRESSURES SPECIFIED.
- SYMBOLS, LEGENDS, AND PIPE IDENTIFICATIONS SHOWN SHALL BE FOLLOWED THROUGHOUT THE DRAWINGS. ALL OF THE ITEMS SHOWN ARE NOT NECESSARILY USED IN THE PROJECT.
- ALL PIPING WITH UNRESTRAINED JOINTS, SHALL BE PROVIDED WITH THRUST PROTECTION AT ALL DIRECTION CHANGES, UNLESS OTHERWISE NOTED. SEE THRUST DETAILS AND NOTES ON DRAWINGS.
- NUMBER AND LOCATION OF UNIONS SHOWN ON DRAWINGS ARE ONLY APPROXIMATE. PROVIDE ALL UNIONS NECESSARY TO FACILITATE CONVENIENT REMOVAL OF VALVES AND MECHANICAL EQUIPMENT.
- THE CONTRACTOR IS RESPONSIBLE FOR COORDINATING AND PERFORMING THE CONNECTION OF THE PIPING AND ASSOCIATED APPURTENANCES INSTALLED UNDER THIS CONTRACT TO THE EXISTING PIPING AND FACILITIES, AND TO THE WORK OF OTHER CONTRACTORS.
- PRIOR TO SUBMITTING PIPING DRAWINGS FOR ANY NEW PIPE THAT IS TO CONNECT TO AN EXISTING PIPE OR STRUCTURE, THE CONTRACTOR SHALL EXPOSE THE EXISTING PIPE, PIPE CROSSINGS OR STRUCTURE TO VERIFY ITS EXACT LOCATION, SIZE, MATERIALS, AND INVERT ELEVATIONS.
- ALL EXPOSED PIPING IS TO BE PAINTED AND LABELED UNLESS NOTED OTHERWISE. LABELING SHALL INCLUDE FLOW DIRECTION ARROW AND PIPE USE.
- ALL PIPING UNDER STRUCTURES TO BE CONCRETE ENCASED UNLESS NOTED OTHERWISE.


PIPING DESIGNATION

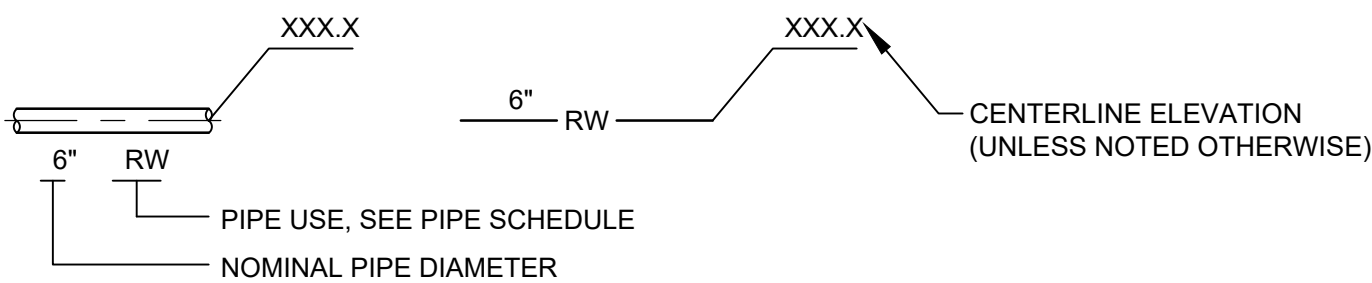

VALVE DESIGNATION

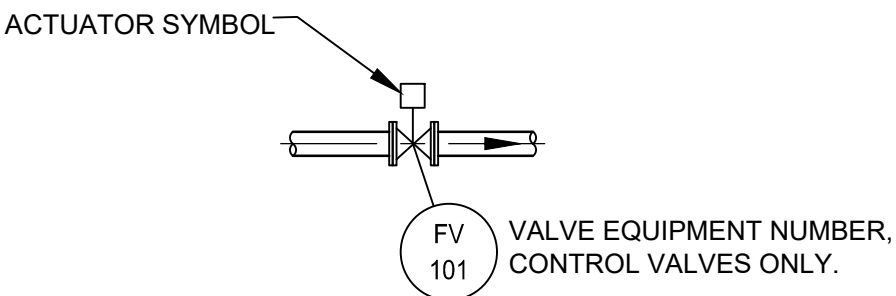

PIPE SUPPORT DESIGNATION

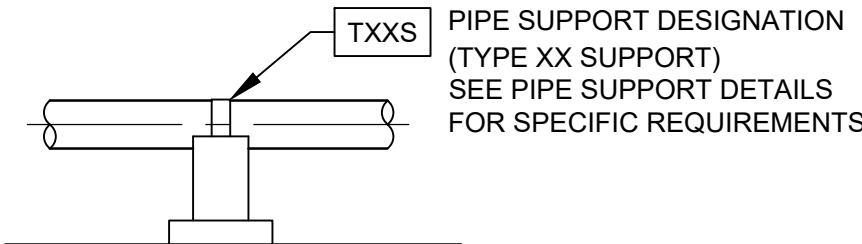

PIPE SYMBOLS

DESCRIPTION	SINGLE LINE	DOUBLE LINE
EXISTING PIPE		
NEW PIPE		
PIPE TO BE REMOVED		
FLANGED, WELD NECK		
FLANGED, SLIP ON		
SCREWED OR SOCKET WELD		
BELL & SPIGOT		
MECHANICAL JOINT		
ELBOW - STRAIGHT		
ELBOW - REDUCING		
ELBOW - DOWN		
ELBOW - UP		
CROSS		
REDUCER		
TEE		
TEE - DOWN		
TEE - UP		
UNION		
FLEXIBLE RUBBER CONNECTOR		
FLEXIBLE HOSE CONNECTOR		
FLANGED COUPLING ADAPTER		
FLEXIBLE COUPLING		
DISASSEMBLING JOINT		
FLOOR DRAIN		
CLEAN OUT		

ACTUATOR SYMBOLS

MOTOR	
SOLENOID	
PNEUMATIC	

VALVE SYMBOLS

DESCRIPTION	SINGLE LINE	DOUBLE LINE
GATE VALVE		
GLOBE VALVE		
PLUG VALVE		
SWING CHECK VALVE		
BUTTERFLY (FLANGED)		
BUTTERFLY (WAFER)		
BALL VALVE		
DIAPHRAGM VALVE		
CAPILLARY CONTROL VALVE		
CONTROL VALVE (ELEVATION)		
CONTROL VALVE (PLAN)		
PRESSURE RELIEF VALVE (ELEVATION)		
PRESSURE RELIEF VALVE (PLAN)		
HOSE BIBB		

PIPE SCHEDULE

LINE	SYSTEM	SIZE	SERVICE	FLOW	PIPE TYPE	MAT'L	VALVE SYSTEM	TEST PRESSURE	TEST MEDIUM	ALLOWABLE LEAKAGE	TEST DURATION	NOTES
CA	COMPRESSED AIR	ALL	E	P	BS	BS	I	SEE NOTES	A	NONE	4 HRS	5
D	DRAIN (FLOOR)	≤ 4	B/C	G	CISP	CISP	-		W	NONE	1 HR	6
		≥ 4	B	G	HDPE	HDPE	-		W	NONE	1 HR	2, 6
OF	OVERFLOW	ALL	B	P	HDPE	HDPE	-		W	NONE	4 HRS	2
PW	POTABLE WATER	<4	B/E	P	CUP	CU	E	150	W	NONE	4 HRS	
		≥ 4	B	P	DIPB	DI	A	SEE NOTES	W	SEE NOTES	4 HRS	1, 3, 4
			B	P	HDPE	HDPE	A	SEE NOTES	W	NONE	4 HRS	1
		≥ 4	E	P	DIPF	DI	A		W	NONE	4 HRS	

STA	PIPELINE			
	297/520 ZONE		724 ZONE	
	WORKING PRESSURE	DR	WORKING PRESSURE	DR
PIPELINE A - 1ST AVE NE TO PUMP STATION				
6+40	100	21		
11+70	80	26		
19+80	63	26	275	7
24+99	63	26	275	7
PIPELINE B - ACCESS ROAD TO NE DISCOVERY DR				
1+00			275	7
16+08			250	9
60+00			200	11
67+00			160	13.5

PIPE TYPE LEGEND

SERVICE
B BURIED
C CONCRETE ENCASED
E EXPOSED
S SUBMERGED

FLOW
P PRESSURE
G GRAVITY
V VENT

SIZE
NOMINAL DIAMETER IN INCHES

PIPE TYPE, MATERIAL AND VALVE SYSTEM SEE SPECIFICATIONS UNLESS OTHERWISE NOTED

PIPE SCHEDULE NOTES

- PROVIDE DUCTILE IRON UNLESS NOTED ON DRAWINGS. HDPE WATER MAIN TO BE PROVIDED WHERE INDICATED.
- PROVIDE DR 32.5 FOR OVERFLOW AND DRAIN LINES.
- ALLOWABLE LEAKAGE PER AWWA C600.
- SEE TABLE FOR WORKING PRESSURE AND MINIMUM DR. TEST AT 1.5 TIMES WORKING PRESSURE.
- COMPRESSED AIR SYSTEM IS 250 PSI WITH 150 PSI SERVICE TO SUCTION SIDE HYDROPNEUMATIC TANK. TEST AT 1.5 TIMES WORKING PRESSURE.
- TEST PER PLUMBING CODE.

FLOWMETER SYMBOLS

DESCRIPTION	SINGLE LINE	DOUBLE LINE
MAGMETER		
TURBINE METER		
VENTURI METER		

CONDUIT USAGE SCHEDULE

CIRCUIT TYPE	INSIDE BUILDINGS		OUTSIDE BUILDINGS		TRANSITION
	STANDARD	EMBEDDED IN CONCRETE	EXPOSED	BURIED IN SOIL	WITHIN 5 FEET OF BUILDING
LOW VOLTAGE POWER, 120 VAC CONTROL, SIGNAL, FIBER	GRS	PVC-80	PVC COATED GRS	HDPE-80	PVC COATED GRS
MEDIUM VOLTAGE POWER (PSE)	N/A	N/A	DB120	DB120	N/A

USE OF DOCUMENTS

THIS DOCUMENT, INCLUDING THE INCORPORATED DESIGNS, IS AN INSTRUMENT OF SERVICE FOR THIS PROJECT AND SHALL NOT BE USED FOR ANY OTHER PROJECT WITHOUT THE WRITTEN AUTHORIZATION OF KENNEDY/JENKS CONSULTANTS.

NO.	REVISION	DATE	BY
-----	----------	------	----

SCALES
0 1"
0 25mm
IF THIS BAR IS NOT DIMENSION SHOWN, ADJUST SCALES ACCORDINGLY.



DESIGNED	JMF
DRAWN	LMM
CHECKED	LMM





CITY OF ISSAQUAH
ISSAQUAH, WASHINGTON
SOUTH SPAR BOOSTER PUMP STATION

Kennedy/Jenks Consultants
FEDERAL WAY, WASHINGTON

PIPING SYMBOLS, NOTES, AND SCHEDULE



90% SUBMITTAL (REVISED 7/1/2020)

FILE NAME	139700500-G005.DWG
JOB NO.	1397005*00
DATE	JUNE 2020
SHEET	5 OF 83
	G5

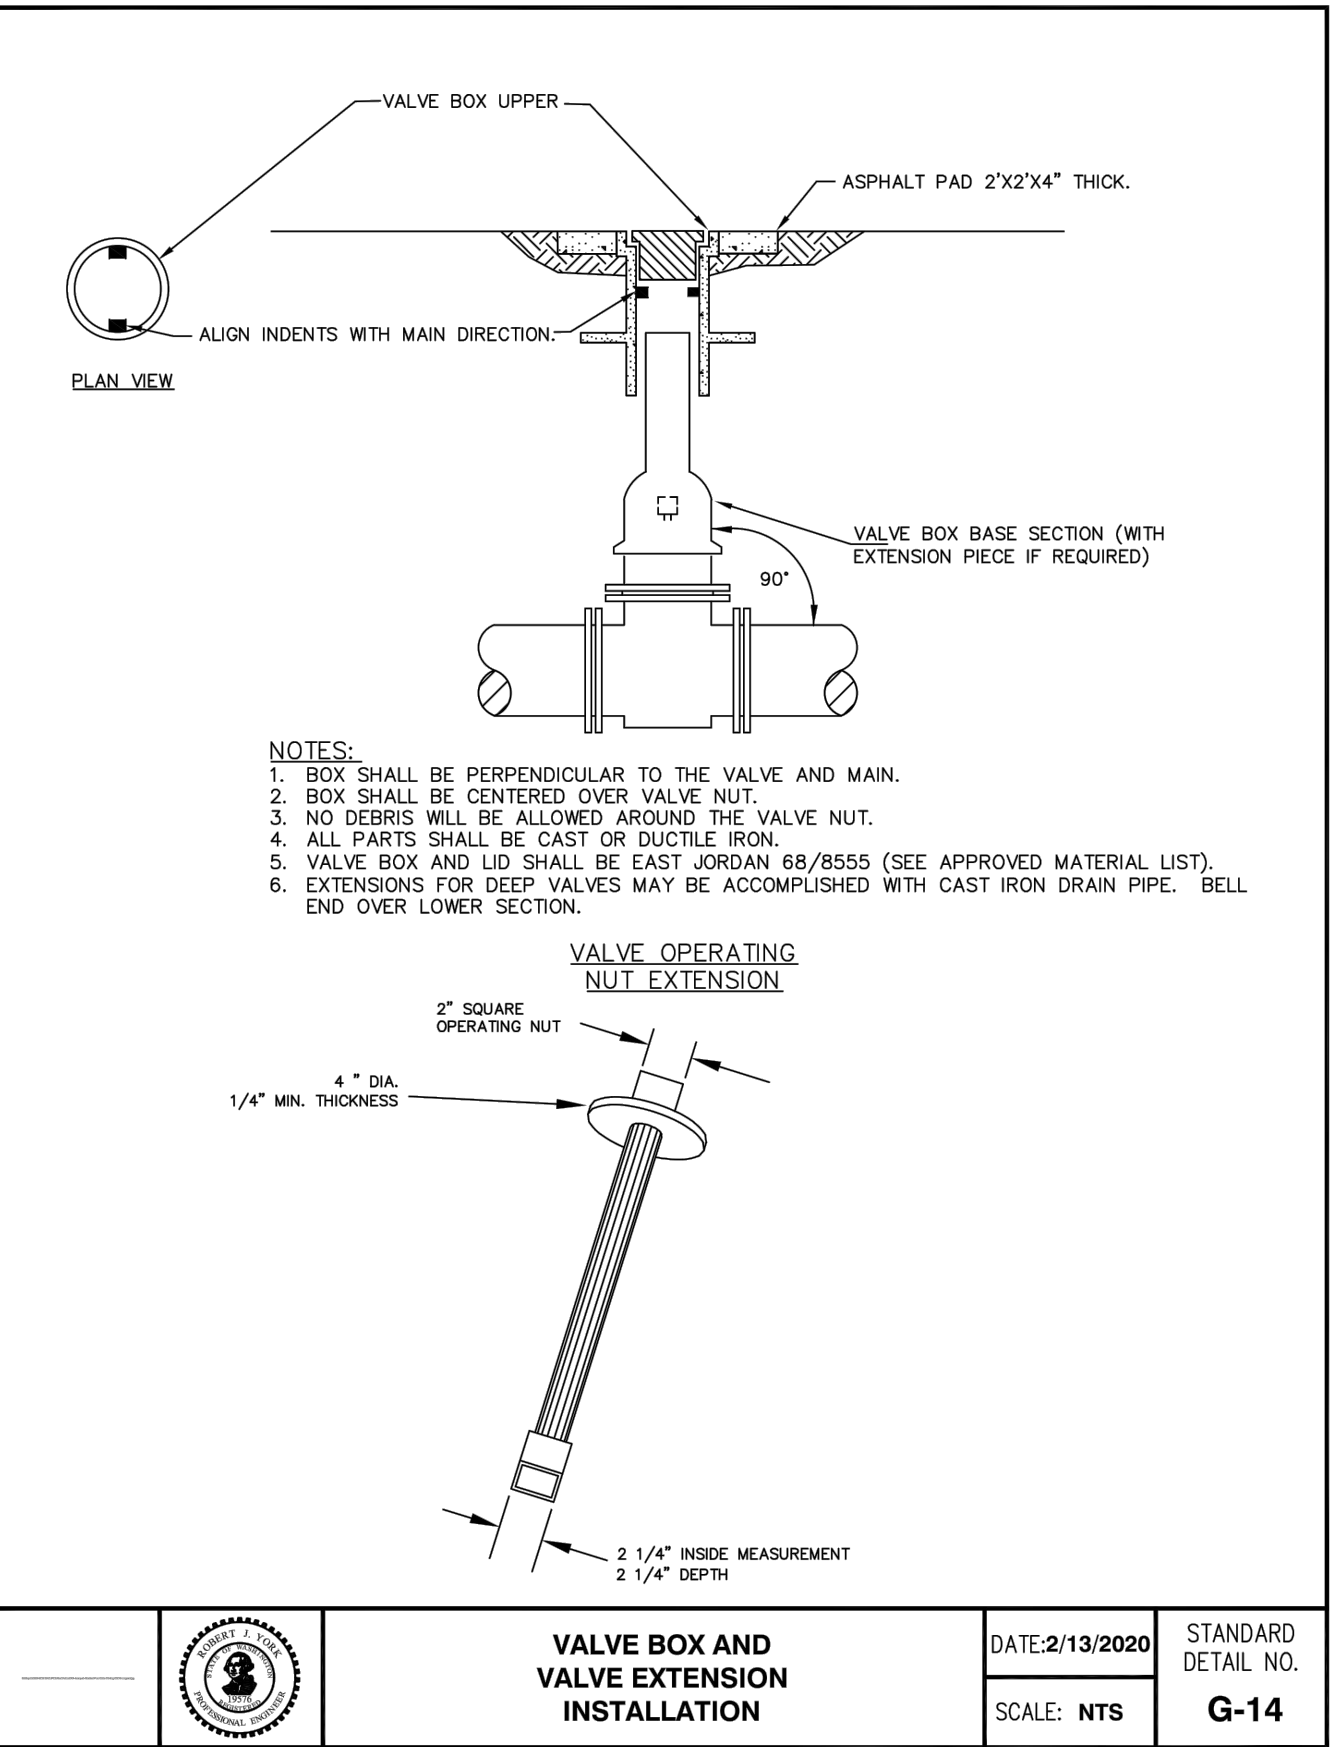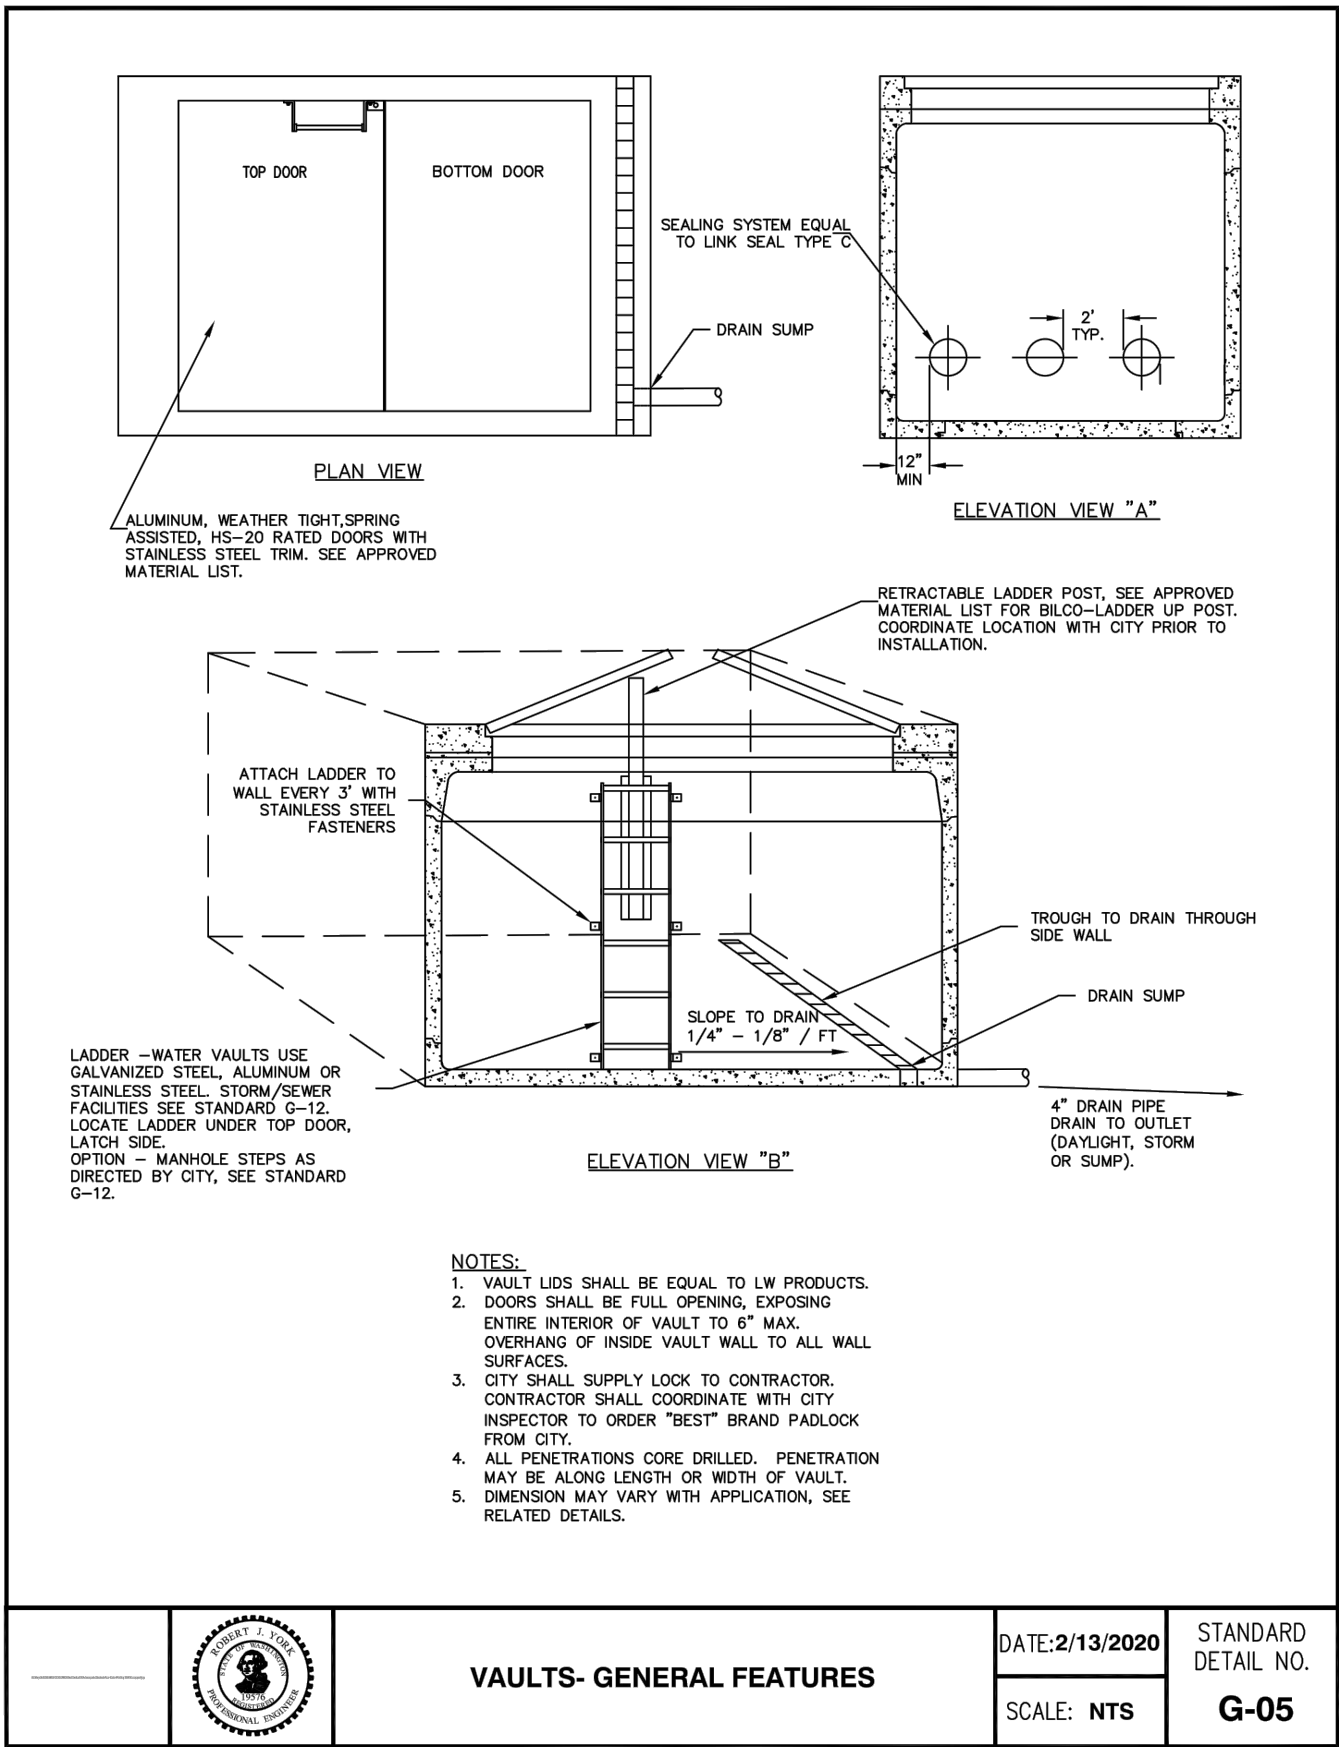

NOTES:

1. NOTE FOR DETAIL G-05: DO NOT PAINT VAULT FLOOR. PAINT WALLS AS FOLLOWS - CLEAN, SCUFF-SAND AND PREPARE PAINT PER PAINT MANUFACTURERS SPECIFICATION. PRIME WITH ONE COAT (6 MILS) OF SHERWIN WILLIAMS PRO-CRYL ACRYLIC PRIMER (B66 W 310 C43-22681) AND THEN TOP COAT WITH ONE COAT (6 MILS) OF SHERWIN WILLIAMS CRYL-HPA HIGH PERFORMANCE ACRYLIC GLOSS HIGH GLOSS BRIGHT WHITE (B66 W 377 6405-18908).

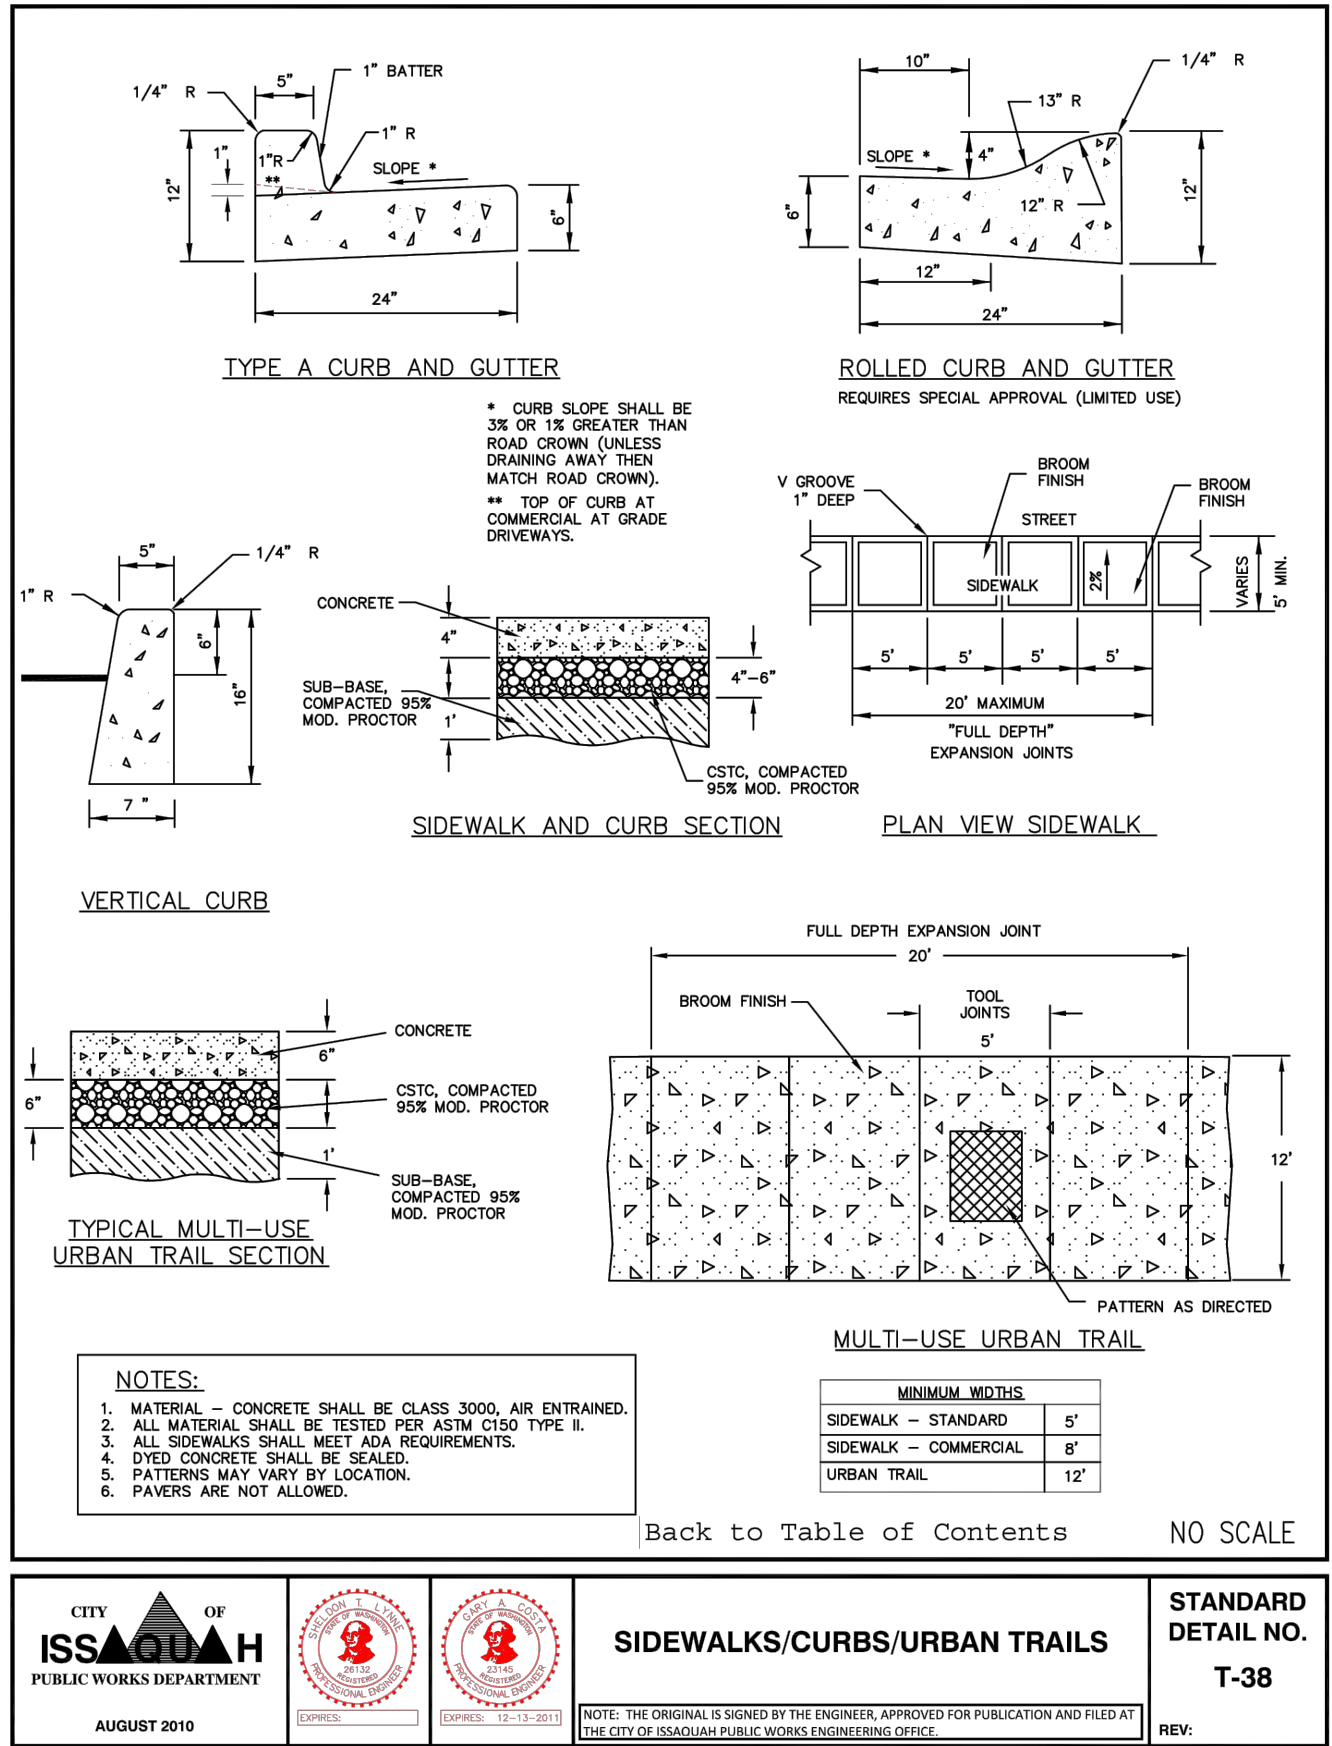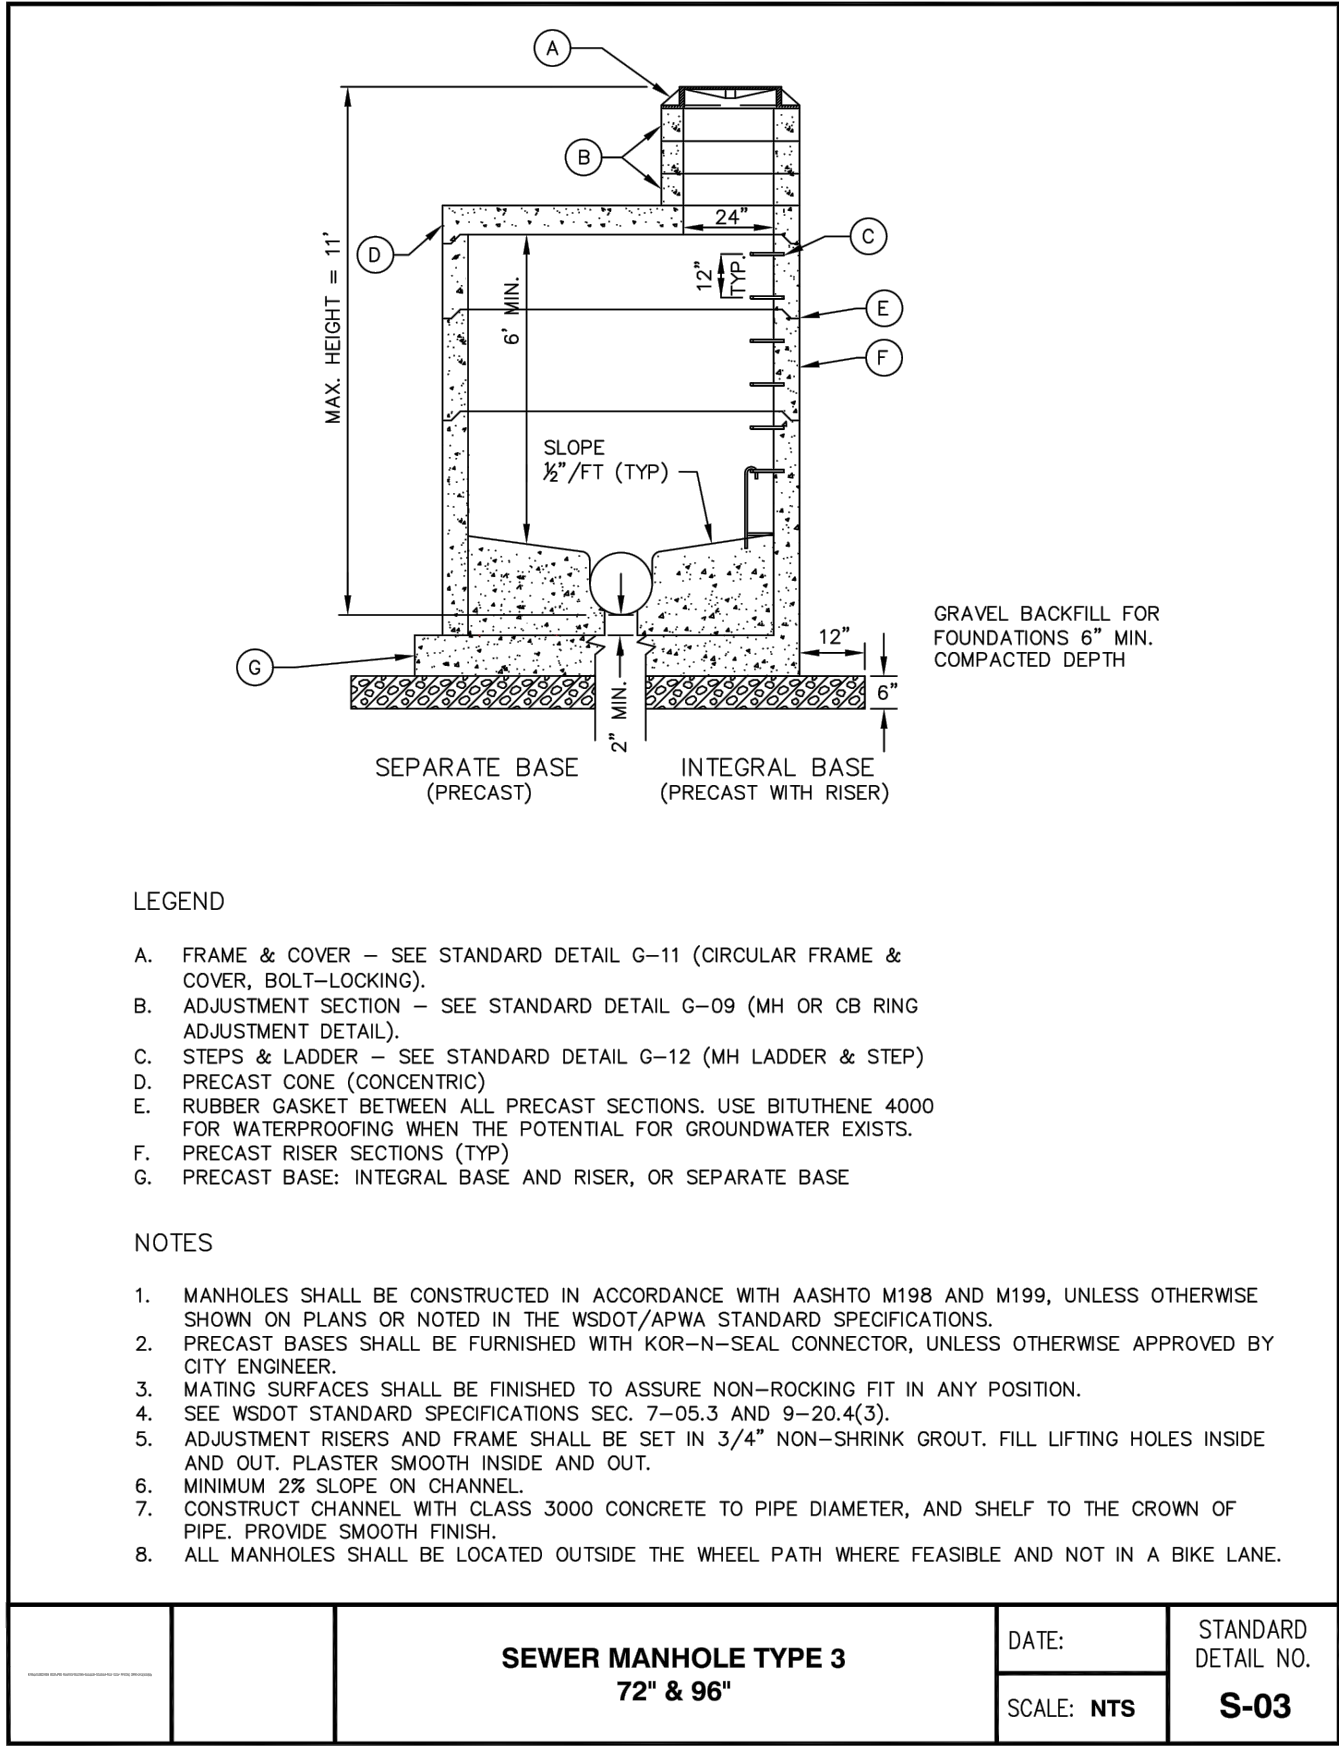

USE OF DOCUMENTS

THIS DOCUMENT, INCLUDING THE INCORPORATED DESIGNS, IS AN INSTRUMENT OF SERVICE FOR THIS PROJECT AND SHALL NOT BE USED FOR ANY OTHER PROJECT WITHOUT THE WRITTEN AUTHORIZATION OF KENNEDY/JENKS CONSULTANTS.

NO.	REVISION	DATE	BY

SCALES

0 1" 25mm

IF THIS BAR IS NOT DIMENSION SHOWN, ADJUST SCALES ACCORDINGLY.



DESIGNED	JMF
DRAWN	LMM
CHECKED	MDL



CITY OF ISSAQUAH

ISSAQUAH, WASHINGTON

SOUTH SPAR BOOSTER PUMP STATION

Kennedy/Jenks Consultants

FEDERAL WAY, WASHINGTON


CITY STANDARD DETAILS

90% SUBMITTAL (REVISED 11/30/2020)

FILE NAME	139700500-G006.DWG
JOB NO.	1397005'00
DATE	NOVEMBER 2020
SHEET	OF
G6	

JONILUND 11/30/2020 10:11 AM

F:\K-Cad\FederalWay\CAD\131397005_00_City_of_Issaquah\139700500-G007.dwg

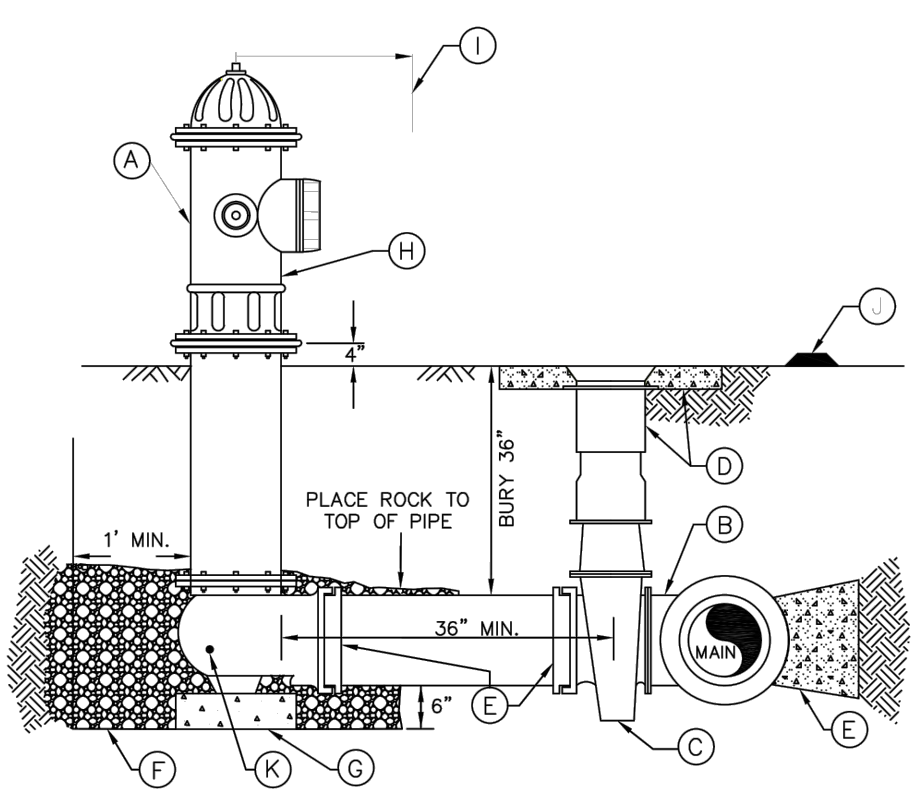

LEGEND:

A. AWK 275M-A2906-0A2J2-GD, MUELLER 423-540627 OR EAST JORDAN 714390. NOTE: THE PART NUMBERS SPECIFIED ARE FOR A 4' BURY DEPTH. PART NUMBERS WILL CHANGE WITH DIFFERENT HYDRANT BURY DEPTHS. PUMPER PORT TO FACE STREET OR AS DIRECTED BY THE FIRE DEPARTMENT.

B. FLANGE OUTLET ON DUCTILE IRON TEE OR SEE STANDARD DETAIL W-08 (TAPPING TEES).

C. 1-AUXILIARY GATE VALVE-AWK SERIES 45 RESILIENT SEAT GATE VALVE WITH STAINLESS STEM AND DIRT SEAL, MUELLER A2362 RESILIENT SEAT GATE VALVE WITH STAINLESS STEM AND DIRT SEAL OR EAST JORDAN FLOWMASTER RESILIENT SEAT GATE VALVE WITH STAINLESS STEM AND DIRT SEAL, ALL W/FL. WITH LUGS. DO NOT MIX PARTS BETWEEN AWK, MUELLER OR EAST JORDAN. SEE APPROVED MATERIAL LIST.

D. 1-TWO PIECE CAST IRON VALVE BOX. SEE STANDARD DETAIL W-21 (VALVE BOX INSTALLATION).

E. 1-6" DUCTILE IRON CLASS 52 CEMENT-LINED PIPE, LENGTH UP TO 50'. OVER 50', 8" CLASS 52 DUCTILE IRON IS REQUIRED. RESTRAIN PIPE WITH APPROVED SYSTEM - SEE APPROVED MATERIAL LIST OR STANDARD DETAIL W-01 (TYPICAL HORIZONTAL CONCRETE BLOCKING).

F. 1/2 YARD WASHED DRAIN ROCK (3/4"), PLACE TO TOP OF PIPE. PLACE GEO FABRIC AROUND TOP AND SIDES OF GRAVEL, DO NOT BLOCK DRAIN HOLES. DEEPER EXCAVATION WITH MORE DRAIN ROCK MAY BE REQUIRED IN POOR DRAINING SOILS.

G. 16"x6"x4" MINIMUM SIZE CONCRETE BLOCK UNDER HYDRANT.

H. FOOTAGE TO VALVE STENCILED ON HYDRANT IN 2" BLACK BLOCK ENAMEL NUMBERS TO THE NEAREST FOOT. LETTERS SHALL FACE HYDRANT VALVE.

I. MINIMUM 3' CLEAR LEVEL AREA AROUND HYDRANT.

J. TWO WAY 4" SQUARE RAISED PAVEMENT MARKER BLUE. PLACE 4" OFF STREET CENTERLINE - HYDRANT SIDE.

K. DRAIN HOLE.

NOTES:


1. HYDRANTS AND VALVES SHALL BE FROM THE SAME MANUFACTURER.


2. HYDRANT SHALL BE VERTICAL (FLUMB).

3. EXTENSION KITS ARE NOT ALLOWED.

4. HYDRANT WILL COME FACTORY WHITE FURNISHED WITH 5" STORZ CONNECTION. NO REPAIRS. ALLOW 6-8 WEEKS LEAD TIME FROM THE FACTORY.

5. TORQUE ALL BOLTS TO MANUFACTURE SPECIFICATIONS.


	FIRE HYDRANT ASSEMBLY	DATE: 2/13/2020	STANDARD DETAIL NO.
		SCALE: NTS	W-02

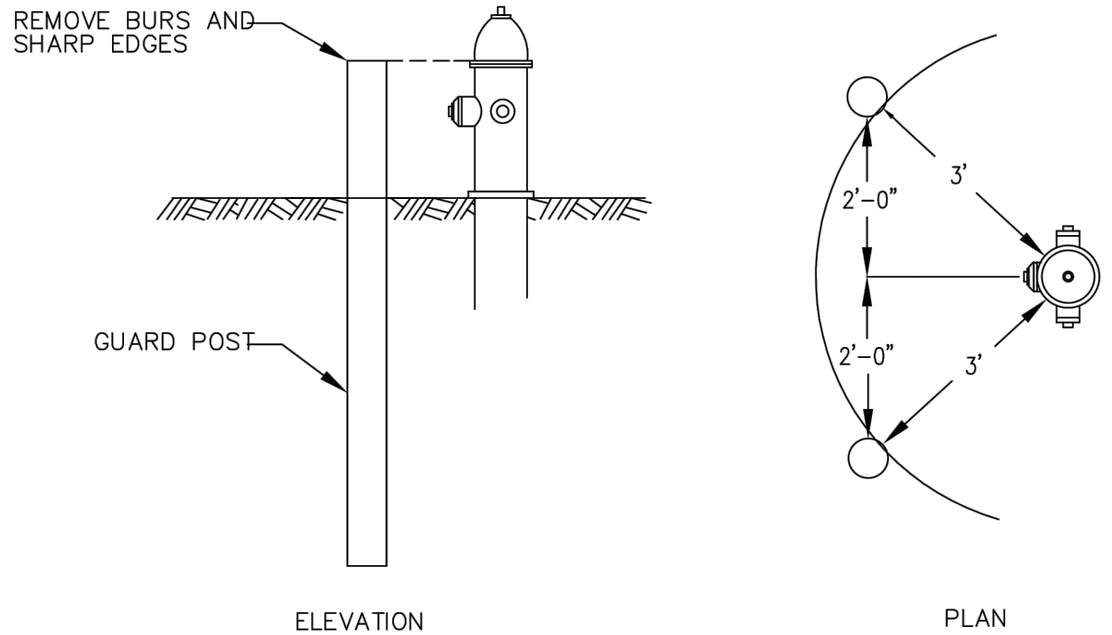


NOTES:

1. GUARD POST SHALL BE 6" CLASS 52 D.I. PIPE, 6' LONG, FILLED WITH CEMENT. PAINT ALL GUARD POST(S) WHITE PER SHERWIN WILLIAMS RECOMMENDATIONS. GUARD POST MUST BE CLEANED, SCUFFED SANDED AND PREPARED PER PAINT MANUFACTURE SPECIFICATION. PRIME WITH 1 COAT (6 MILLS) OF SHERWIN WILLIAMS PRO-CRYL ACRYLIC PRIMER (B66 W 310 643-22681) AND THEN TOP COAT WITH 1 COAT (6 MILLS) SHERWIN WILLIAMS CRYL-HPA HIGH PERFORMANCE ACRYLIC GLOSS (B66 W 377 6405-18908) HIGH GLOSS BRIGHT WHITE.

2. D.I. GUARD POSTS SHALL ONLY BE USED IN PARKING LOTS, OR AS DIRECTED.

	GUARD POST	DATE: 2/13/2020	STANDARD DETAIL NO.
		SCALE: NTS	W-03

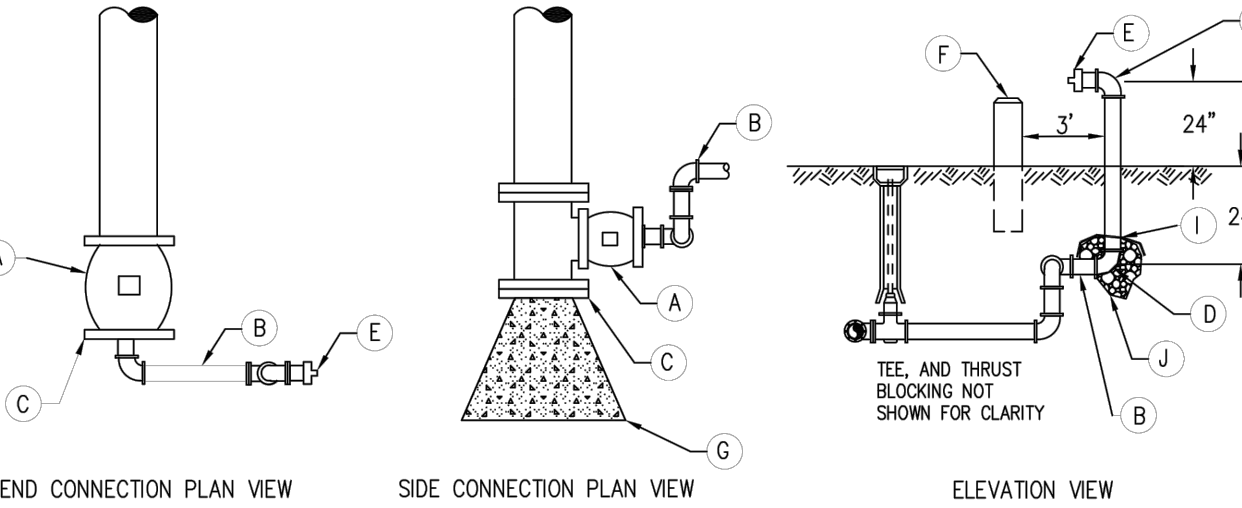

LEGEND:

A. CAST IRON GATE VALVE, MAIN SIZE x BLOW-OFF SIZE TEE (SEE APPROVED MATERIAL LIST).

B. BRASS OR DUCTILE IRON PIPE.

C. BLIND FLANGE OR M.I. PLUG x SIZED BLOW-OFF PIPE.

D. 90° ELBOW WITH 3/4" DRAIN HOLE.

E. INSTALL BRASS, 4" FEMALE SEATTLE STANDARD THREAD X 2 1/2" MALE NATIONAL STANDARD THREAD FITTING. INSTALL 2 1/2" CAP NST.

F. GUARD POSTS WHEN REQUIRED.

G. PROVIDE RESTRAINED JOINTS.

H. PAINT ALL ABOVE-GROUND PIPE, FITTINGS AND GUARD POST(S) WHITE PER SHERWIN WILLIAMS RECOMMENDATIONS. BLOW-OFF ASSEMBLY MUST BE CLEANED, SCUFFED SANDED AND PREPARED PER PAINT MANUFACTURE SPECIFICATION. PRIME WITH 1 COAT (6 MILLS) OF SHERWIN WILLIAMS PRO-CRYL ACRYLIC PRIMER (B66 W 310 643-22681) AND THEN TOP COAT WITH 1 COAT (6 MILLS) SHERWIN WILLIAMS CRYL-HPA HIGH PERFORMANCE ACRYLIC GLOSS (B66 W 377 6405-18908) HIGH GLOSS BRIGHT WHITE.

I. PROVIDE GEO-FABRIC AROUND TOP AND SIDES OF ROCK. DO NOT BLOCK DRAIN HOLE.

J. PLACE 1/2 YARD OF 3/4" WASHED ROCK AROUND DRAIN HOLE. DEEPER EXCAVATION WITH MORE DRAIN ROCK MAY BE REQUIRED IN POOR DRAINING SOILS.

NOTES:

1. SEE STANDARD DETAIL W-21 (VALVE BOX INSTALLATION).

2. LOCATION OF BLOW-OFF TO BE DETERMINED BY CITY.

3. 2" BLOW-OFF SHALL BE INSTALLED ON ALL FUTURE STUBS.


4. TORQUE ALL BOLTS TO MANUFACTURE SPECIFICATIONS.

5. STENCIL FOOTAGE TO VALVE ON DISCHARGE PIPE. 2" BLACK BLOCK ENAMEL NUMBERS.

6. HYDRANT ASSEMBLIES MAY BE SUBSTITUTED FOR BLOW-OFF ASSEMBLIES. SEE STANDARD DETAIL W-02 (FIRE HYDRANT ASSEMBLY).


7. VALVE SHALL BE LOCATED AT LEAST 3' FROM GUARD POST OR STAND PIPE.

8. ALL JOINTS AND FITTINGS SHALL USE RESTRAINED JOINT SYSTEMS. SEE APPROVED MATERIAL LIST.

	BLOW-OFF ASSEMBLY	DATE: 2/13/2020	STANDARD DETAIL NO.
		SCALE: NTS	W-04

NOTES:

- NOTE FOR DETAILS W-04: CLEAN, SCUFF-SAND AND PREPARE PAINT PER PAINT MANUFACTURERS SPECIFICATION. PRIME WITH ONE COAT (6 MILS) OF SHERWIN WILLIAMS PRO-CRYL ACRYLIC PRIMER (B66 W 310 C43-22681) AND THEN TOP COAT WITH ONE COAT (6 MILS) OF SHERWIN WILLIAMS CRYL-HPA HIGH PERFORMANCE ACRYLIC GLOSS HIGH GLOSS BRIGHT WHITE (B66 W 377 6405-18908)
- NOTE FOR DETAIL W-04, ITEM E: INSTALL BRASS, 4-INCH FEMALE SEATTLE STANDARD THREAD X 2 1/2-INCH MALE NATIONAL STANDARD THREAD FITTING, INSTALL 2 1/2-INCH CAP NST.

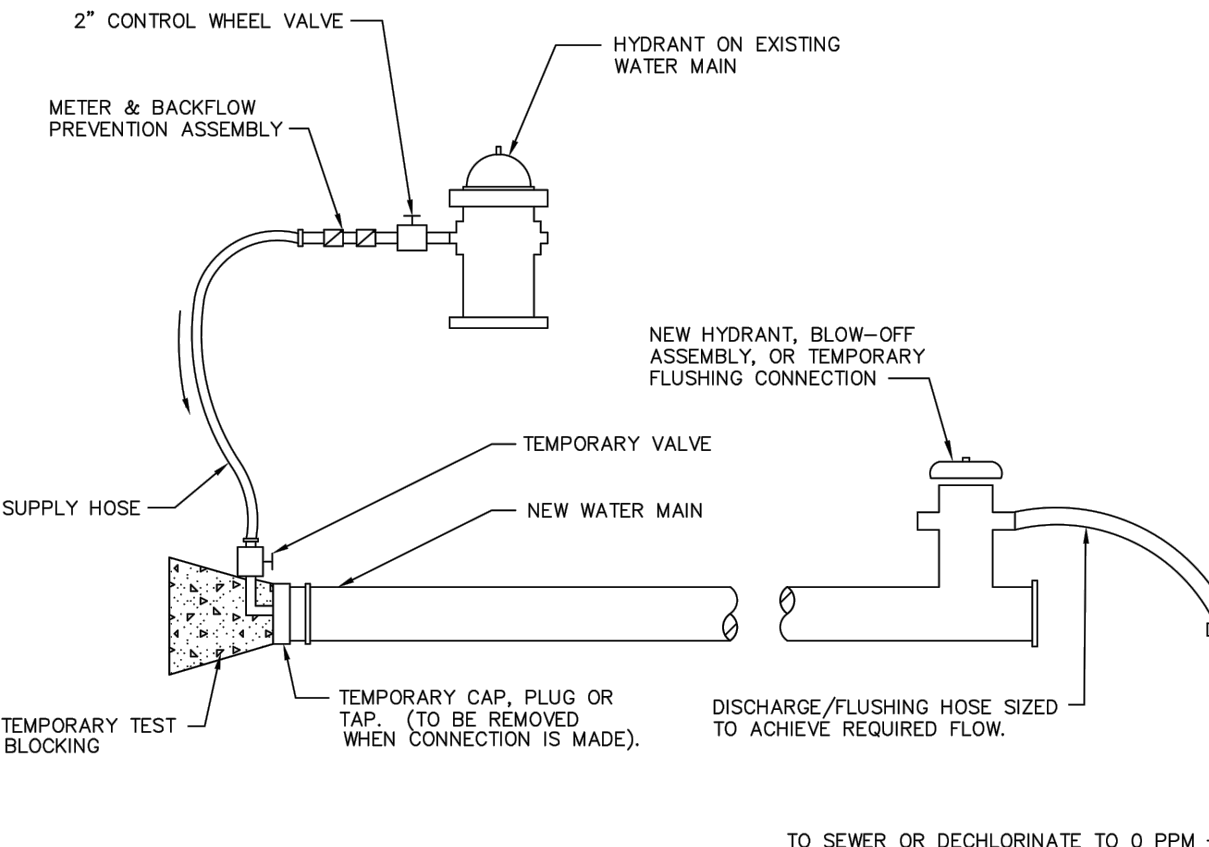

NOTES:

1. AN APPROVED BACKFLOW PREVENTION ASSEMBLY SHALL BE INSTALLED BETWEEN THE EXISTING AND NEW WATER MAIN DURING DISINFECTION AND FLUSHING OF NEW WATER MAIN. (OBTAINED FROM ISSAQUAH PUBLIC WORKS OPERATIONS).

2. THE BACKFLOW PREVENTION ASSEMBLY AND SUPPLY HOSE MUST BE DISCONNECTED DURING HYDROSTATIC PRESSURE TESTING OF THE NEW MAIN.


3. THE NEW WATER MAIN SHALL BE CONNECTED TO THE EXISTING SYSTEM ONLY AFTER NEW MAIN IS PRESSURE TESTED, FLUSHED, DISINFECTED AND SATISFACTORY BACTERIOLOGICAL SAMPLE RESULTS ARE OBTAINED.


4. FOR DISINFECTION PROCEDURES SEE TECHNICAL SPECIFICATIONS.

5. AFTER CHLORINE IS FLUSHED AND MAIN CONNECTION IS MADE, THE NEW MAIN SHALL BE FLUSHED AT A VELOCITY OF 5 FPS. DISCHARGE SHALL BE SCREENED TO COLLECT ROCKS. FLUSHING DURATION SHALL ENSURE AT LEAST 3 CHANGES OF WATER IN THE NEW MAIN.

6. IF FLOW OR DISCHARGE LIMITATIONS PREVENT ACHIEVING 5 FPS, THEN THE PIPE SHALL BE PIGGED.

7. PROVIDE DECHLORINATION DURING FLUSHING WHERE NECESSARY.

	FILLING AND FLUSHING NEW WATER MAINS	DATE: 2/13/2020	STANDARD DETAIL NO.
		SCALE: NTS	W-05

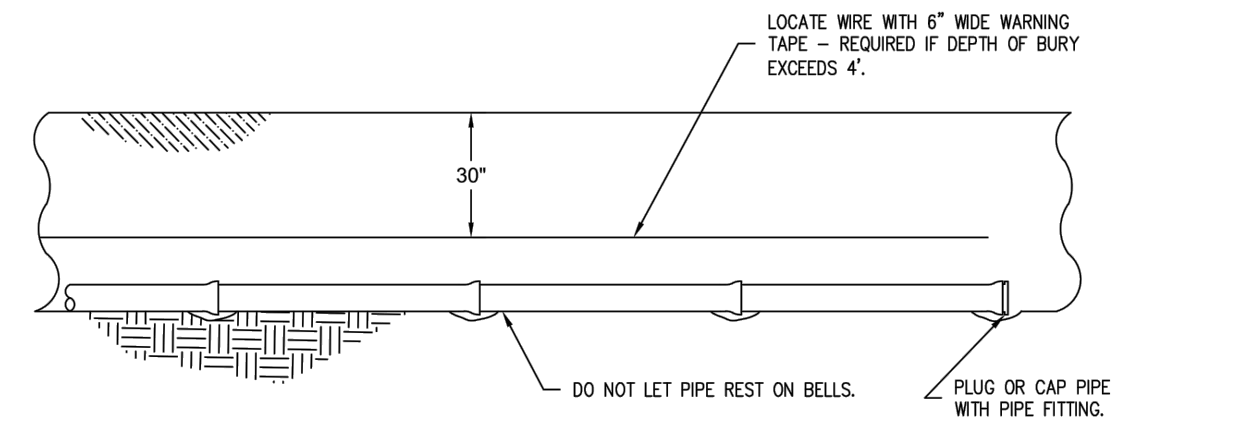

*** ALL JOINTS & CONNECTIONS SHALL BE MECHANICALLY RESTRAINED. SEE APPROVED MATERIAL LIST.**

NOTES:

1. LAY PIPE WITH BELLS UPGRADE.

2. PREPARE TRENCH SO PIPE IS SUPPORTED FULL-LENGTH.

3. PLUG OR CAP PIPE WHENEVER NOT ACTIVELY WORKING ON PIPE SECTION. USE M.J. OR TYTON JOINT PLUG OR CAP. BOARDS, BUCKETS, ETC. ARE NOT ALLOWED.

4. PIPE THAT IS ROLLED OFF A TRUCK OR TRAILER, OR IS DROPPED OR OTHERWISE MISHANDLED WILL BE REJECTED.

5. CUT ENDS SHALL BE BEVELED PER MANUFACTURER SPECIFICATIONS PRIOR TO ASSEMBLY.

6. GASKETS SHALL BE LUBRICATED WITH APPROVED AWWA C11/A21.11-07 SEC. 4.5.4 LUBRICANT.

7. THE NEW WATER MAIN SHALL BE CONNECTED TO THE EXISTING SYSTEM ONLY AFTER NEW MAIN IS PRESSURE TESTED, DISINFECTED, FLUSHED AND SATISFACTORY BACTERIOLOGICAL SAMPLE RESULTS ARE OBTAINED.

8. NEW MAINS SHALL BE FLUSHED AT A MINIMUM VELOCITY OF 5 FPS.

9. PIPES LESS THEN 20' OR LENGTHS APPROVED BY CITY ENGINEER MAY BE SWABBED WITH 500 PPM CHLORINE SOLUTION. CARE SHALL BE TAKEN NOT TO GET CHLORINE ON THE OUTSIDE OF THE PIPE OR FITTINGS.


10. EXTREME CARE SHALL BE TAKEN TO PREVENT WATER AND/OR DEBRIS FROM ENTERING PIPE.


11. A TORQUE WRENCH SHALL BE USED TO PROPERLY TIGHTEN BOLTS AND NUTS TO MANUFACTURER SPECIFICATIONS.

12. JOINT ASSEMBLY SHALL BE INSTALLED PER MANUFACTURER SPECIFICATIONS.

13. PIPE LAYING OPERATIONS VIOLATING ANY SECTION OF THIS DETAIL SHALL BE IMMEDIATELY SUSPENDED UNTIL THE CITY HAS BEEN SATISFIED OF THE CONTRACTORS ABILITY TO MEET THESE REQUIREMENTS.

14. MAINTAIN 18" CLEAR ZONE AROUND WATER MAIN AND OTHER UTILITIES.

	PIPE LAYING DETAIL	DATE: 2/13/2020	STANDARD DETAIL NO.
		SCALE: NTS	W-06

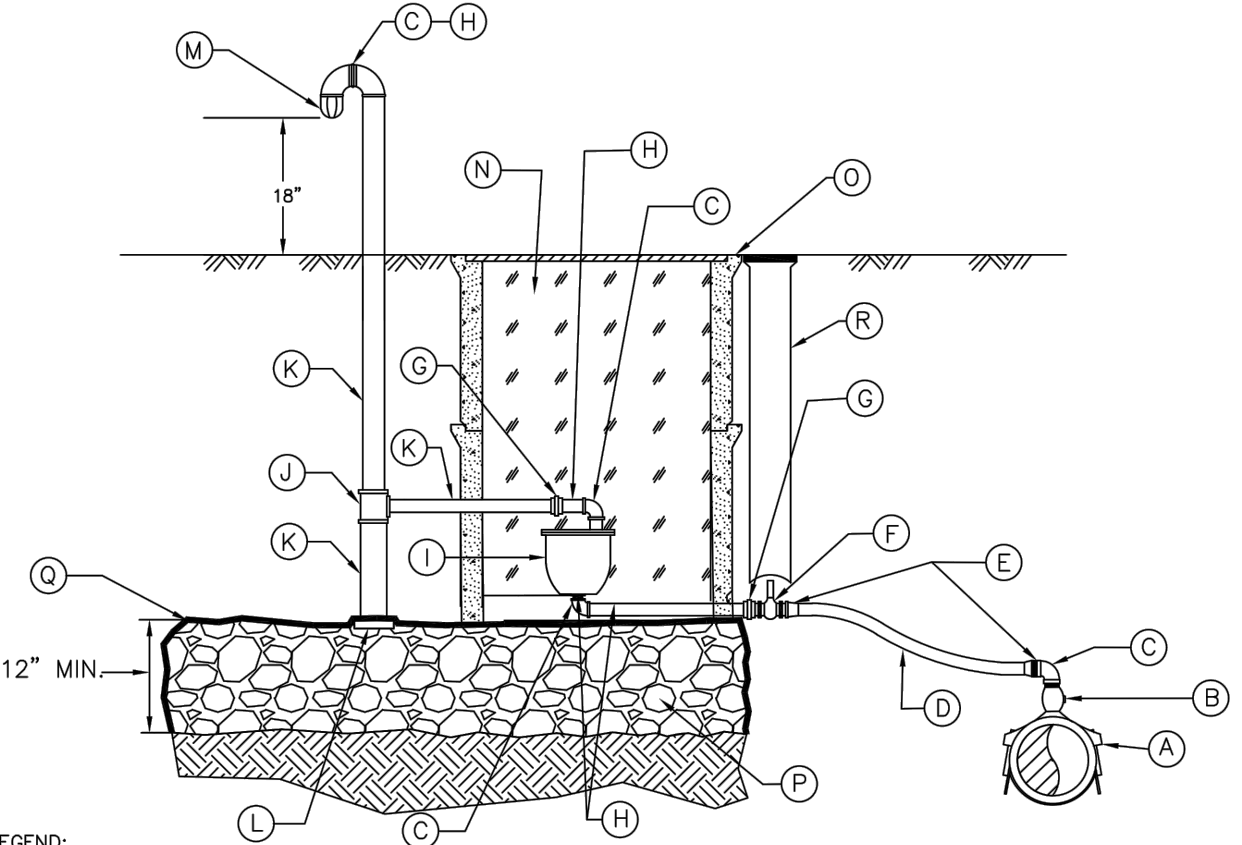

LEGEND:

A. ROMAC TAPPING SADDLE. SEE STANDARD DETAIL W-09 OR W-10 FOR PARTS.

B. MUELLER OR FORD BALL CORPORATION STOP, MALE CO. THREAD INLET BY MALE IRON PIPE OUTLET.

C. 90° BRASS ELBOW FEMALE IRON PIPE BY FEMALE IRON PIPE THREADS.

D. TYPE K SOFT COPPER WITH NO JOINTS. MAINTAIN POSITIVE SLOPE TO AIR VACUUM ASSEMBLY.

E. COUPLING COPPER TO MALE IRON PIPE THREADS: MUELLER 110 COMPRESSION OR FORD QUICK JOINTS, NO PACK JOINTS ALLOWED.

F. CURB STOP: FORD OR MUELLER (SEE STANDARD DETAIL W-09 OR W-10 FOR PARTS).

G. BRASS UNION, FEMALE IRON PIPE BY FEMALE IRON PIPE.

H. NIPPLES: BRASS, MALE IRON PIPE BY MALE IRON PIPE THREADS, LENGTHS VARY.

I. AIR & VACUUM VALVE ASSEMBLY. SEE APPROVED MATERIAL LIST.

J. BRASS TEE, IRON PIPE THREADS.

K. BRASS PIPE, MALE IRON PIPE THREADS.

L. BRASS CAP WITH 1/2" DRILLED HOLE. PLACE BELOW PLASTIC SHEET.

M. BRASS BEEHIVE STRAINER.

N. CEDAR SHAVINGS.

O. METER BOX (2 SECTIONS REQUIRED) DFWB400NF4-525-4MA2 FOR 1" AND SMALLER VALVES. VAULT REQUIRED FOR 1-1/2" AND LARGER VALVES. SEE STANDARD DETAIL G-05 (VAULTS-GENERAL FEATURES).

P. 3/4" WASHED ROCK.

Q. GEO FABRIC- ENCLOSE WASHED ROCK ON TOP AND ALL SIDES.

R. STANDARD VALVE BOX SEE STANDARD DETAIL W-21 (VALVE BOX INSTALLATION).

NOTES:

1. ALL PIPE AND FITTINGS TO BE BRASS, DUCTILE IRON OR COPPER.


2. PIPE ABOVE GROUND TO BE PAINTED AIR VACUUM ASSEMBLY MUST BE CLEANED, SCUFFED SANDED AND PREPARED PER PAINT MANUFACTURE SPECIFICATION. PRIME WITH 1 COAT (6 MILLS) OF SHERWIN WILLIAMS PRO-CRYL ACRYLIC PRIMER (B66 W 310 643-22681) AND THEN TOP COAT WITH 1 COAT (6 MILLS) SHERWIN WILLIAMS CRYL-HPA HIGH PERFORMANCE ACRYLIC GLOSS (B66 W 377 6405-18908) HIGH GLOSS BRIGHT WHITE.

3. AIR & VACUUM RELEASE VALVE ASSEMBLY TAP MUST BE INSTALLED AT HIGHEST POINT OF WATER MAIN.

4. LOCATE AIR & VACUUM METER BOX OUTSIDE OF TRAFFIC AREAS, BEHIND CURB OR SIDEWALK.

5. REQUIRED SIZE SHALL BE DESIGNED BY THE ENGINEER.

6. GUARD POST(S) MAY BE REQUIRED PER CITY'S DIRECTION.

	AIR VACUUM RELEASE VALVE ASSEMBLY	DATE: 2/13/2020	STANDARD DETAIL NO.
		SCALE: NTS	W-07

USE OF DOCUMENTS

THIS DOCUMENT, INCLUDING THE INCORPORATED DESIGNS, IS AN INSTRUMENT OF SERVICE FOR THIS PROJECT AND SHALL NOT BE USED FOR ANY OTHER PROJECT WITHOUT THE WRITTEN AUTHORIZATION OF KENNEDY/JENKS CONSULTANTS.

NO.	REVISION	DATE	BY

SCALES

0 1"

0 25mm

IF THIS BAR IS NOT DIMENSION SHOWN, ADJUST SCALES ACCORDINGLY.



DESIGNED

JMF

DRAWN

LMM

CHECKED

MDL



CITY OF ISSAQUAH
ISSAQUAH, WASHINGTON
SOUTH SPAR BOOSTER PUMP STATION

Kennedy/Jenks Consultants
FEDERAL WAY, WASHINGTON

CITY STANDARD DETAILS

90% SUBMITTAL (REVISED 11/30/2020)


FILE NAME	139700500-G007.DWG
JOB NO.	1397005*00
DATE	NOVEMBER 2020
SHEET	OF
G7	

12/10/2020 5:09 PM


NICOLASLOZANCORDONEZ

W:\local\JC-Roth\K-Office\FW\VCAD\CAD131\397005_00_City_of_Issaquah\139700500-G008.dwg

W:\local\JC-Roth\K-Office\FW\VCAD\CAD131\397005_00_City_of_Issaquah\139700500-G008.dwg

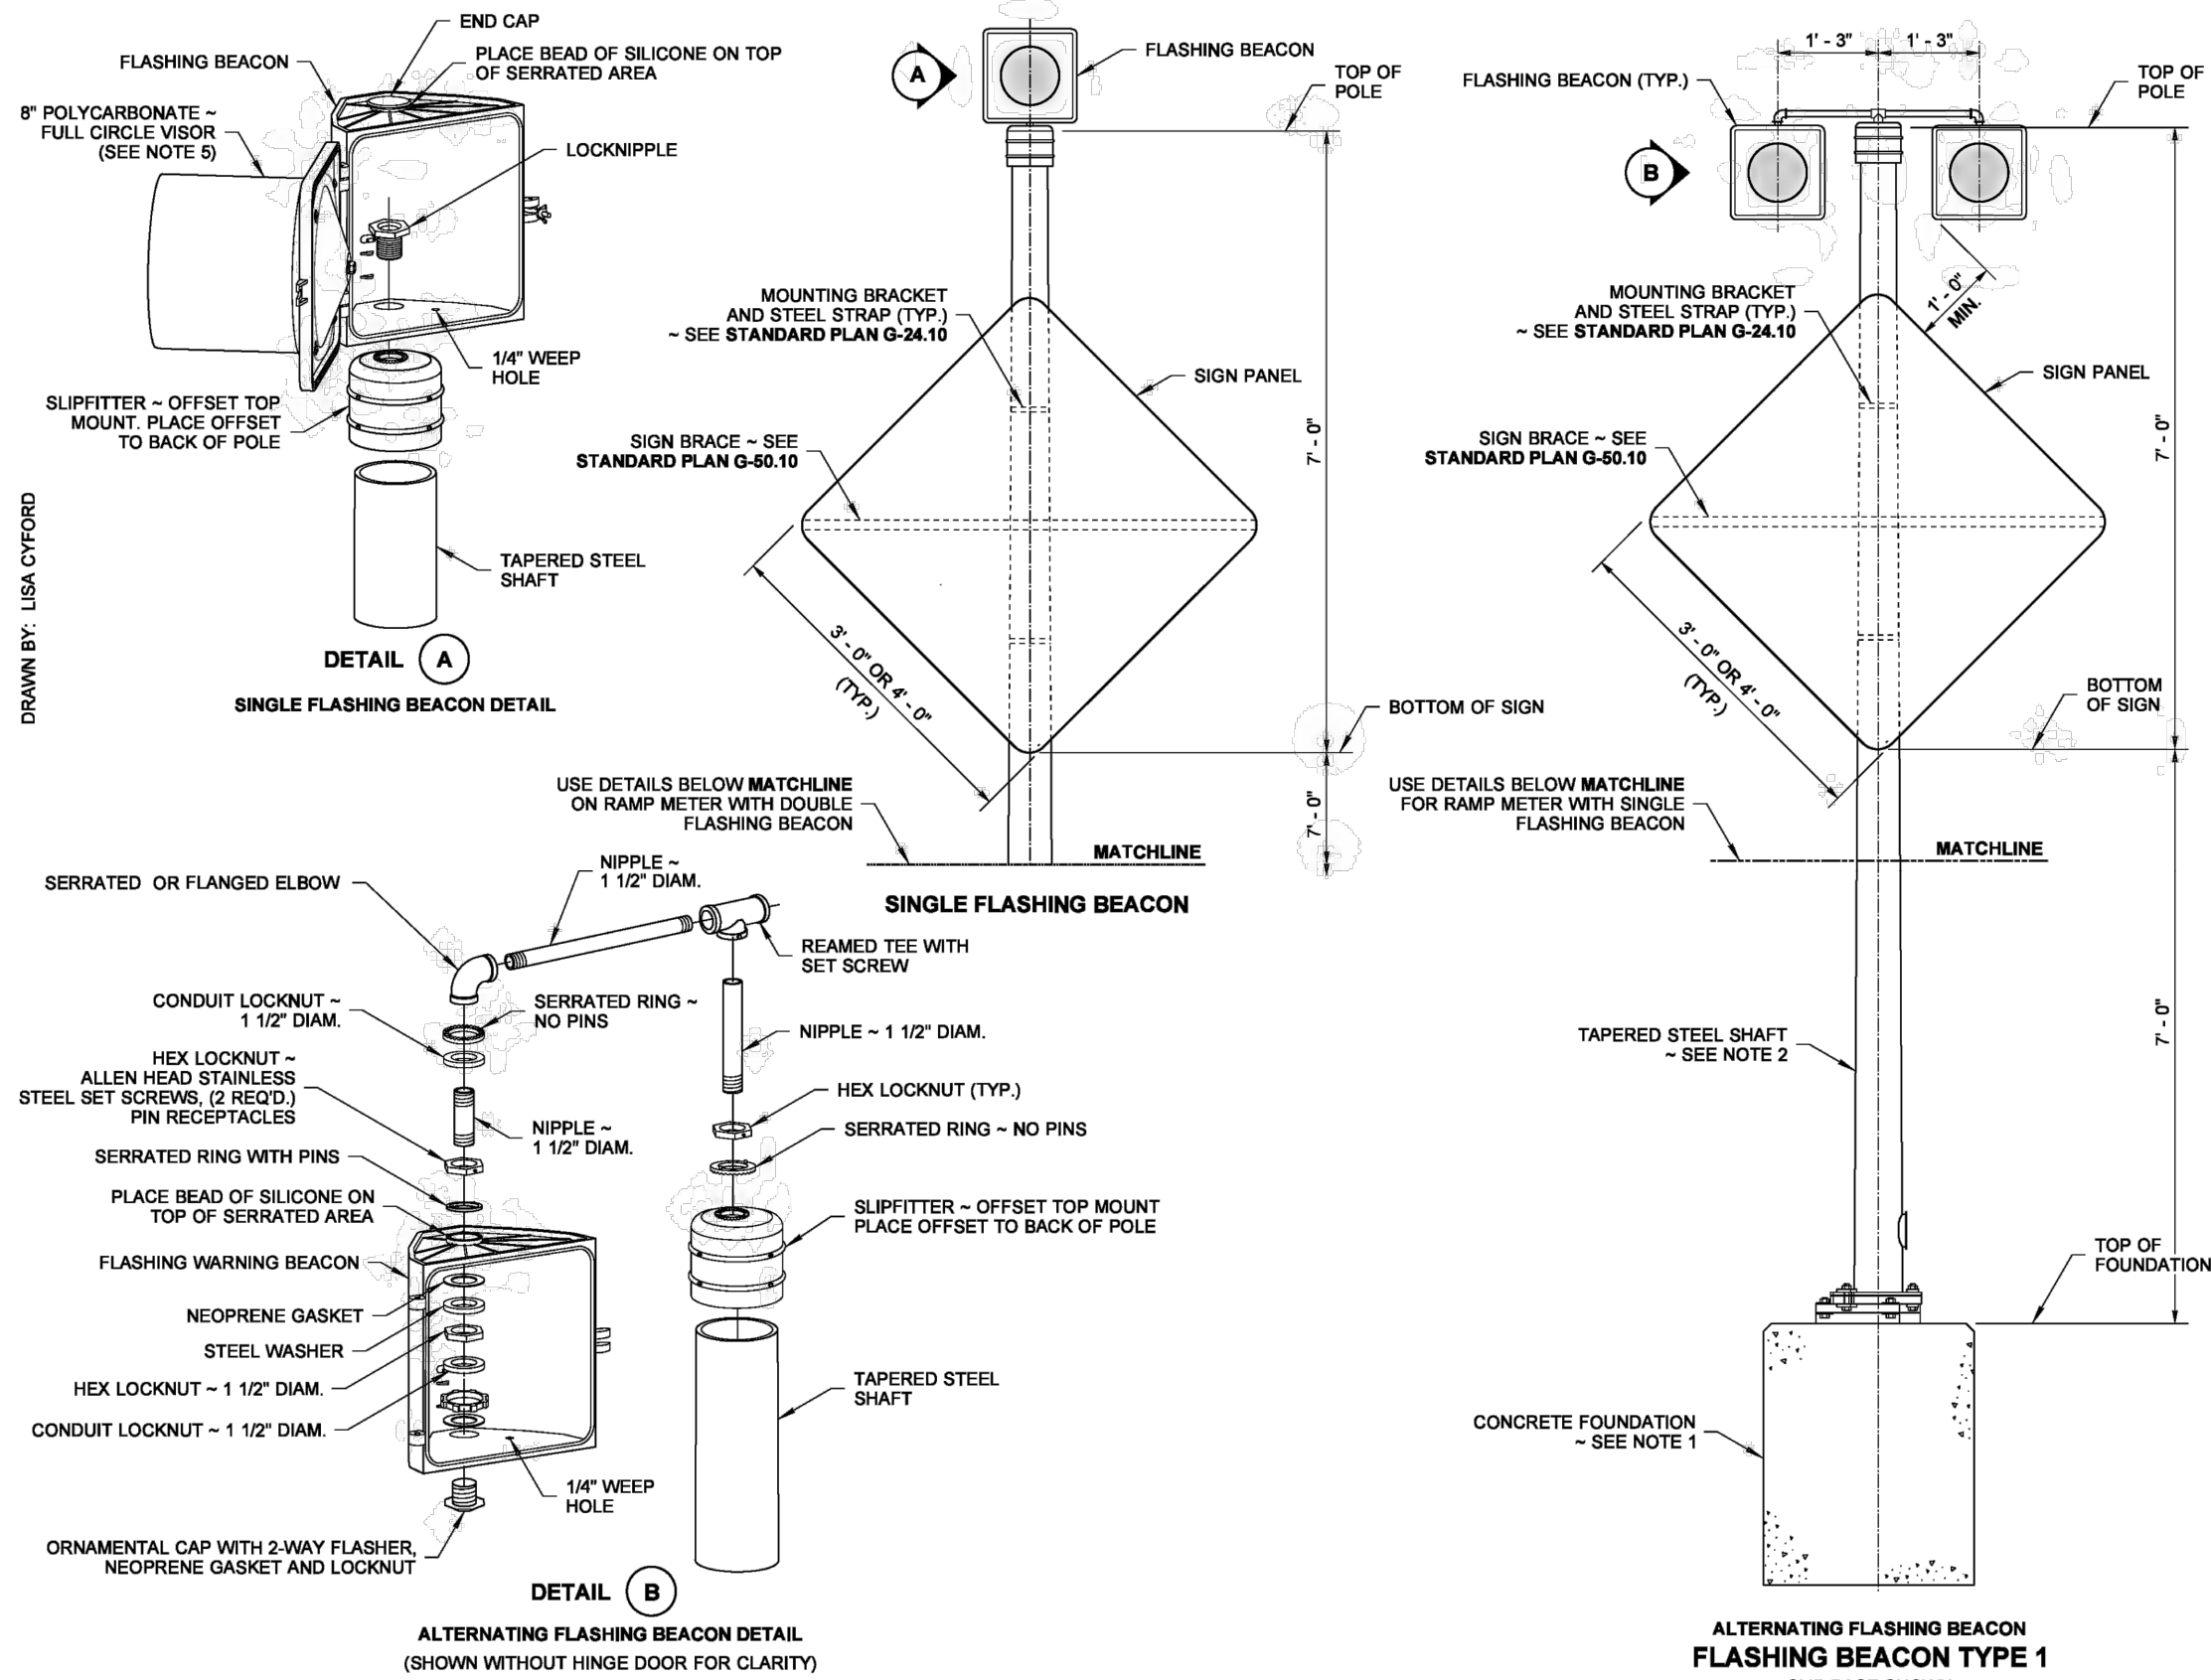


- NOTES**
1. See **Standard Plan J-21.10** for Signal Standard Foundation details.
 2. All poles shall be hot dip galvanized per AASHTO M111.
 3. Welding of structures shall be in accordance with the latest edition of the AWS D1.1 Structural Welding Code - Steel. All butt welds shall be ground flush with base metal.
 4. Visor shall be 8" Polycarbonate, fully enclosed circle at bottom to reduce glare on sign. Display shall be of appropriate color needed.
 5. See **Standard Plan J-21.17** for Electrical details.
 6. Junction Box serving the Standard shall preferably be located 5' - 0" (10' - 0" Max.) from the Standard.

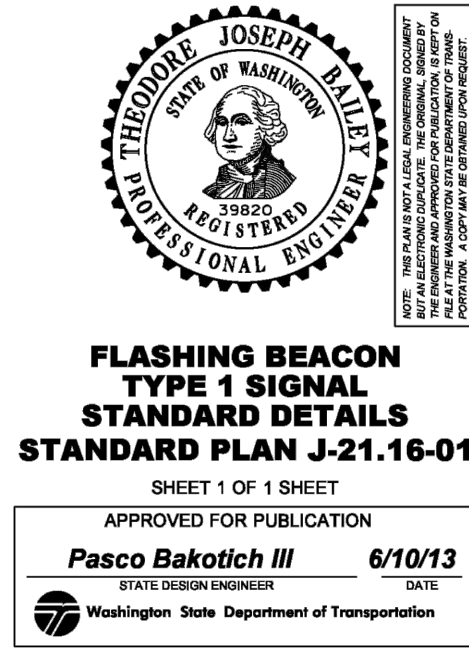


**FLASHING BEACON
TYPE 1 SIGNAL
STANDARD DETAILS
STANDARD PLAN J-21.16-01**
SHEET 1 OF 1 SHEET
APPROVED FOR PUBLICATION
Pasco Bakotich III 6/10/13
STATE DESIGN ENGINEER DATE
Washington State Department of Transportation

WSDOT STANDARD DETAIL J-21.16-01

- NOTES**
1. See **Standard Specification 9-29.3** for Cable Conductor requirements.
 2. See **Standard Plan J-21.16** for Flashing Beacon Type 1 Signal Standard details.
 3. Supplemental Grounding Conductor shall be non-insulated #4 AWG stranded copper, provide 3' - 0" min. slack. Clamp to vertical steel reinforcing bar with listed connector suitable for use embedded in concrete.
 4. See **Standard Plan J-21.10** for foundation requirements.
 5. Provide Cable Tie at wiring entering the Junction Box (for Slip Base installations only) - See **Detail A**, **Standard Plan J-28.70**.

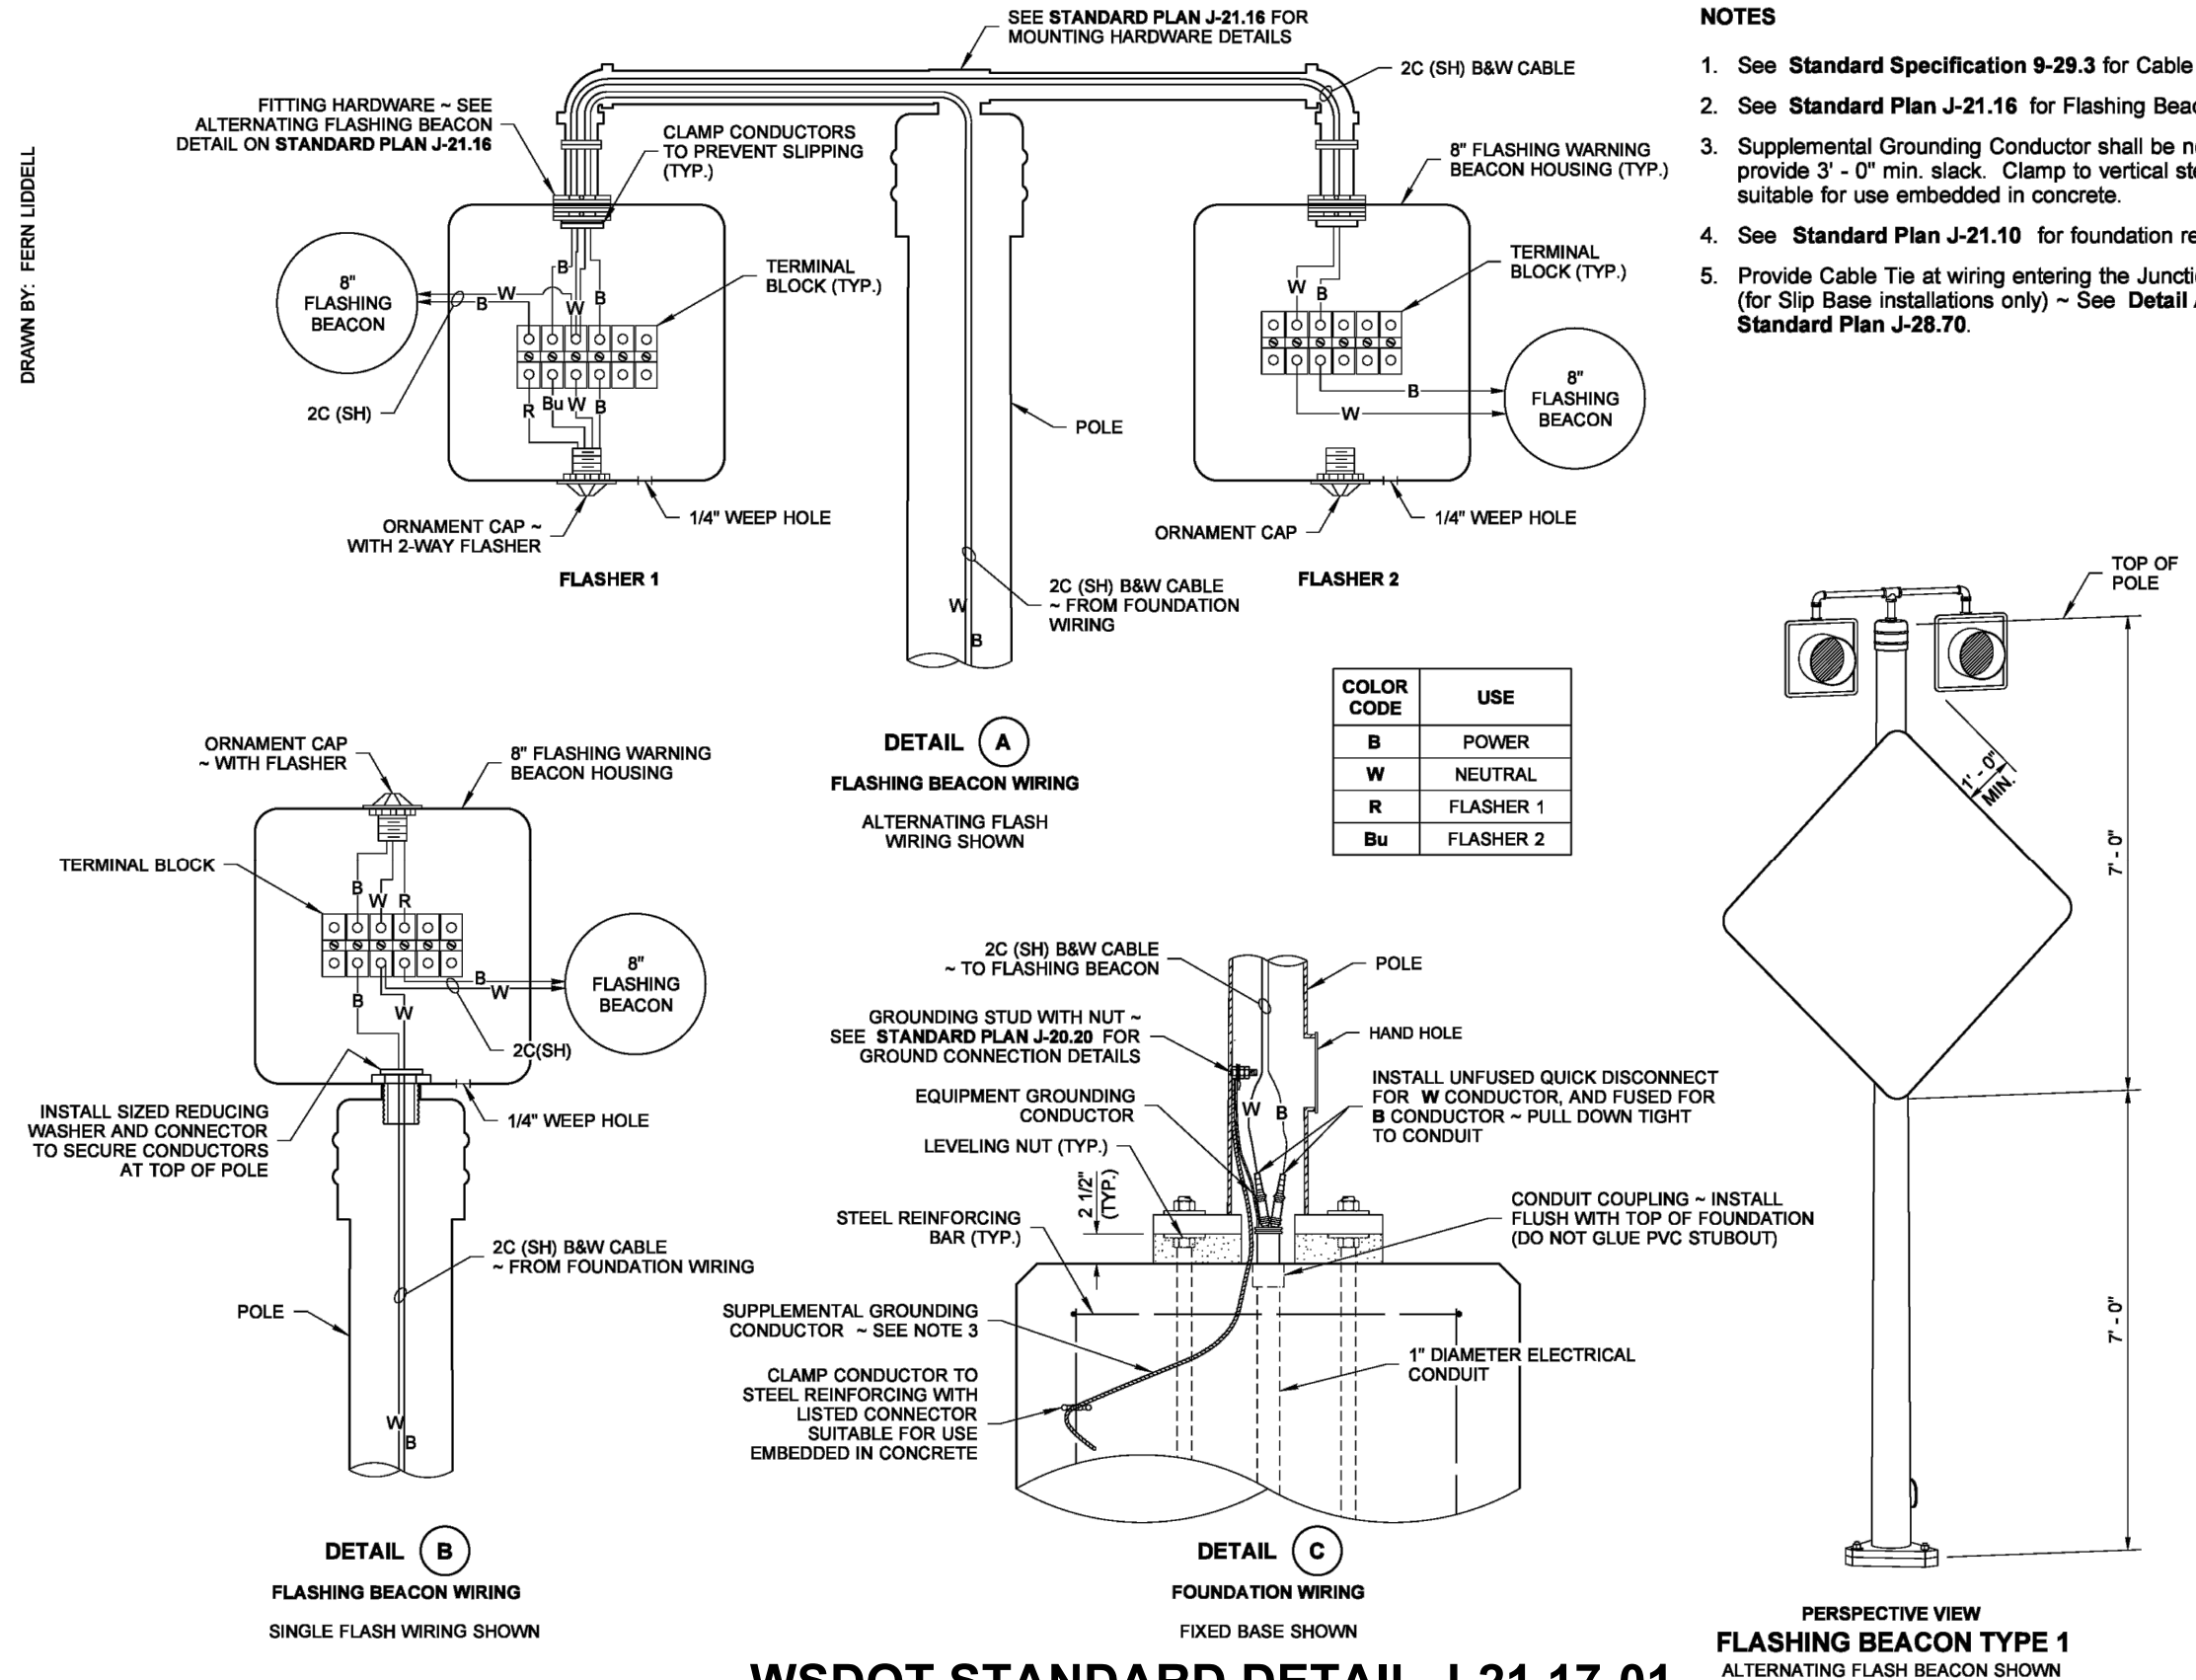


WSDOT STANDARD DETAIL J-21.17-01

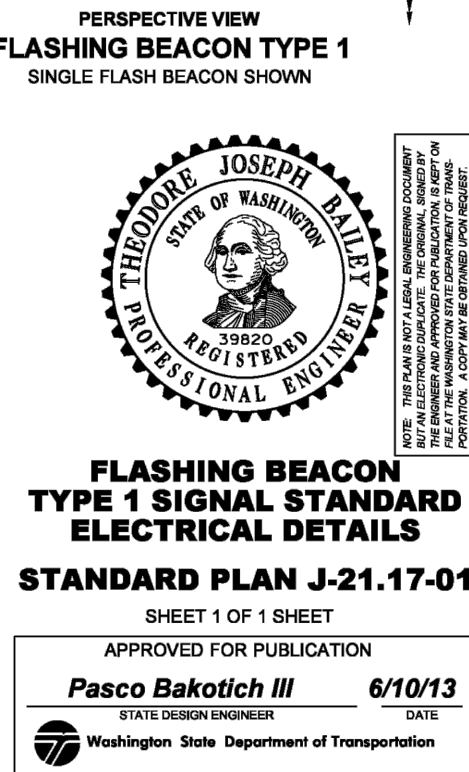


**FLASHING BEACON
TYPE 1 SIGNAL STANDARD
ELECTRICAL DETAILS
STANDARD PLAN J-21.17-01**
SHEET 1 OF 1 SHEET
APPROVED FOR PUBLICATION
Pasco Bakotich III 6/10/13
STATE DESIGN ENGINEER DATE
Washington State Department of Transportation


DRAWN BY: FERN LIDDELL

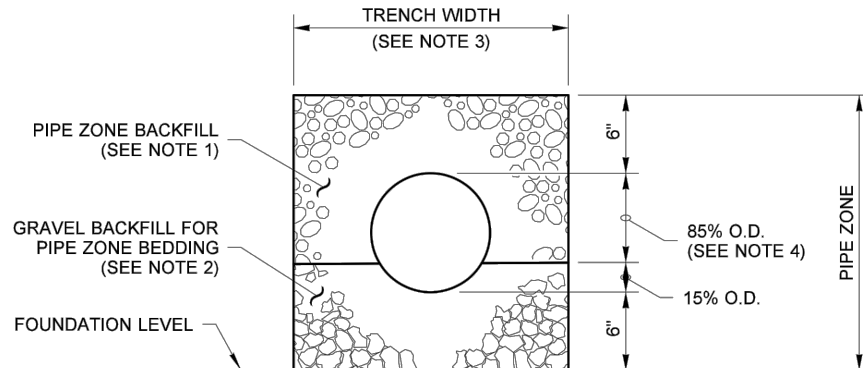

CONCRETE AND DUCTILE IRON PIPE

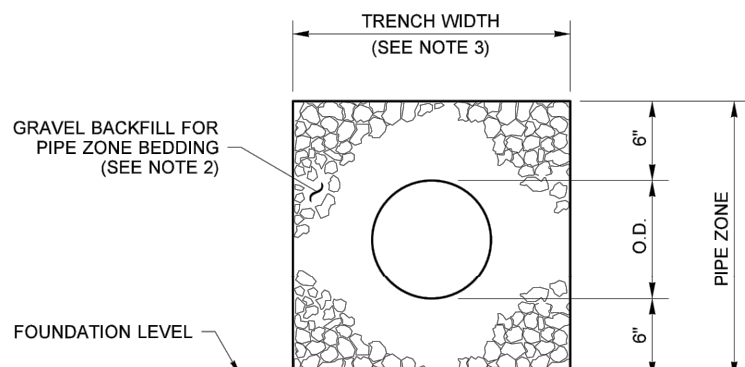

THERMOPLASTIC PIPE

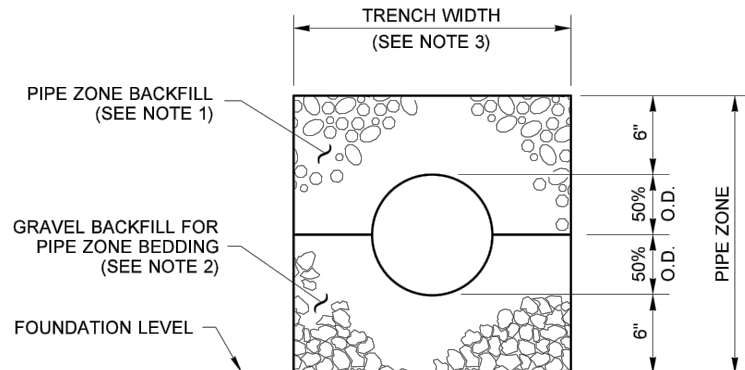


METAL AND STEEL RIB REINFORCED POLYETHYLENE PIPE

H

NOTES:

1. SEE STANDARD SPECIFICATIONS 9-03.9(3) (CSTC) FOR PIPE ZONE BACKFILL.
2. SEE STANDARD SPECIFICATIONS 9-03.9(3) (CSTC) FOR GRAVEL BACKFILL FOR PIPE ZONE BEDDING.
3. SEE STANDARD SPECIFICATIONS SECTION 2-09.4 FOR MEASUREMENT OF TRENCH WIDTH.
4. FOR SANITARY SEWER INSTALLATION, CONCRETE PIPE SHALL BE BEDDED TO SPRING LINE.
5. PIPE TRENCH MATERIALS SHALL BE COMPACTED TO 95% OF THE MAXIMUM DRY DENSITY DETERMINED IN ACCORDANCE WITH ASTM D 1557 TEST METHOD.
6. SEE DRAWINGS C5 AND C6 FOR PAVING REQUIREMENTS.
7. MINIMUM BURY DEPTH SHALL BE AS SHOWN ON PIPELINE DRAWINGS.
8. TRENCH BACKFILL ABOVE PIPE ZONE BACKFILL SHALL BE CSTC (WSDOT STANDARD SPECIFICATION SECTION 9-03.9(3)).
9. PROVIDE TRACER WIRE ABOVE ALL BURIED THERMOPLASTIC PIPE.

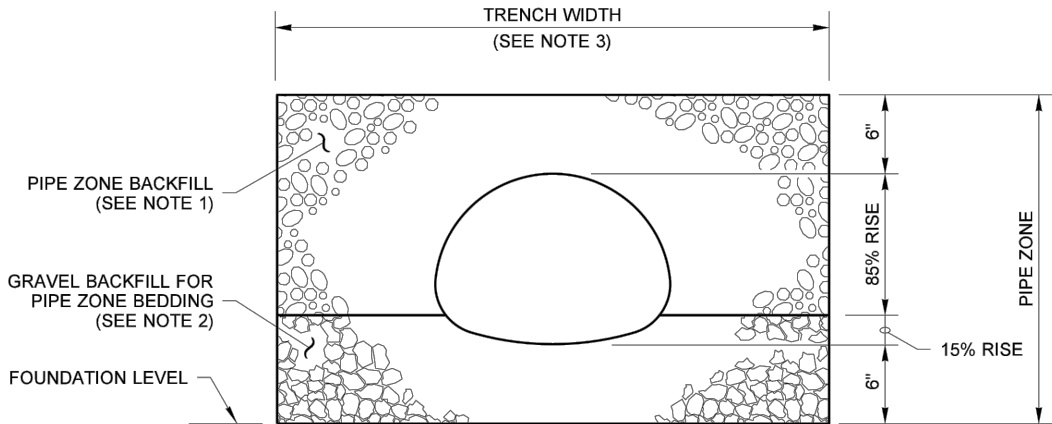

PIPE ARCHES

CLEARANCE BETWEEN PIPES FOR MULTIPLE INSTALLATIONS		
PIPE	SIZE	MINIMUM DISTANCE BETWEEN BARRELS
CIRCULAR PIPE (DIAMETER)	UP TO 48"	24"
METAL PIPE ARCH (SPAN)	48" AND LARGER	DIAMETER/2 OR 36" WHICHEVER IS LESS

WSDOT STANDARD DETAIL B-55.20-02



**PIPE ZONE BEDDING
AND BACKFILL
STANDARD PLAN B-55.20-02**
SHEET 1 OF 1 SHEET
APPROVED FOR PUBLICATION
Julie Heilman Feb-20-2018 12:56 PM
STATE DESIGN ENGINEER DATE
Washington State Department of Transportation


USE OF DOCUMENTS

THIS DOCUMENT, INCLUDING THE INCORPORATED DESIGNS, IS AN INSTRUMENT OF SERVICE FOR THIS PROJECT AND SHALL NOT BE USED FOR ANY OTHER PROJECT WITHOUT THE WRITTEN AUTHORIZATION OF KENNEDY/JENKS CONSULTANTS.

NO.	REVISION	DATE	BY

SCALES

0 1" 25mm
IF THIS BAR IS NOT
DIMENSION SHOWN,
ADJUST SCALES
ACCORDINGLY.

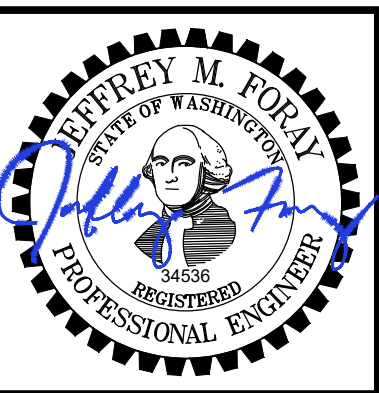

DESIGNED
JMF
DRAWN
LMM
CHECKED
MDL



CITY OF ISSAQUAH
ISSAQUAH, WASHINGTON
SOUTH SPAR BOOSTER PUMP STATION


Kennedy/Jenks Consultants
FEDERAL WAY, WASHINGTON



WSDOT STANDARD DETAILS

90% SUBMITTAL (REVISED 11/30/2020)

FILE NAME
139700500-G008.DWG
JOB NO.
1397005*00
DATE
NOVEMBER 2020
SHEET
OF
G8



P:\CAD\13\1397005_00_City_of_Issaquah\139700500-G009.dwg
7/1/2020 10:32 AM
MIKE/MARX

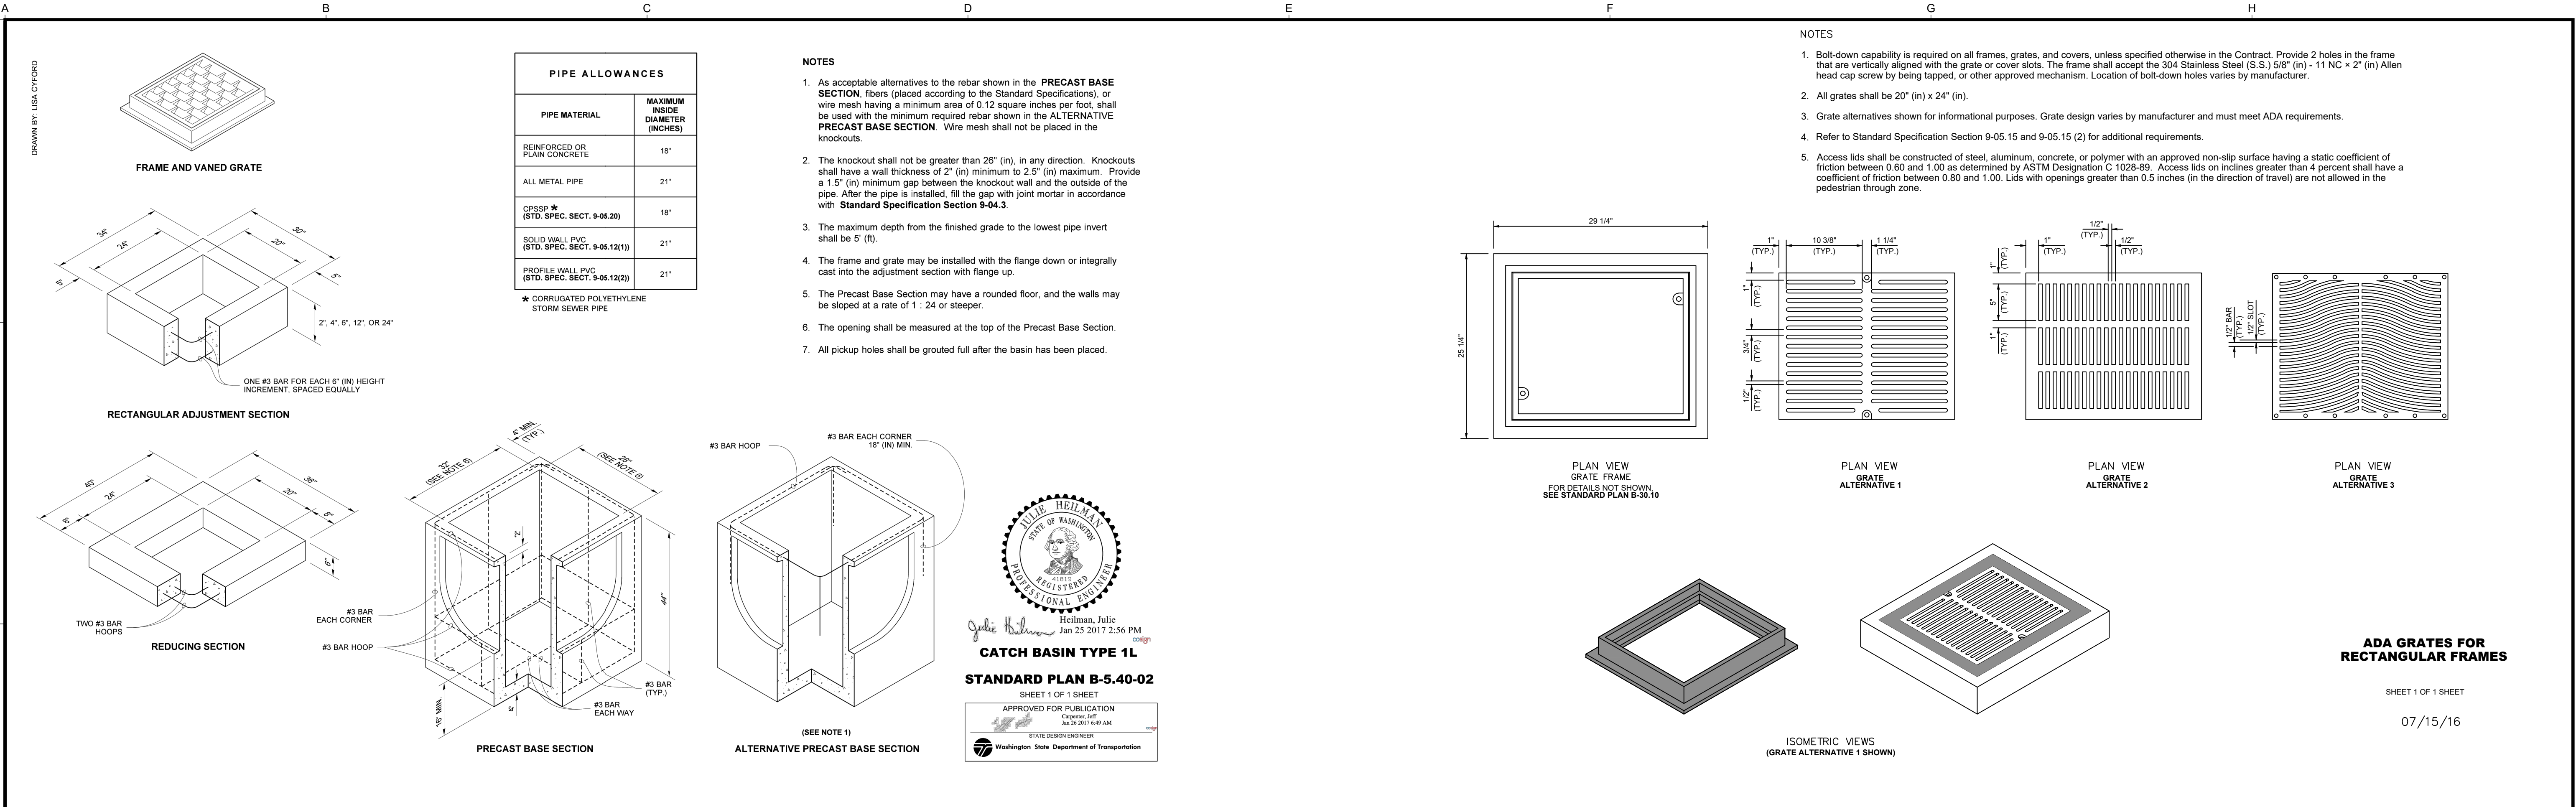

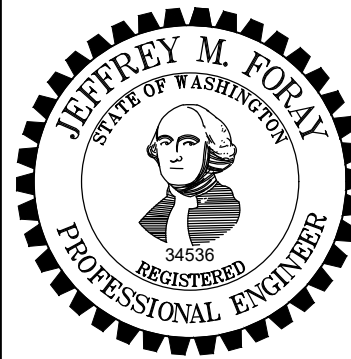USE OF DOCUMENTS THIS DOCUMENT, INCLUDING THE INCORPORATED DESIGNS, IS AN INSTRUMENT OF SERVICE FOR THIS PROJECT AND SHALL NOT BE USED FOR ANY OTHER PROJECT WITHOUT THE WRITTEN AUTHORIZATION OF KENNEDY/JENKS CONSULTANTS.						SCALES 0 1" 0 25mm IF THIS BAR IS NOT DIMENSION SHOWN, ADJUST SCALES ACCORDINGLY.		DESIGNED JMF	 <div>CITY OF ISSAQUAH ISSAQUAH, WASHINGTON SOUTH SPAR BOOSTER PUMP STATION</div>	Kennedy/Jenks Consultants FEDERAL WAY, WASHINGTON	WSDOT STANDARD DETAILS 90% SUBMITTAL (REVISED 7/1/2020)		FILE NAME 139700500-G009.DWG
								DRAWN LMM					JOB NO. 1397005*00
								CHECKED MDL					DATE JUNE 2020
	NO.	REVISION	DATE	BY									SHEET 9 OF 83 G9




6/30/2020 9:45 PM
DANPHIPPS
\\FWY01\cad\CAD\131\1397005-00_City_of_Issaquah\139700500-G010.dwg

DRAWN BY: BILL BERENS

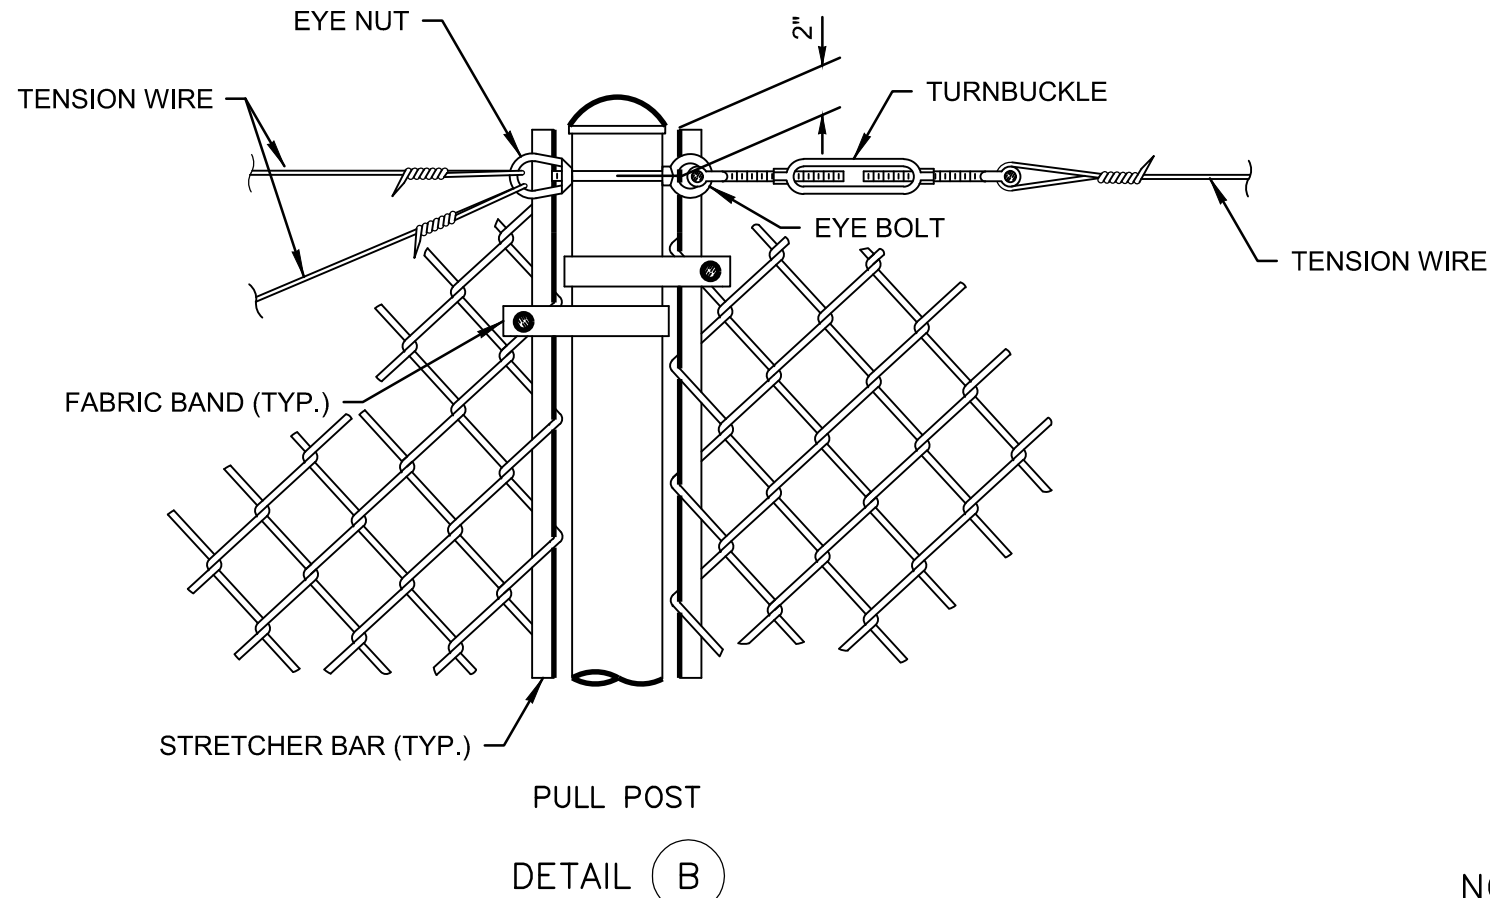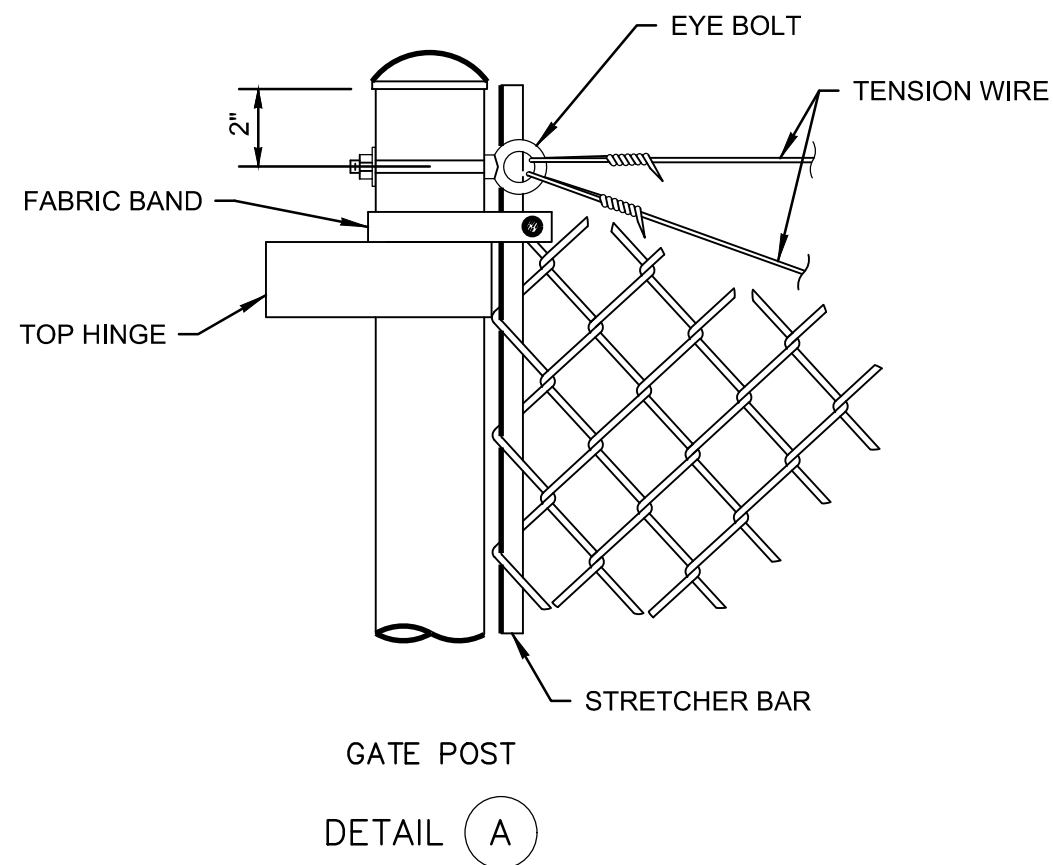

NOTES

1. Materials shall meet the requirements of **Standard Specification 9-16**.

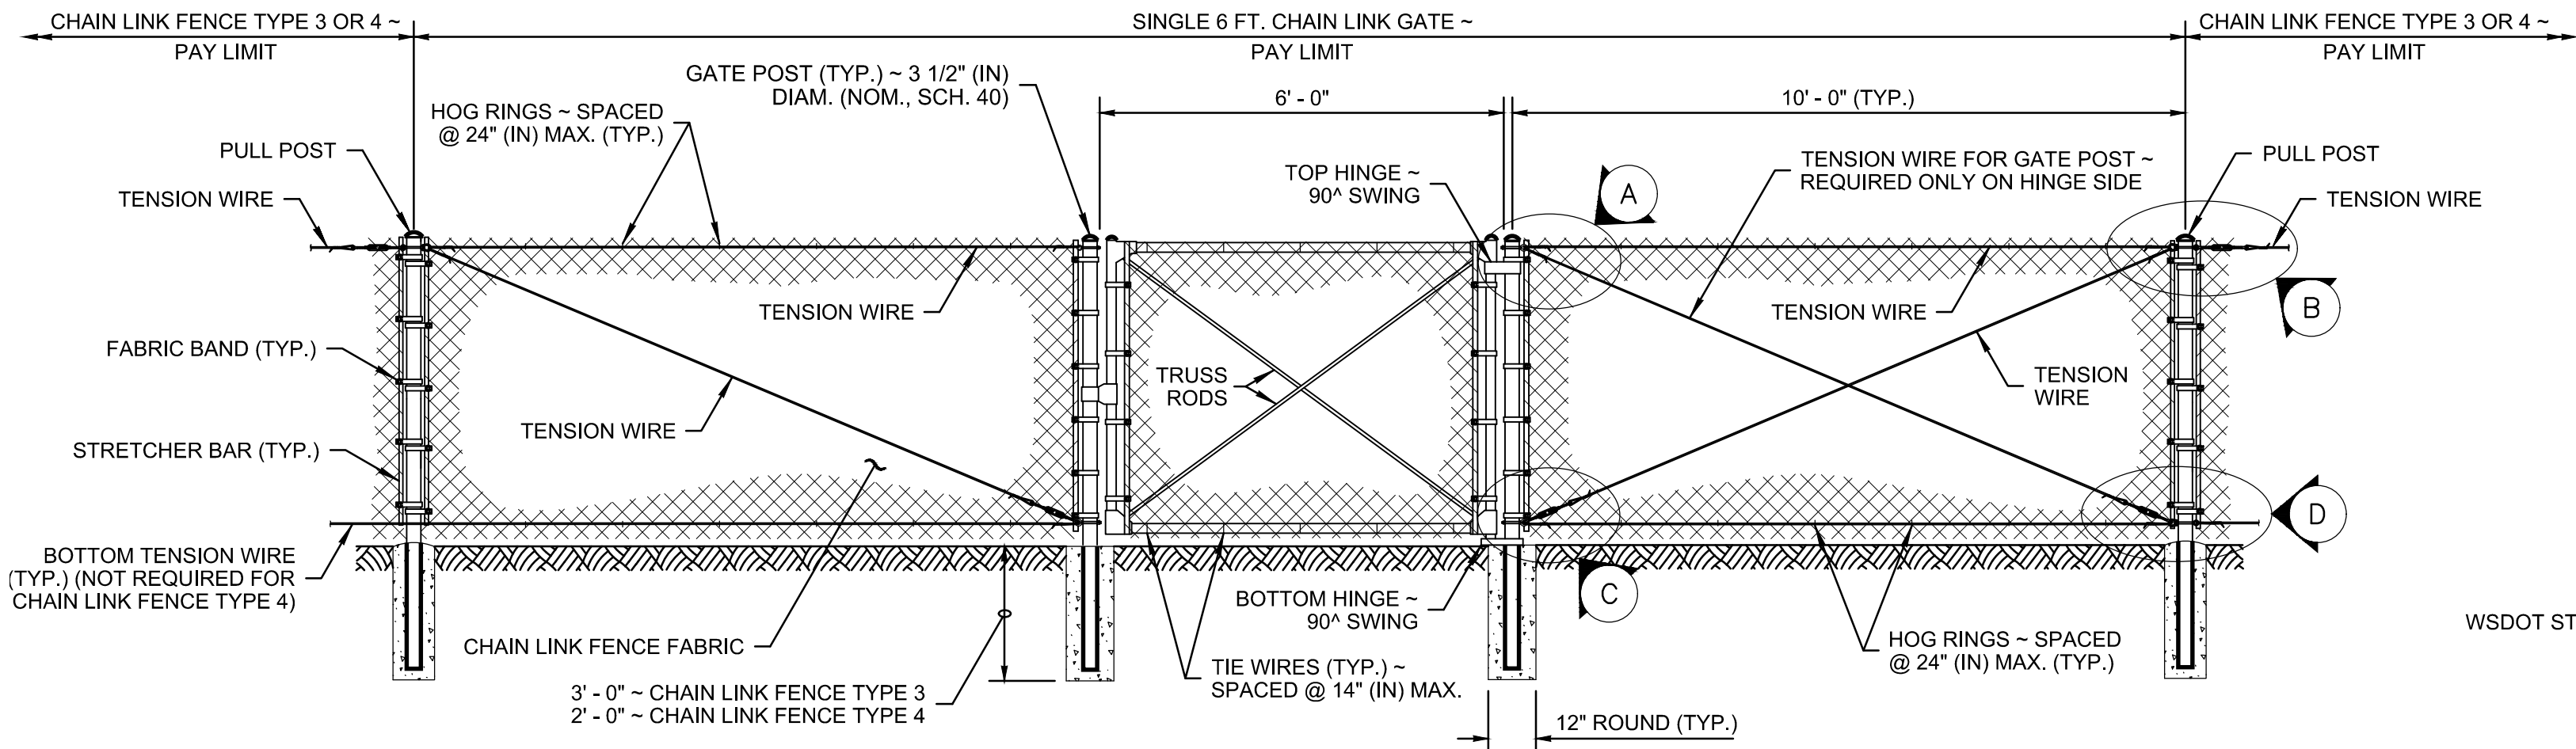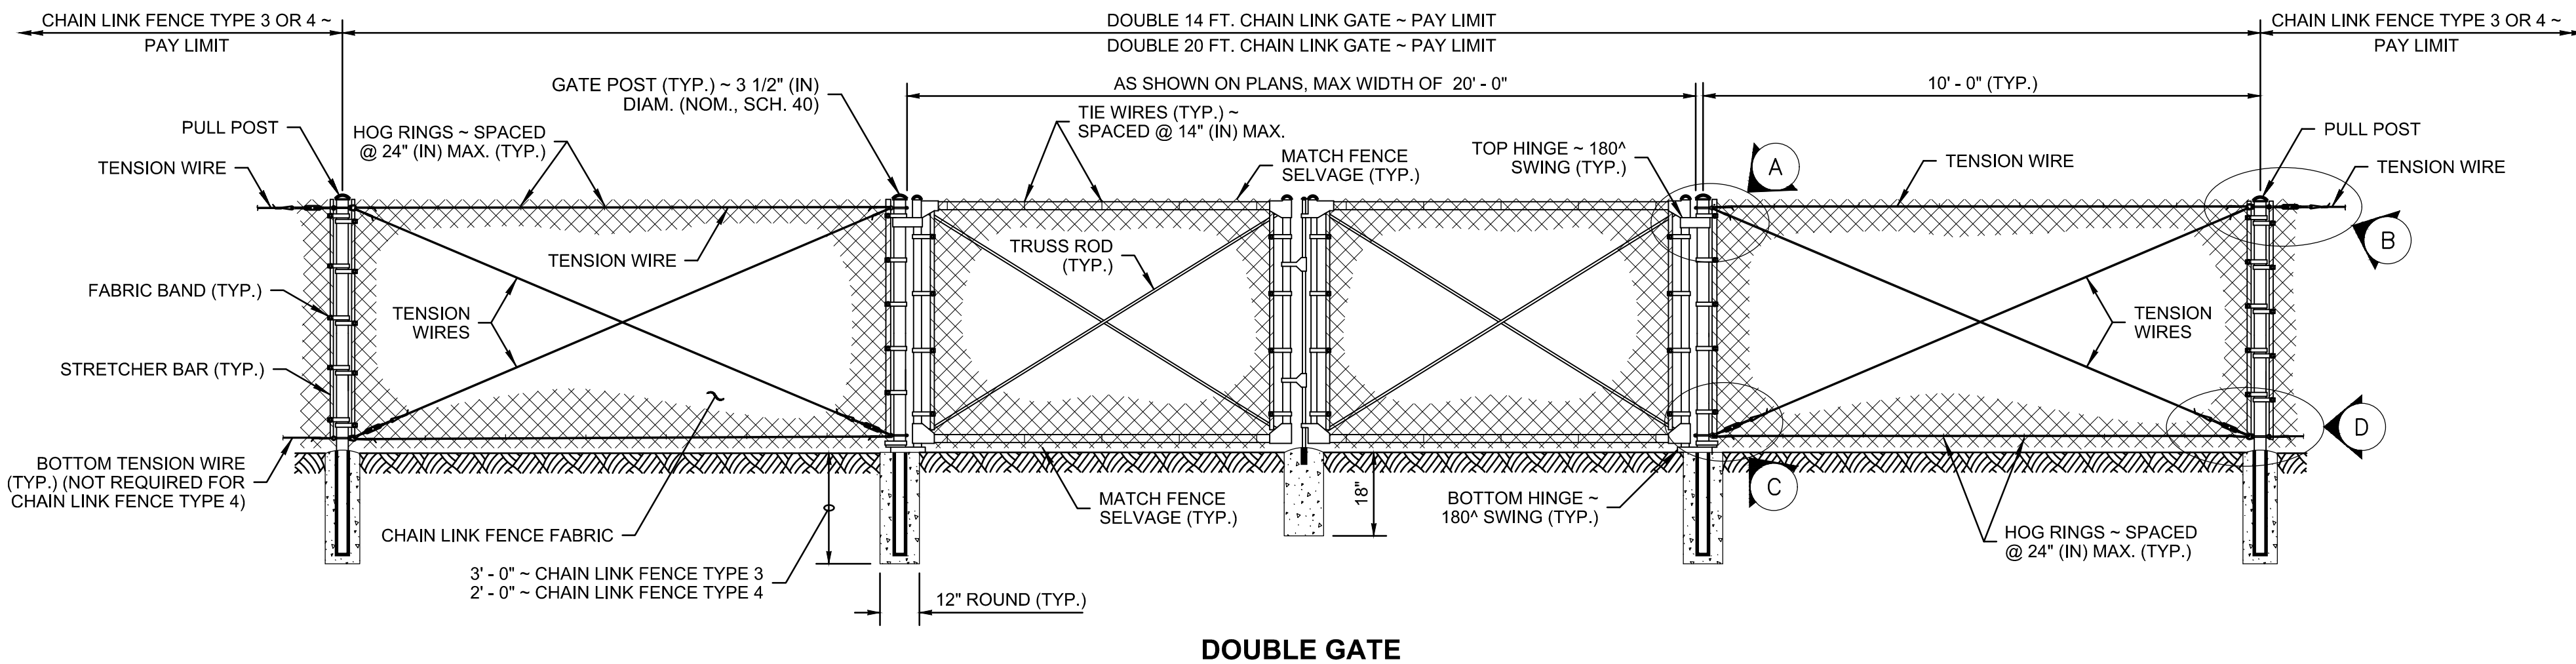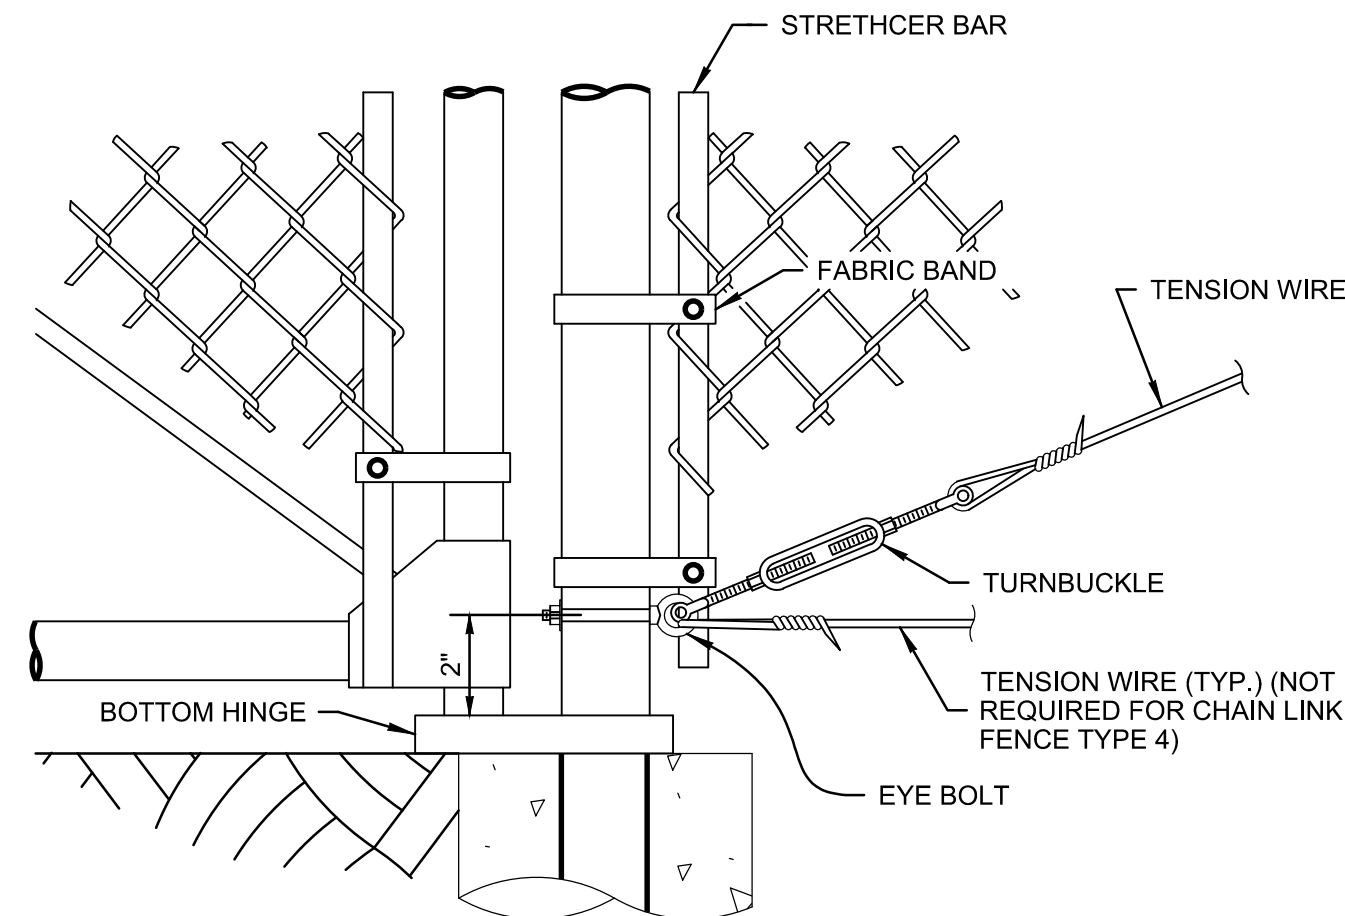

WSDOT STANDARD PLAN L-30.10-02


WSDOT STANDARD DETAIL L-30.10-02

USE OF DOCUMENTS

THIS DOCUMENT, INCLUDING THE INCORPORATED DESIGNS, IS AN INSTRUMENT OF SERVICE FOR THIS PROJECT AND SHALL NOT BE USED FOR ANY OTHER PROJECT WITHOUT THE WRITTEN AUTHORIZATION OF KENNEDY/JENKS CONSULTANTS.

NO.	REVISION	DATE	BY

SCALES
0 1"
0 25mm
IF THIS BAR IS NOT DIMENSION SHOWN, ADJUST SCALES ACCORDINGLY.

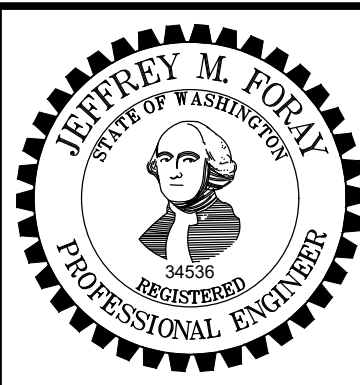

DESIGNED	KSP
DRAWN	RJS
CHECKED	MDL




CITY OF ISSAQUAH
ISSAQUAH, WASHINGTON
SOUTH SPAR BOOSTER PUMP STATION

Kennedy/Jenks Consultants
FEDERAL WAY, WASHINGTON

WSDOT STANDARD DETAILS

90% SUBMITTAL (REVISED 7/1/2020)

FILE NAME	139700500-G010.DWG
JOB NO.	1397005*00
DATE	JUNE 2020
SHEET	10 OF 83
G10	

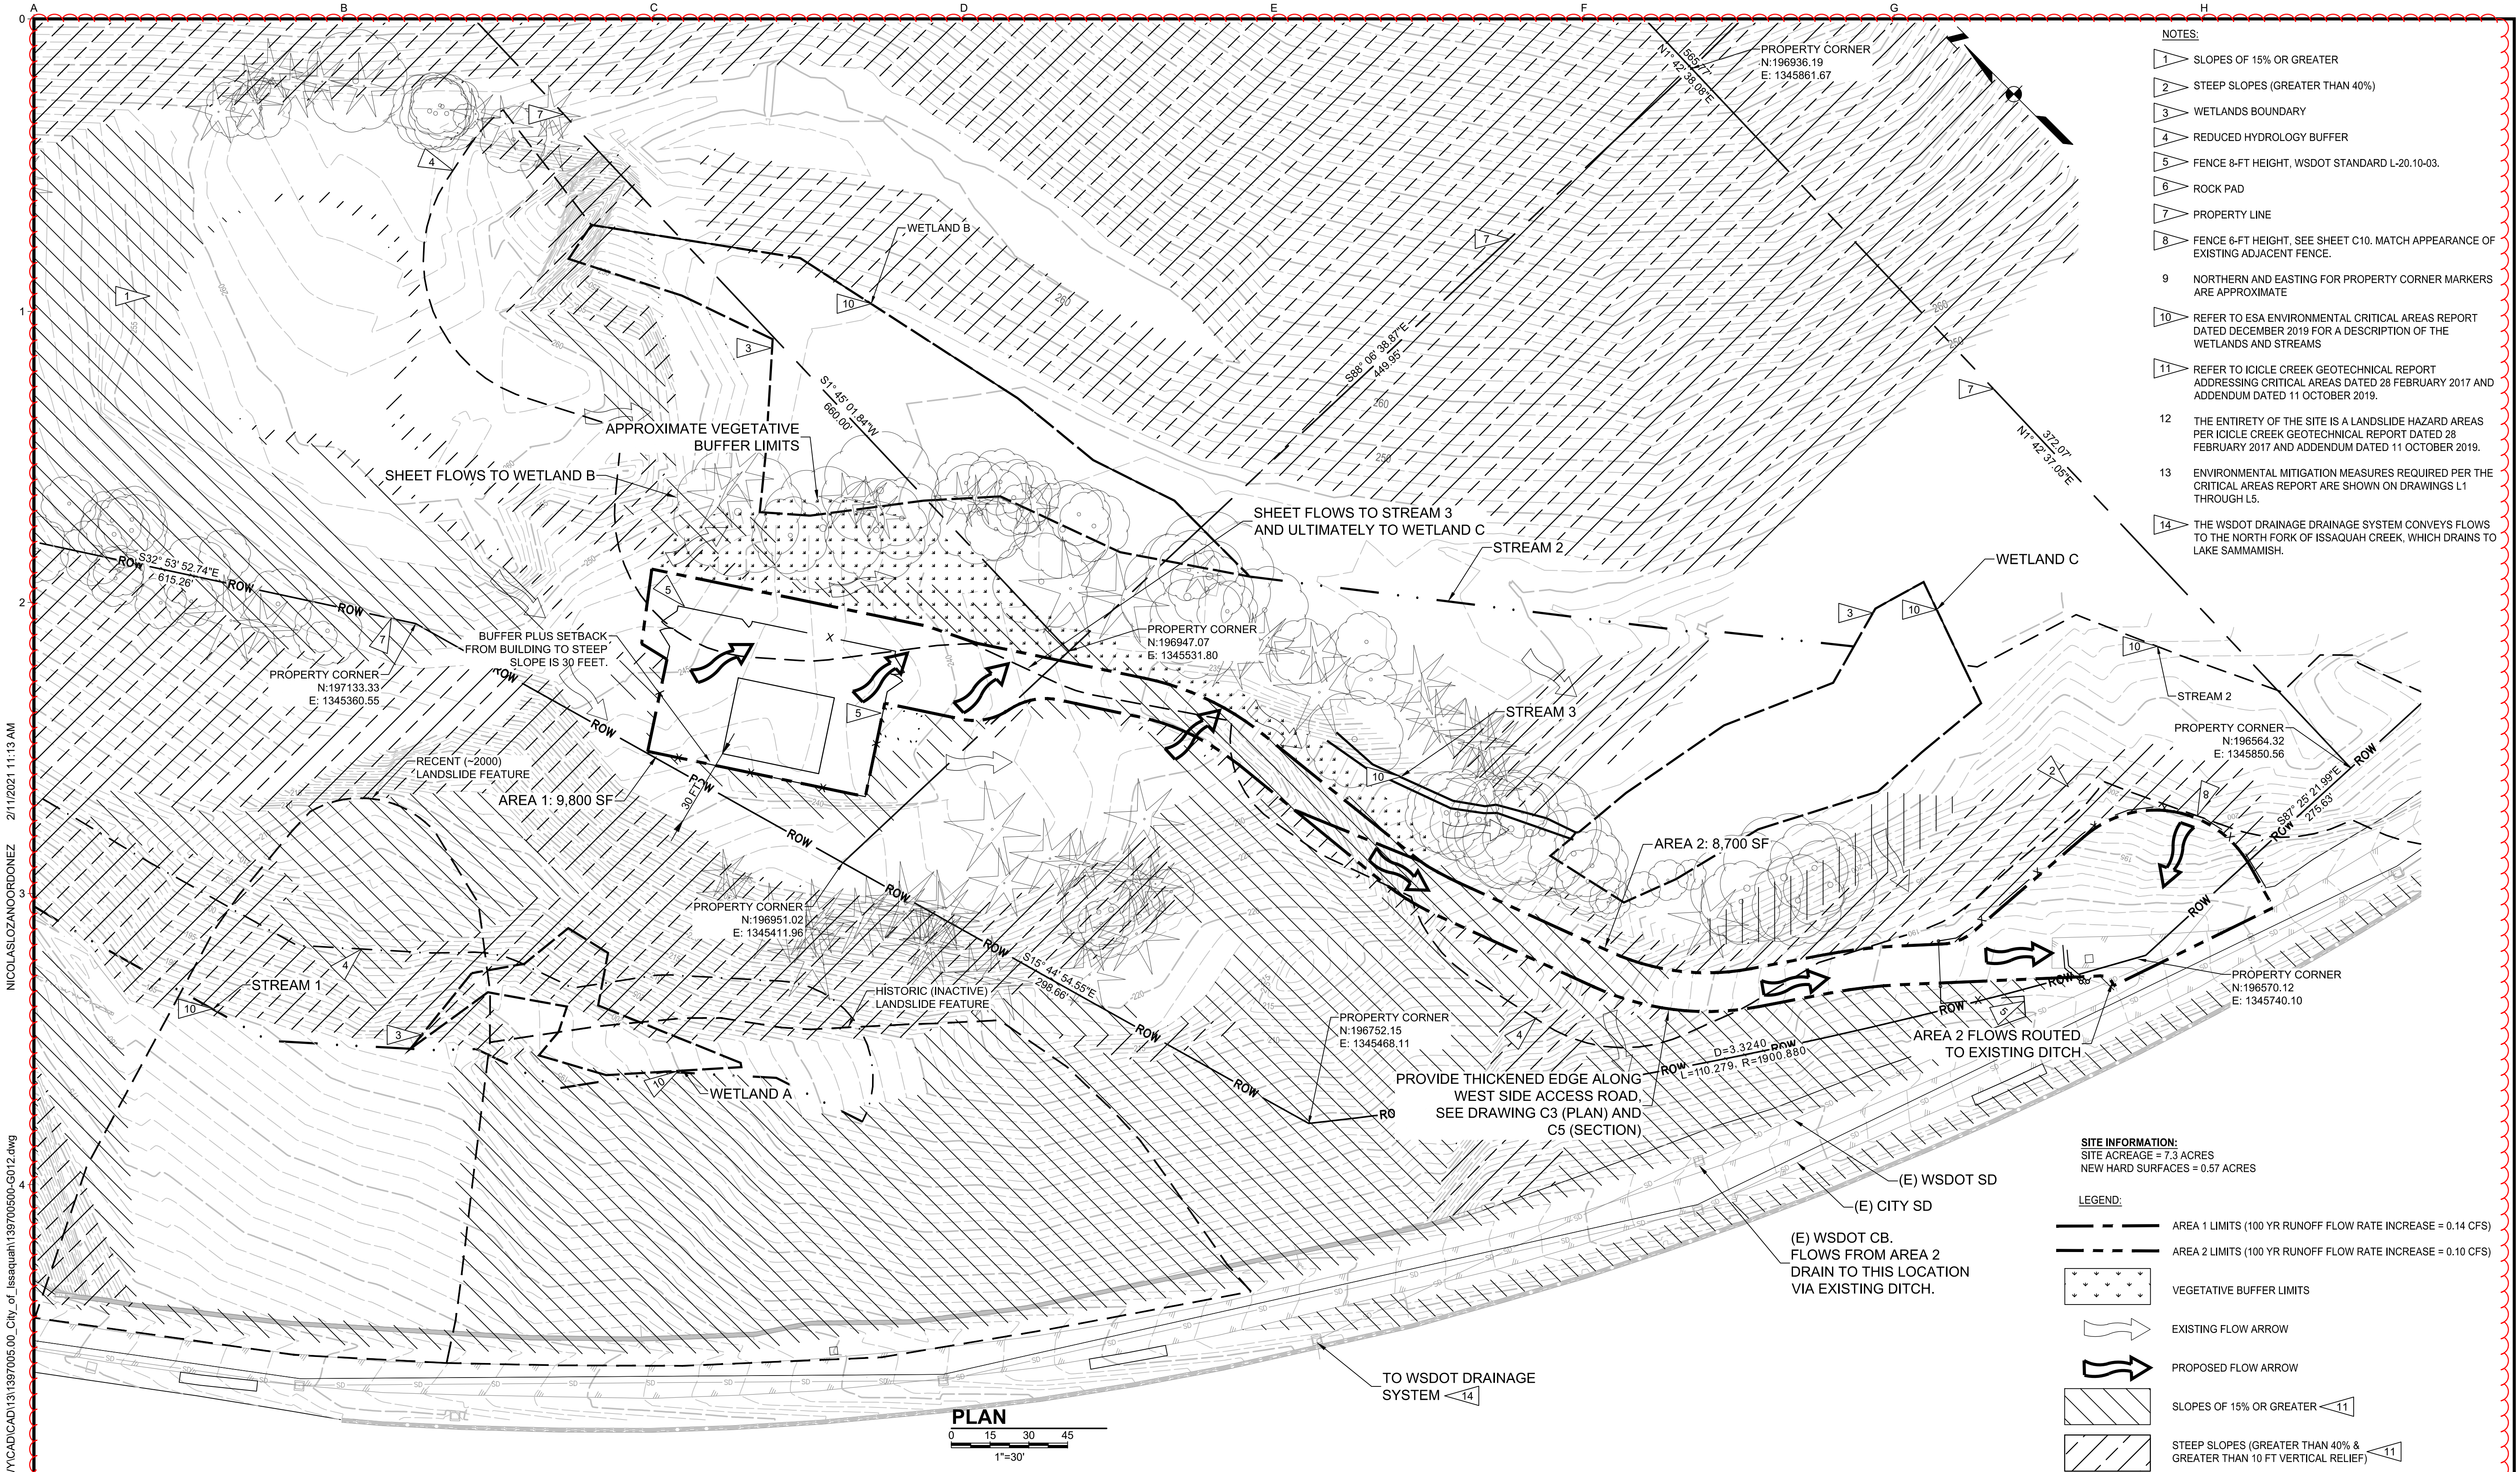

- NOTES:
- 1 SLOPES OF 15% OR GREATER
 - 2 STEEP SLOPES (GREATER THAN 40%)
 - 3 WETLANDS BOUNDARY
 - 4 REDUCED HYDROLOGY BUFFER
 - 5 FENCE 8-FT HEIGHT, WSDOT STANDARD L-20.10-03.
 - 6 ROCK PAD
 - 7 PROPERTY LINE
 - 8 FENCE 6-FT HEIGHT, SEE SHEET C10. MATCH APPEARANCE OF EXISTING ADJACENT FENCE.
 - 9 NORTHERN AND EASTING FOR PROPERTY CORNER MARKERS ARE APPROXIMATE
 - 10 REFER TO ESA ENVIRONMENTAL CRITICAL AREAS REPORT DATED DECEMBER 2019 FOR A DESCRIPTION OF THE WETLANDS AND STREAMS
 - 11 REFER TO ICICLE CREEK GEOTECHNICAL REPORT ADDRESSING CRITICAL AREAS DATED 28 FEBRUARY 2017 AND ADDENDUM DATED 11 OCTOBER 2019.
 - 12 THE ENTIRETY OF THE SITE IS A LANDSLIDE HAZARD AREAS PER ICICLE CREEK GEOTECHNICAL REPORT DATED 28 FEBRUARY 2017 AND ADDENDUM DATED 11 OCTOBER 2019.
 - 13 ENVIRONMENTAL MITIGATION MEASURES REQUIRED PER THE CRITICAL AREAS REPORT ARE SHOWN ON DRAWINGS L1 THROUGH L5.
 - 14 THE WSDOT DRAINAGE DRAINAGE SYSTEM CONVEYS FLOWS TO THE NORTH FORK OF ISSAQUAH CREEK, WHICH DRAINS TO LAKE SAMMAMISH.

SITE INFORMATION:
SITE ACREAGE = 7.3 ACRES
NEW HARD SURFACES = 0.57 ACRES


LEGEND:

- AREA 1 LIMITS (100 YR RUNOFF FLOW RATE INCREASE = 0.14 CFS)
- AREA 2 LIMITS (100 YR RUNOFF FLOW RATE INCREASE = 0.10 CFS)
- VEGETATIVE BUFFER LIMITS
- EXISTING FLOW ARROW
- PROPOSED FLOW ARROW
- SLOPES OF 15% OR GREATER
- STEEP SLOPES (GREATER THAN 40% & GREATER THAN 10 FT VERTICAL RELIEF)

2/11/2021 11:13 AM
NICOLASLOZANOORDONEZ
\\jc.local\KUC-Rodrik-Office\FWY\CAD\CAD131\397005.00_City_of_Issaquah\139700500-G012.dwg

USE OF DOCUMENTS THIS DOCUMENT, INCLUDING THE INCORPORATED DESIGNS, IS AN INSTRUMENT OF SERVICE FOR THIS PROJECT AND SHALL NOT BE USED FOR ANY OTHER PROJECT WITHOUT THE WRITTEN AUTHORIZATION OF KENNEDY/JENKS CONSULTANTS.					SCALES 0 1" 25mm IF THIS BAR IS NOT DIMENSION SHOWN, ADJUST SCALES ACCORDINGLY.		DESIGNED DRP		CITY OF ISSAQUAH ISSAQUAH, WASHINGTON SOUTH SPAR BOOSTER PUMP STATION	DRAINAGE PLAN	FILE NAME 139700500-G012.DWG
	NO.	REVISION	DATE	BY			DRAWN DRP				CHECKED JMF

P:\CAD\131397005_00_City_of_Issaquah\139700500-G013.dwg
MIKE MARY
2/22/2021 1:23 PM

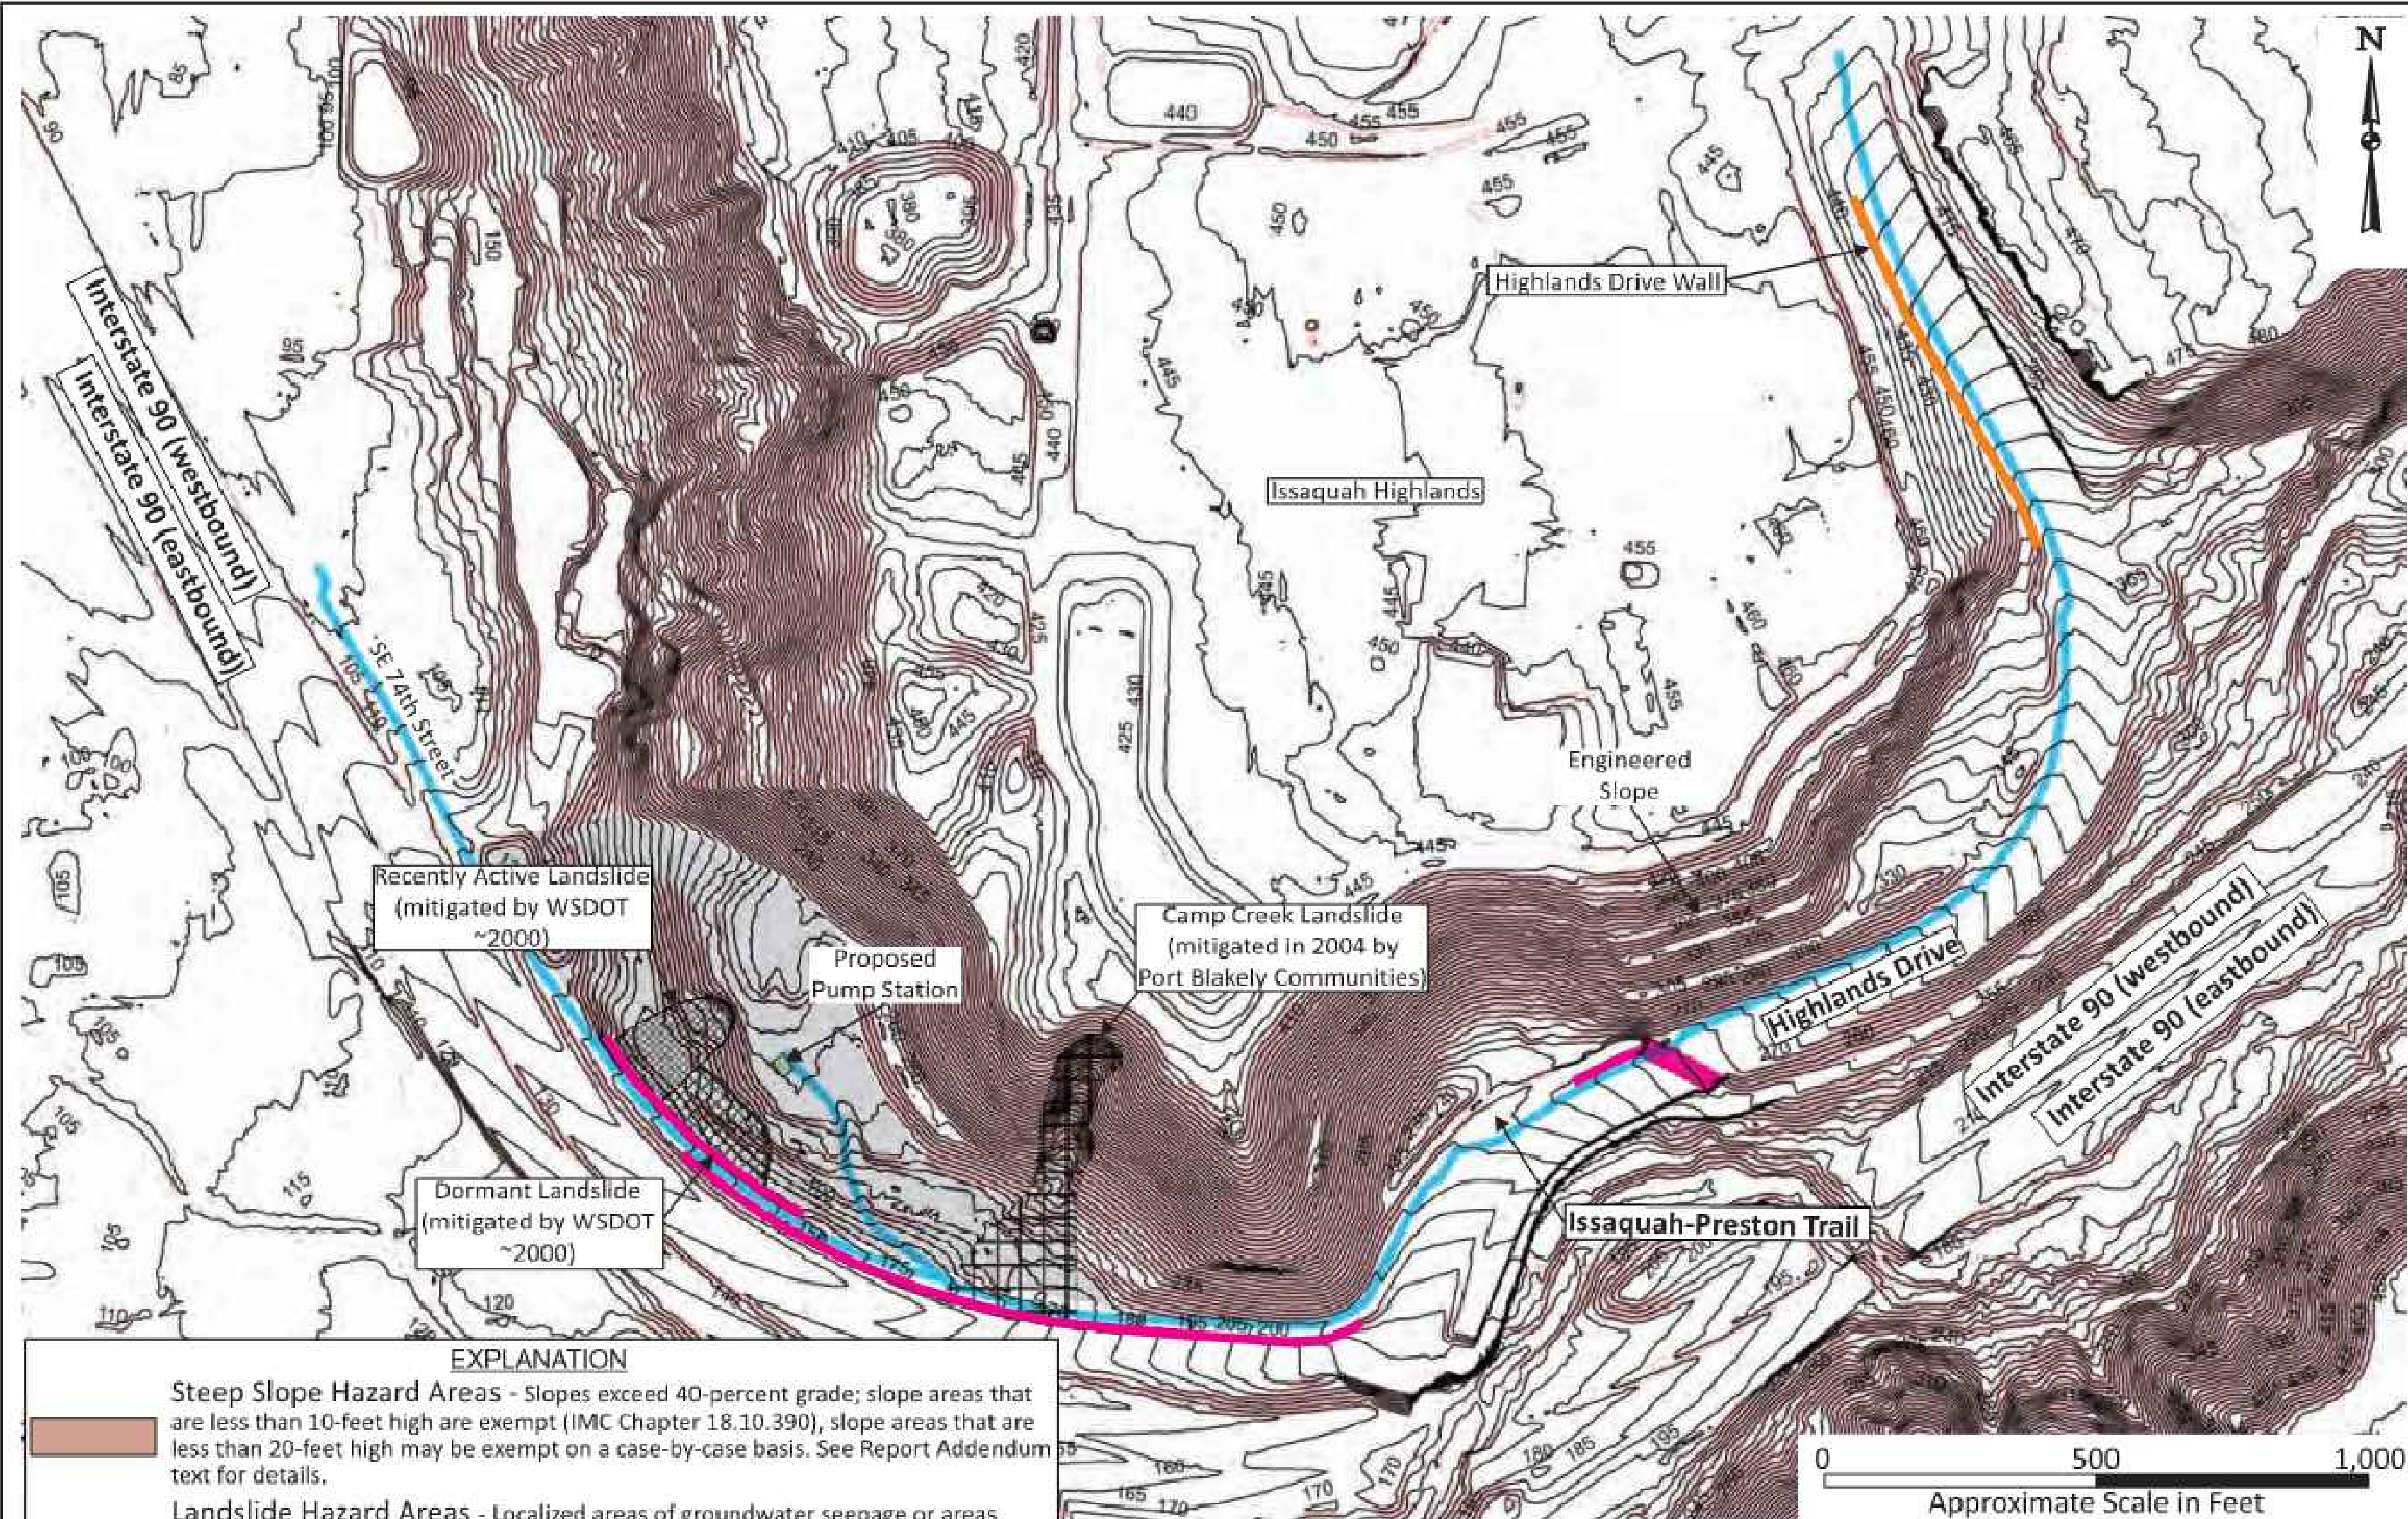

EXPLANATION

Steep Slope Hazard Areas - Slopes exceed 40-percent grade; slope areas that are less than 10-feet high are exempt (IMC Chapter 18.10.390), slope areas that are less than 20-feet high may be exempt on a case-by-case basis. See Report Addendum text for details.

Landslide Hazard Areas - Localized areas of groundwater seepage or areas that have experienced recent movement (identified landslide areas as shown). See Report Addendum text for details.

Erosion Hazard Areas - Large portions of the site are considered Erosion Hazard Areas (IMC Chapter 18.10.390). Implement appropriate Best Management Practices.

Known Landslides

WSDOT Retaining Walls and Structures (only shown adjacent to alignment)

Proposed Water Line

NOTES: 1) Base map prepared using Light Detection and Ranging (LIDAR) Digital Terrain Model (DTM) data (King County 2016 acquisition) obtained from the Washington State Department of Natural Resources (DNR) LIDAR Portal (<http://lidarportal.dnr.wa.gov/>) and processed for 5-foot contours and 40-percent slopes using Esri ArcGIS 10.6.

2) Proposed Pump Station and Water Line locations based on Kennedy/Jenks Consultants, November 2020, South SPAR Booster Pump Station, sheets CP1 to CP8.

SITE PLAN AND CRITICAL AREAS MAP

SOUTH SPAR BOOSTER PUMP STATION AND 297/520 ZONE AND 742 ZONE WATER LINES

ICICLE CREEK ENGINEERS

29335 NE 20th Street
Carnation, Washington 98014
(425) 333-0093

SCALE: As shown	ICE FILE NO.
DESIGNED: —	0101-013
DRAWN: JMS/BRB	Attachment
CHECKED: USK	A
DATE: 01/22/2021	

NOTES:

1. SEE DRAWING G12 FOR ADDITIONAL INFORMATION REGARDING CRITICAL AREAS AROUND PUMP STATION SITE.

USE OF DOCUMENTS

THIS DOCUMENT, INCLUDING THE INCORPORATED DESIGNS, IS AN INSTRUMENT OF SERVICE FOR THIS PROJECT AND SHALL NOT BE USED FOR ANY OTHER PROJECT WITHOUT THE WRITTEN AUTHORIZATION OF KENNEDY/JENKS CONSULTANTS.

NO.	REVISION	DATE	BY

SCALES

0 1" 25mm

IF THIS BAR IS NOT DIMENSION SHOWN, ADJUST SCALES ACCORDINGLY.

DESIGNED: JMF

DRAWN: LMM

CHECKED: MDL

CITY OF ISSAQUAH
ISSAQUAH, WASHINGTON

SOUTH SPAR BOOSTER PUMP STATION

Kennedy/Jenks Consultants
FEDERAL WAY, WASHINGTON

CRITICAL AREA MAP

FILE NAME: 139700500-G013.DWG

JOB NO.: 1397005*00

DATE: FEBRUARY 2021

SHEET OF: **G13**

SIGN SPACING

RURAL ROADS & URBAN ARTERIALS	35/40 MPH	350' ±
RURAL ROADS, URBAN ARTERIALS, RESIDENTIAL AND BUSINESS DISTRICTS	25/30 MPH	200' ± (2)
URBAN STREETS	25 MPH OR LESS	100' ± (2)
(1) ALL SPACING MAY BE ADJUSTED TO ACCOMMODATE INTERSECTIONS AND DRIVEWAYS		
(2) THIS SPACING MAY BE REDUCED IN URBAN AREAS TO FIT ROADWAY CONDITIONS		

*SPEED LIMIT HIGHLANDS DRIVE NE: 40MPH

MINIMUM SHOULDER TAPER LENGTH = L/3 (FEET)

SHOULDER WIDTH (FEET)	POSTED SPEED (MPH)									
	25	30	35	40	45	50	55	60	65	70
8'	40	40	60	90	-	-	-	-	-	-
14'	40	60	90	90	-	-	-	-	-	-

USE A 3 DEVICES TAPER FOR SHOULDERS LESS THAN 8'

CHANNELIZATION DEVICE
SPACING (FEET)


MPH	TAPER	TANGENT
35/40	30	60
25/30	20	40



LEGEND

- TEMPORARY SIGN LOCATION
- TRAFFIC SAFETY DRUM WITH TYPE C LIGHTS
- JERSEY BARRIER
- WORK ZONE

- NOTES:
- 1. FOLLOW SIGN SPACING LEGEND, ADJUST AND ADD AS NEEDED.
 - 2. ENSURE SIGNS ARE VISIBLE TO ONCOMING TRAFFIC.

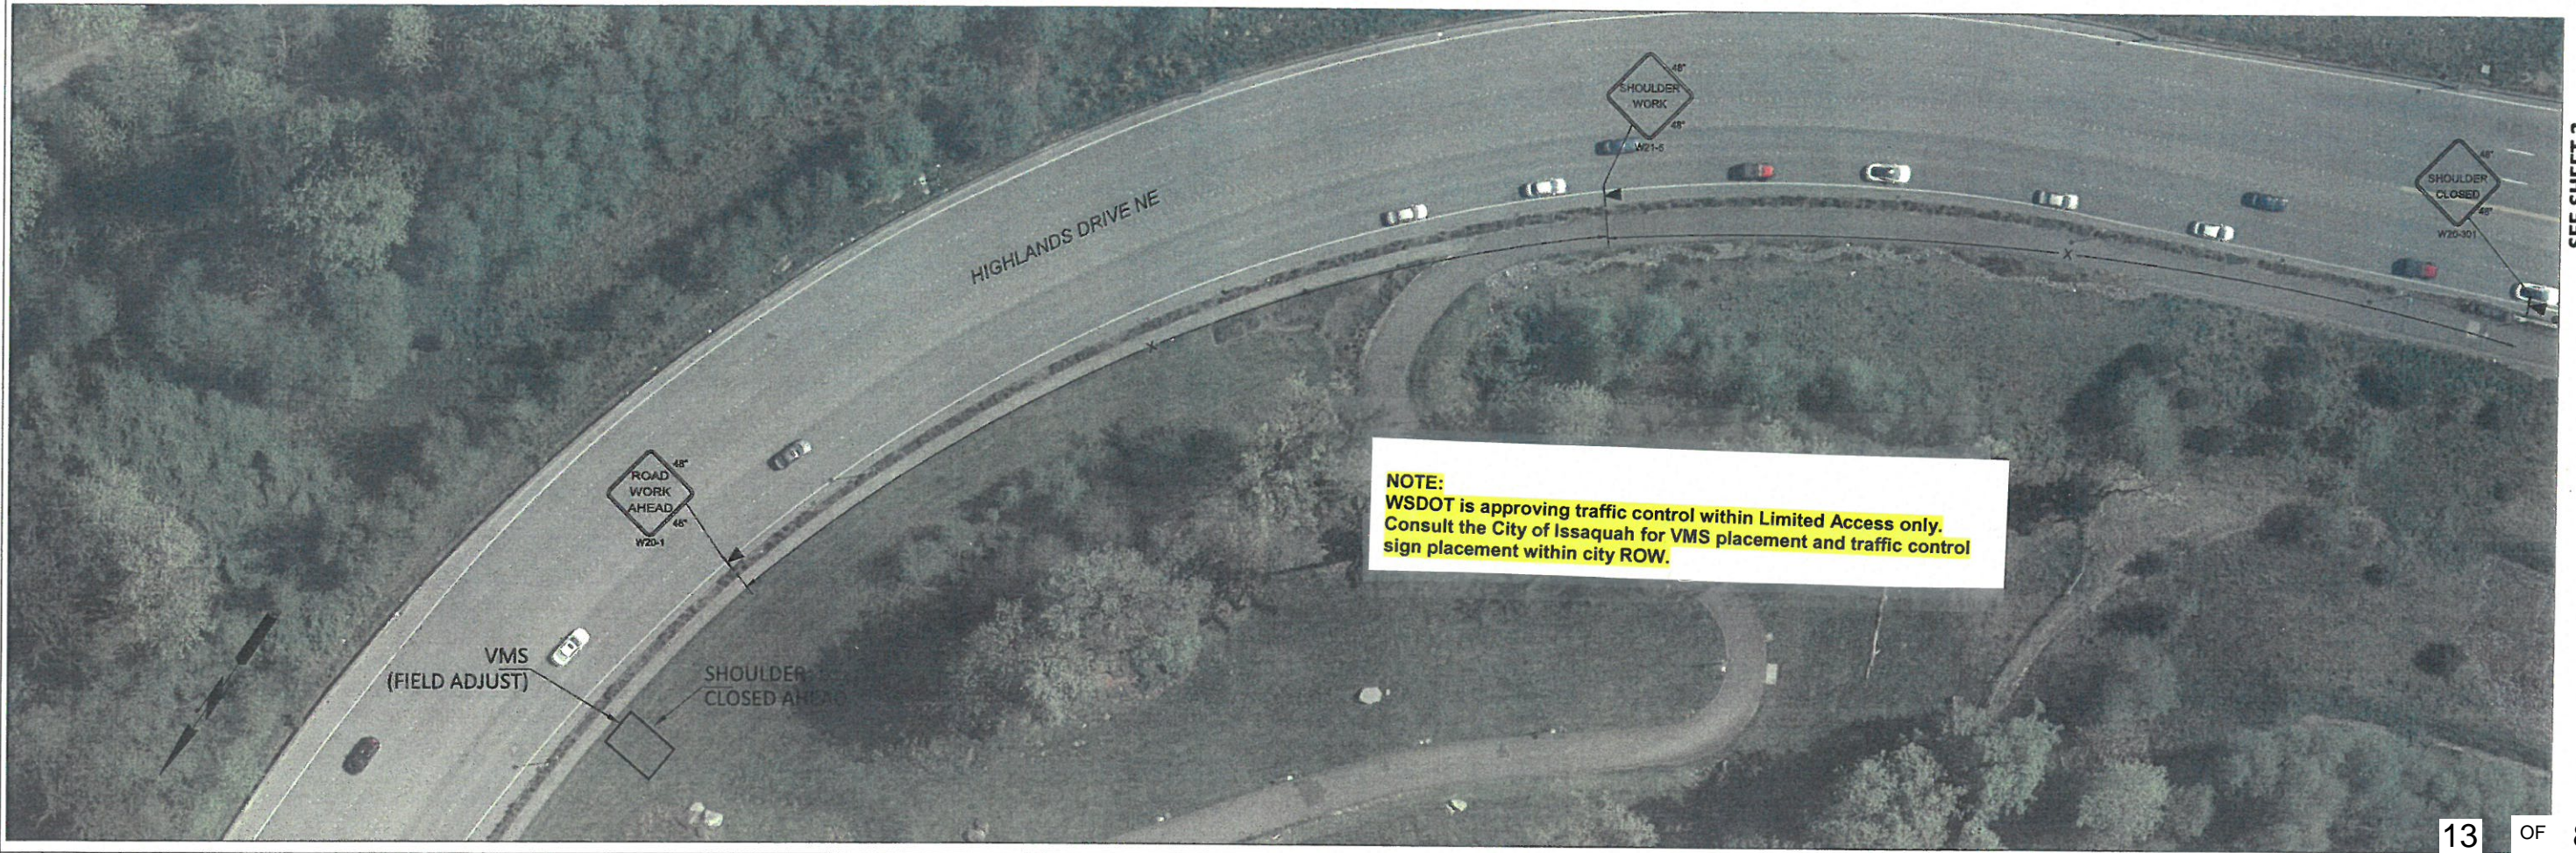

NOTE:
WSDOT is approving traffic control within Limited Access only.
Consult the City of Issaquah for VMS placement and traffic control
sign placement within city ROW.

NO.	DATE	BY	APPR	REVISION

DEPARTMENT OF PUBLIC WORKS
P.O. BOX 1307 ISSAQUAH WA 98027 (425) 837-3400

SPAR PUMP STATION

DRN: JT DSGN: TN CHKD: RY


TRAFFIC CONTROL PLAN

DATE: FEB 2020 JOB#: WATR15002 SCALE: 1:30


13 OF 83

2 OF 3

SEE SHEET 2

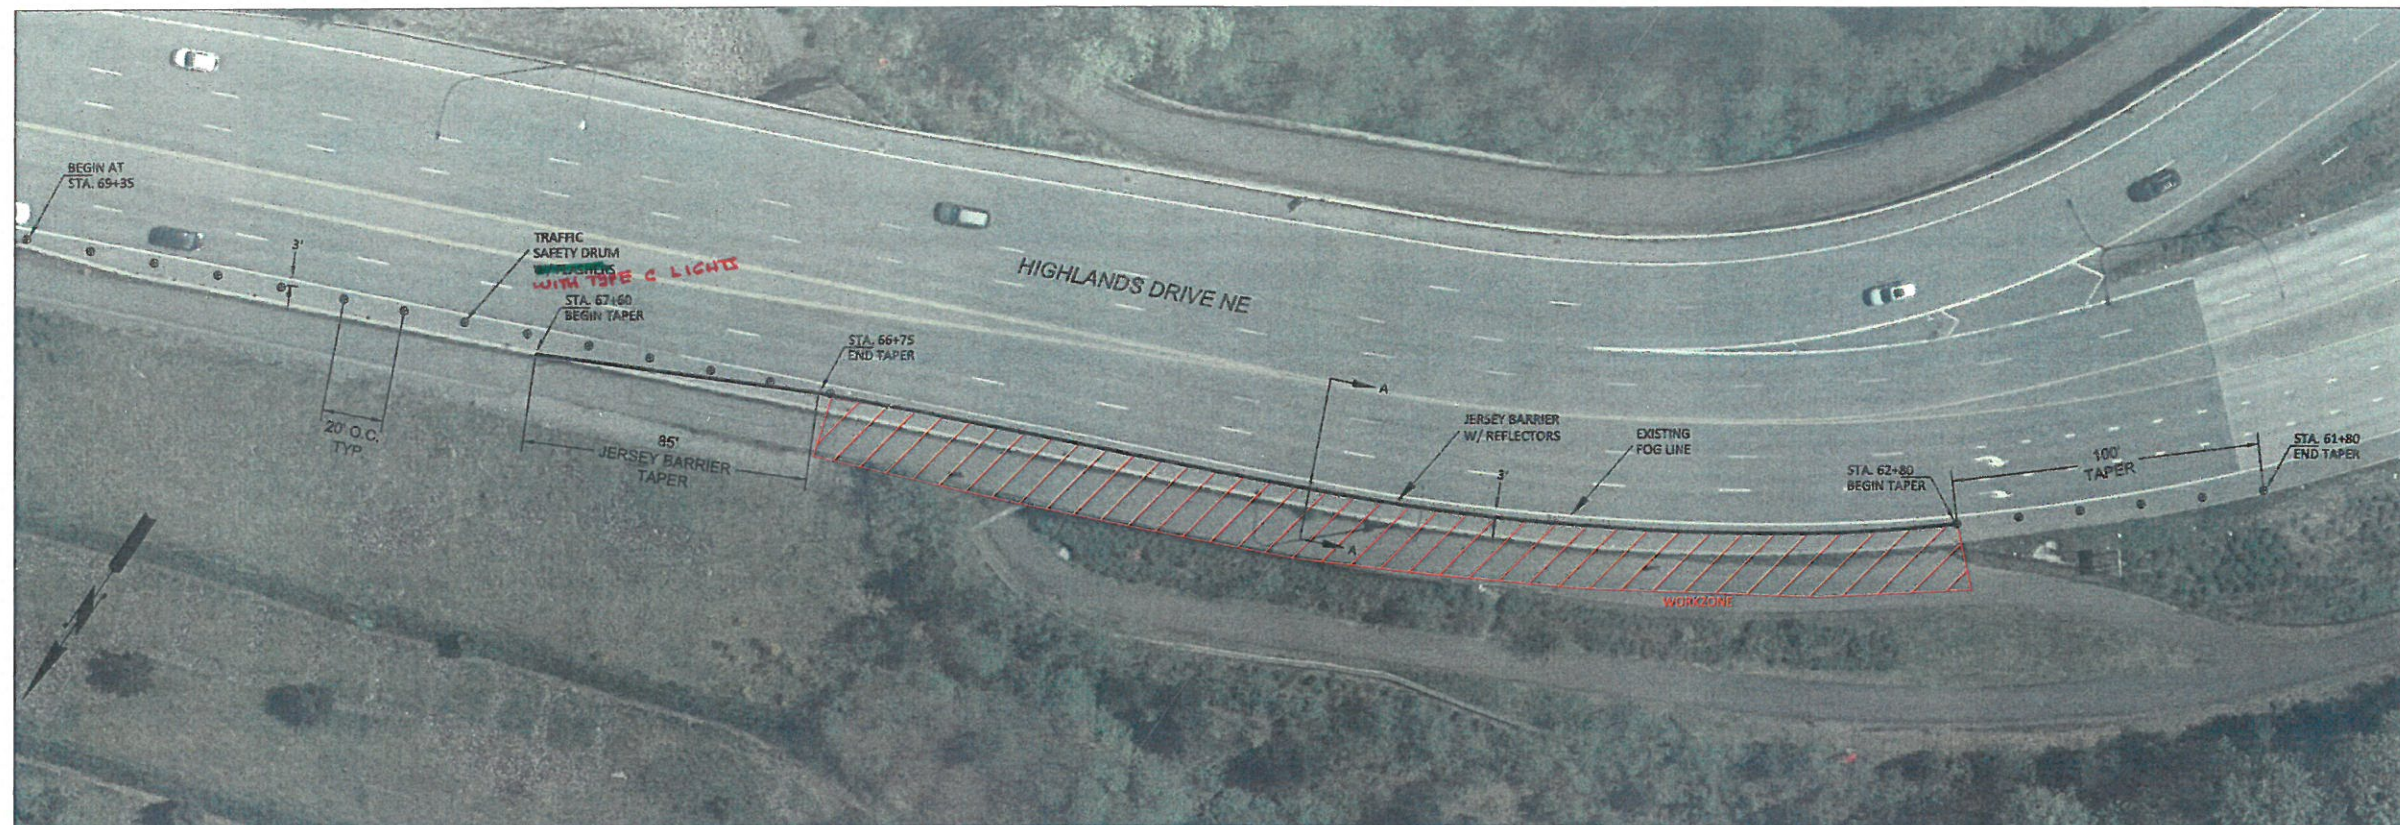

APPROVED AS NOTED
2-12-2020
TRAFFIC OPERATIONS

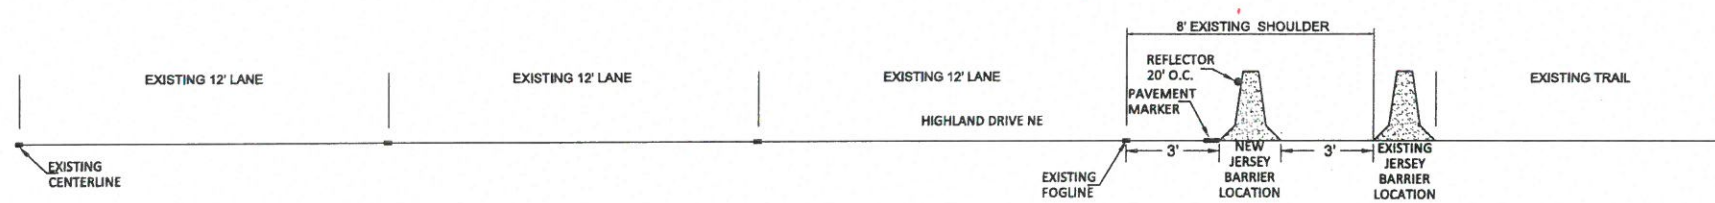

SECTION A-A


NOTE:
WSDOT is approving traffic control within Limited Access only. The existing fence shall remain in place on top of the barrier after the barrier is temporarily moved 3 feet from the fogline.

LEGEND

- ◀ TEMPORARY SIGN LOCATION
- TRAFFIC SAFETY DRUM w/ type C Lights
- JERSEY BARRIER
- ▨ WORK ZONE

- NOTES:**
1. MOVE JERSEY BARRIER 3' BEHIND FOG LINE, AS SHOWN. SEE SECTION A- A.
 2. FOLLOW SIGN SPACING LEGEND, ADJUST AND ADD AS NEEDED.
 3. ENSURE SIGNS ARE VISIBLE TO ONCOMING TRAFFIC.
 4. ~~FLASHING LIGHTS ON BARRIERS~~ REFLECTORS ON BARRIERS.
 5. THE DURATION OF THE JERSEY BARRIER TEMPORARY RELOCATION SHALL NOT EXCEED TWO WEEKS. BOTH THE FENCE AND JERSEY BARRIER SHALL BE RESTORED TO THE ORIGINAL CONDITIONS ONCE THE NEW PIPE IS INSTALLED AND THE FINAL PAVEMENT LAYER IS SET ON THE TRAIL.

NO.	DATE	BY	APPR	REVISION



CITY OF ISSAQUAH
WASHINGTON

DEPARTMENT OF PUBLIC WORKS
P.O. BOX 1307 ISSAQUAH WA 98027 (425) 837-3400

SPAR PUMP STATION

DRN: JT DSGN: TN CHKD: RY

TRAFFIC CONTROL PLAN

DATE: FEB 2020 JOB#: WATR15002 SCALE: 1"=30'


P:\CAD\13\1397005_00_City_of_Issaquah\139700500-EC01.dwg 7/2/2020 4:01 PM MIKE\ARX

GENERAL NOTES

1. APPROVAL OF THIS EROSION AND SEDIMENTATION CONTROL (ESC) PLAN DOES NOT CONSTITUTE AN APPROVAL OF PERMANENT ROAD OR DRAINAGE DESIGN (E.G., SIZE AND LOCATION OF ROADS, PIPES, RESTRICTORS, CHANNELS, RETENTION FACILITIES, UTILITIES, ETC.).
2. THE IMPLEMENTATION OF THESE ESC PLANS AND THE CONSTRUCTION, MAINTENANCE, REPLACEMENT, AND UPGRADING OF THESE ESC FACILITIES IS THE RESPONSIBILITY OF THE APPLICANT/ESC SUPERVISOR UNTIL ALL CONSTRUCTION IS APPROVED.
3. THE BOUNDARIES OF THE CLEARING LIMITS SHOWN ON THIS PLAN SHALL BE CLEARLY FLAGGED BY SURVEY TAPE OR FENCING, IF REQUIRED, PRIOR TO CONSTRUCTION (SWDM APPENDIX D). DURING THE CONSTRUCTION PERIOD, NO DISTURBANCE BEYOND THE CLEARING LIMITS SHALL BE PERMITTED. THE CLEARING LIMITS SHALL BE MAINTAINED BY THE APPLICANT/ESC SUPERVISOR FOR THE DURATION OF CONSTRUCTION.
4. STABILIZED CONSTRUCTION ENTRANCES SHALL BE INSTALLED AT THE BEGINNING OF CONSTRUCTION AND MAINTAINED FOR THE DURATION OF THE PROJECT. ADDITIONAL MEASURES, SUCH AS CONSTRUCTED WHEEL WASH SYSTEMS OR WASH PADS, MAY BE REQUIRED T ENSURE THAT ALL PAVED AREAS ARE KEPT CLEAN AND TRACK OUT TO ROAD RIGHT OF WAY DOES NOT OCCUR FOR THE DURATION OF THE PROJECT.
5. THE ESC FACILITIES SHOWN ON THIS PLAN MUST BE CONSTRUCTED PRIOR TO OR IN CONJUNCTION WITH ALL CLEARING AND GRADING SO AS TO ENSURE THAT THE TRANSPORT OF SEDIMENT TO SURFACE WATERS, DRAINAGE SYSTEMS, AND ADJACENT PROPERTIES IS MINIMIZED.
6. THE ESC FACILITIES SHOWN ON THIS PLAN ARE THE MINIMUM REQUIREMENTS FOR ANTICIPATED SITE CONDITIONS. DURING THE CONSTRUCTION PERIOD, THESE ESC FACILITIES SHALL BE UPGRADED AS NEEDED FOR UNEXPECTED STORM EVENTS AND MODIFIED TO ACCOUNT FOR CHANGING SITE CONDITIONS (E.G. ADDITIONAL COVER MEASURES, ADDITIONAL SUMP PUMPS, RELOCATION OF DITCHES AND SILT FENCES, PERIMETER PROTECTION ETC.) AS DIRECTED BY KING COUNTY.
7. THE ESC FACILITIES SHALL BE INSPECTED DAILY BY THE APPLICANT/ESC SUPERVISOR AND MAINTAINED TO ENSURE CONTINUED PROPER FUNCTIONING. WRITTEN RECORDS SHALL BE KEPT OF WEEKLY REVIEWS OF THE ESC FACILITIES.
8. ANY AREAS OF EXPOSED SOILS, INCLUDING ROADWAY EMBANKMENTS, THAT WILL NOT BE DISTURBED FOR TWO CONSECUTIVE DAYS DURING THE WET SEASON OR SEVEN DAYS DURING THE DRY SEASON SHALL BE IMMEDIATELY STABILIZED WITH THE APPROVED ESC METHODS (E.G., SEEDING, MULCHING, PLASTIC COVERING, ETC.).
9. ANY AREA NEEDING ESC MEASURES THAT DO NOT REQUIRE IMMEDIATE ATTENTION SHALL BE ADDRESSED WITHIN SEVEN (7) DAYS.
10. THE ESC FACILITIES ON INACTIVE SITES SHALL BE INSPECTED AND MAINTAINED A MINIMUM OF ONCE A MONTH DURING THE DRY SEASON, BI-MONTHLY DURING THE WET SEASON, OR WITHIN TWENTY FOUR (24) HOURS FOLLOWING A STORM EVENT.
11. AT NO TIME SHALL MORE THAN ONE (1) FOOT OF SEDIMENT BE ALLOWED TO ACCUMULATE WITHIN A CATCH BASIN. ALL CATCH BASINS AND CONVEYANCE LINES SHALL BE CLEANED PRIOR TO PAVING. THE CLEANING OPERATION SHALL NOT FLUSH SEDIMENT-LADEN WATER INTO THE DOWNSTREAM SYSTEM.
12. ANY PERMANENT RETENTION/DETENTION FACILITY USED AS A TEMPORARY SETTLING BASIN SHALL BE MODIFIED WITH THE NECESSARY EROSION CONTROL MEASURES AND SHALL PROVIDE ADEQUATE STORAGE CAPACITY. IF THE FACILITY IS TO FUNCTION ULTIMATELY AS AN INFILTRATION SYSTEM, THE TEMPORARY FACILITY MUST BE ROUGH GRADED SO THAT THE BOTTOM AND SIDES ARE AT LEAST THREE FEET ABOVE THE FINAL GRADE OF THE PERMANENT FACILITY.
13. PRIOR TO THE BEGINNING OF THE WET SEASON (OCT. 1), ALL DISTURBED AREAS SHALL BE REVIEWED TO IDENTIFY WHICH ONES CAN BE SEEDED IN PREPARATION FOR THE WINTER RAINS. DISTURBED AREAS SHALL BE SEEDED WITHIN ONE WEEK OF THE BEGINNING OF THE WET SEASON. A SKETCH MAP OF THOSE AREAS TO BE SEEDED AND THOSE AREAS TO REMAIN UNCOVERED SHALL BE SUBMITTED TO THE INSPECTOR.

USE OF DOCUMENTS THIS DOCUMENT, INCLUDING THE INCORPORATED DESIGNS, IS AN INSTRUMENT OF SERVICE FOR THIS PROJECT AND SHALL NOT BE USED FOR ANY OTHER PROJECT WITHOUT THE WRITTEN AUTHORIZATION OF KENNEDY/JENKS CONSULTANTS.					<div>SCALES</div> <div><div>01"25mm</div></div> <div>IF THIS BAR IS NOT DIMENSION SHOWN, ADJUST SCALES ACCORDINGLY.</div>	<div>JEFFREY M. FORAY</div> <div>STATE OF WASHINGTON</div> <div>34536</div> <div>REGISTERED</div> <div>PROFESSIONAL ENGINEER</div>	DESIGNED	<div></div>	CITY OF ISSAQUAH ISSAQUAH, WASHINGTON SOUTH SPAR BOOSTER PUMP STATION	Kennedy/Jenks Consultants FEDERAL WAY, WASHINGTON	EROSION AND SEDIMENTATION CONTROL GENERAL NOTES		FILE NAME
	DRAWN	139700500-EC01.DWG											
	CHECKED	JOB NO.											
	MDL	1397005*00											
		DATE											
	NO.	REVISION	DATE	BY			90% SUBMITTAL (REVISED 7/1/2020)		JUNE 2020	SHEET			
									15 OF 83	EC01			

6/30/2020 7:04 PM
NICOLASLOZANORDONEZ
\\FWY01\cad\CAD\13\1397005-00_City_of_Issaquah\139700500-EC02.dwg

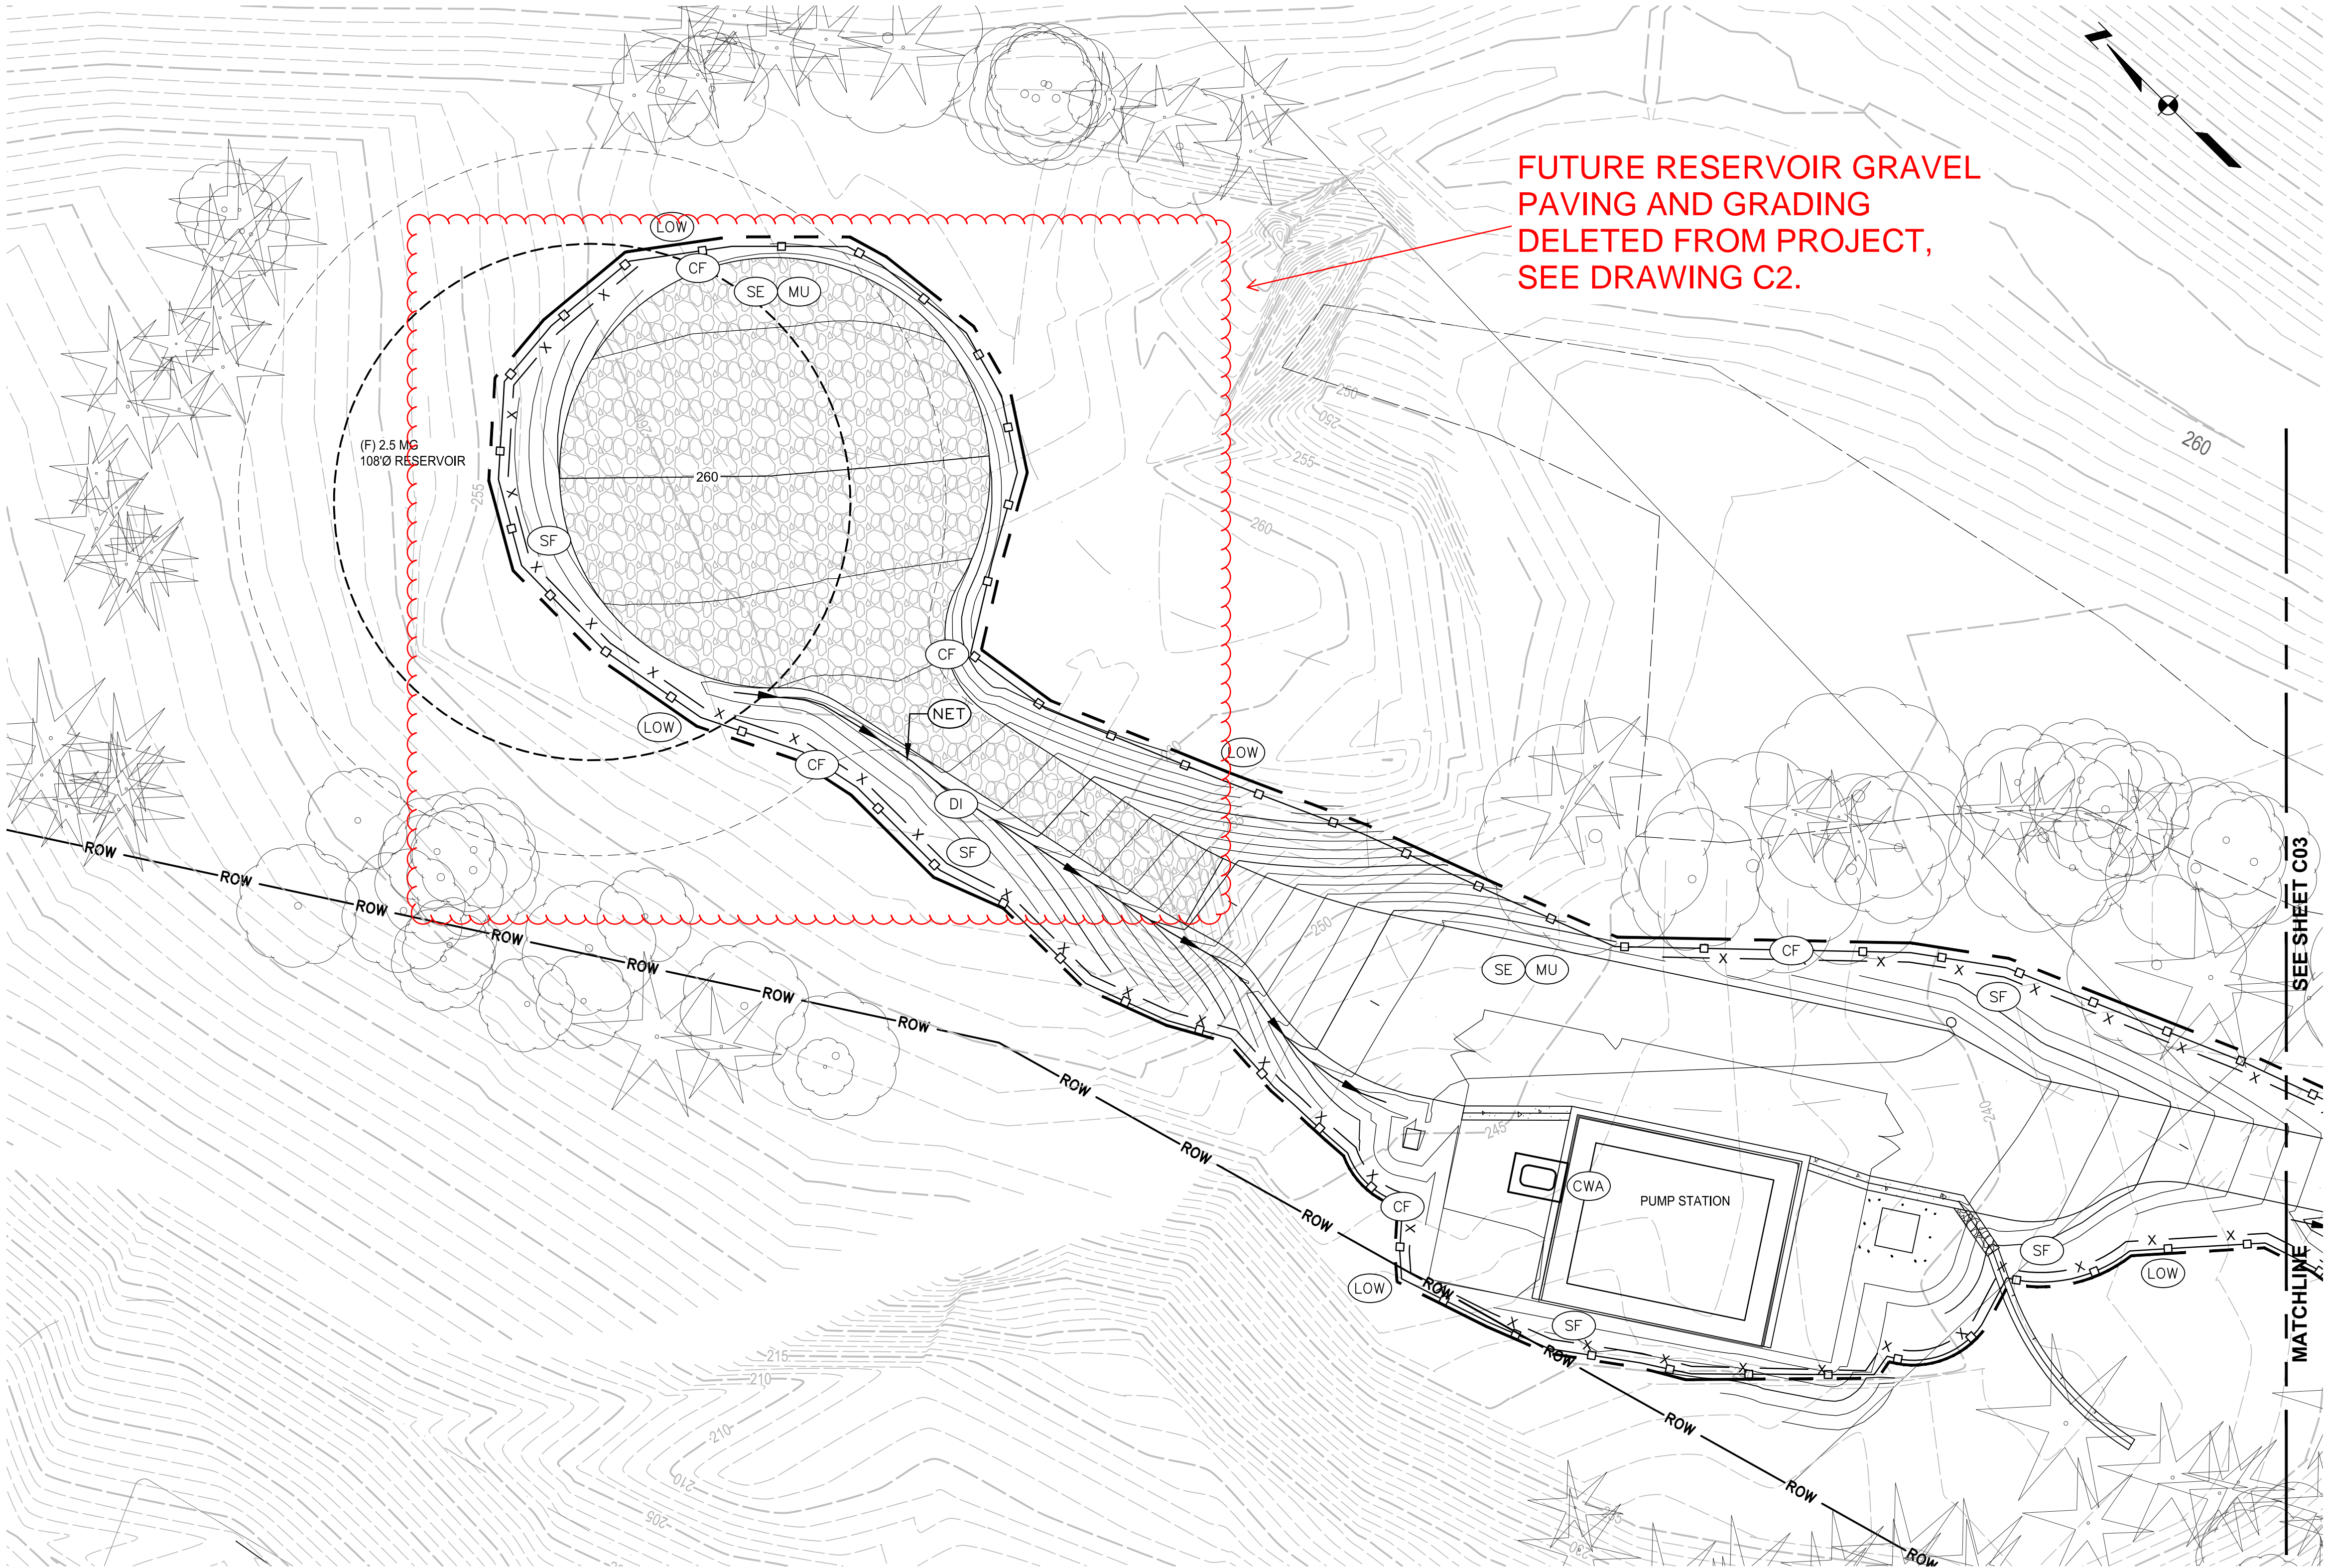

PLAN
0 10 20 30
1"=20'

- NOTES:**
1. ALL ESC MEASURES SHOWN ARE CONSIDERED INITIAL AND INTERIM. EXCEPT FOR SEEDING AND MULCHING, WHICH ARE FINAL.
 2. ALL ESC MEASURES SHALL BE REMOVED UPON COMPLETION OF SITE STABILIZATION.
 3. INSTALL EROSION CONTROL BLANKET IN PROPOSED DITCH.
 4. PROVIDE TEMPORARY CONSTRUCTION FENCING AT ALL WORK LIMITS.

ESC LEGEND:

---	(LOW)	WORK LIMITS
— x —	(SF)	SILT FENCE
— □ —	(CF)	CONSTRUCTION FENCE
□	(IP)	INLET PROTECTION
▨	(CE)	CONSTRUCTION ENTRANCE
— —	(DI)	DITCH WITH CHECK DAMS
□	(CWA)	CONCRETE WASHOUT
○	(SE)	SEEDING
○	(MU)	MULCHING
○	(NET)	NETS AND BLANKETS

SEE SHEET C03

MATCHLINE

USE OF DOCUMENTS

THIS DOCUMENT, INCLUDING THE INCORPORATED DESIGNS, IS AN INSTRUMENT OF SERVICE FOR THIS PROJECT AND SHALL NOT BE USED FOR ANY OTHER PROJECT WITHOUT THE WRITTEN AUTHORIZATION OF KENNEDY/JENKS CONSULTANTS.

NO.	REVISION	DATE	BY

SCALES
0 1" 25mm
IF THIS BAR IS NOT DIMENSION SHOWN, ADJUST SCALES ACCORDINGLY.



DESIGNED
DRP
DRAWN
DRP
CHECKED
MDL




CITY OF ISSAQUAH
ISSAQUAH, WASHINGTON
SOUTH SPAR BOOSTER PUMP STATION

Kennedy/Jenks Consultants
FEDERAL WAY, WASHINGTON

SITE EROSION CONTROL PLAN


90% SUBMITTAL (REVISED 7/1/2020)

FILE NAME 139700500-EC02.DWG
JOB NO. 1397005*00
DATE JUNE 2020
SHEET 16 OF 83 EC02

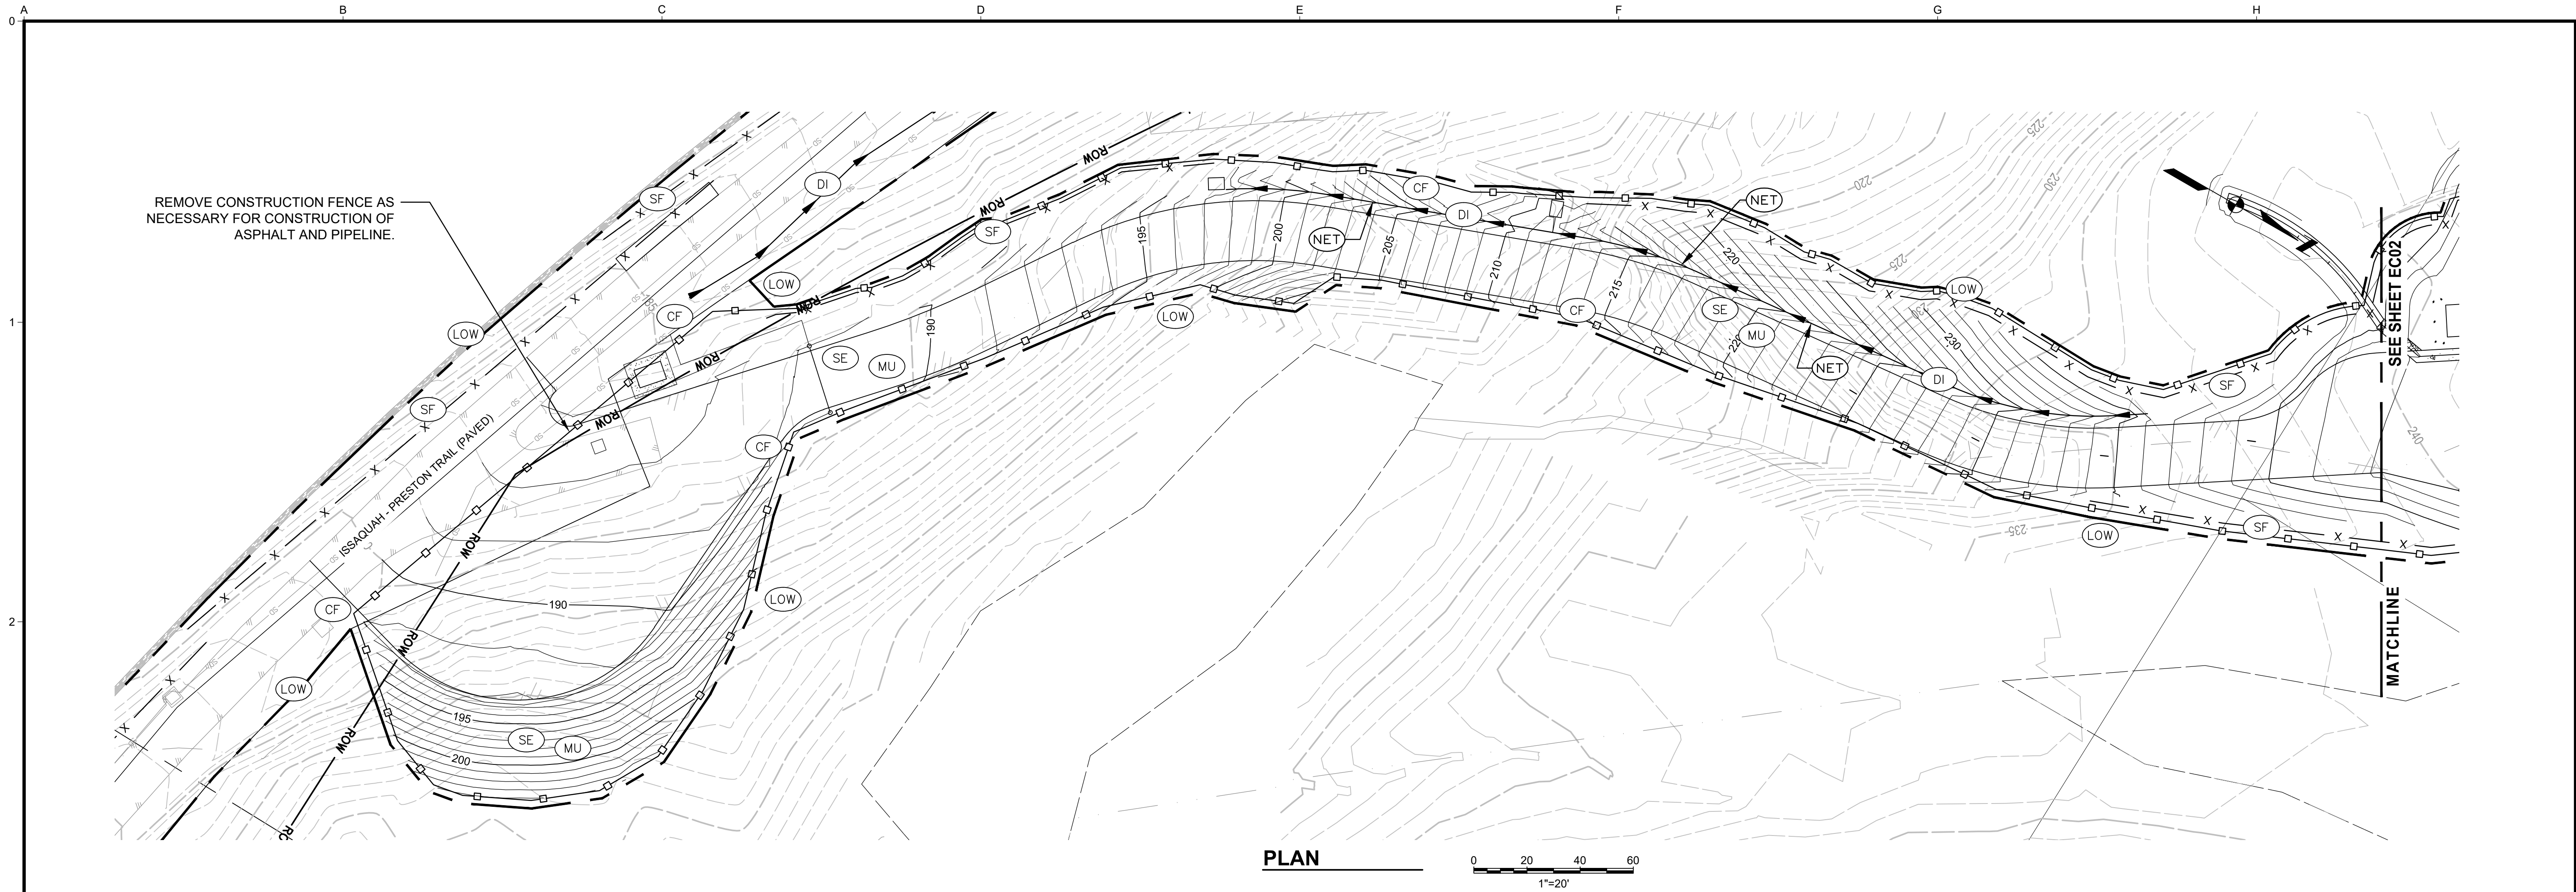


- NOTES:
- ALL ESC MESAURES SHOWN ARE CONSIDERED INITIAL AND INTERIM, EXCEPT FOR SEEDING AND MULCHING, WHICH ARE FINAL.
 - ALL ESC MEASURES SHALL BE REMOVED UPON COMPLETION OF SITE STABILIZATION.
 - INSTALL EROSION CONTROL BLANKET IN PROPOSED DITCH.
 - PROVIDE TEMPORARY CONSTRUCTION FENCING AT ALL WORK LIMITS.

- ESC LEGEND:
- | | | |
|--|-------|-----------------------|
| | (LOW) | WORK LIMITS |
| | (SF) | SILT FENCE |
| | (CF) | CONSTRUCTION FENCE |
| | (IP) | INLET PROTECTION |
| | (CE) | CONSTRUCTION ENTRANCE |
| | (DI) | DITCH WITH CHECK DAMS |
| | (CWA) | CONCRETE WASHOUT |
| | (SE) | SEEDING |
| | (MU) | MULCHING |
| | (NET) | NETS AND BLANKETS |



USE OF DOCUMENTS THIS DOCUMENT, INCLUDING THE INCORPORATED DESIGNS, IS AN INSTRUMENT OF SERVICE FOR THIS PROJECT AND SHALL NOT BE USED FOR ANY OTHER PROJECT WITHOUT THE WRITTEN AUTHORIZATION OF KENNEDY/JENKS CONSULTANTS.					<div>SCALES</div> <div><div>0</div><div>1"</div></div> <div><div>0</div><div>25mm</div></div> <div>IF THIS BAR IS NOT DIMENSION SHOWN, ADJUST SCALES ACCORDINGLY.</div>	<div><div>JEFFREY M. FORAY</div><div>STATE OF WASHINGTON</div><div><div>34536</div><div>REGISTERED</div></div><div>PROFESSIONAL ENGINEER</div></div>	DESIGNED	<div></div> <div>CITY OF ISSAQUAH</div> <div>ISSAQUAH, WASHINGTON</div> <div>SOUTH SPAR BOOSTER PUMP STATION</div>	<div>SITE EROSION CONTROL PLAN</div> <div>90% SUBMITTAL (REVISED 7/1/2020)</div>		FILE NAME
	KSP	139700500-EC03.DWG									
	DRAWN	JOB NO.									
	LMM	1397005*00									
	CHECKED	DATE									
MDL	JUNE 2020										
Kennedy/Jenks Consultants							FEDERAL WAY, WASHINGTON		SHEET 17 OF 83		
NO.							REVISION		DATE		
BY									EC03		

6/24/2020 11:38 PM
DANPHIPPS
\\FWY01\\cad\\CAD\\13\\1397005_00_City_of_Issaquah\\139700500-EC05.dwg

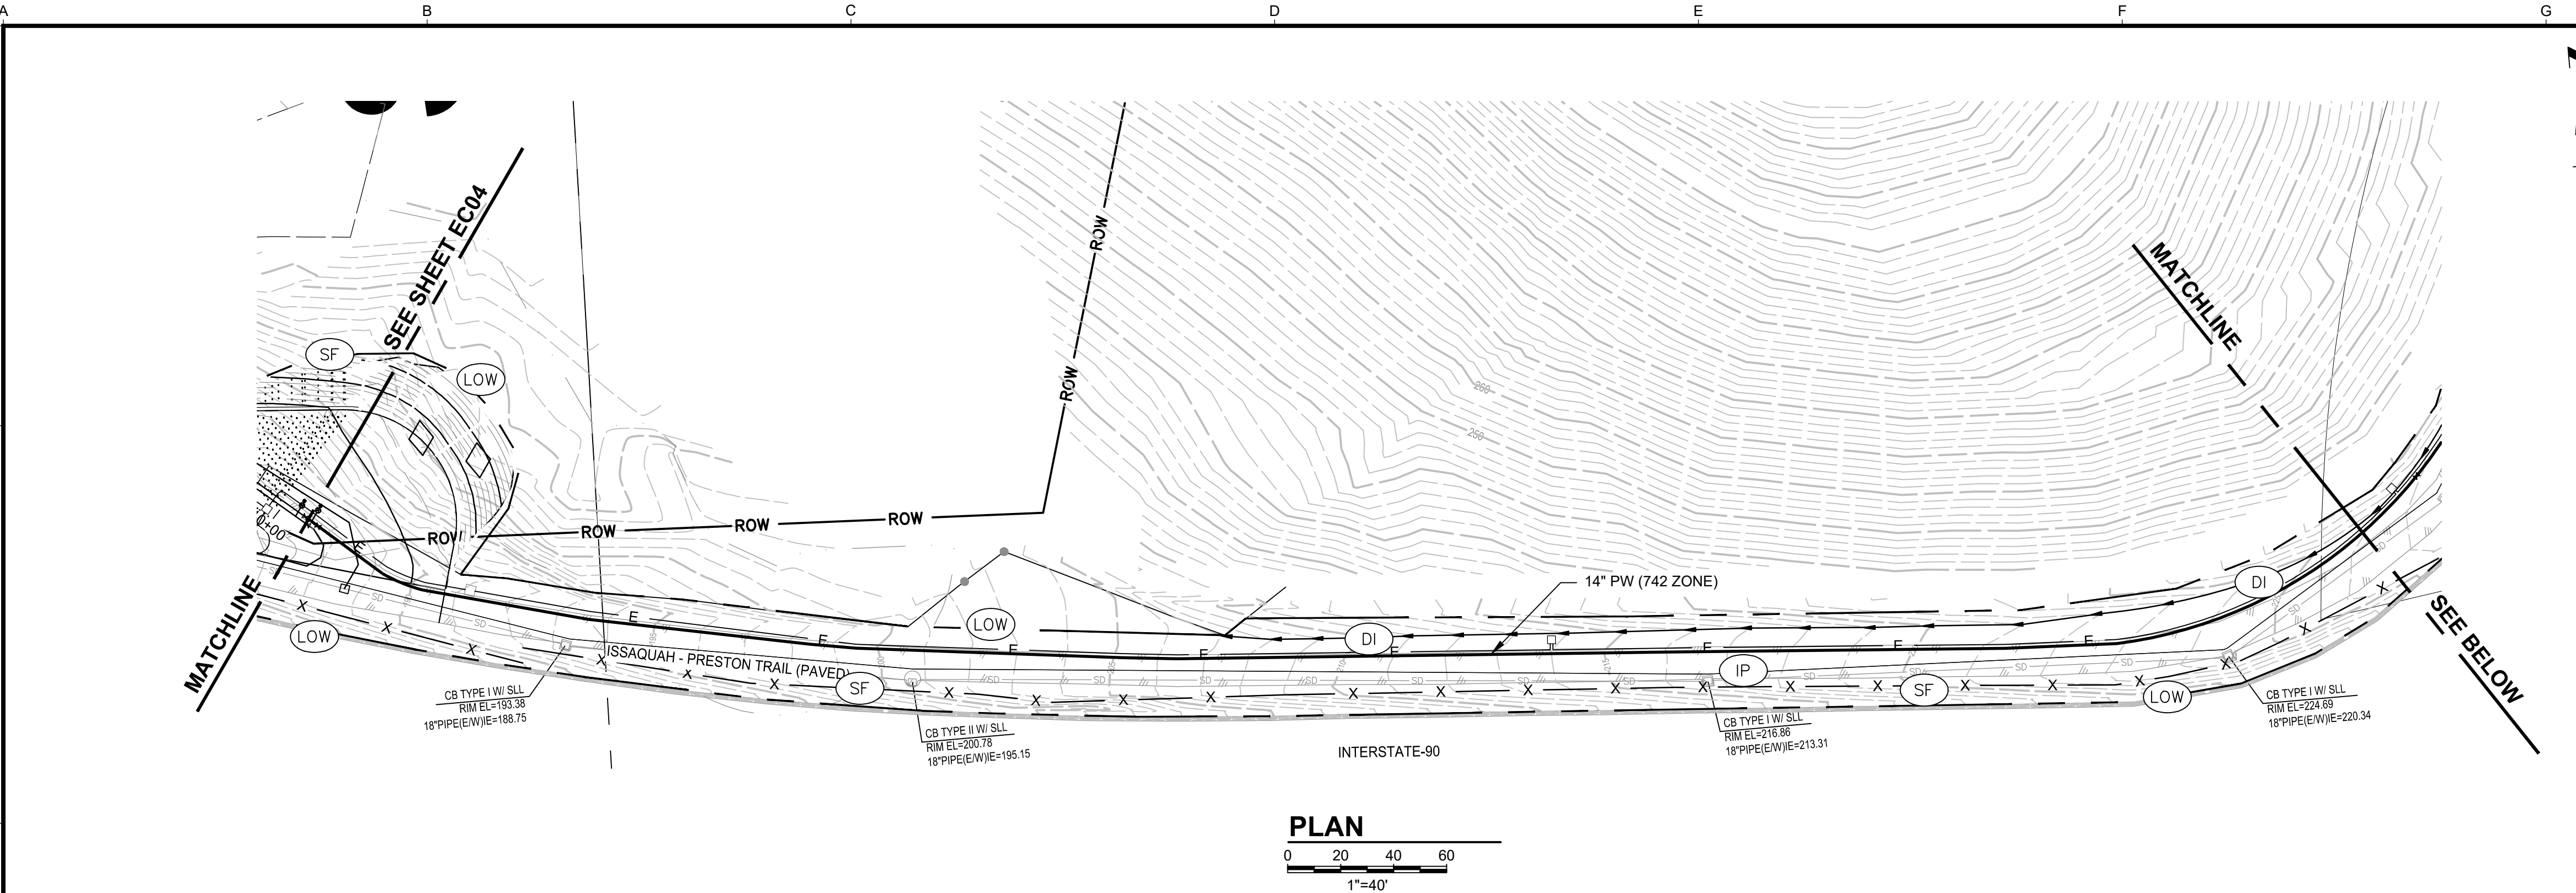






- NOTES:**
1. ALL ESC MEASURES SHOWN ARE CONSIDERED INITIAL AND INTERIM, EXCEPT FOR SEEDING AND MULCHING, WHICH ARE FINAL.
 2. ALL ESC MEASURES SHALL BE REMOVED UPON COMPLETION OF SITE STABILIZATION.
 3. INSTALL EROSION CONTROL BLANKET IN PROPOSED DITCH.


- ESC LEGEND:**
- (LOW) WORK LIMITS
 - X --- (SF) SILT FENCE
 - [] (IP) INLET PROTECTION
 - [] (CE) CONSTRUCTION ENTRANCE
 - [] (DI) DITCH WITH CHECK DAMS
 - [] (CWA) CONCRETE WASHOUT
 - [] (SE) SEEDING
 - [] (MU) MULCHING
 - [] (NET) NETS AND BLANKETS

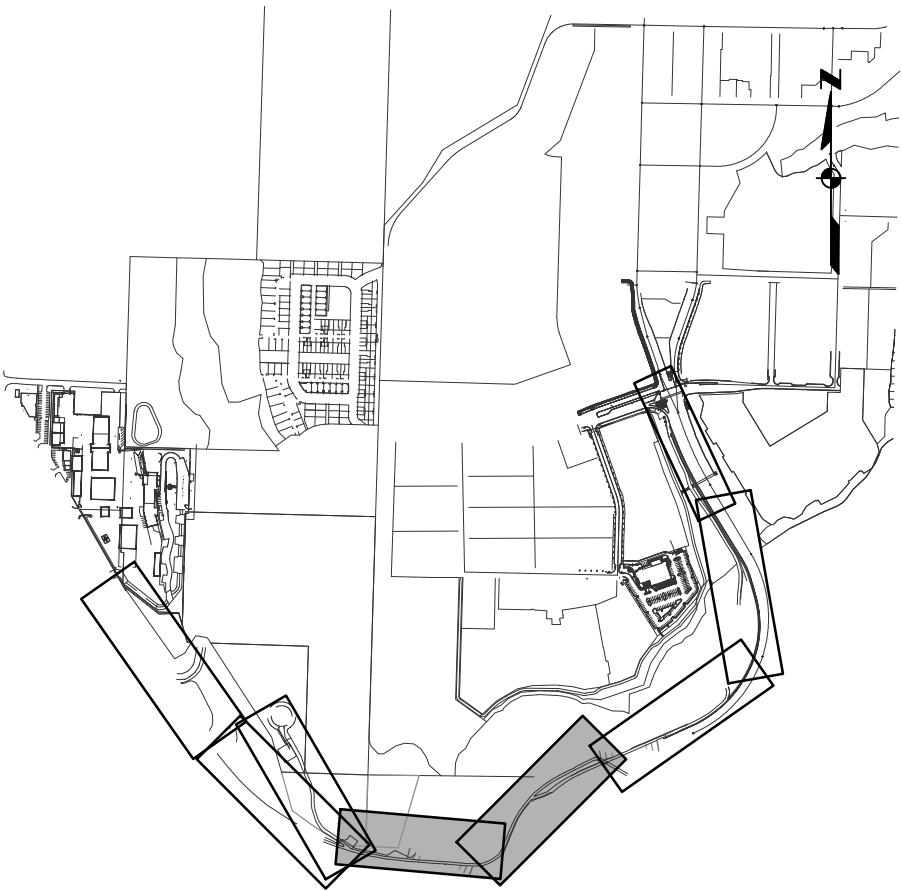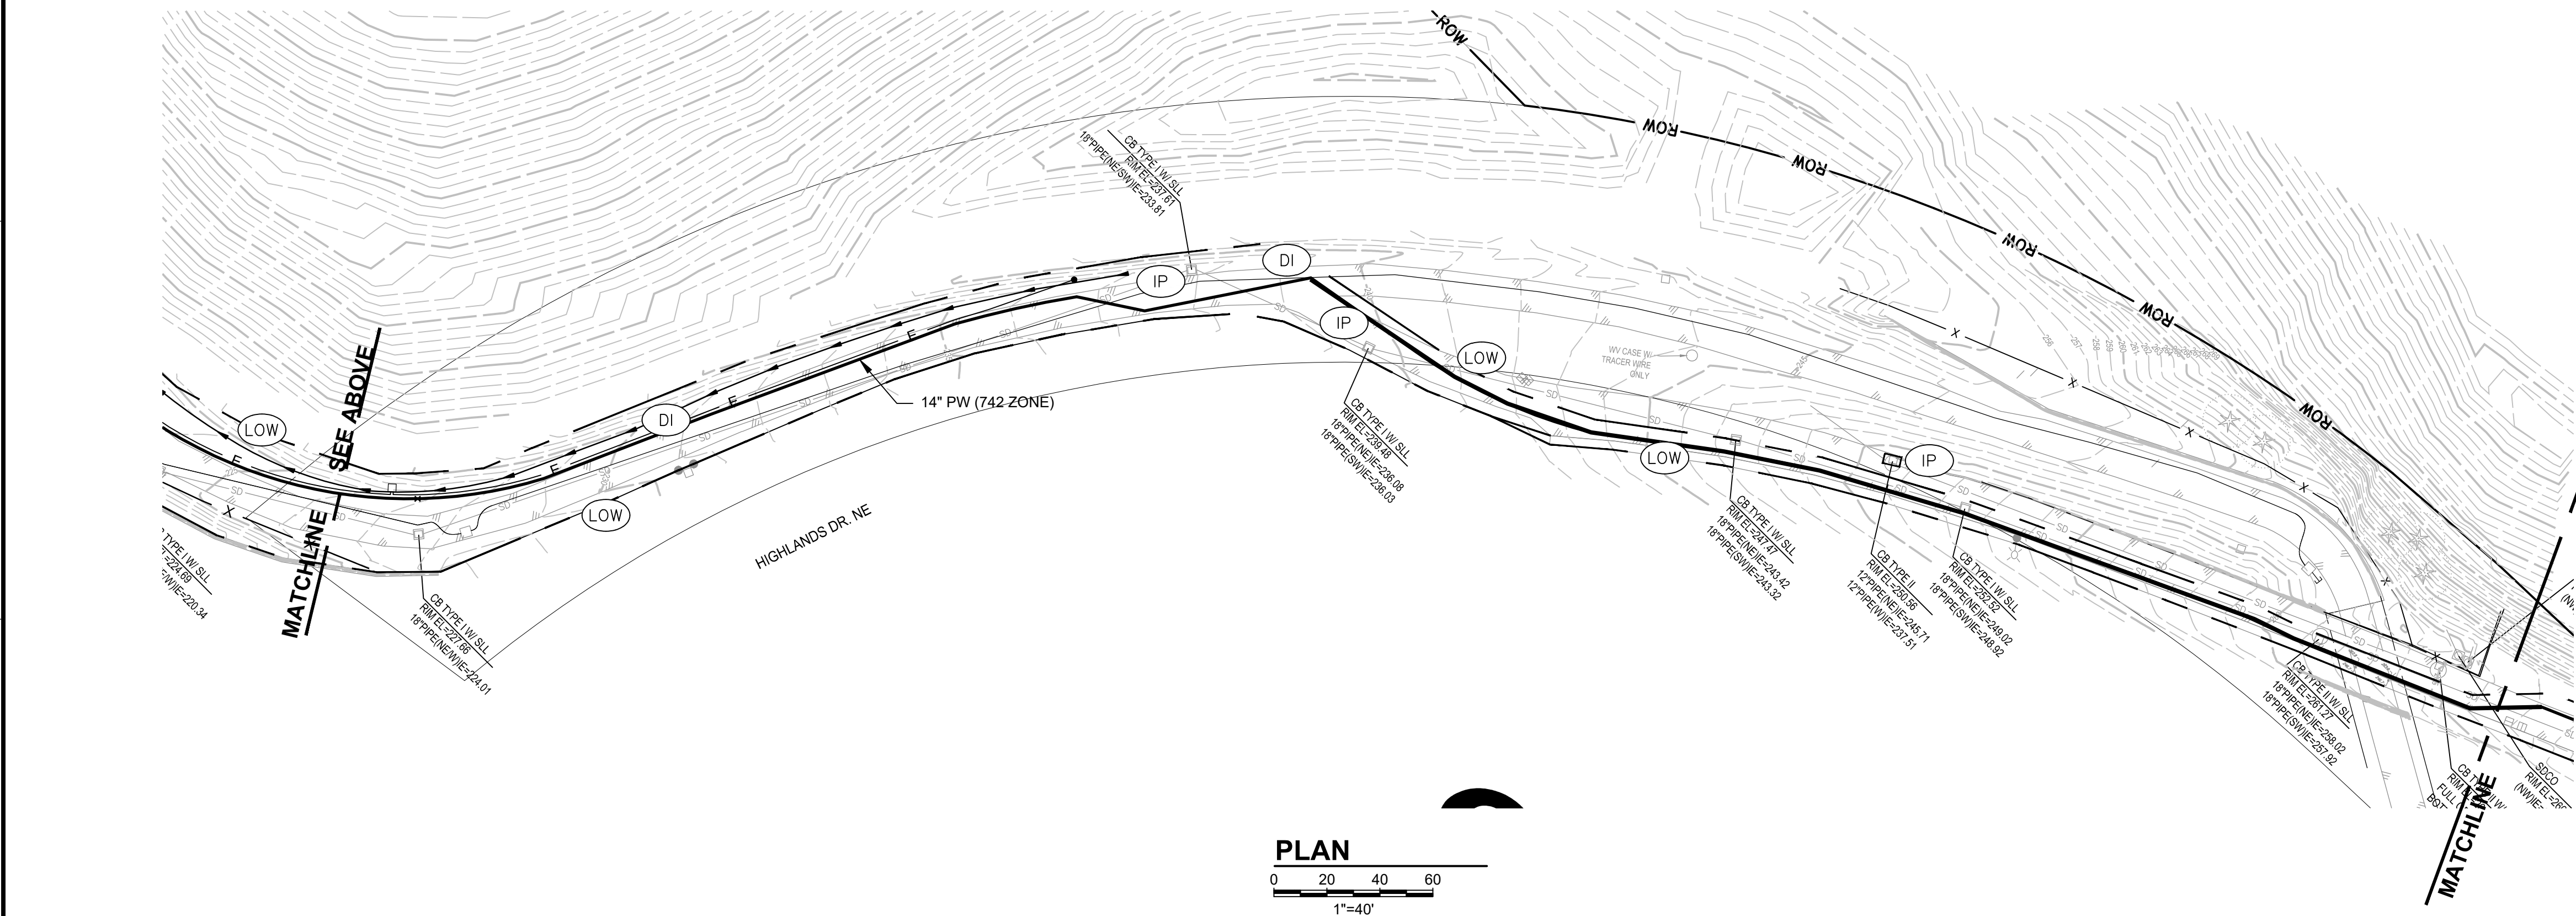


KEY PLAN
SCALE NONE

<p>USE OF DOCUMENTS</p> <p>THIS DOCUMENT, INCLUDING THE INCORPORATED DESIGNS, IS AN INSTRUMENT OF SERVICE FOR THIS PROJECT AND SHALL NOT BE USED FOR ANY OTHER PROJECT WITHOUT THE WRITTEN AUTHORIZATION OF KENNEDY/JENKS CONSULTANTS.</p>				<p>DESIGNED KSP</p> <p>DRAWN LMM</p> <p>CHECKED MDL</p>				<p>CITY OF ISSAQUAH ISSAQUAH, WASHINGTON</p> <p>SOUTH SPAR BOOSTER PUMP STATION</p> <p>Kennedy/Jenks Consultants FEDERAL WAY, WASHINGTON</p>				<p>SITE EROSION CONTROL PLAN</p> <p>90% SUBMITTAL (REVISED 7/1/2020)</p>				<p>FILE NAME 139700500-EC05.DWG</p> <p>JOB NO. 1397005*00</p> <p>DATE JUNE 2020</p> <p>SHEET 19 OF 83 EC05</p>			
NO.	REVISION	DATE	BY	<p>SCALES</p> <p>0 1" 0 25mm</p> <p>IF THIS BAR IS NOT DIMENSION SHOWN, ADJUST SCALES ACCORDINGLY.</p>				<p>JEFFREY M. FORAY STATE OF WASHINGTON REGISTERED PROFESSIONAL ENGINEER 34536</p>											

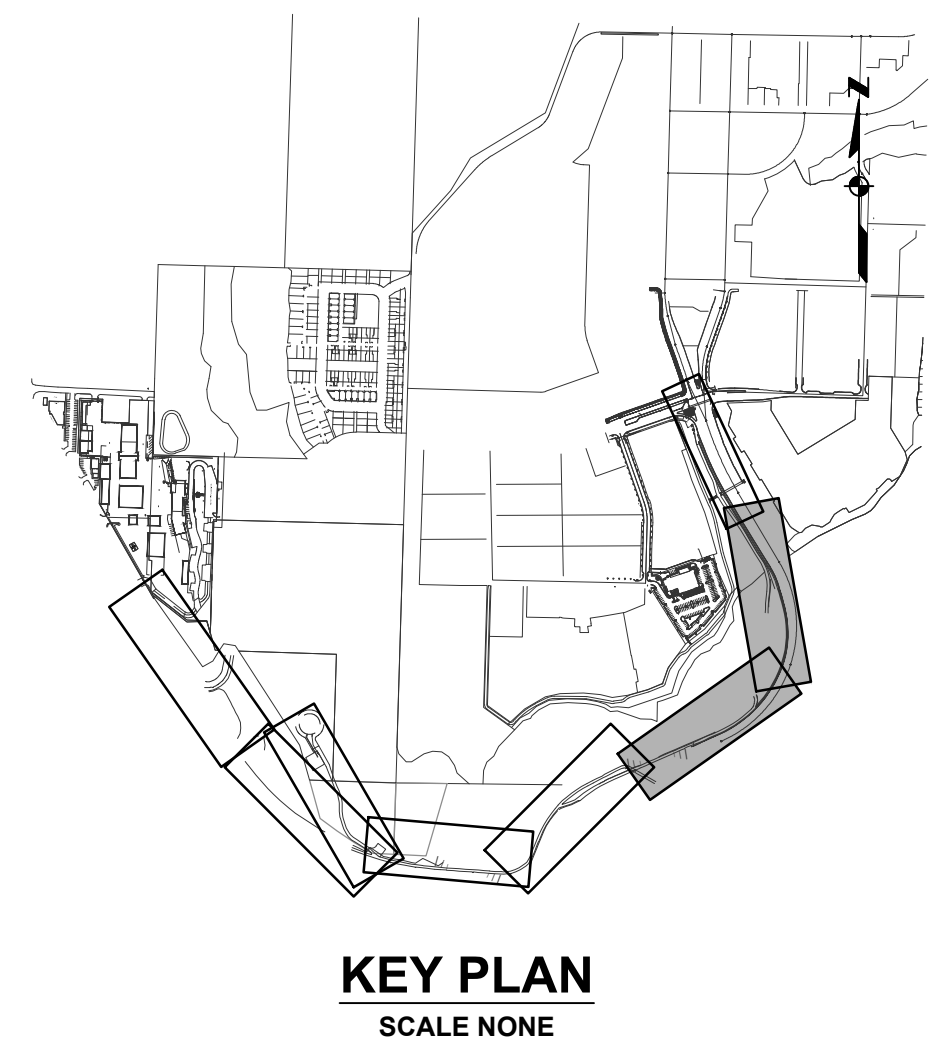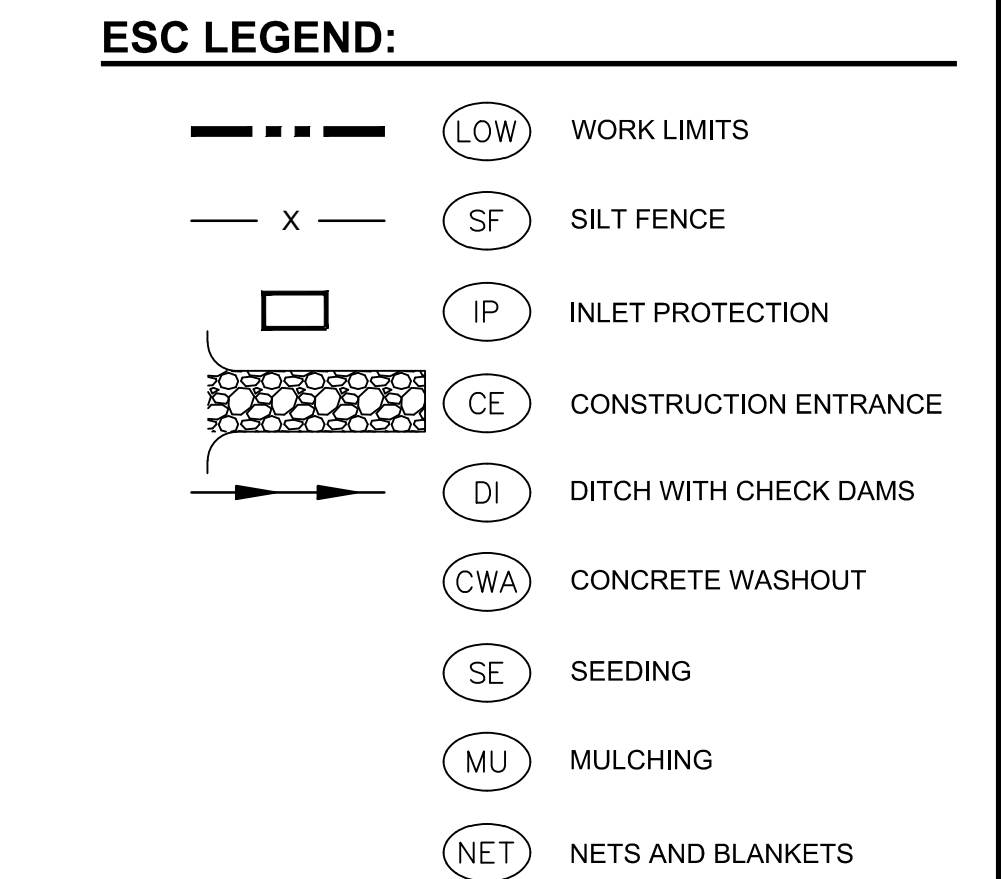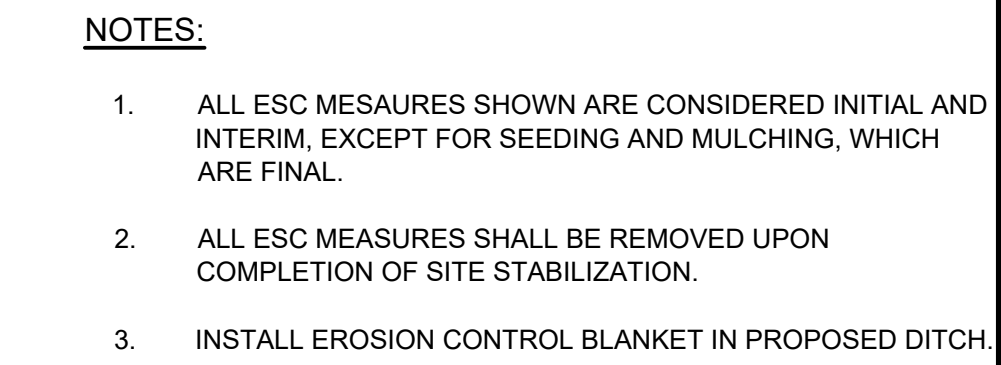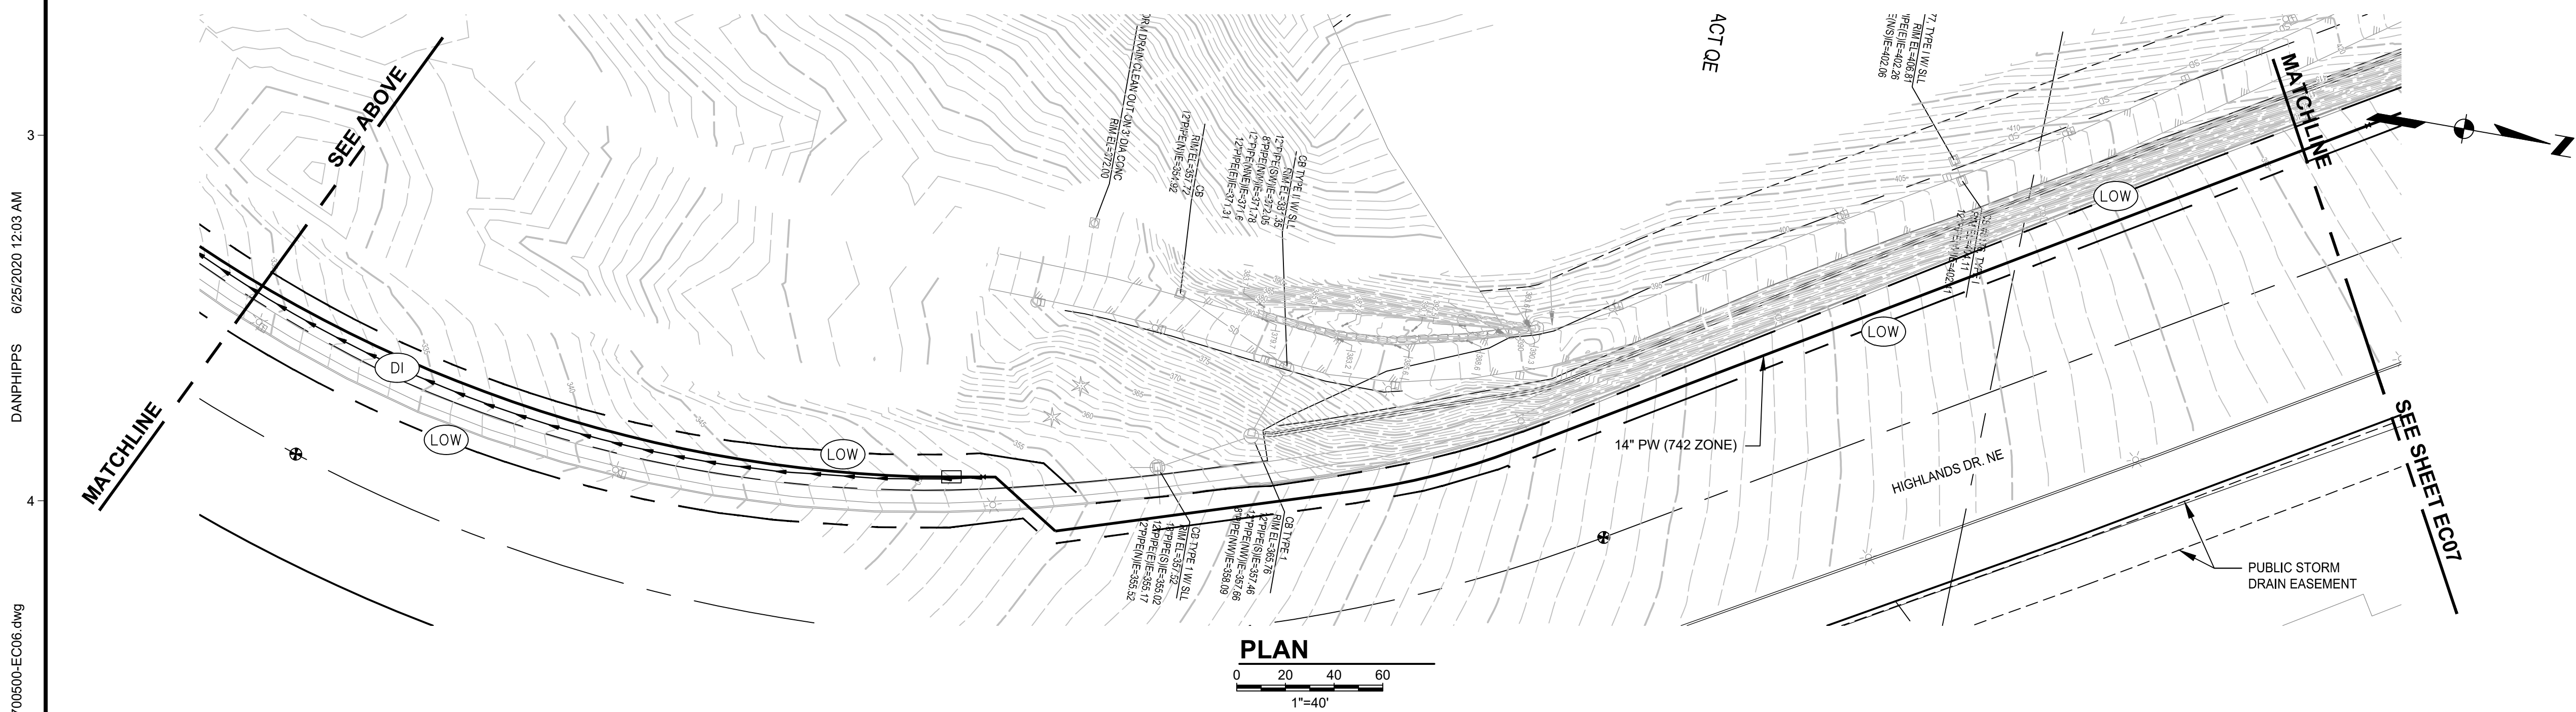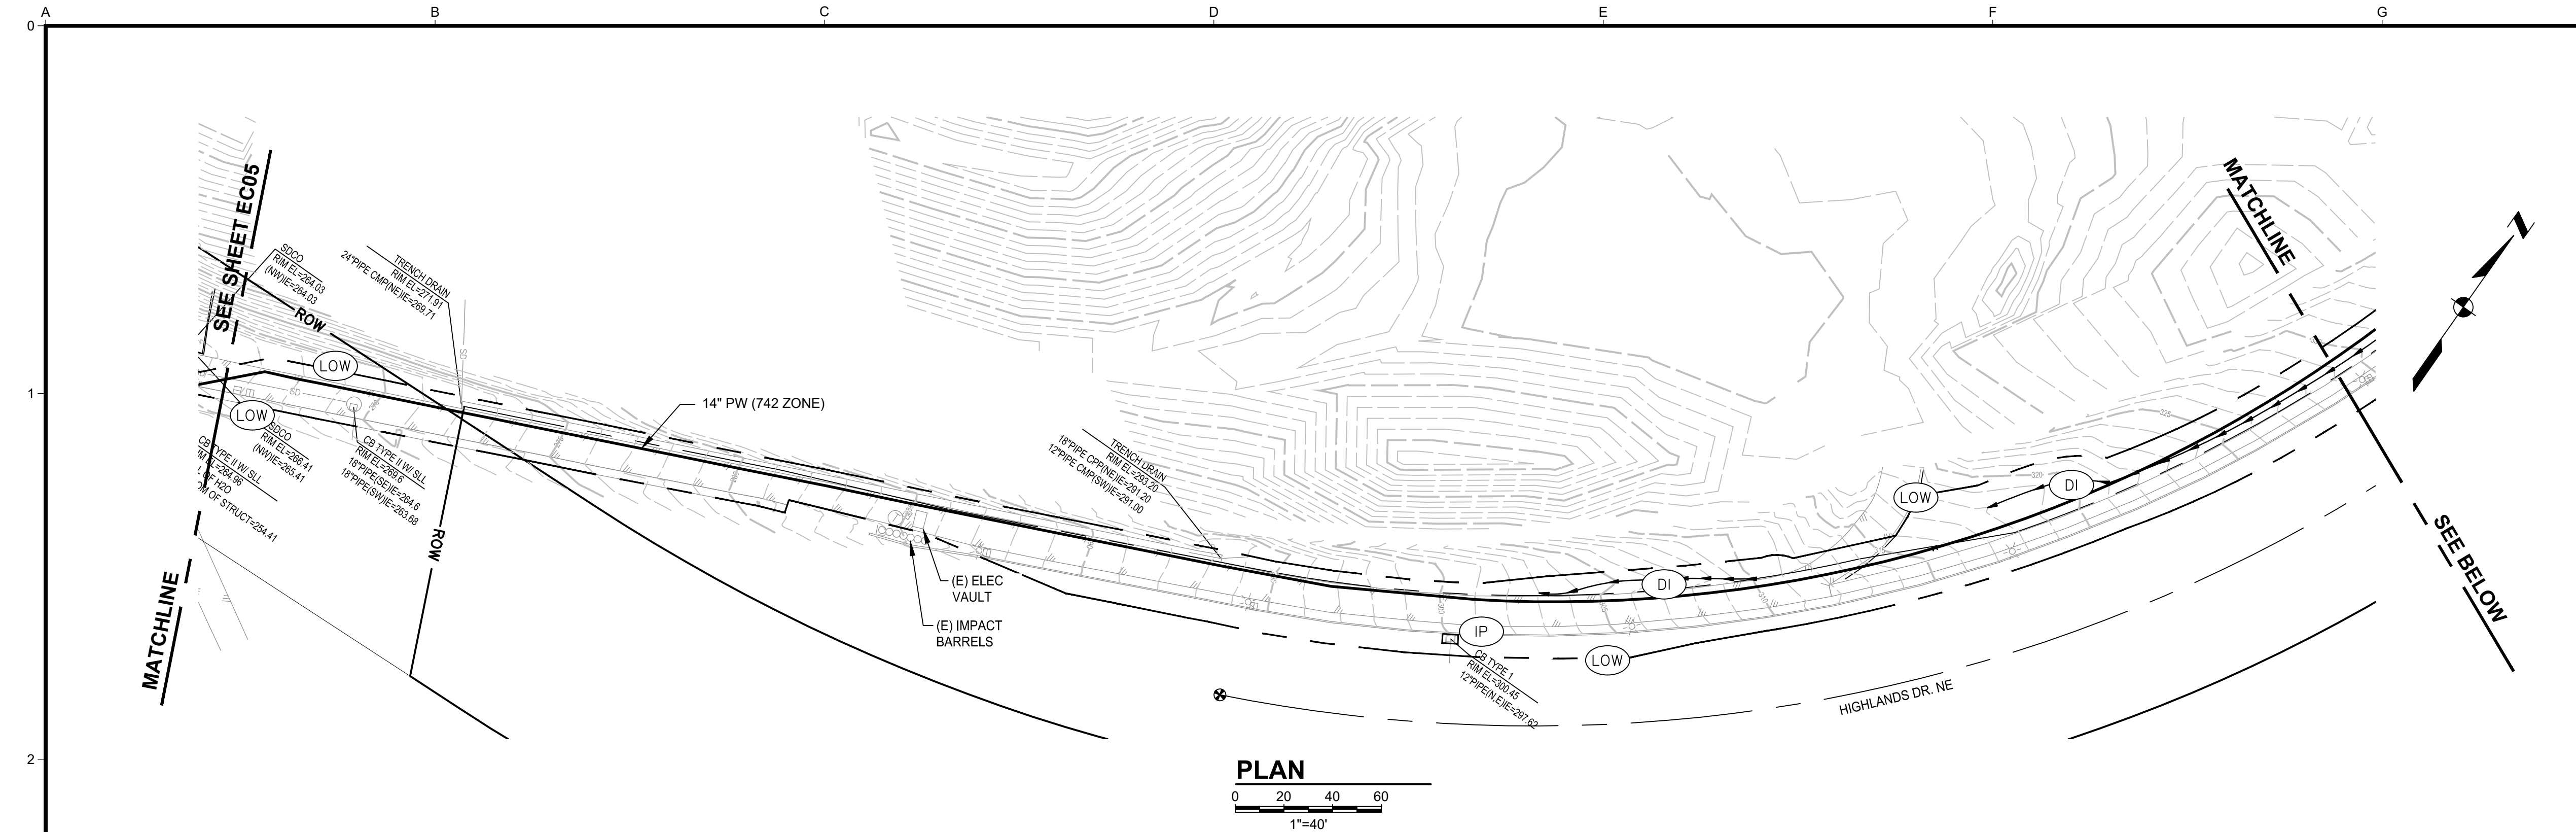

<div>USE OF DOCUMENTS</div> <div>THIS DOCUMENT, INCLUDING THE INCORPORATED DESIGNS, IS AN INSTRUMENT OF SERVICE FOR THIS PROJECT AND SHALL NOT BE USED FOR ANY OTHER PROJECT WITHOUT THE WRITTEN AUTHORIZATION OF KENNEDY/JENKS CONSULTANTS.</div>					<div>SCALES</div> <div><div>01"025mm</div></div> <div>IF THIS BAR IS NOT DIMENSION SHOWN, ADJUST SCALES ACCORDINGLY.</div>	<div><div>JEFFREY M. FORAY</div><div>STATE OF WASHINGTON</div><div><div>34536</div>REGISTERED</div>PROFESSIONAL ENGINEER</div>	DESIGNED	<div></div> <div>CITY OF ISSAQUAH ISSAQUAH, WASHINGTON</div> <div>SOUTH SPAR BOOSTER PUMP STATION</div>	<div>90% SUBMITTAL (REVISED 7/1/2020)</div>	FILE NAME
							139700500-EC06.DWG			
							JOB NO.			
							1397005*00			
									DATE	
									JUNE 2020	
									SHEET 20 OF 83	
									EC06	


\\FWY01\cad\CAD\13\1397005_00_City_of_Issaquah\139700500-EC07.dwg 6/24/2020 11:51 AM DANPHIPPS

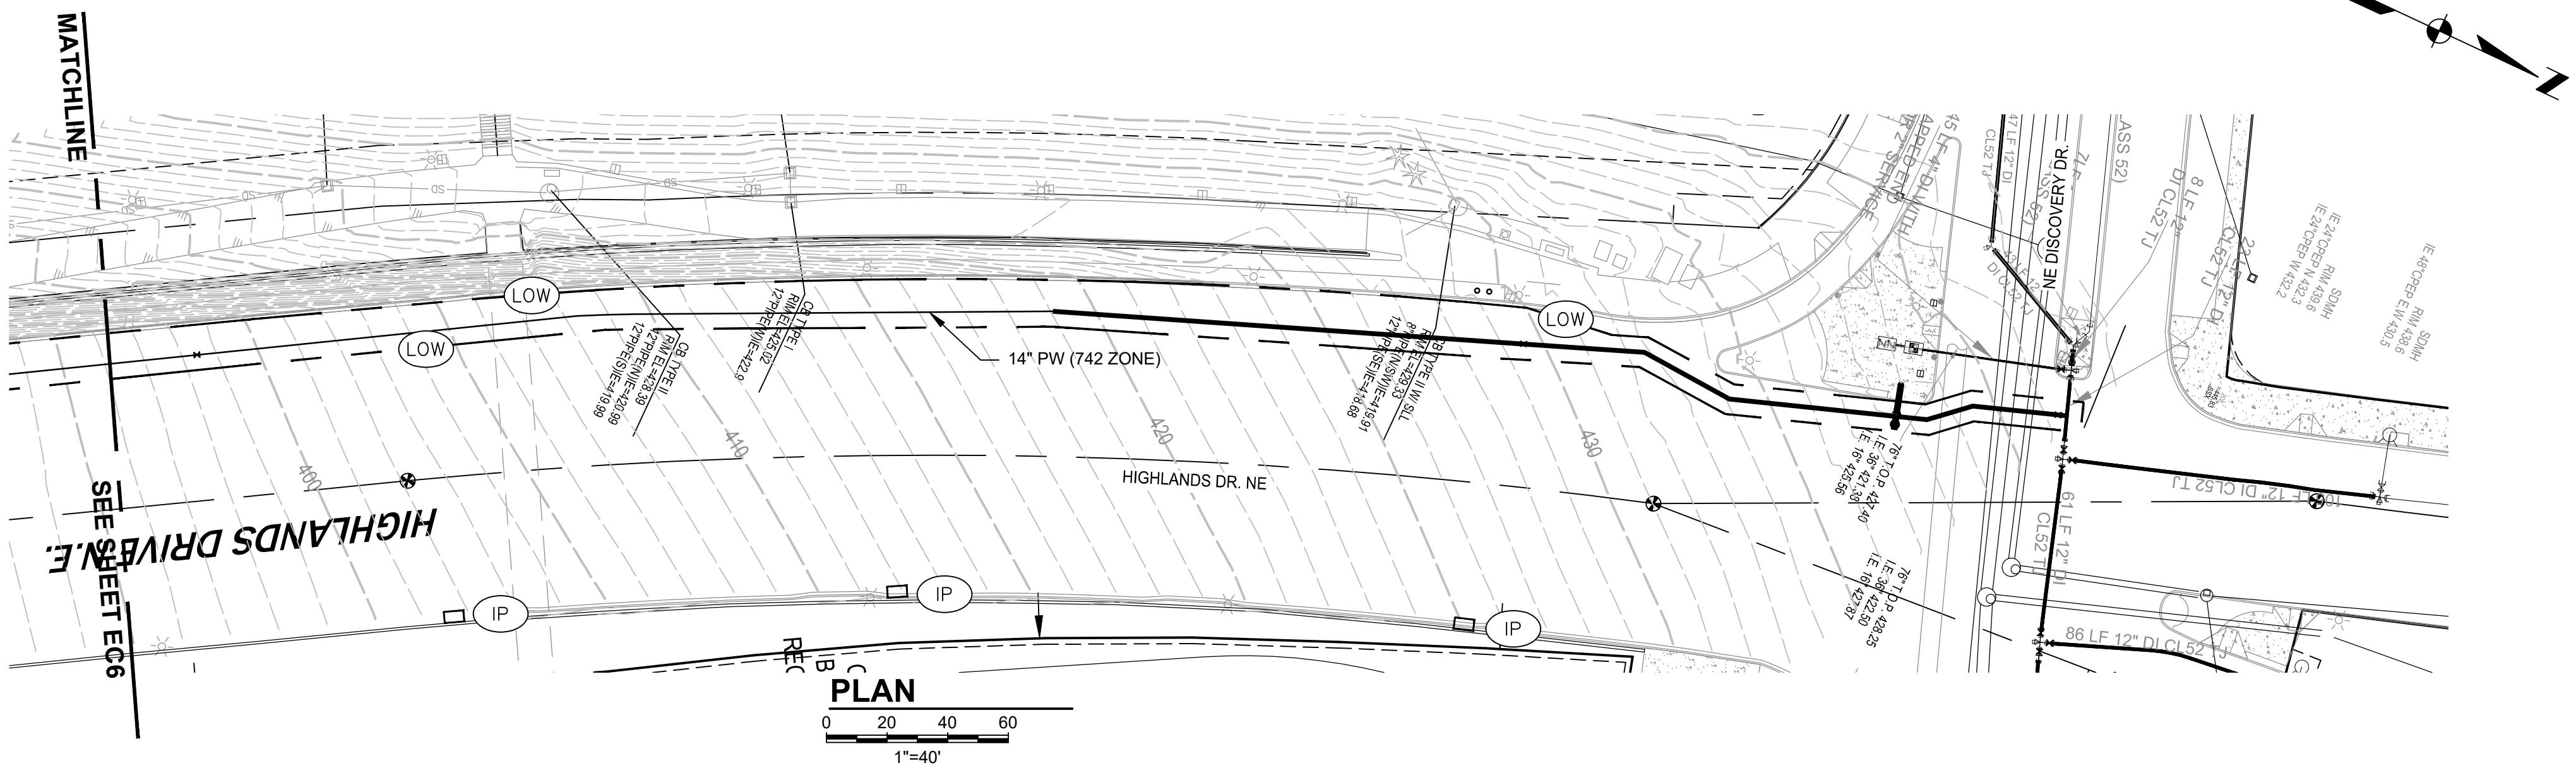

- NOTES:**
1. ALL ESC MESAURES SHOWN ARE CONSIDERED INITIAL AND INTERIM, EXCEPT FOR SEEDING AND MULCHING, WHICH ARE FINAL.
 2. ALL ESC MEASURES SHALL BE REMOVED UPON COMPLETION OF SITE STABILIZATION.
 3. INSTALL EROSION CONTROL BLANKET IN PROPOSED DITCH.

ESC LEGEND:

	(LOW)	WORK LIMITS
	(SF)	SILT FENCE
	(IP)	INLET PROTECTION
	(CE)	CONSTRUCTION ENTRANCE
	(DI)	DITCH WITH CHECK DAMS
	(CWA)	CONCRETE WASHOUT
	(SE)	SEEDING
	(MU)	MULCHING
	(NET)	NETS AND BLANKETS

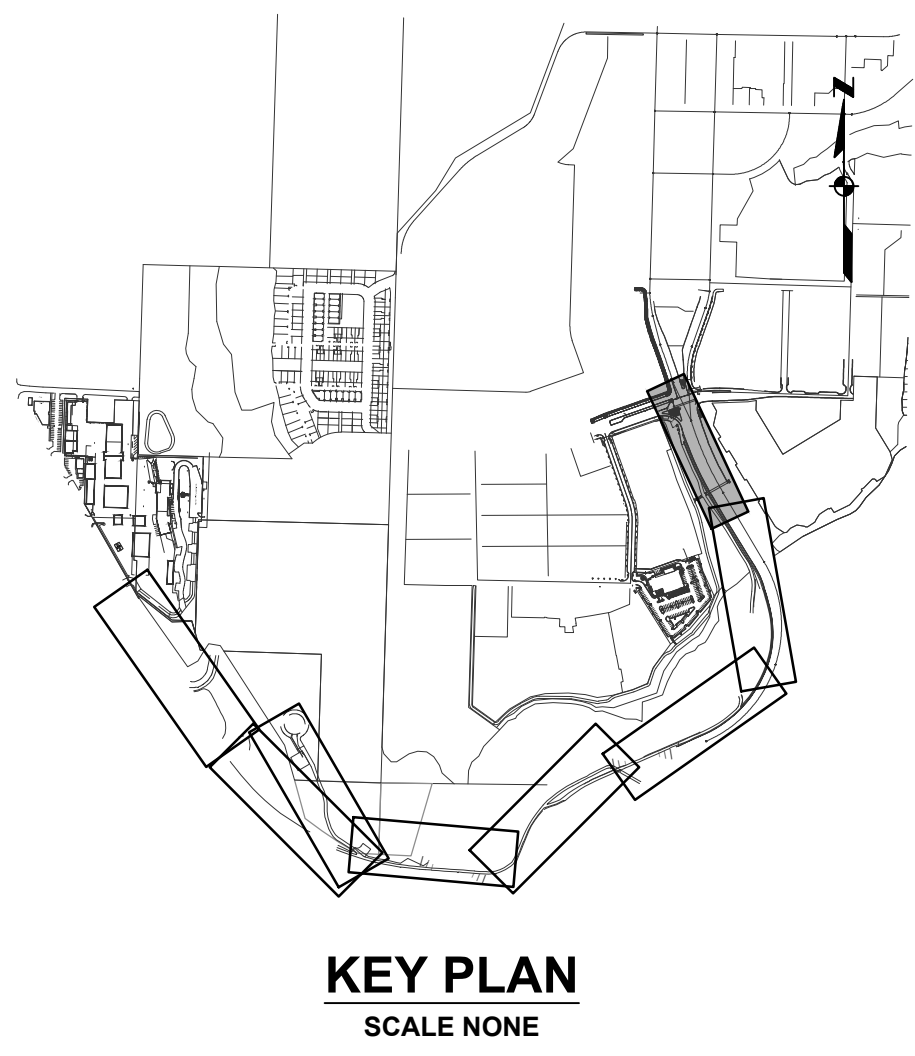

USE OF DOCUMENTS <small>THIS DOCUMENT, INCLUDING THE INCORPORATED DESIGNS, IS AN INSTRUMENT OF SERVICE FOR THIS PROJECT AND SHALL NOT BE USED FOR ANY OTHER PROJECT WITHOUT THE WRITTEN AUTHORIZATION OF KENNEDY/JENKS CONSULTANTS.</small>					SCALES 0 1" 0 25mm <small>IF THIS BAR IS NOT DIMENSION SHOWN, ADJUST SCALES ACCORDINGLY.</small>		DESIGNED KSP		CITY OF ISSAQUAH ISSAQUAH, WASHINGTON SOUTH SPAR BOOSTER PUMP STATION	Kennedy/Jenks Consultants FEDERAL WAY, WASHINGTON	SITE EROSION CONTROL PLAN		FILE NAME 139700500-EC07.DWG
	DRAWN LMM	JOB NO. 1397005*00											
	CHECKED MDL	DATE JUNE 2020											
											90% SUBMITTAL (REVISED 7/1/2020)		SHEET 21 OF 83 EC07

11/23/2020 4:36 PM

NICOLASOZANCORDONEZ

\\jc.local\JC-Rodrik-Office\FW\CAD\CAD131\397005.00_City_of_Issaquah\139700500-EC08.dwg

FIGURE D.3.2.B WATERWAY INSTALLATION


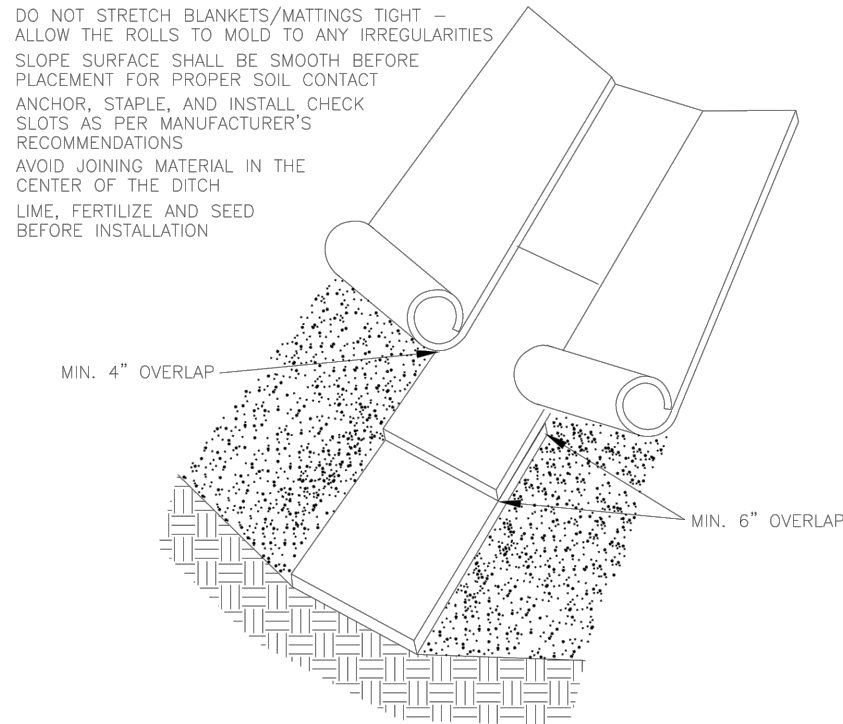



FIGURE D.3.2.C SLOPE INSTALLATION

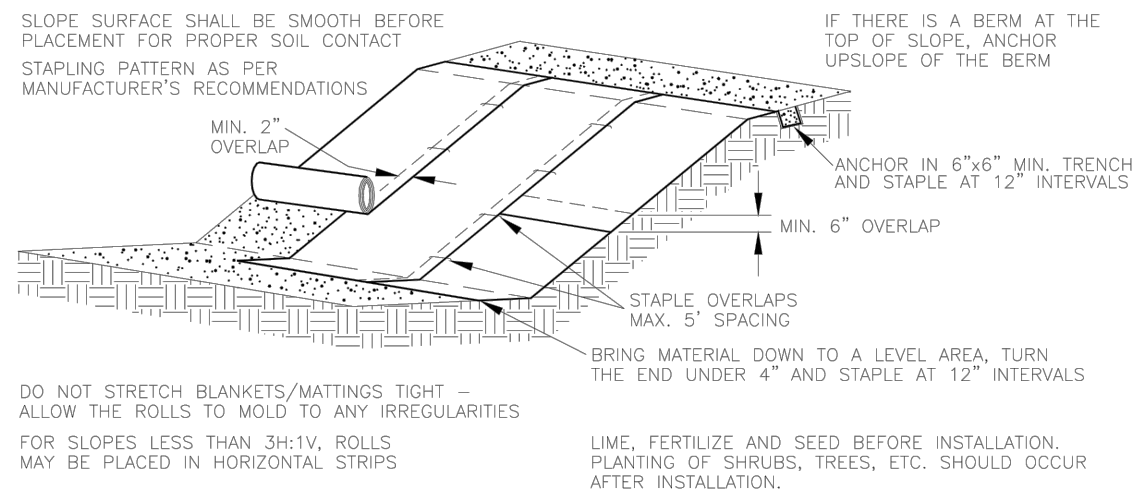


NETTING DETAIL

NOT TO SCALE

FIGURE D.3.6.E CHECK DAMS

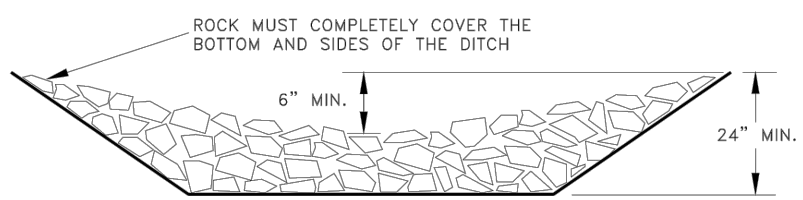

CROSS SECTION

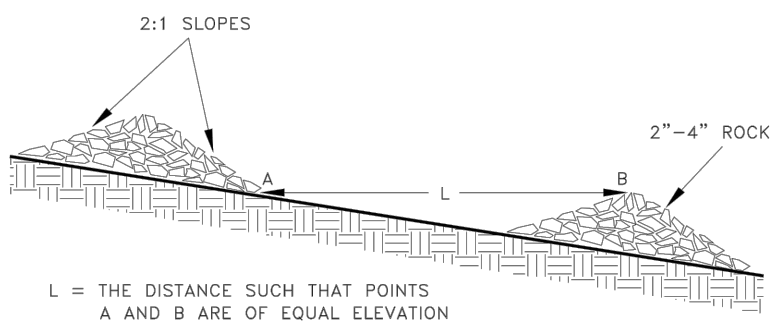

CHECK DAM SPACING

CHECK DAM DETAIL

NOT TO SCALE

FIGURE D.3.3.A SILT FENCE


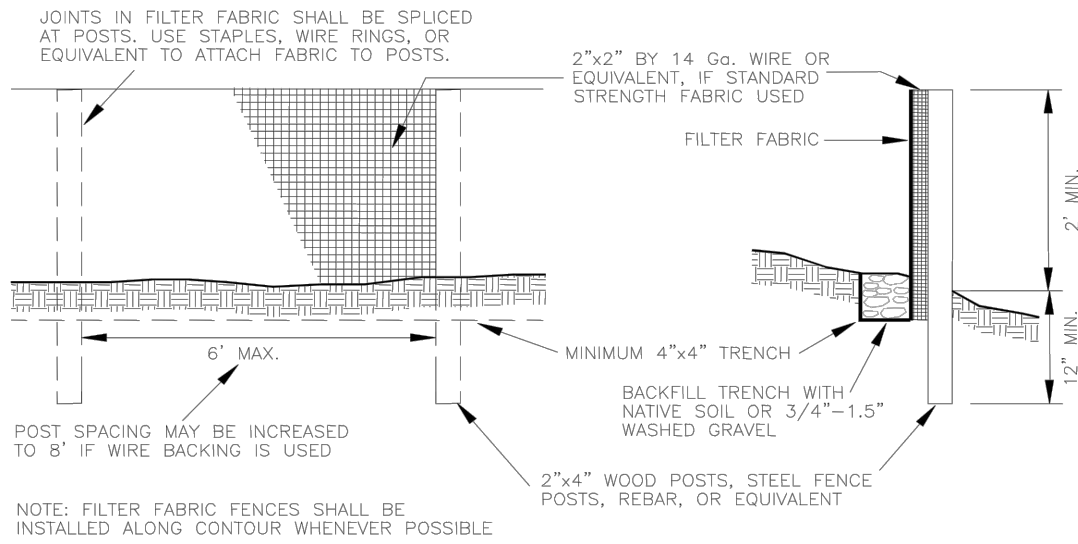



FIGURE D.3.3.B SILT FENCE INSTALLATION BY SLICING

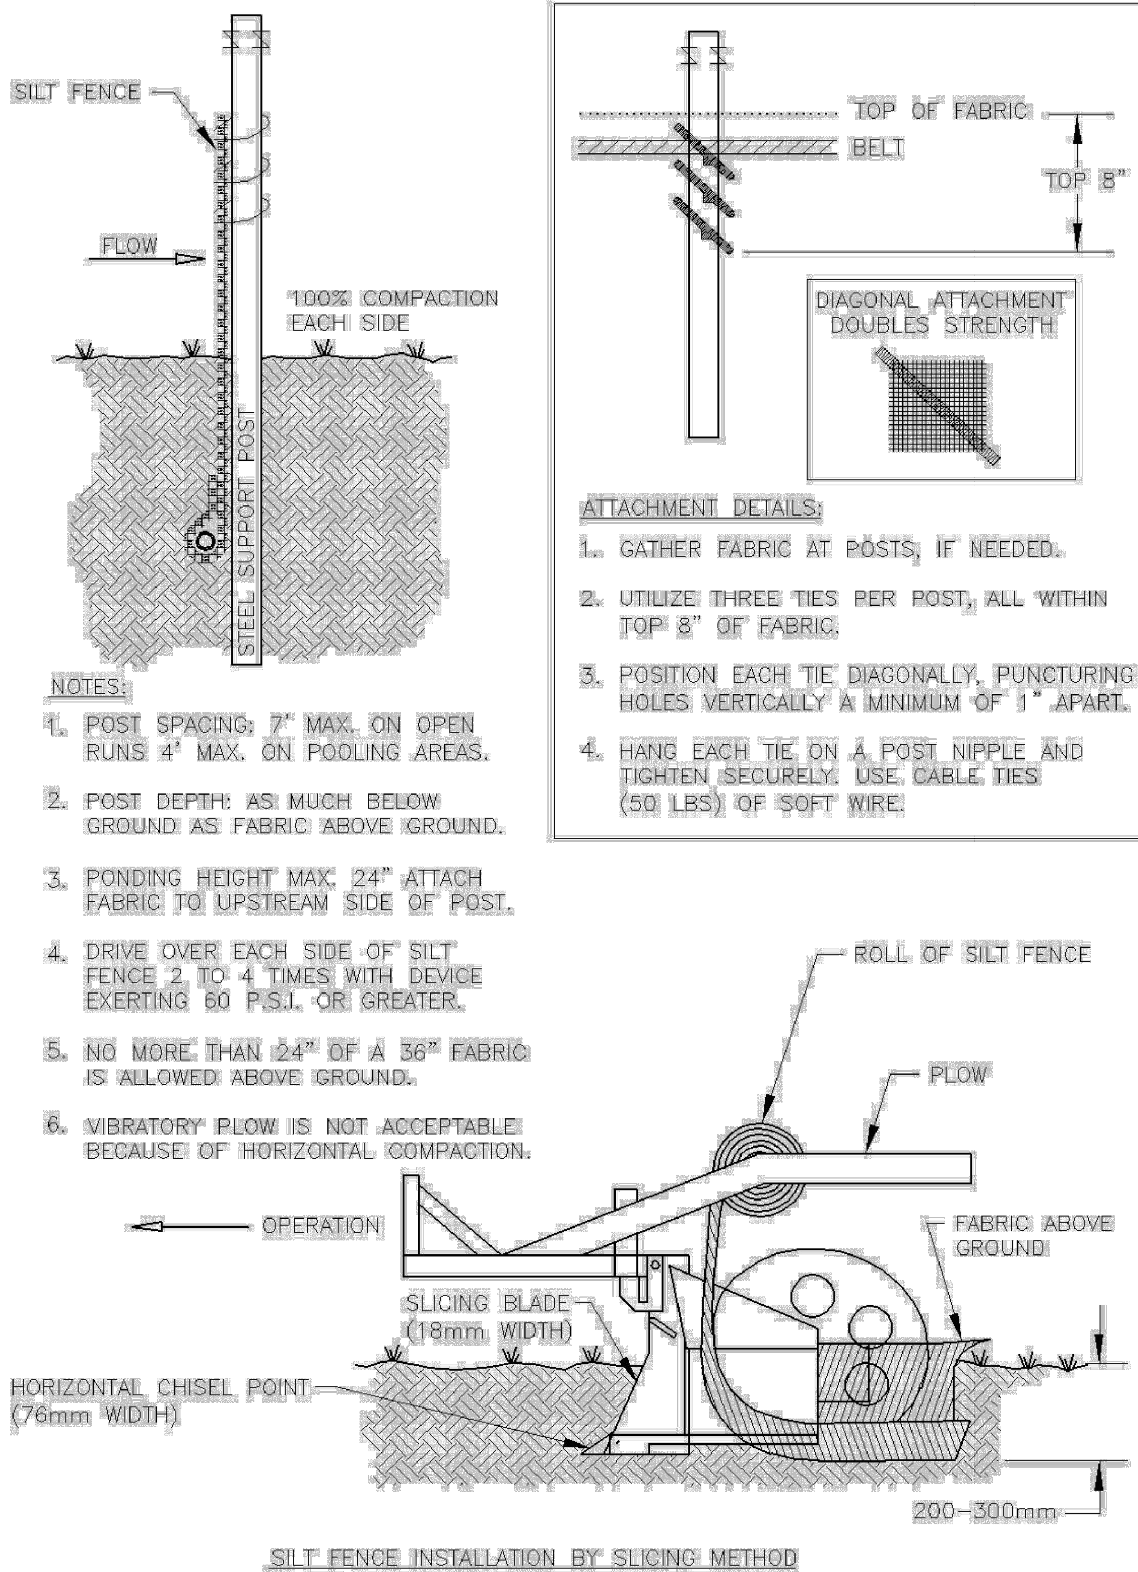

SILT FENCE DETAIL

NOT TO SCALE

FIGURE D.3.4.A STABILIZED CONSTRUCTION ENTRANCE

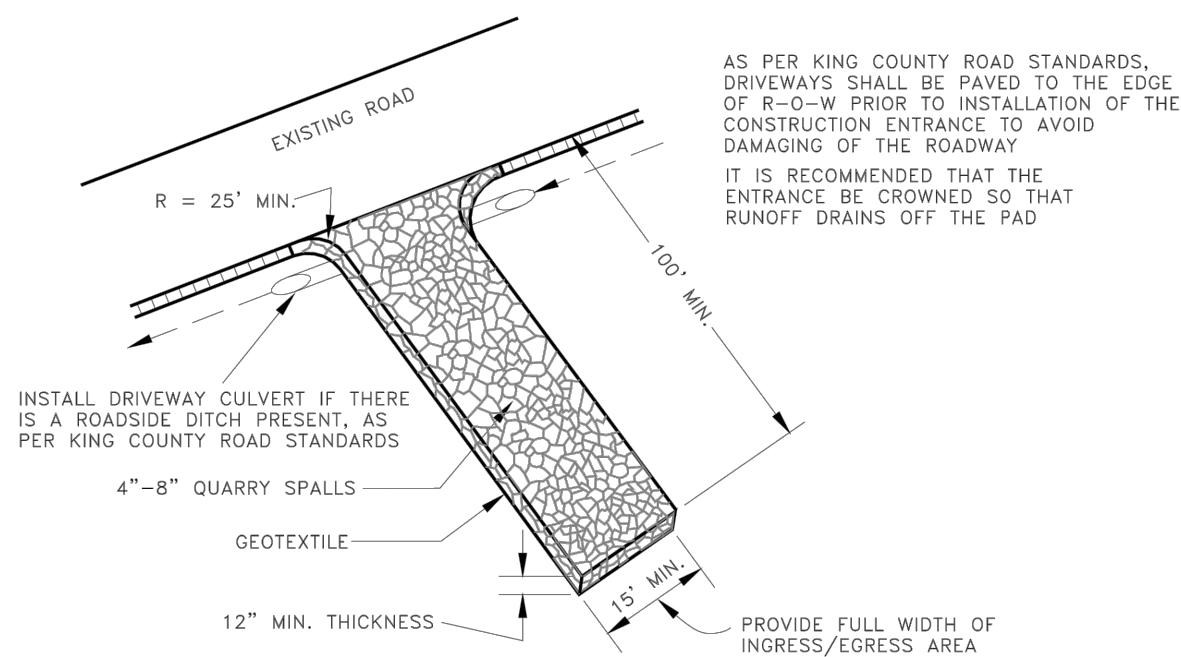

CONSTRUCTION ENTRANCE DETAIL

NOT TO SCALE

FIGURE D.3.5.E FILTER FABRIC PROTECTION

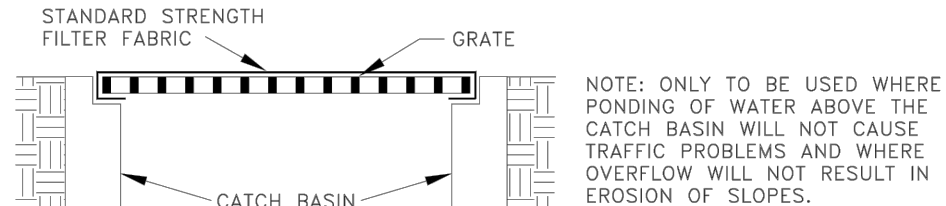


FIGURE D.3.5.F CATCH BASIN INSERT


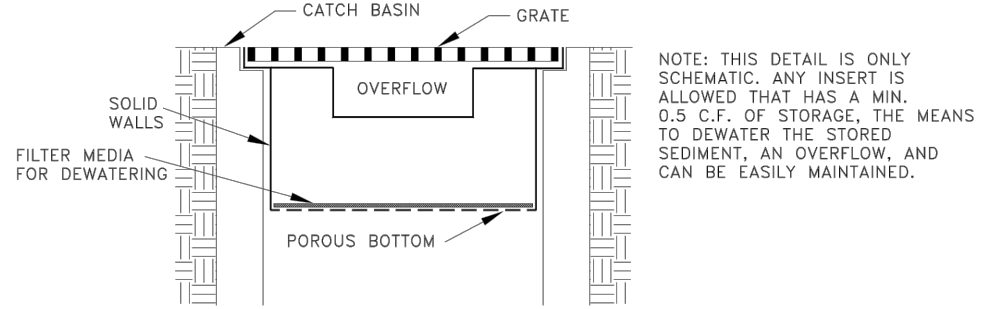



FIGURE D.3.5.H CURB AND GUTTER BARRIER PROTECTION

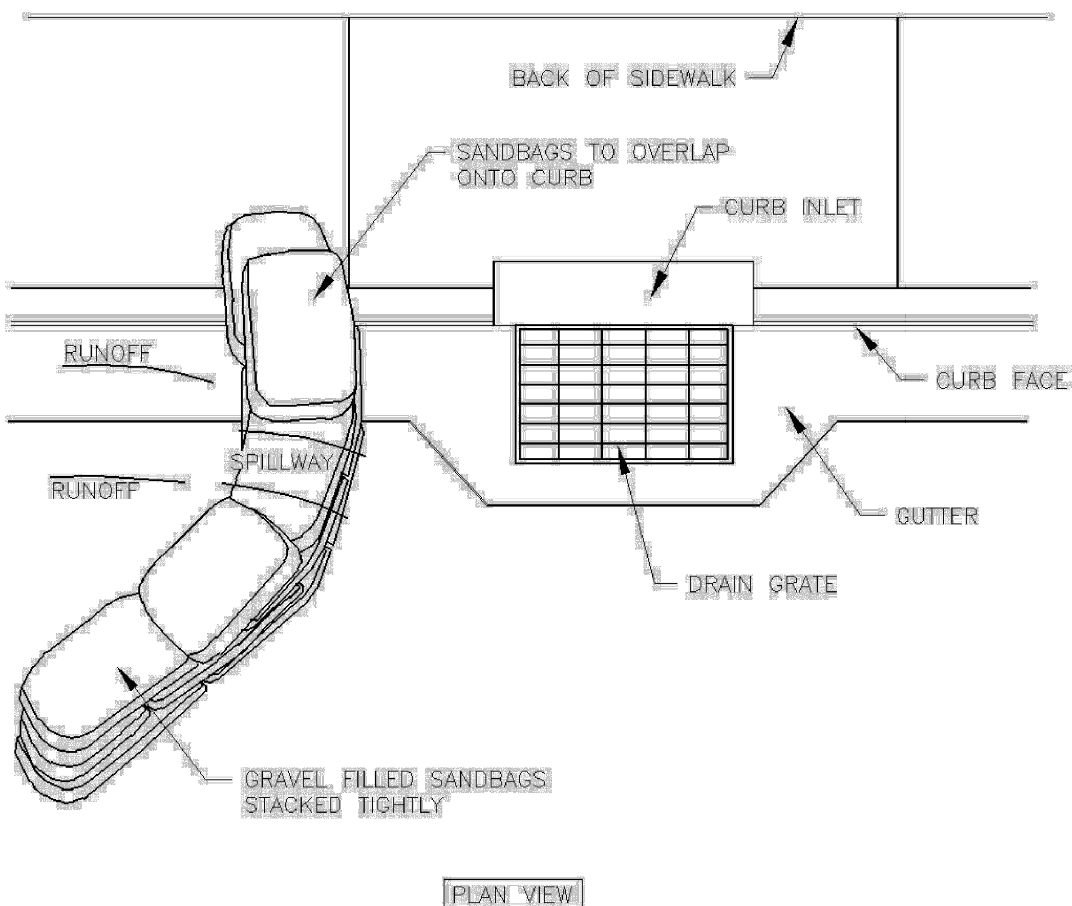

INLET PROTECTION DETAIL

NOT TO SCALE


FIGURE D.3.5.G BLOCK AND GRAVEL CURB INLET PROTECTION

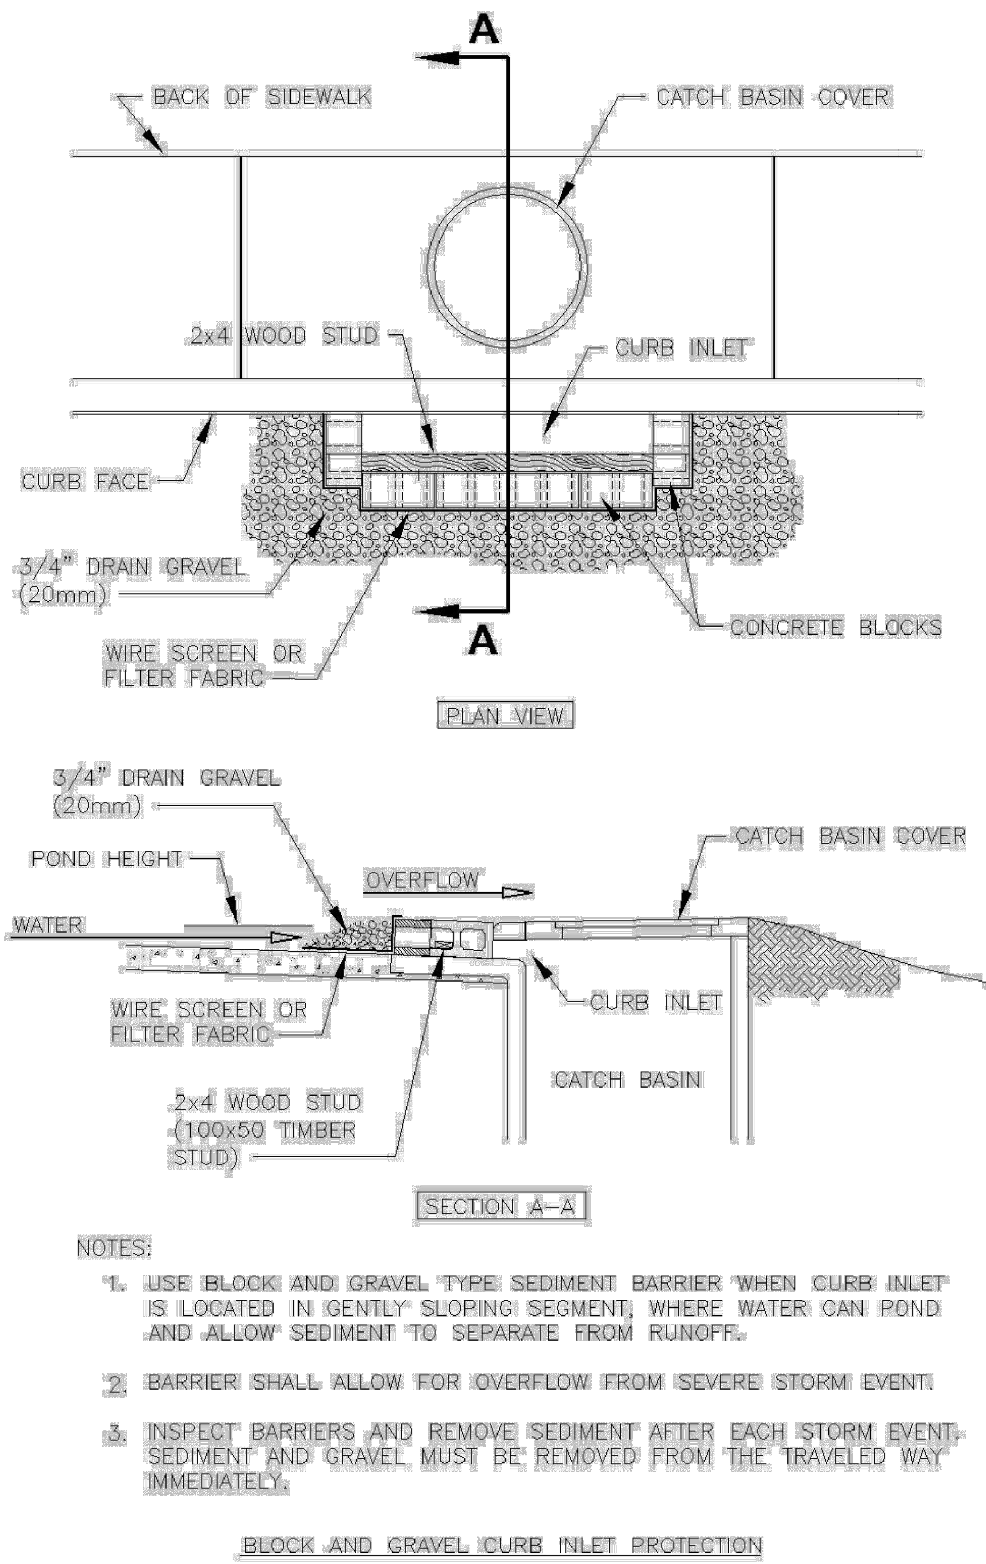

INLET PROTECTION DETAIL

NOT TO SCALE

- NOTES:
1. 6-FT HIGH TEMPORARY CHAIN LINK FENCE SHALL BE PLACED AT THE DRIPLINE OF THE TREE TO BE SAVED. FENCE SHALL COMPLETELY ENCLOSE THE TREE(S). INSTALL FENCE POSTS USING PIER BLOCKS ONLY. AVOID DRIVING POSTS OR STAKES INTO MAJOR ROOTS.
 2. FOR ROOTS OVER 1-INCH DIAMETER THAT ARE DAMAGED DURING CONSTRUCTION, MAKE A CLEAN, STRAIGHT CUT TO REMOVE THE DAMAGED PORTION. ALL EXPOSED ROOTS SHALL BE TEMPORARILY COVERED WITH DAMP BURLAP TO PREVENT DRYING AND SHALL BE COVERED WITH SOIL AS SOON AS POSSIBLE.
 3. WORK WITHIN PROTECTION FENCE SHALL BE DONE MANUALLY. NO STOCKPILING OF MATERIALS, VEHICULAR TRAFFIC, OR STORAGE OF EQUIPMENT OR MACHINERY SHALL BE ALLOWED WITHIN THE LIMIT OF THE FENCING.

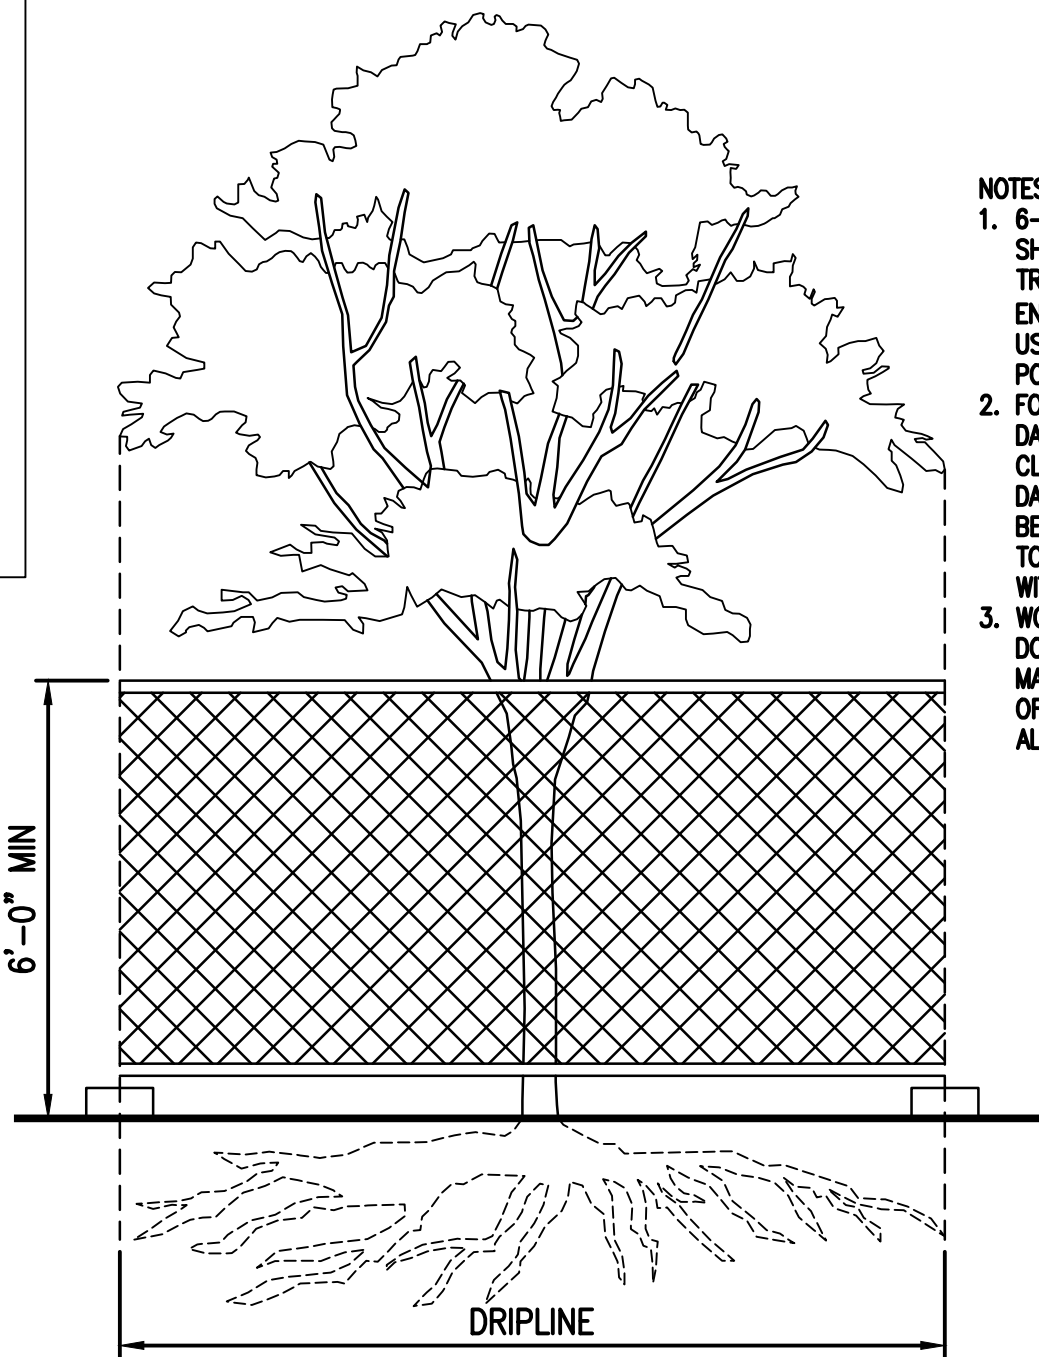

TREE PROTECTION DETAIL

NOT TO SCALE

USE OF DOCUMENTS

THIS DOCUMENT, INCLUDING THE INCORPORATED DESIGNS, IS AN INSTRUMENT OF SERVICE FOR THIS PROJECT AND SHALL NOT BE USED FOR ANY OTHER PROJECT WITHOUT THE WRITTEN AUTHORIZATION OF KENNEDY/JENKS CONSULTANTS.

NO.	REVISION	DATE	BY
-----	----------	------	----

SCALES
0 1"
0 25mm
IF THIS BAR IS NOT
DIMENSION SHOWN,
ADJUST SCALES
ACCORDINGLY.



DESIGNED
KSP
DRAWN
LMM
CHECKED
MDL



CITY OF ISSAQUAH
ISSAQUAH, WASHINGTON
SOUTH SPAR BOOSTER PUMP STATION


Kennedy/Jenks Consultants
FEDERAL WAY, WASHINGTON

SITE EROSION CONTROL DETAILS


90% SUBMITTAL (REVISED 11/30/2020)

FILE NAME
139700500-EC08.DWG
JOB NO.
1397005*00
DATE
NOVEMBER 2020
SHEET
OF
EC08

\\jc.local\JC-Rodrik-Office\FW\CAD\CAD131\397005.00_City_of_Issaquah\139700500-C001.dwg 11/30/2020 10:16 PM DANPHIPPS

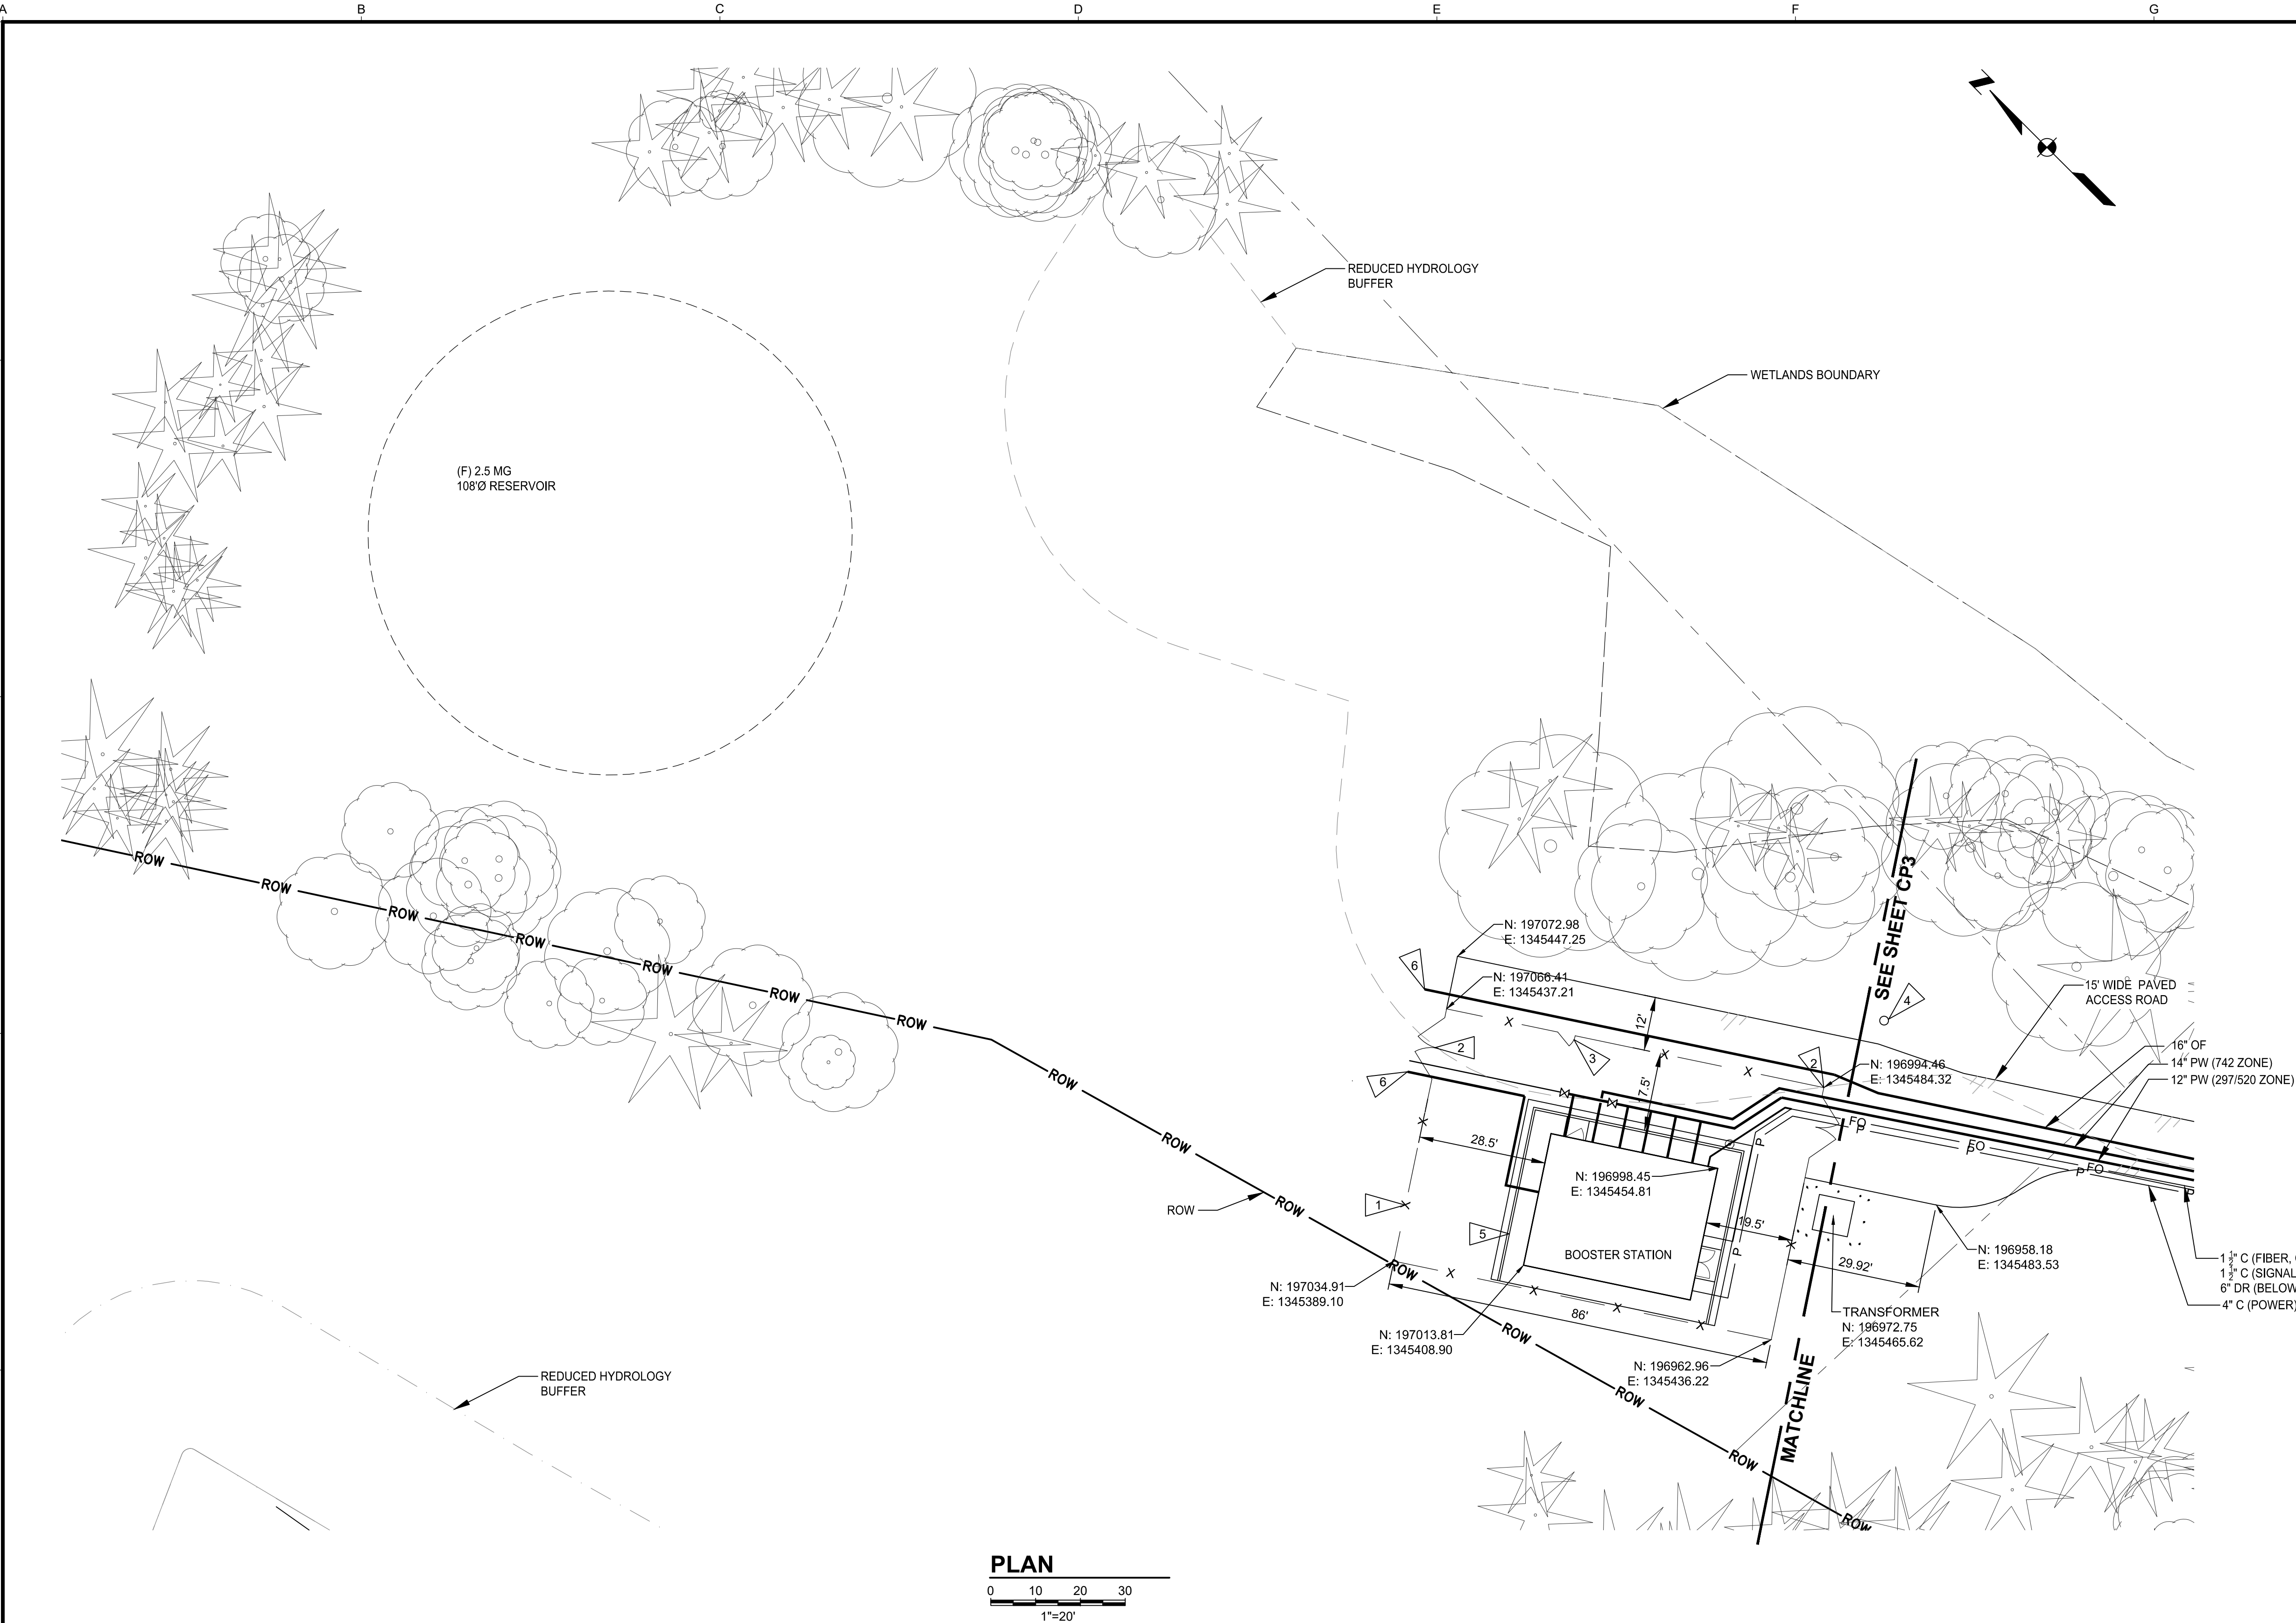


- NOTES:
- 1 NEW FENCE. WSDOT STANDARD L-20.10-03 WITH 8 FOOT HEIGHT. INVERT FABRIC WHEN INSTALLING.
 - 2 NEW DOUBLE GATE. WSDOT STANDARD L-30.10-02 WITH STRONG ARM GATE LATCH.
 - 3 NEW SINGLE GATE. WSDOT STANDARD L-30.10-02.
 - 4 CONCRETE POLE FOR SECURITY CAMERA. SEE SHEET S-4.
 - 5 SIDEWALK. SEE DETAIL 3332 SHEET S-4.
 - 6 EXTEND PIPELINES FOR FUTURE RESERVOIR PAST END OF ASPHALT PAVING.
 - 7 SEE MECHANICAL DRAWINGS FOR PIPING DETAILS.
 - 8 SEE SHEETS C3 AND C4 FOR ACCESS ROAD PLAN AND PROFILE.
 - 9 SEE SHEET C9 FOR DETAILED PUMP STATION GRADING PARTIAL PLAN.

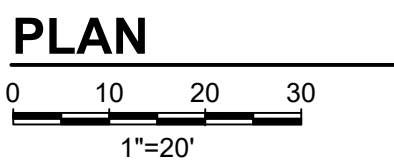


USE OF DOCUMENTS THIS DOCUMENT, INCLUDING THE INCORPORATED DESIGNS, IS AN INSTRUMENT OF SERVICE FOR THIS PROJECT AND SHALL NOT BE USED FOR ANY OTHER PROJECT WITHOUT THE WRITTEN AUTHORIZATION OF KENNEDY/JENKS CONSULTANTS.					<div>SCALES</div> <div><div>01"25mm</div><div>IF THIS BAR IS NOT DIMENSION SHOWN, ADJUST SCALES ACCORDINGLY.</div></div> <div></div>	DESIGNED	<div>CITY OF ISSAQUAH ISSAQUAH, WASHINGTON</div> <div>SOUTH SPAR BOOSTER PUMP STATION</div> <div>Kennedy/Jenks Consultants FEDERAL WAY, WASHINGTON</div>	SITE AND YARD PIPING PLAN		90% SUBMITTAL (REVISED 11/30/2020)	FILE NAME
						139700500-C001.DWG					
						JOB NO. 1397005*00					
						DATE NOVEMBER 2020					
						SHEET 23 OF 83 C1					
	NO.	REVISION	DATE	BY		DRAWN					
						DRP					
						CHECKED					
						MDL					

\\jc.local\JC-Rodrik-Office\FW\CAD\CAD131397005.00_City_of_Issaquah\139700500-C002.dwg 11/30/2020 9:23 PM DANPHIPPS

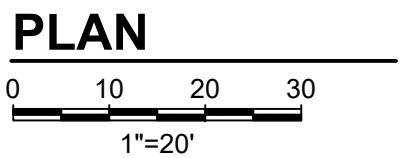


- NOTES:
- 1 MAINTAIN 30' MINIMUM CLEARANCE BETWEEN STRUCTURES AND STEEP SLOPE.
 2. SEE SHEETS C3 AND C4 FOR ACCESS ROAD PLAN AND PROFILE INCLUDING GRADING AND PAVING.

USE OF DOCUMENTS THIS DOCUMENT, INCLUDING THE INCORPORATED DESIGNS, IS AN INSTRUMENT OF SERVICE FOR THIS PROJECT AND SHALL NOT BE USED FOR ANY OTHER PROJECT WITHOUT THE WRITTEN AUTHORIZATION OF KENNEDY/JENKS CONSULTANTS.					SCALES 0 1" 25mm IF THIS BAR IS NOT DIMENSION SHOWN, ADJUST SCALES ACCORDINGLY.		DESIGNED KSP		CITY OF ISSAQUAH ISSAQUAH, WASHINGTON SOUTH SPAR BOOSTER PUMP STATION Kennedy/Jenks Consultants FEDERAL WAY, WASHINGTON	SITE GRADING AND PAVING PLAN 90% SUBMITTAL (REVISED 11/30/2020)	FILE NAME 139700500-C002.DWG
							DRAWN LMM				JOB NO. 1397005*00
							CHECKED MDL				DATE NOVEMBER 2020
	NO.	REVISION	DATE	BY							SHEET 24 OF 83 C2

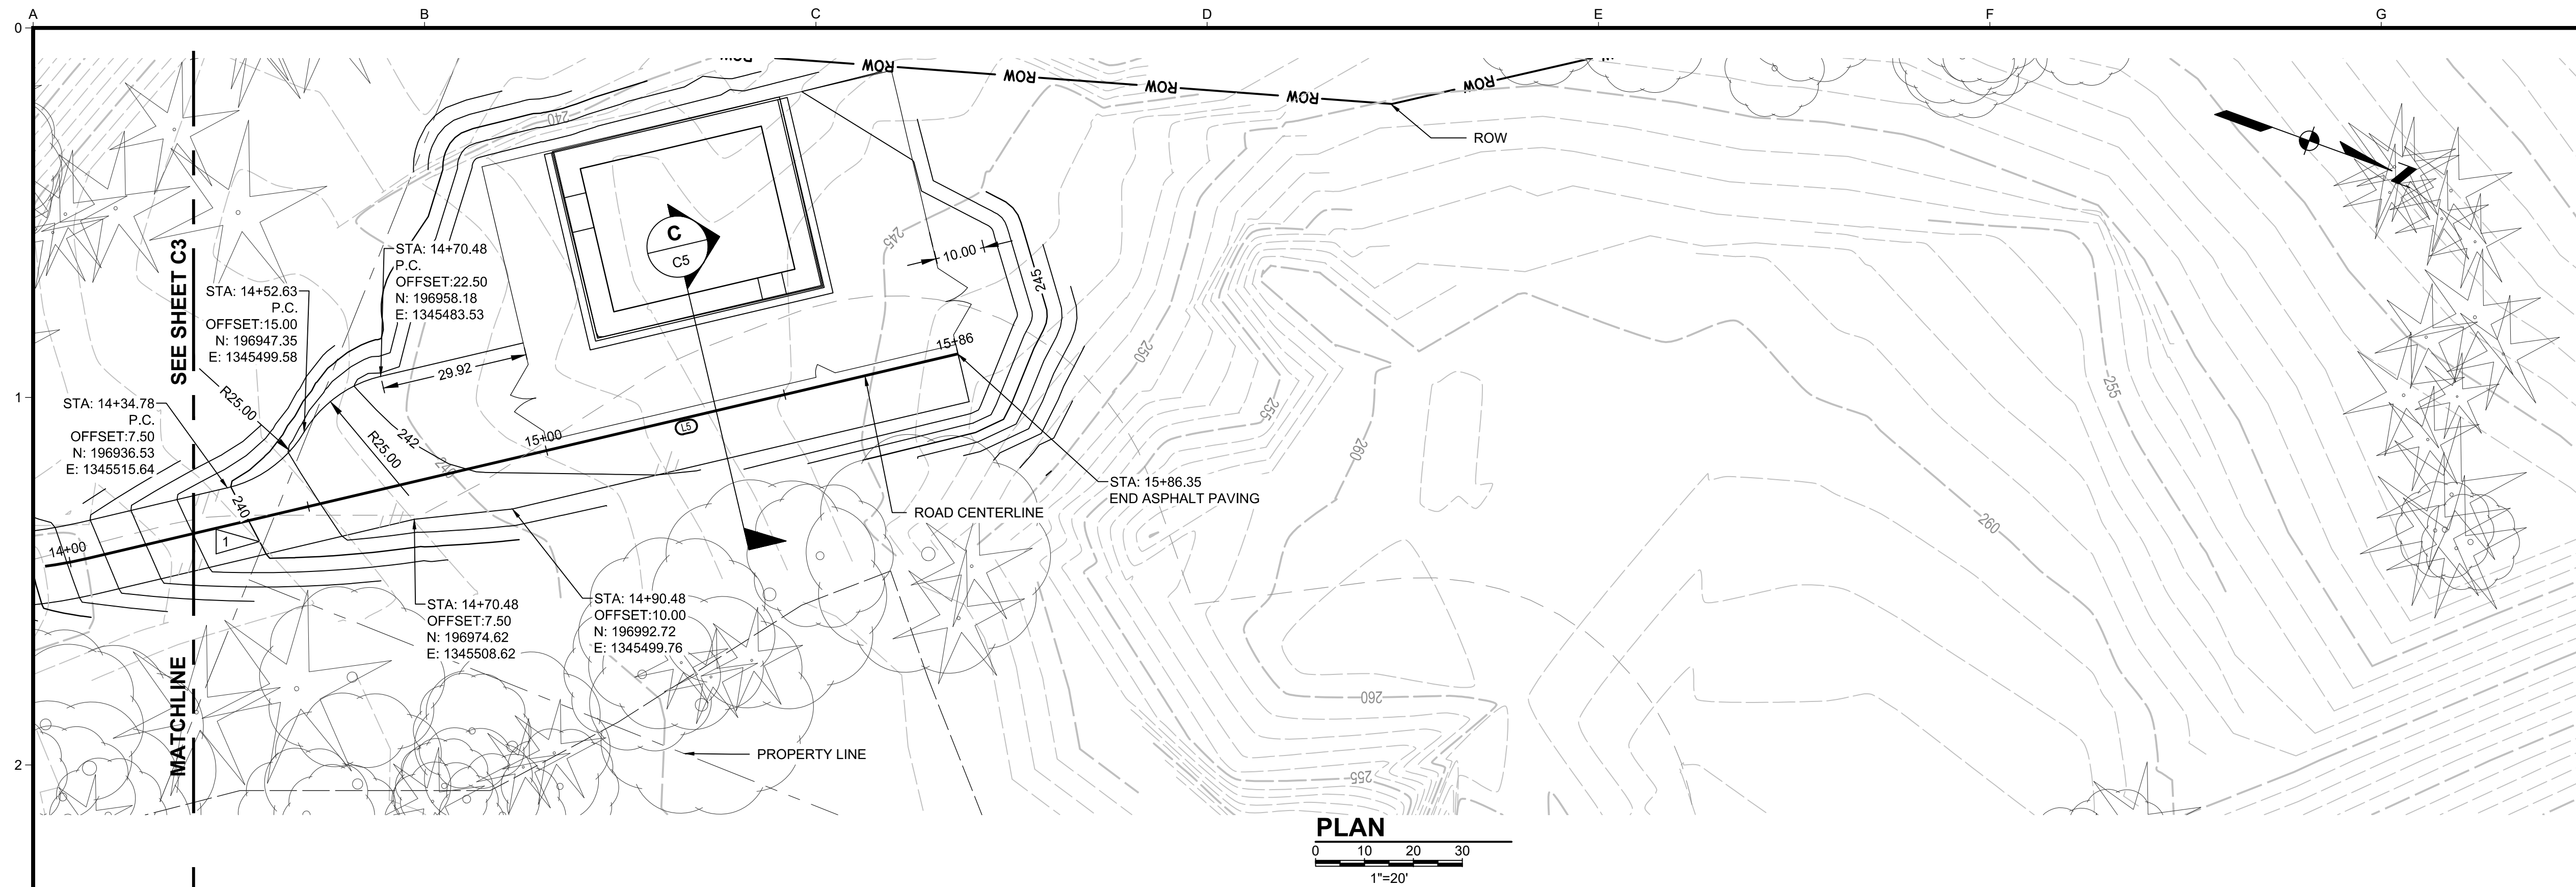


NOTES

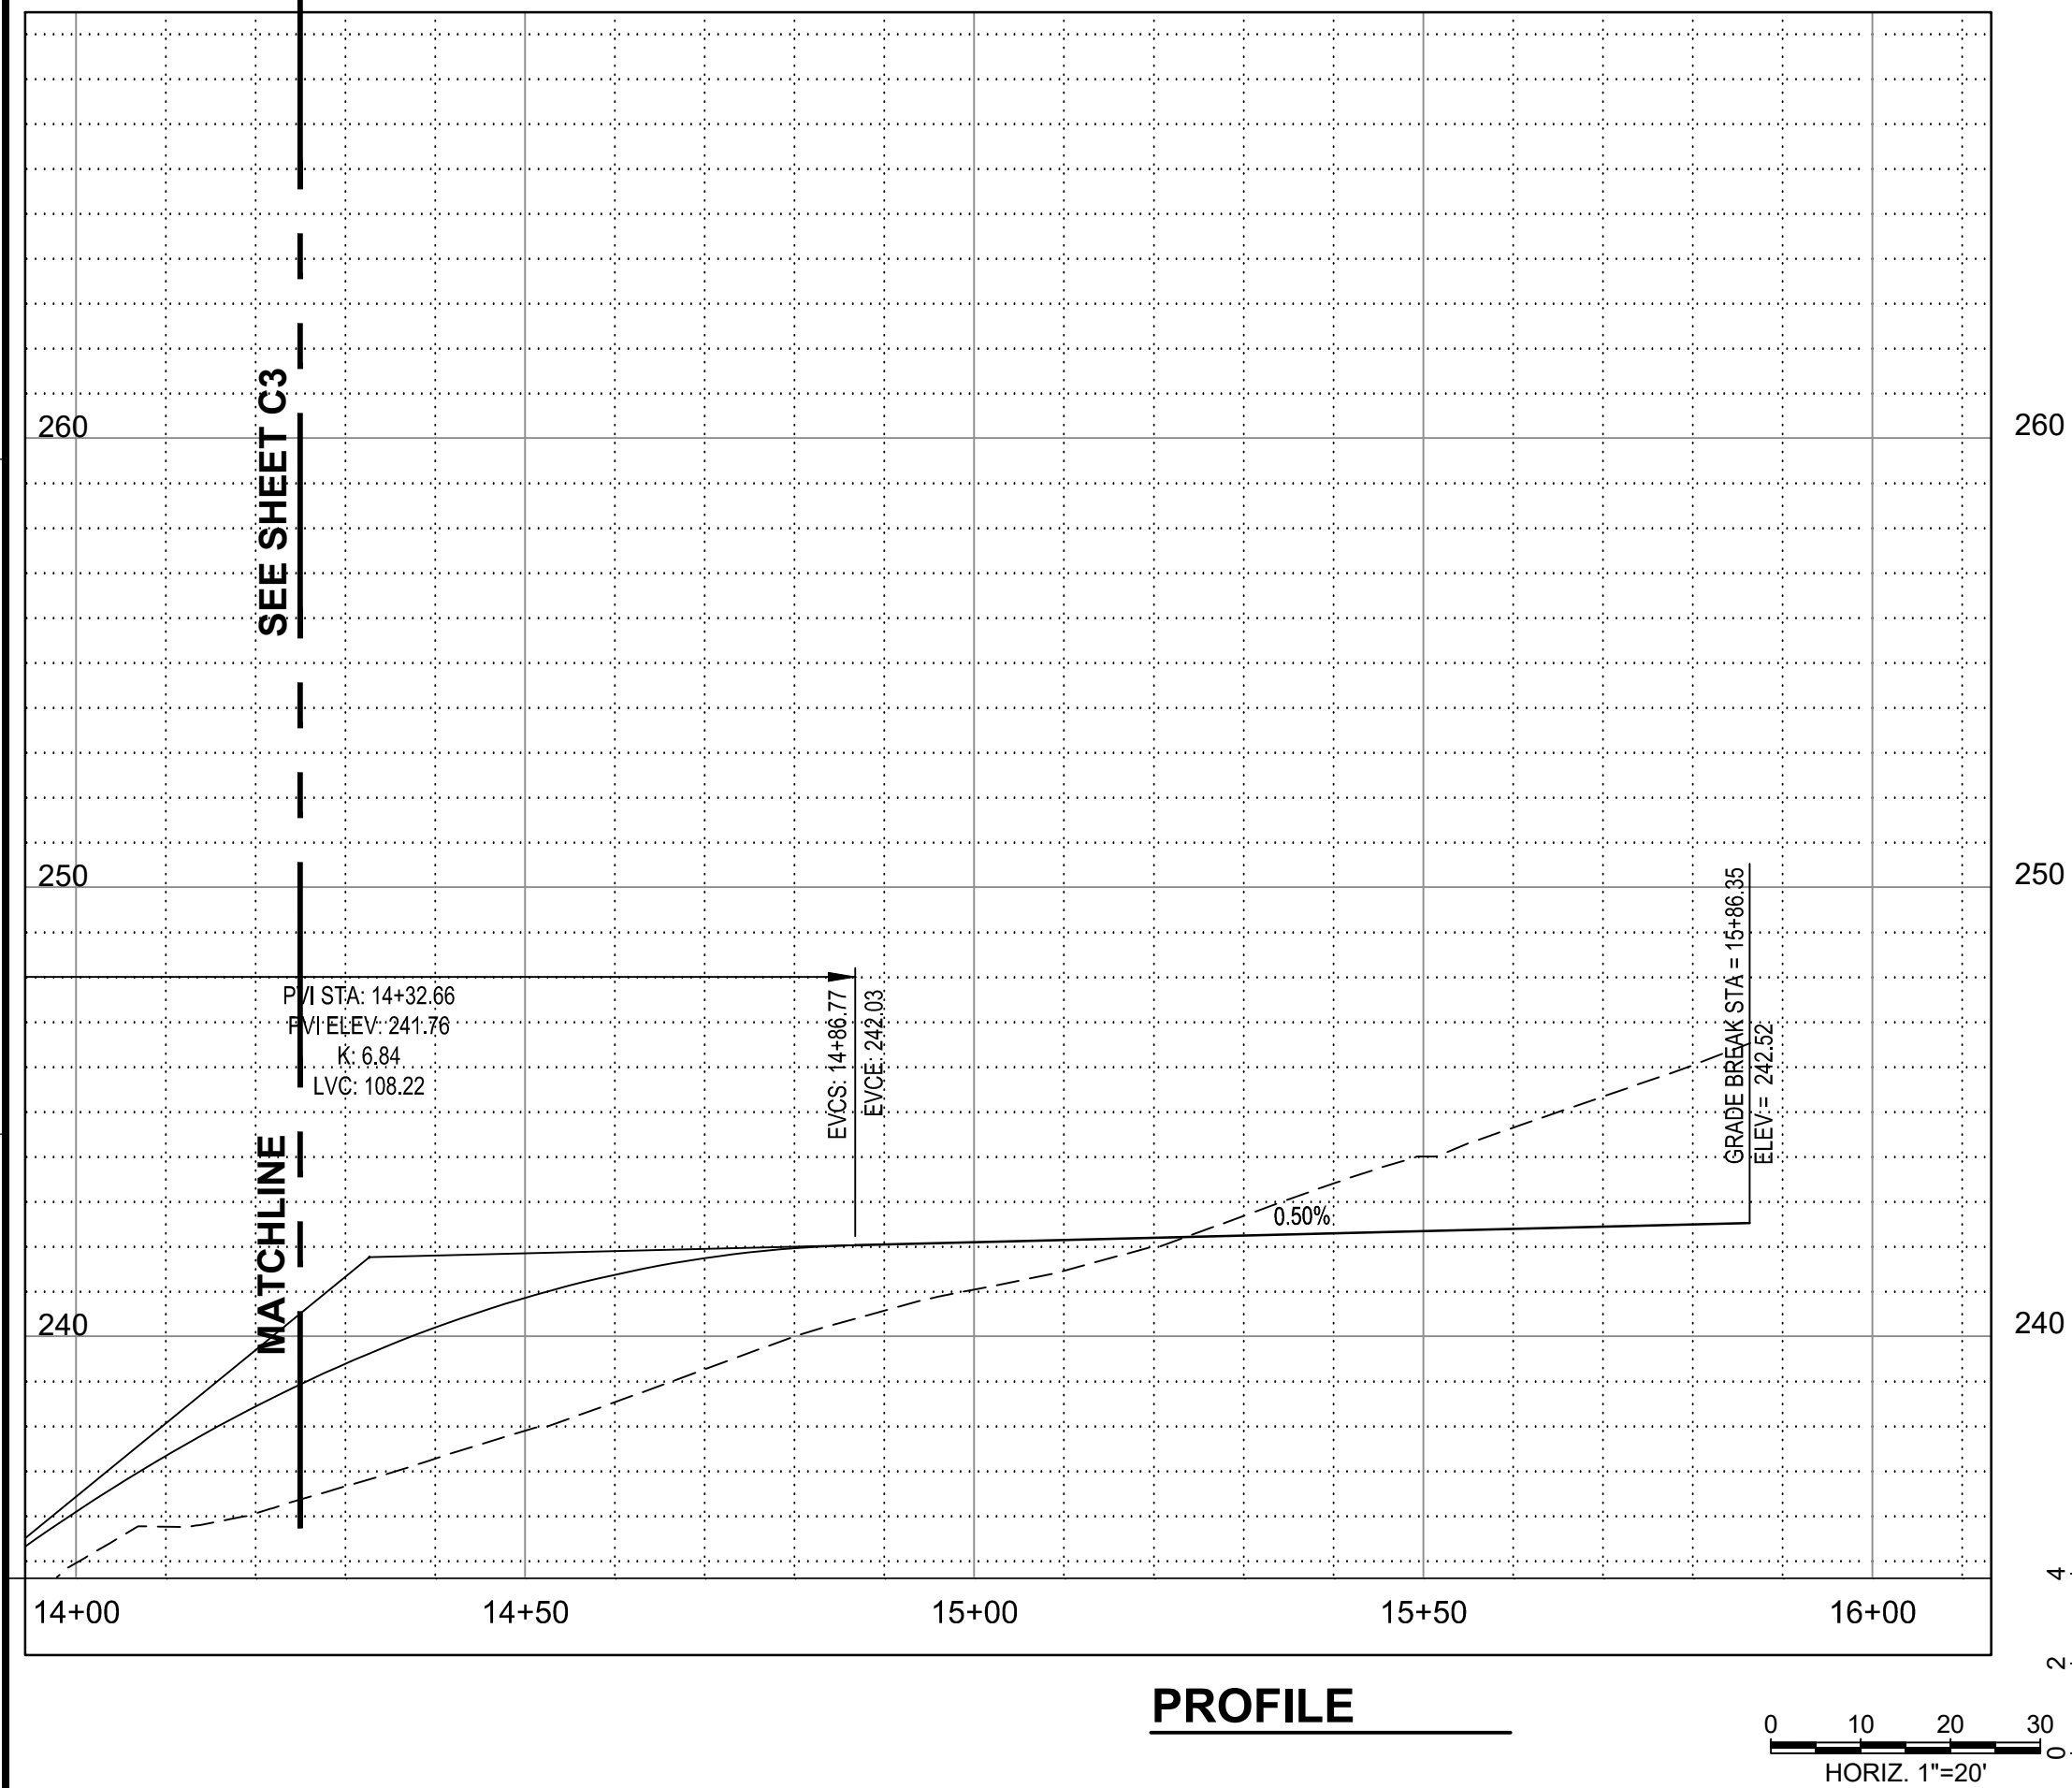

USE OF DOCUMENTS

NO.	REVISION	DATE	BY

SCALES

0  1"

0 25mm

IF THIS BAR IS NOT
DIMENSION SHOWN,
ADJUST SCALES
ACCORDINGLY.



DESIGNED

DRAWN

CHECKED







Kennedy/Jenks Consultants
FEDERAL WAY, WASHINGTON

ACCESS ROAD PLAN AND PROFILE STA 14+25 TO STA 17+80

90% SUBMITTAL (REVISED 11/30/2020)

FILE NAME	139700500-C004.DWG
JOB NO.	1397005*00
DATE	NOVEMBER 2020
SHEET	26 OF 8
C4	

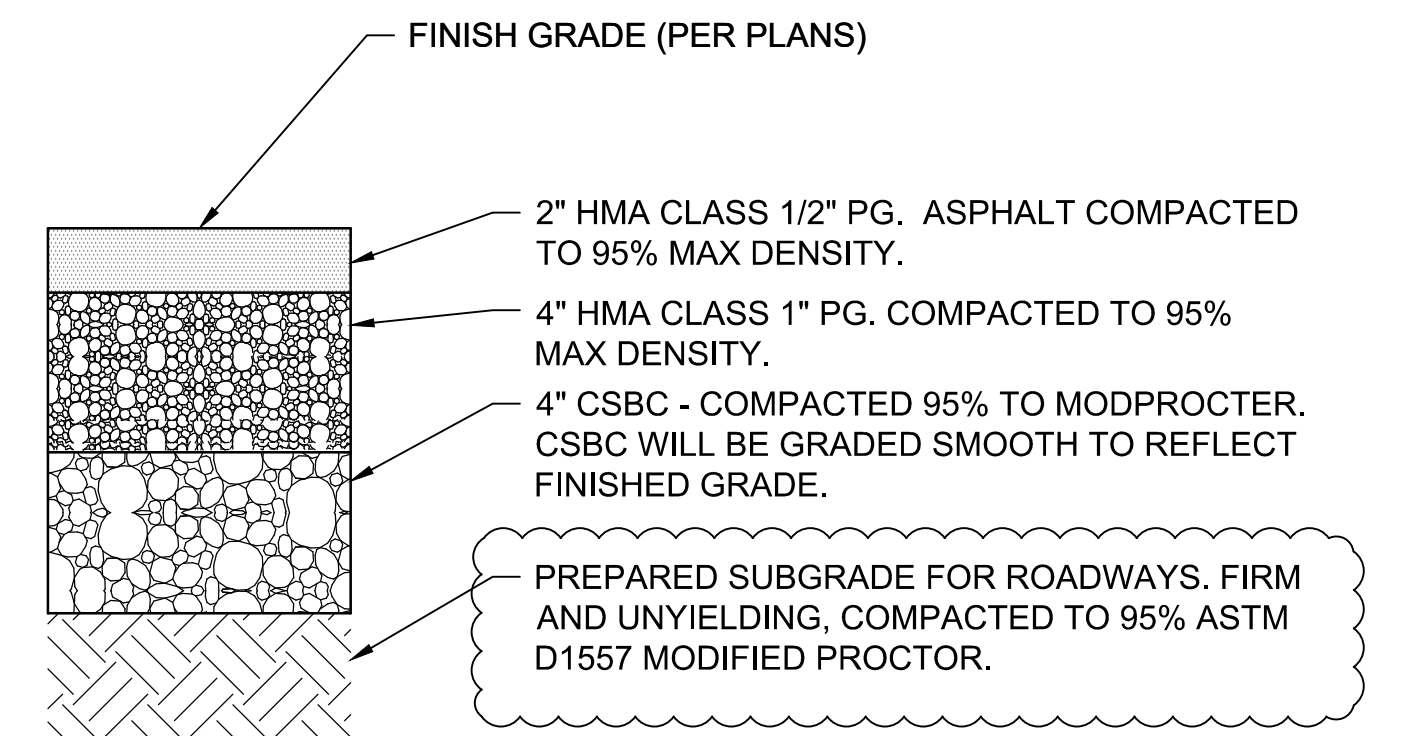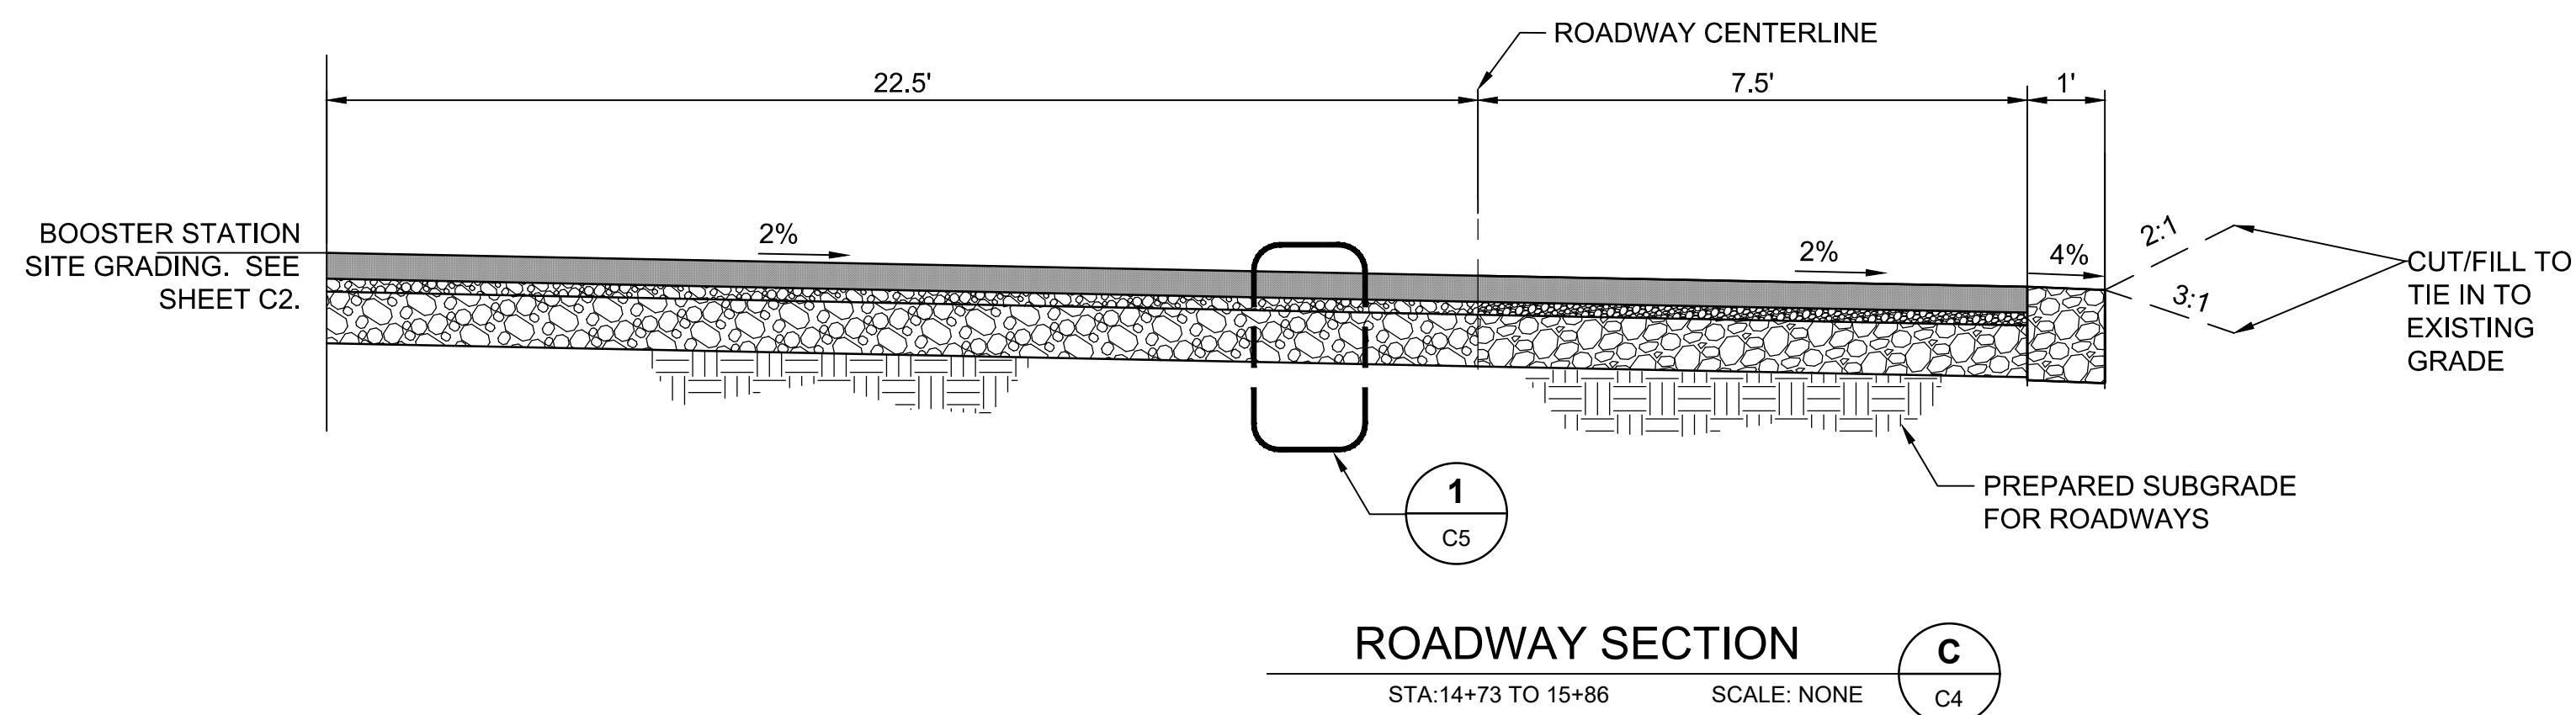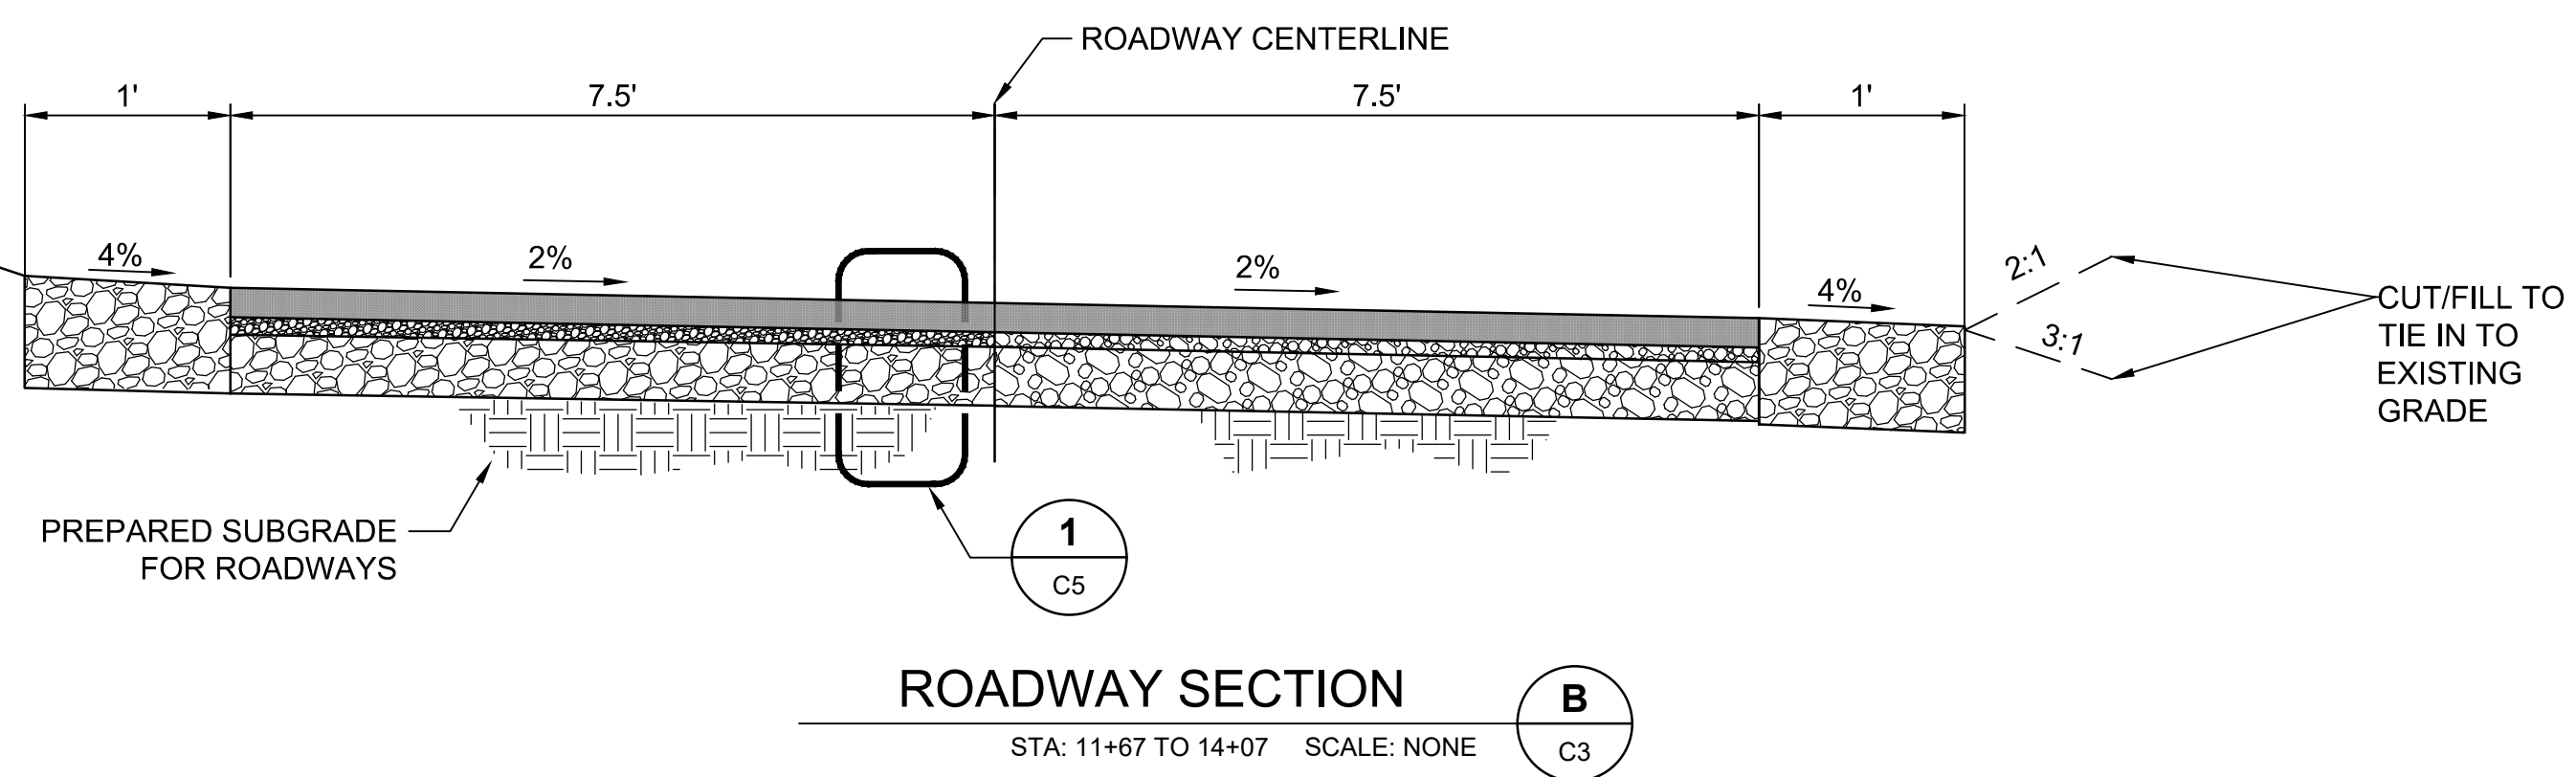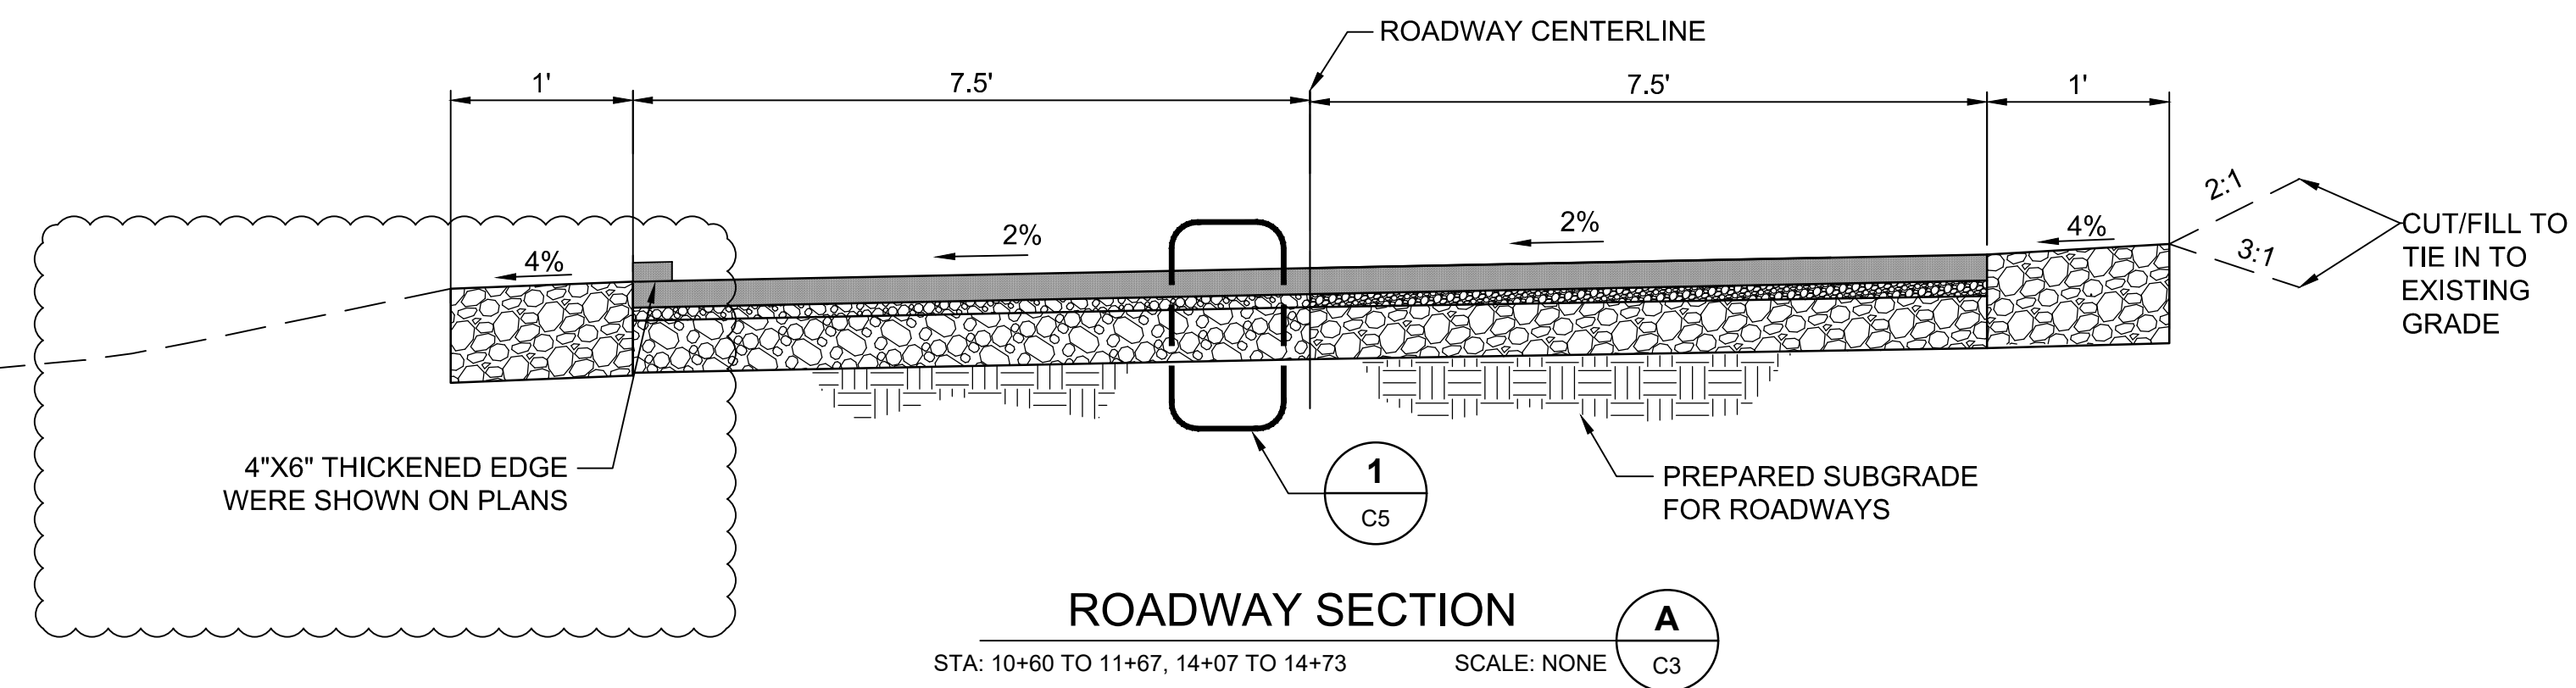

NOTES:
PAVING LIMITS ARE PROVIDED ON SHEETS
CP20 TO CP26.

ACCESS ROAD PAVEMENT DETAIL

USE OF DOCUMENTS

THIS DOCUMENT, INCLUDING THE INCORPORATED
DESIGNS, IS AN INSTRUMENT OF SERVICE FOR THIS
PROJECT AND SHALL NOT BE USED FOR ANY OTHER
PROJECT WITHOUT THE WRITTEN AUTHORIZATION
OF KENNEDY/JENKS CONSULTANTS.

NO.

REVISION


DAT

BY

SCALES

0 1"
0 25mm

IF THIS BAR IS NOT
DIMENSION SHOWN,
ADJUST SCALES
ACCORDINGLY.

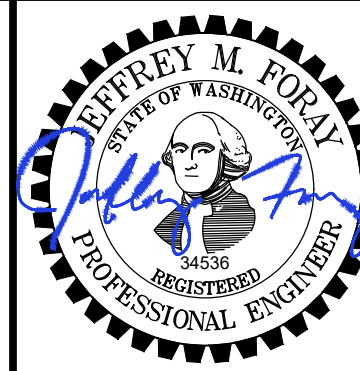

DESIGNED

KSF

DRAWN

RJS

CHECKED

MDI



CITY OF ISSAQUAH
ISSAQUAH, WASHINGTON
SOUTH SPAR BOOSTER PUMP STATION

Kennedy/Jenks Consultants
FEDERAL WAY, WASHINGTON

SECTIONS AND DETAILS

90% SUBMITTAL (REVISED 11/30/2020)


FILE NAME
139700500-C005.DWG

OB NO.	1397005*00
--------	------------

NOVEMBER 2020


SHEET OF
C5

12/10/2020 1:24 PM
NICOLASLOZANO@RDONEZ
\\jc.local\\JC-Rodrik-Office\\FY\\CADCAD\\131397005.00_City_of_Issaquah\\139700500-C006.dwg

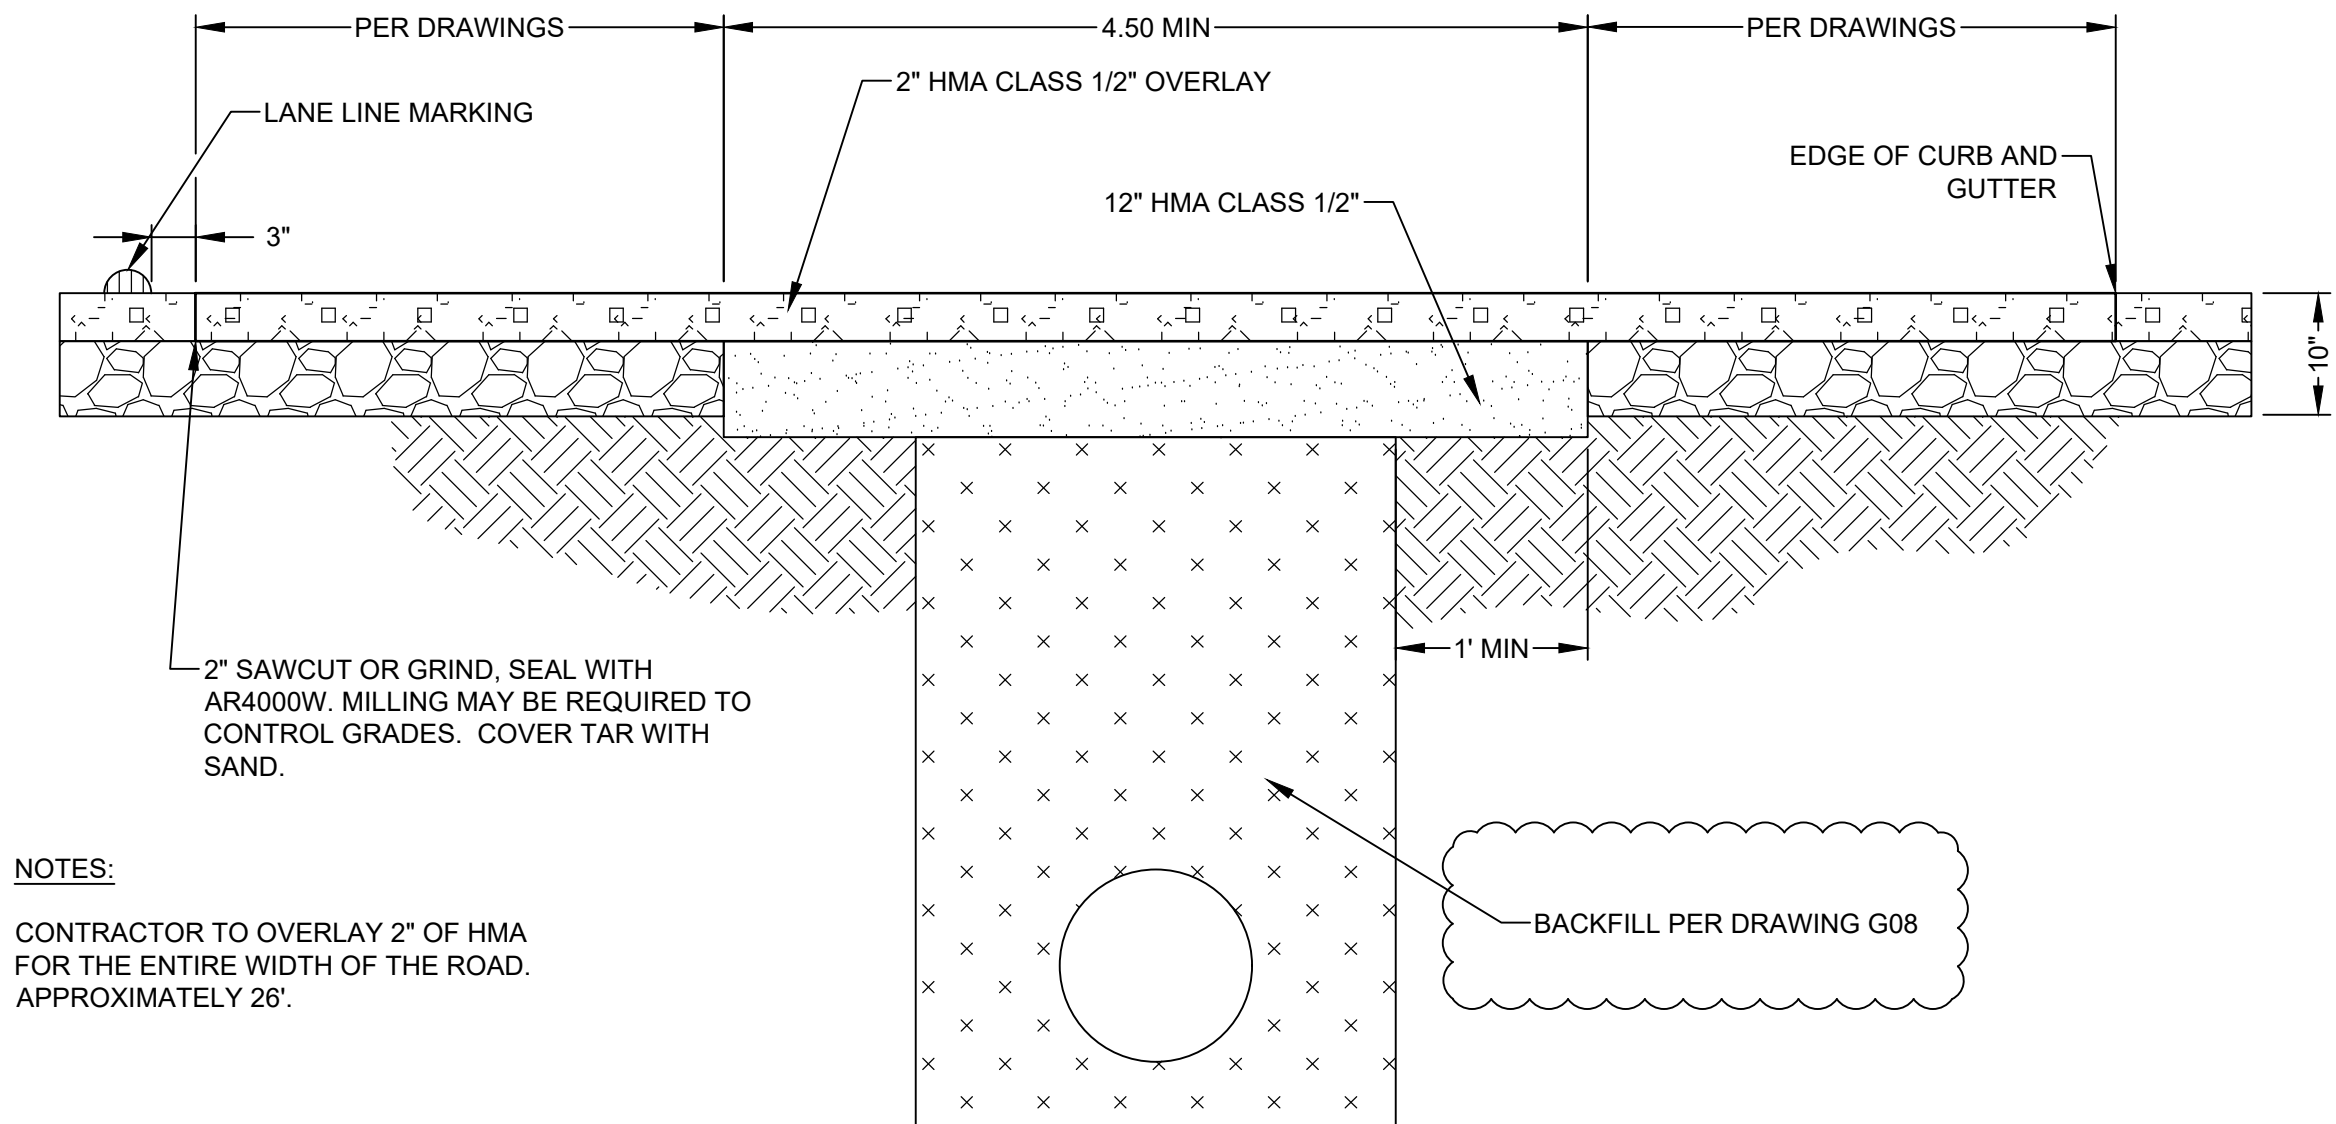


ASPHALT PATCHBACK IN 1ST AVE NE
STA 1+00 TO 6+30

3
CP20
CP21

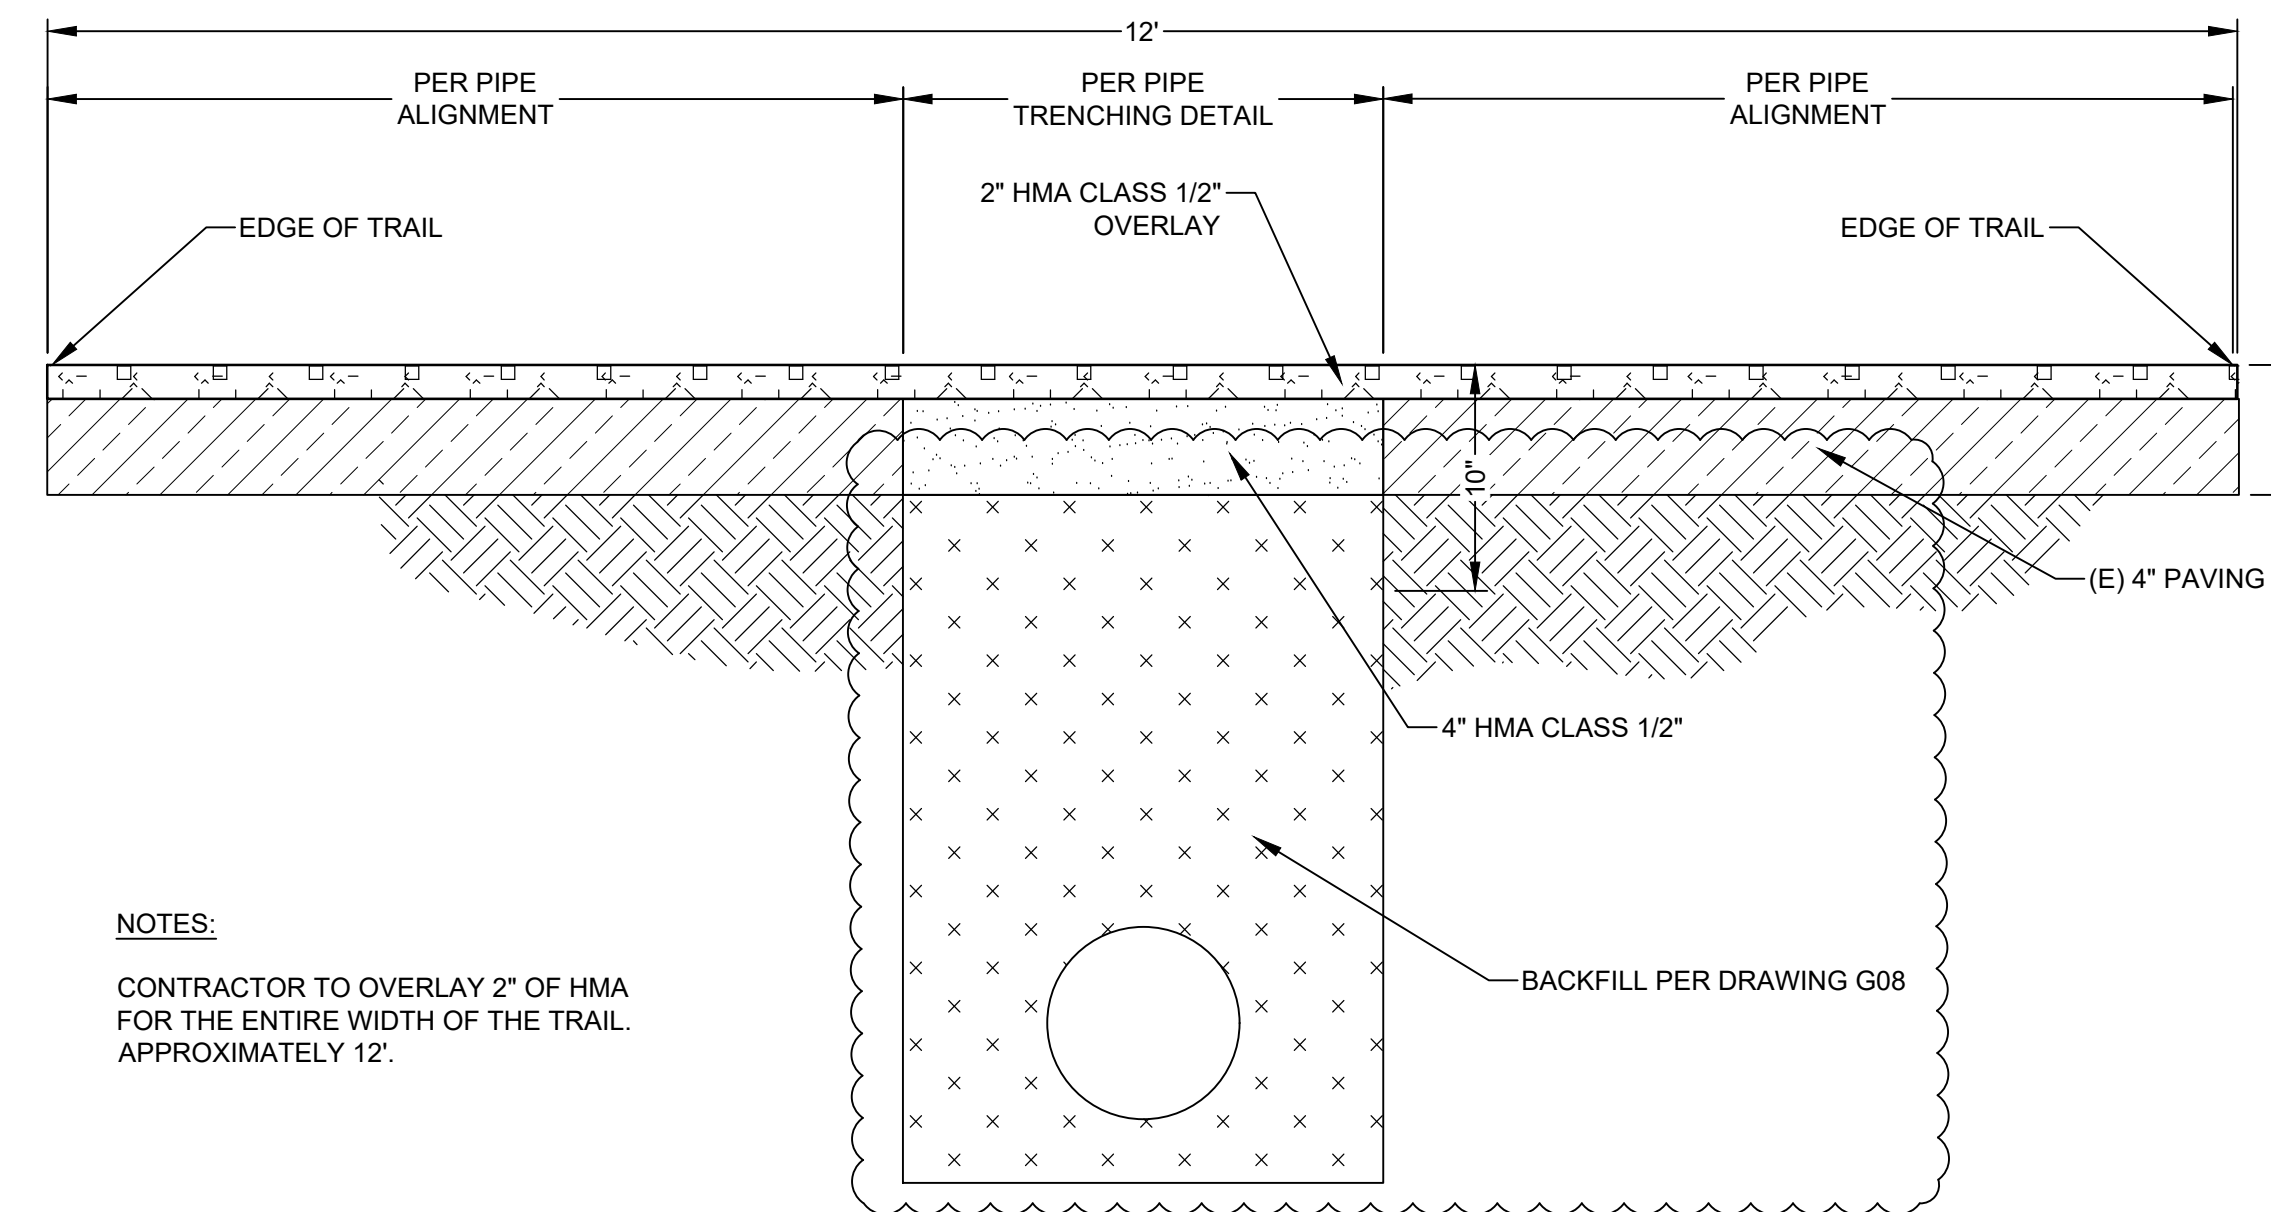


ASPHALT PATCHBACK IN ISSAQUAH PRESTON TRAIL
STA 51+50 TO 65+30 AND STA 66+70 TO 78+70

4B
CP24
CP25
CP31

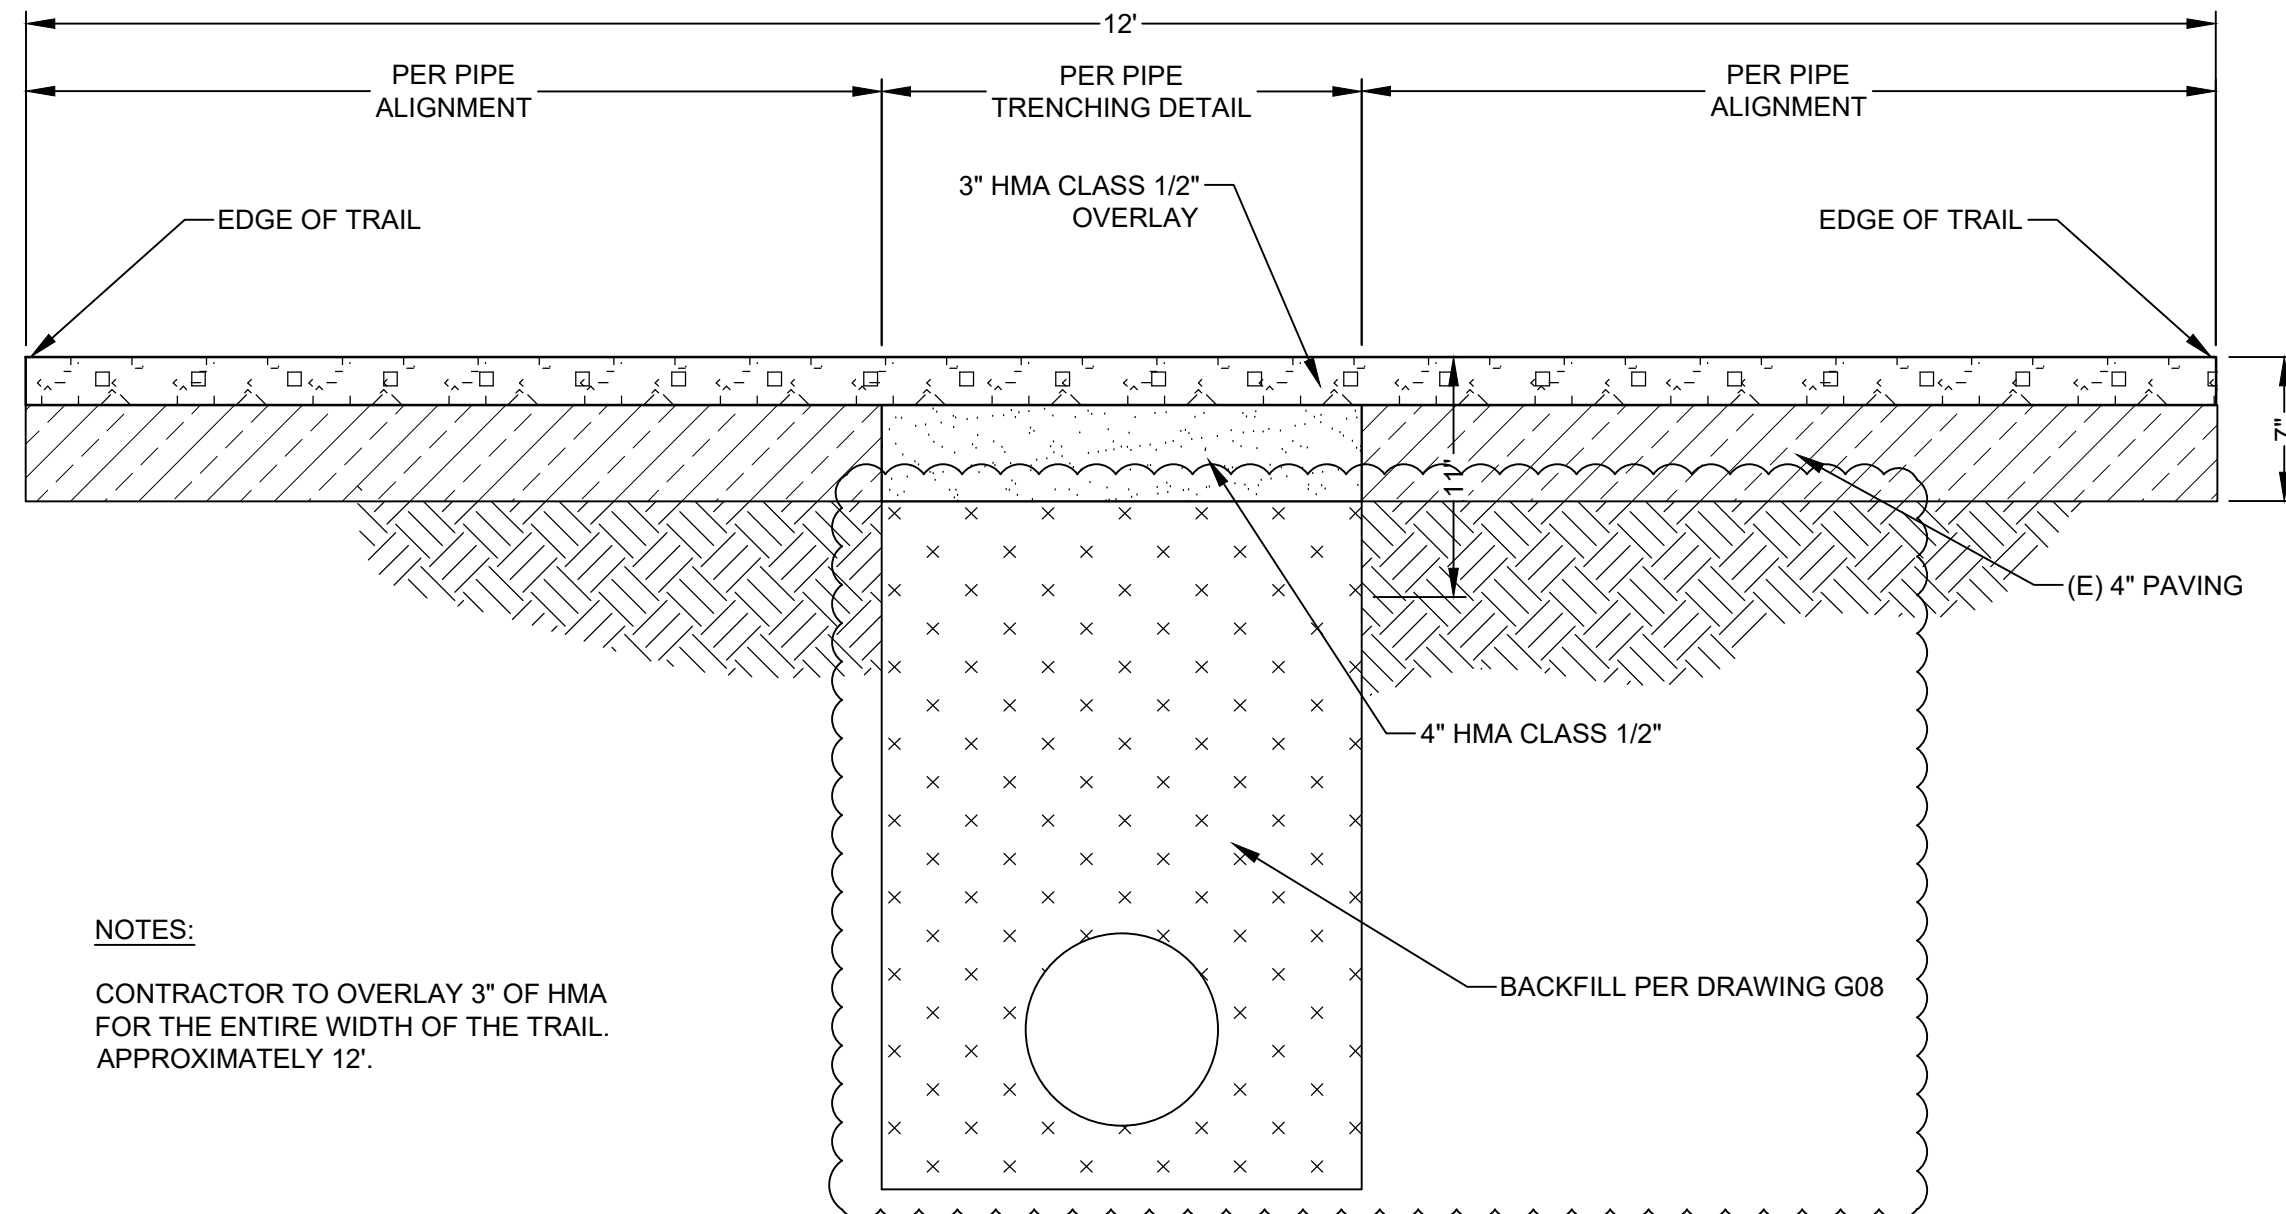

ASPHALT PATCHBACK IN ISSAQUAH PRESTON TRAIL
STA 6+30 TO 20+00 AND STA 50+50 TO STA 51+50

4A
CP1
CP2
CP21
CP22
CP23
CP31

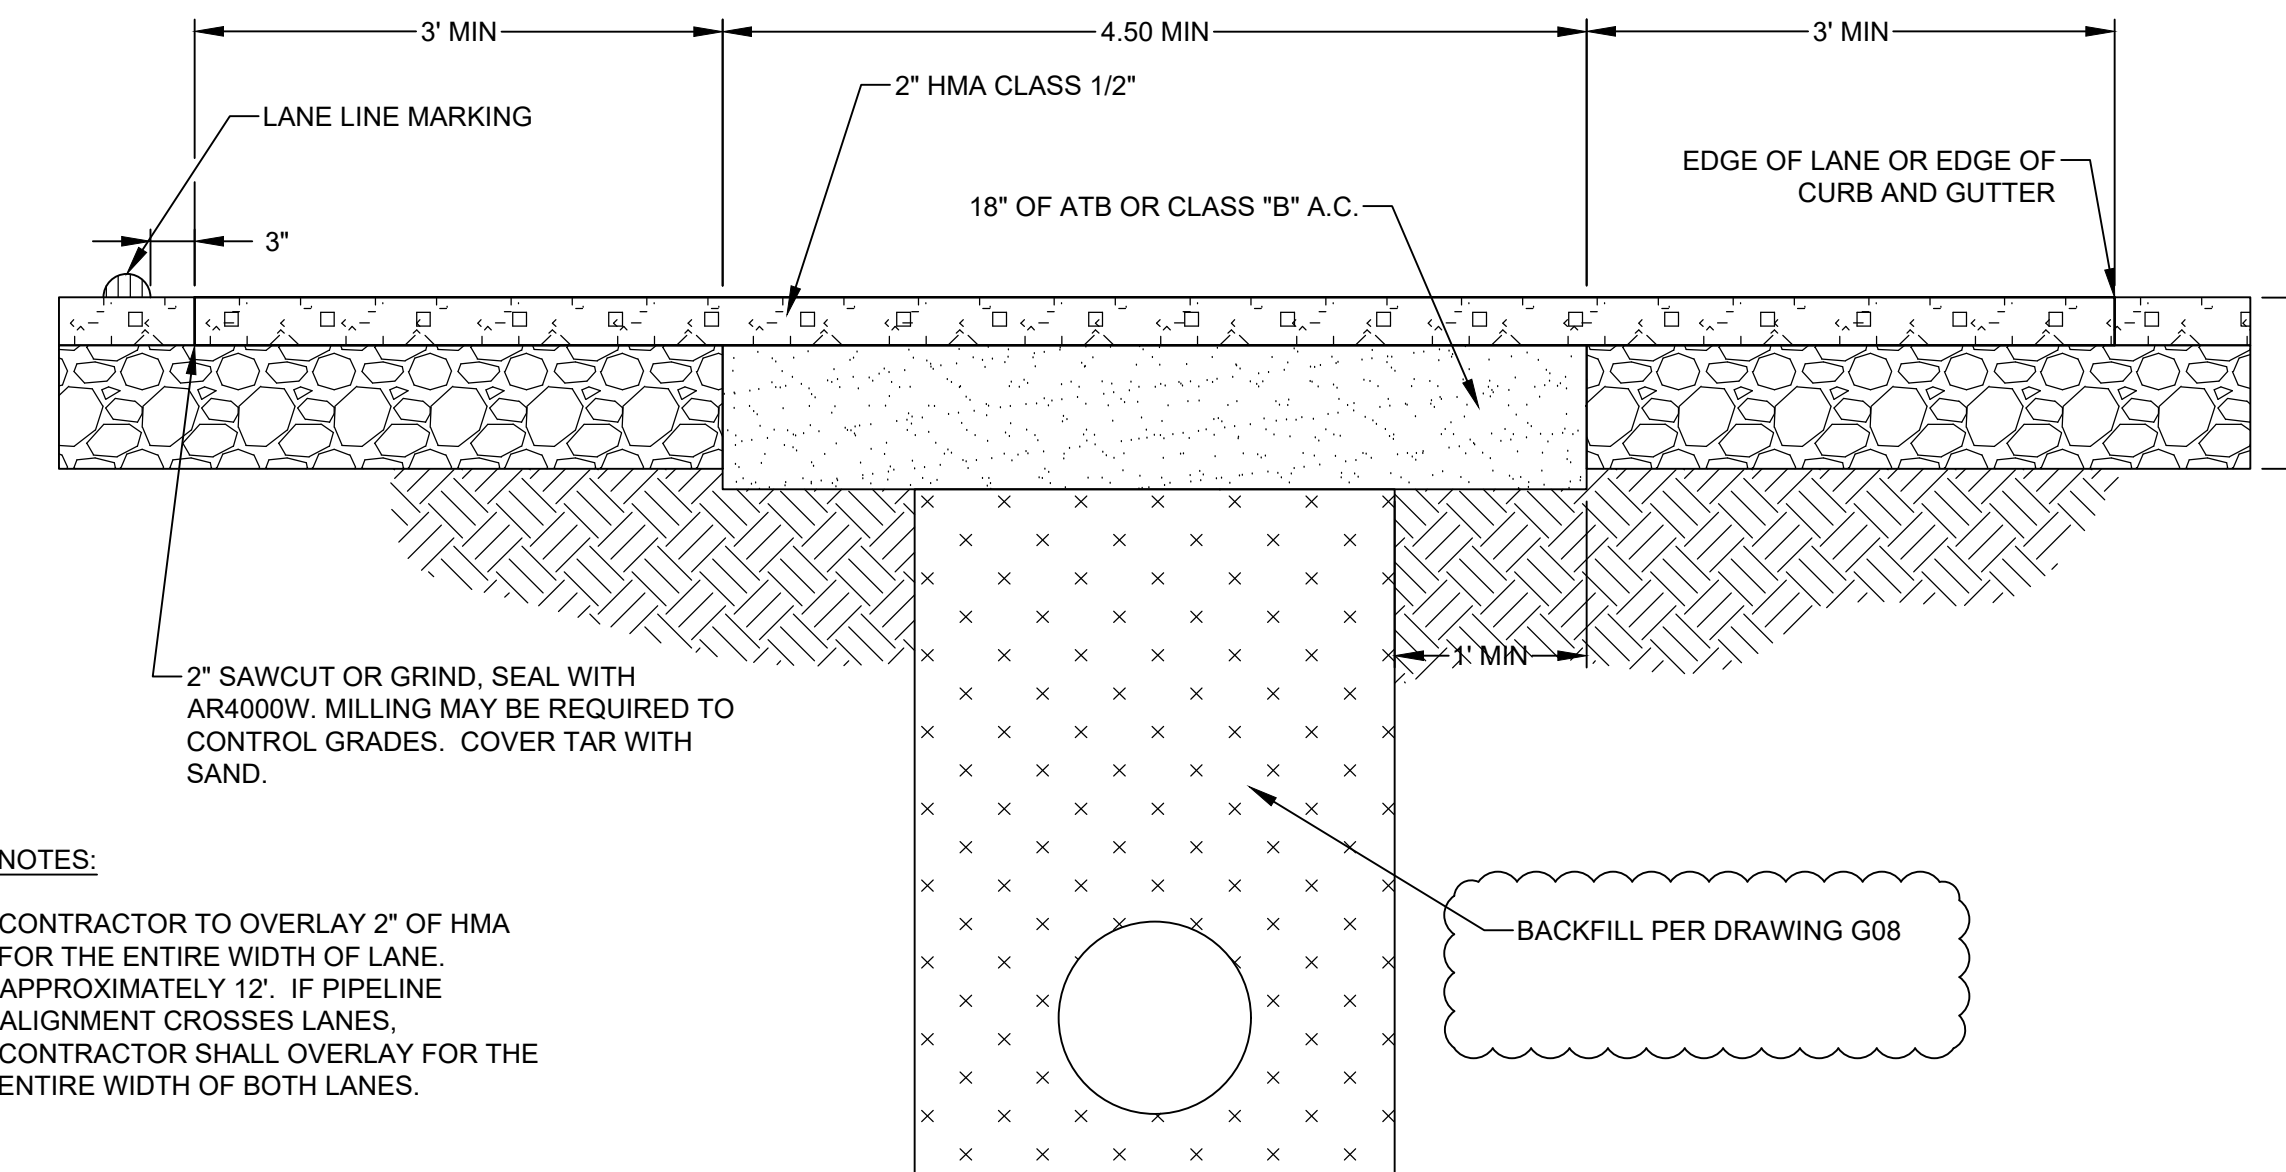

ASPHALT PATCHBACK IN HIGHLANDS DRIVE
STA 78+70 TO 90+92

5
CP26

- NOTES:
1. DETAILS ARE FOR PAVING REQUIREMENTS ONLY. SEE PIPELINE DRAWINGS (CP1-CP8) FOR ALIGNMENT. PAVING DETAILS ARE REFERENCED ON SECTION VIEWS, SEE DRAWINGS CP20 TO CP26.
 2. FOR PAVING LIMITS SEE DRAWINGS CP20 TO CP26.

USE OF DOCUMENTS

THIS DOCUMENT, INCLUDING THE INCORPORATED DESIGNS, IS AN INSTRUMENT OF SERVICE FOR THIS PROJECT AND SHALL NOT BE USED FOR ANY OTHER PROJECT WITHOUT THE WRITTEN AUTHORIZATION OF KENNEDY/JENKS CONSULTANTS.

NO.	REVISION	DATE	BY

SCALES
1" = 25mm
IF THIS BAR IS NOT DIMENSION SHOWN, ADJUST SCALES ACCORDINGLY.



DESIGNED	KSP
DRAWN	RJS
CHECKED	MDL



CITY OF ISSAQUAH
ISSAQUAH, WASHINGTON
SOUTH SPAR BOOSTER PUMP STATION


Kennedy/Jenks Consultants
FEDERAL WAY, WASHINGTON

CIVIL DETAILS - 1

90% SUBMITTAL (REVISED 11/30/2020)

FILE NAME	139700500-C006.DWG
JOB NO.	1397005*00
DATE	NOVEMBER 2020
SHEET	OF
C6	


11/30/2020 10:02 PM
DANPHIPPS
\\jc.local\\JC-Rod\\K-Office\\FW\\CADCAD\\131397005_00_City_of_Issaquah\\139700500-C007.dwg

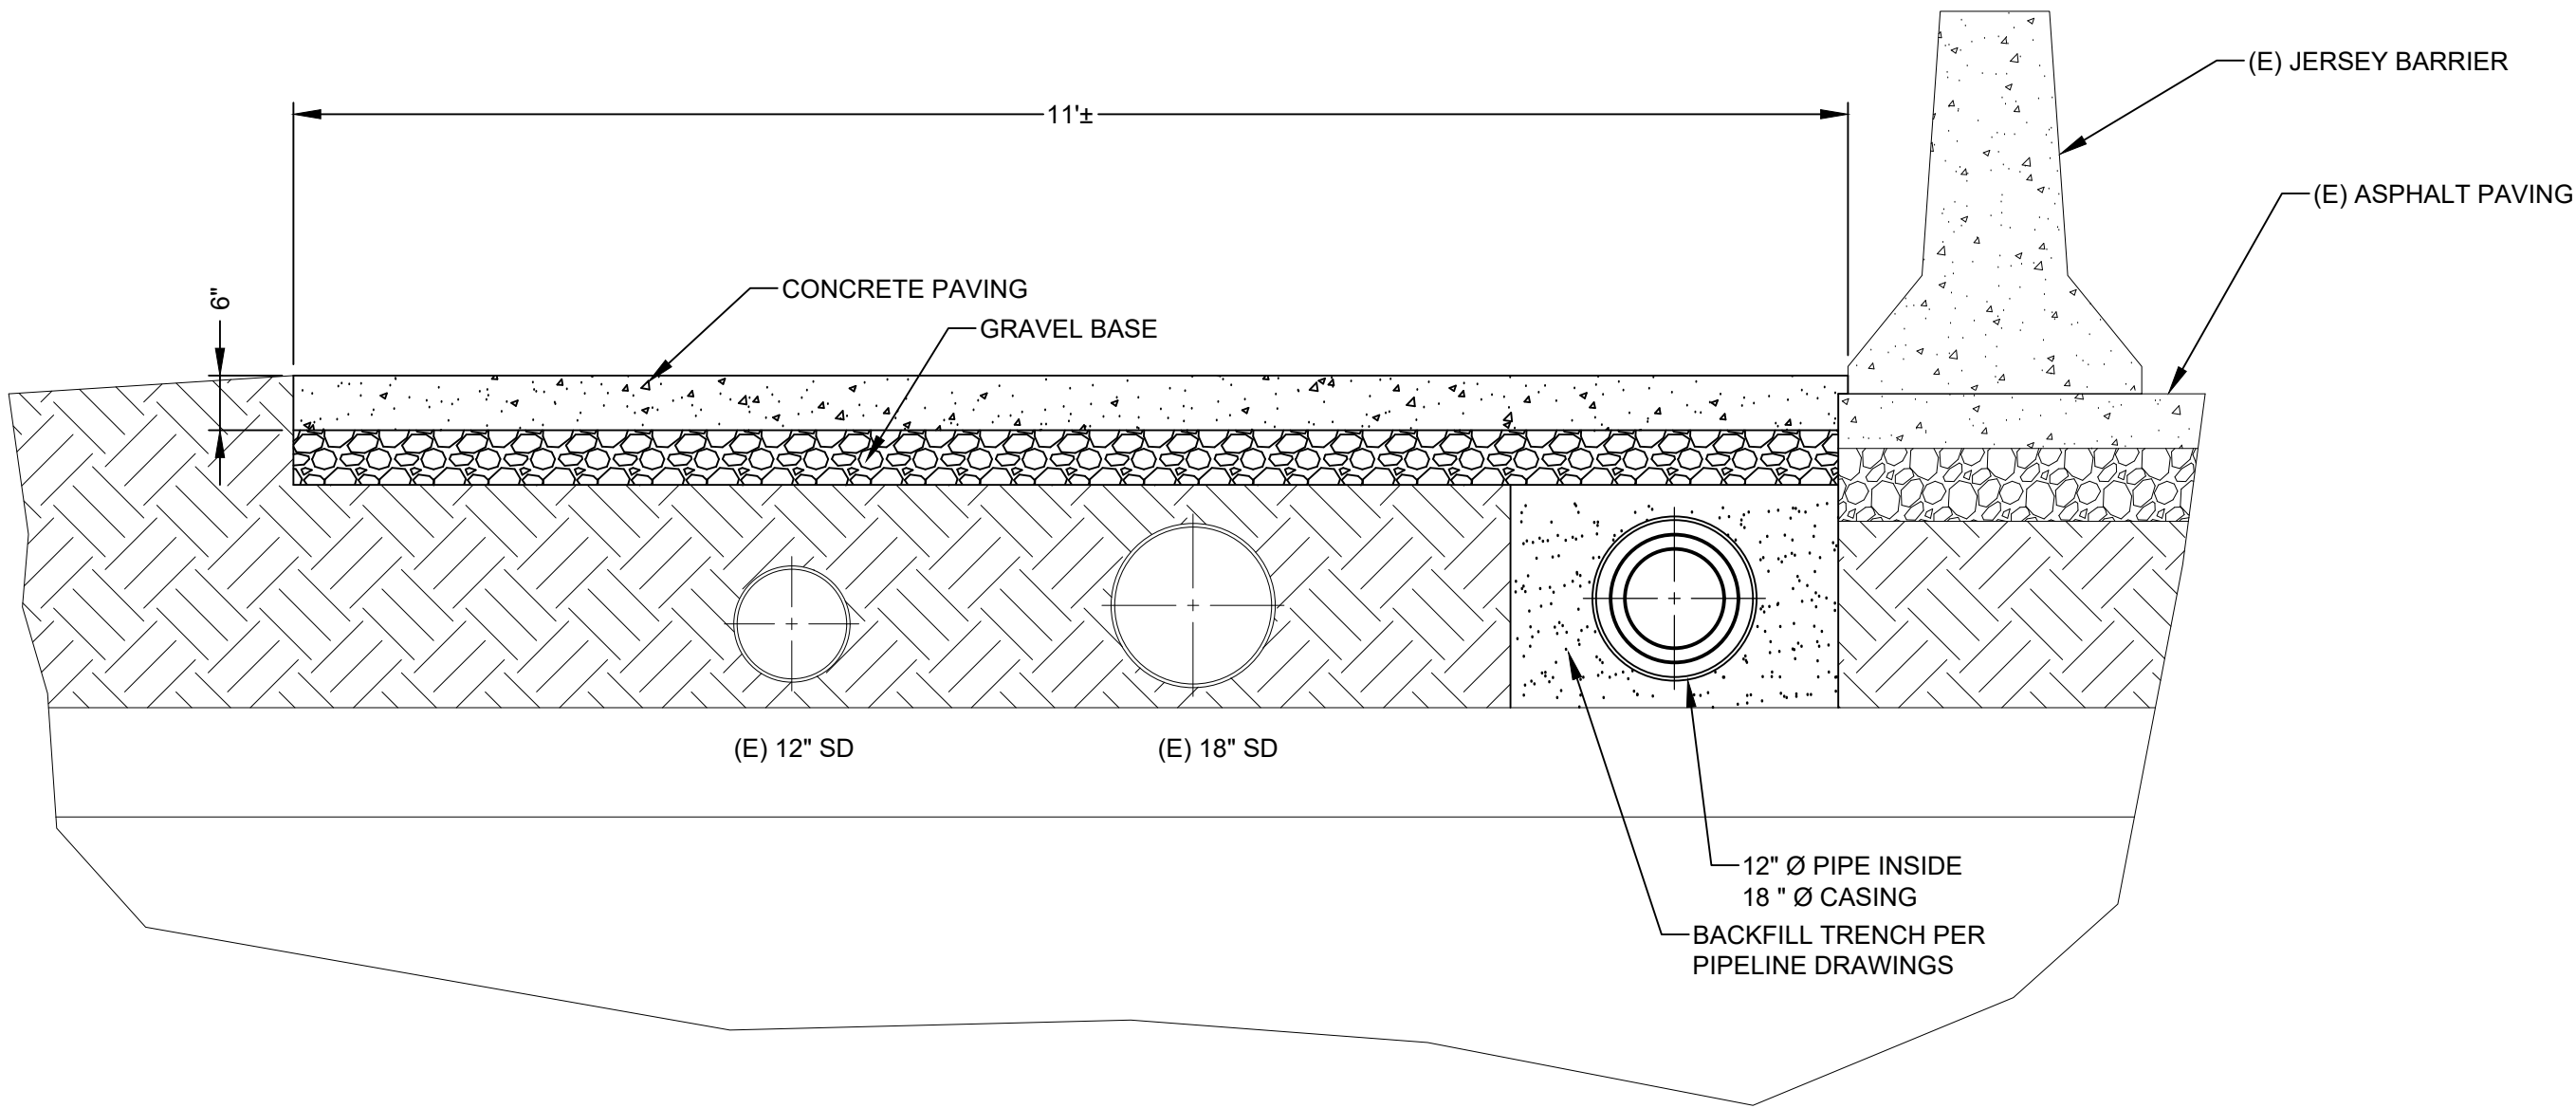

- NOTES:
1. CONTRACTOR TO REMOVE (E) 4-INCH THICK ASPHALT AND RE-PAVE WITH 6-INCH THICK CONCRETE. MATCH GRADE WITH ASPHALT PAVING OVERLAY ON BOTH ENDS.
 2. FOR PAVING LIMITS SEE SHEETS CP20 TO CP26.

CONCRETE PAVING AT PEDESTRIAN TUNNEL


6
CP5

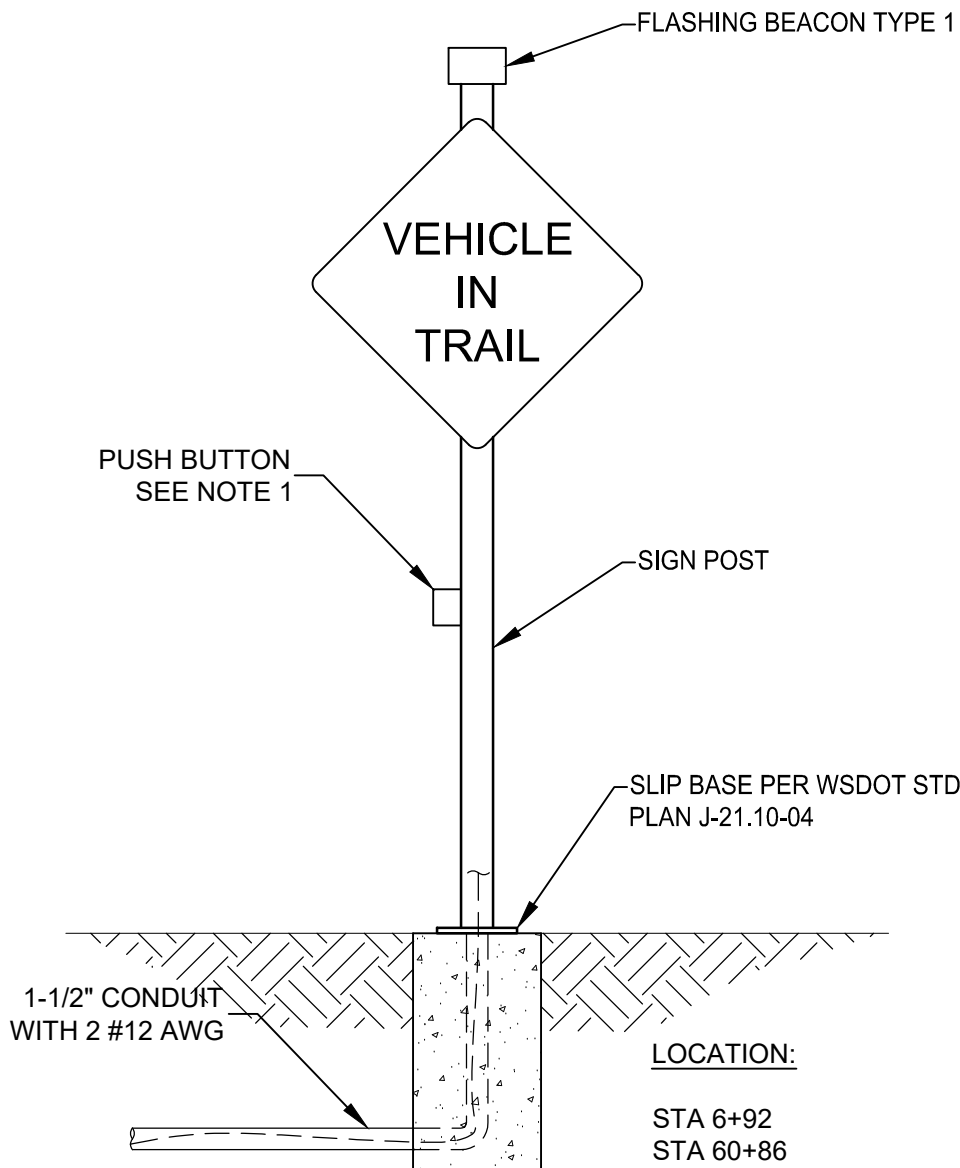

- NOTES:
1. PROVIDE SIGN AND POST ASSEMBLY PER WSDOT STANDARD DETAIL J-21.16-01 EXCEPT AS MODIFIED ABOVE.
 2. BEACON ACTIVATION TO BE FROM POSITION SWITCH UNDERNEATH REMOVABLE BOLLARD, ACTIVATION BUTTON ON SIGN POST, OR FROM CONTROL SYSTEM AT PUMP STATION. ACTIVATION BUTTON TO BE INSTALLED IN A LOCKING ENCLOSURE.
 3. FOR FLASHING BEACON WARNING SEE WSDOT STD PLAN J-21.17-01.

VEHICLE IN TRAIL SIGN

7
CP1
CP5

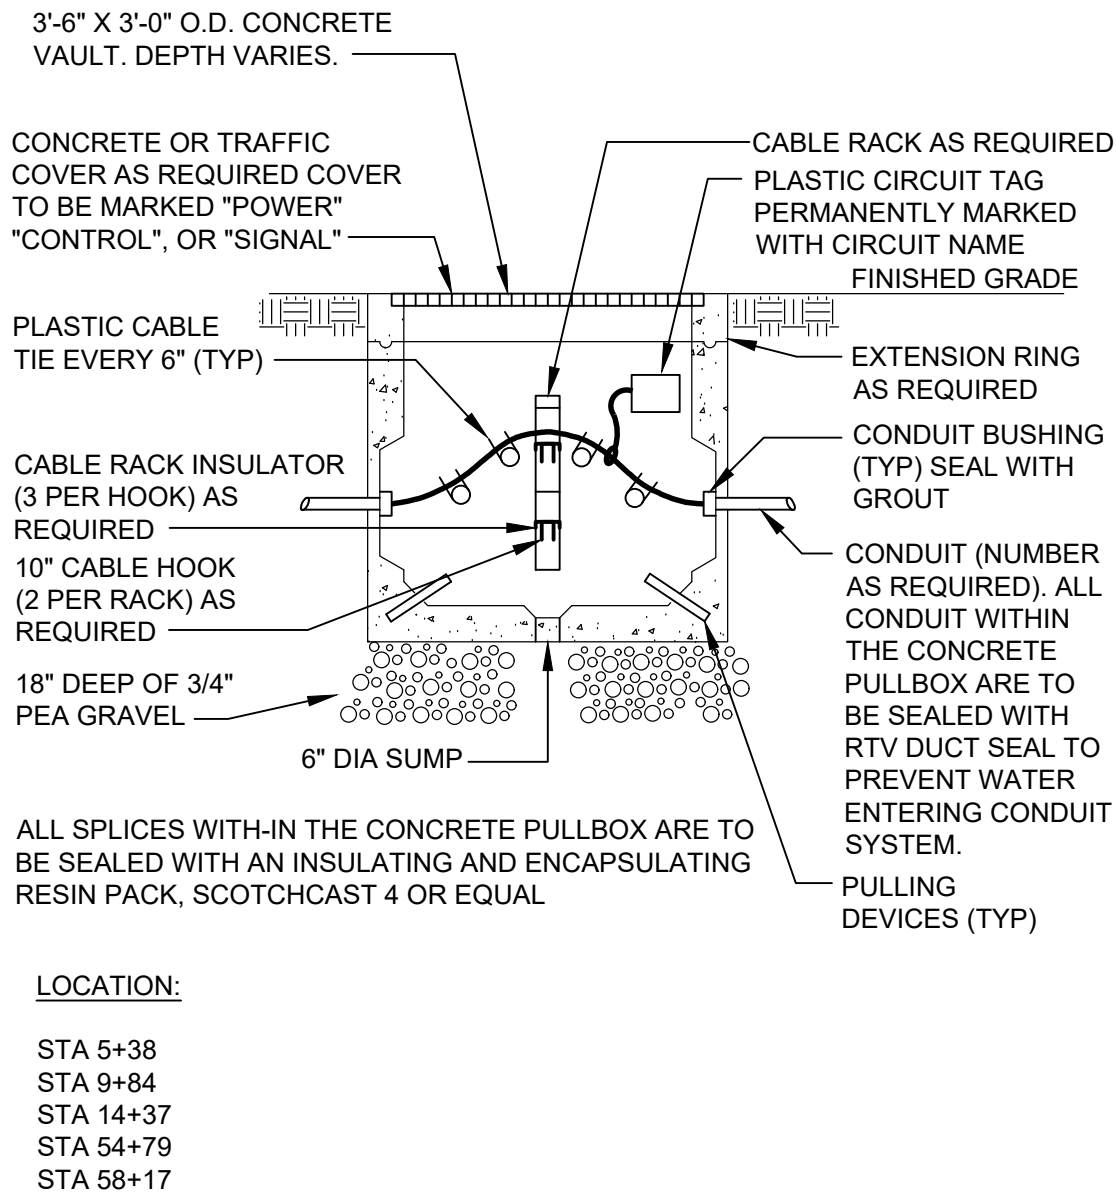

LOCATION:
STA 5+38
STA 9+84
STA 14+37
STA 54+79
STA 58+17

TELEMETRY PULLBOX INSTALLATION

9
CP1
CP2
CP4
CP5


(NOT USED)

8
C1

USE OF DOCUMENTS THIS DOCUMENT, INCLUDING THE INCORPORATED DESIGNS, IS AN INSTRUMENT OF SERVICE FOR THIS PROJECT AND SHALL NOT BE USED FOR ANY OTHER PROJECT WITHOUT THE WRITTEN AUTHORIZATION OF KENNEDY/JENKS CONSULTANTS.					<div>SCALES</div> <div>0 1" 0 25mm</div> <div>IF THIS BAR IS NOT DIMENSION SHOWN, ADJUST SCALES ACCORDINGLY.</div>		DESIGNED		CITY OF ISSAQUAH ISSAQUAH, WASHINGTON SOUTH SPAR BOOSTER PUMP STATION Kennedy/Jenks Consultants FEDERAL WAY, WASHINGTON	CIVIL DETAILS - 2			FILE NAME
							139700500-C007.DWG						
							JOB NO.						
							1397005*00						
							DATE						
											NOVEMBER 2020		
										90% SUBMITTAL (REVISED 11/30/2020)			SHEET 29 OF 83
	NO.	REVISION	DATE	BY									C7


90% SUBMITTAL (REVISED 11/30/2020)

11/30/2020 10:11 PM
DANPHIPPS
\\jc.local\\JC-Rodrik-Office\\FWY\\CADCAD\\131397005.00_City_of_Issaquah\\139700500-C008.dwg

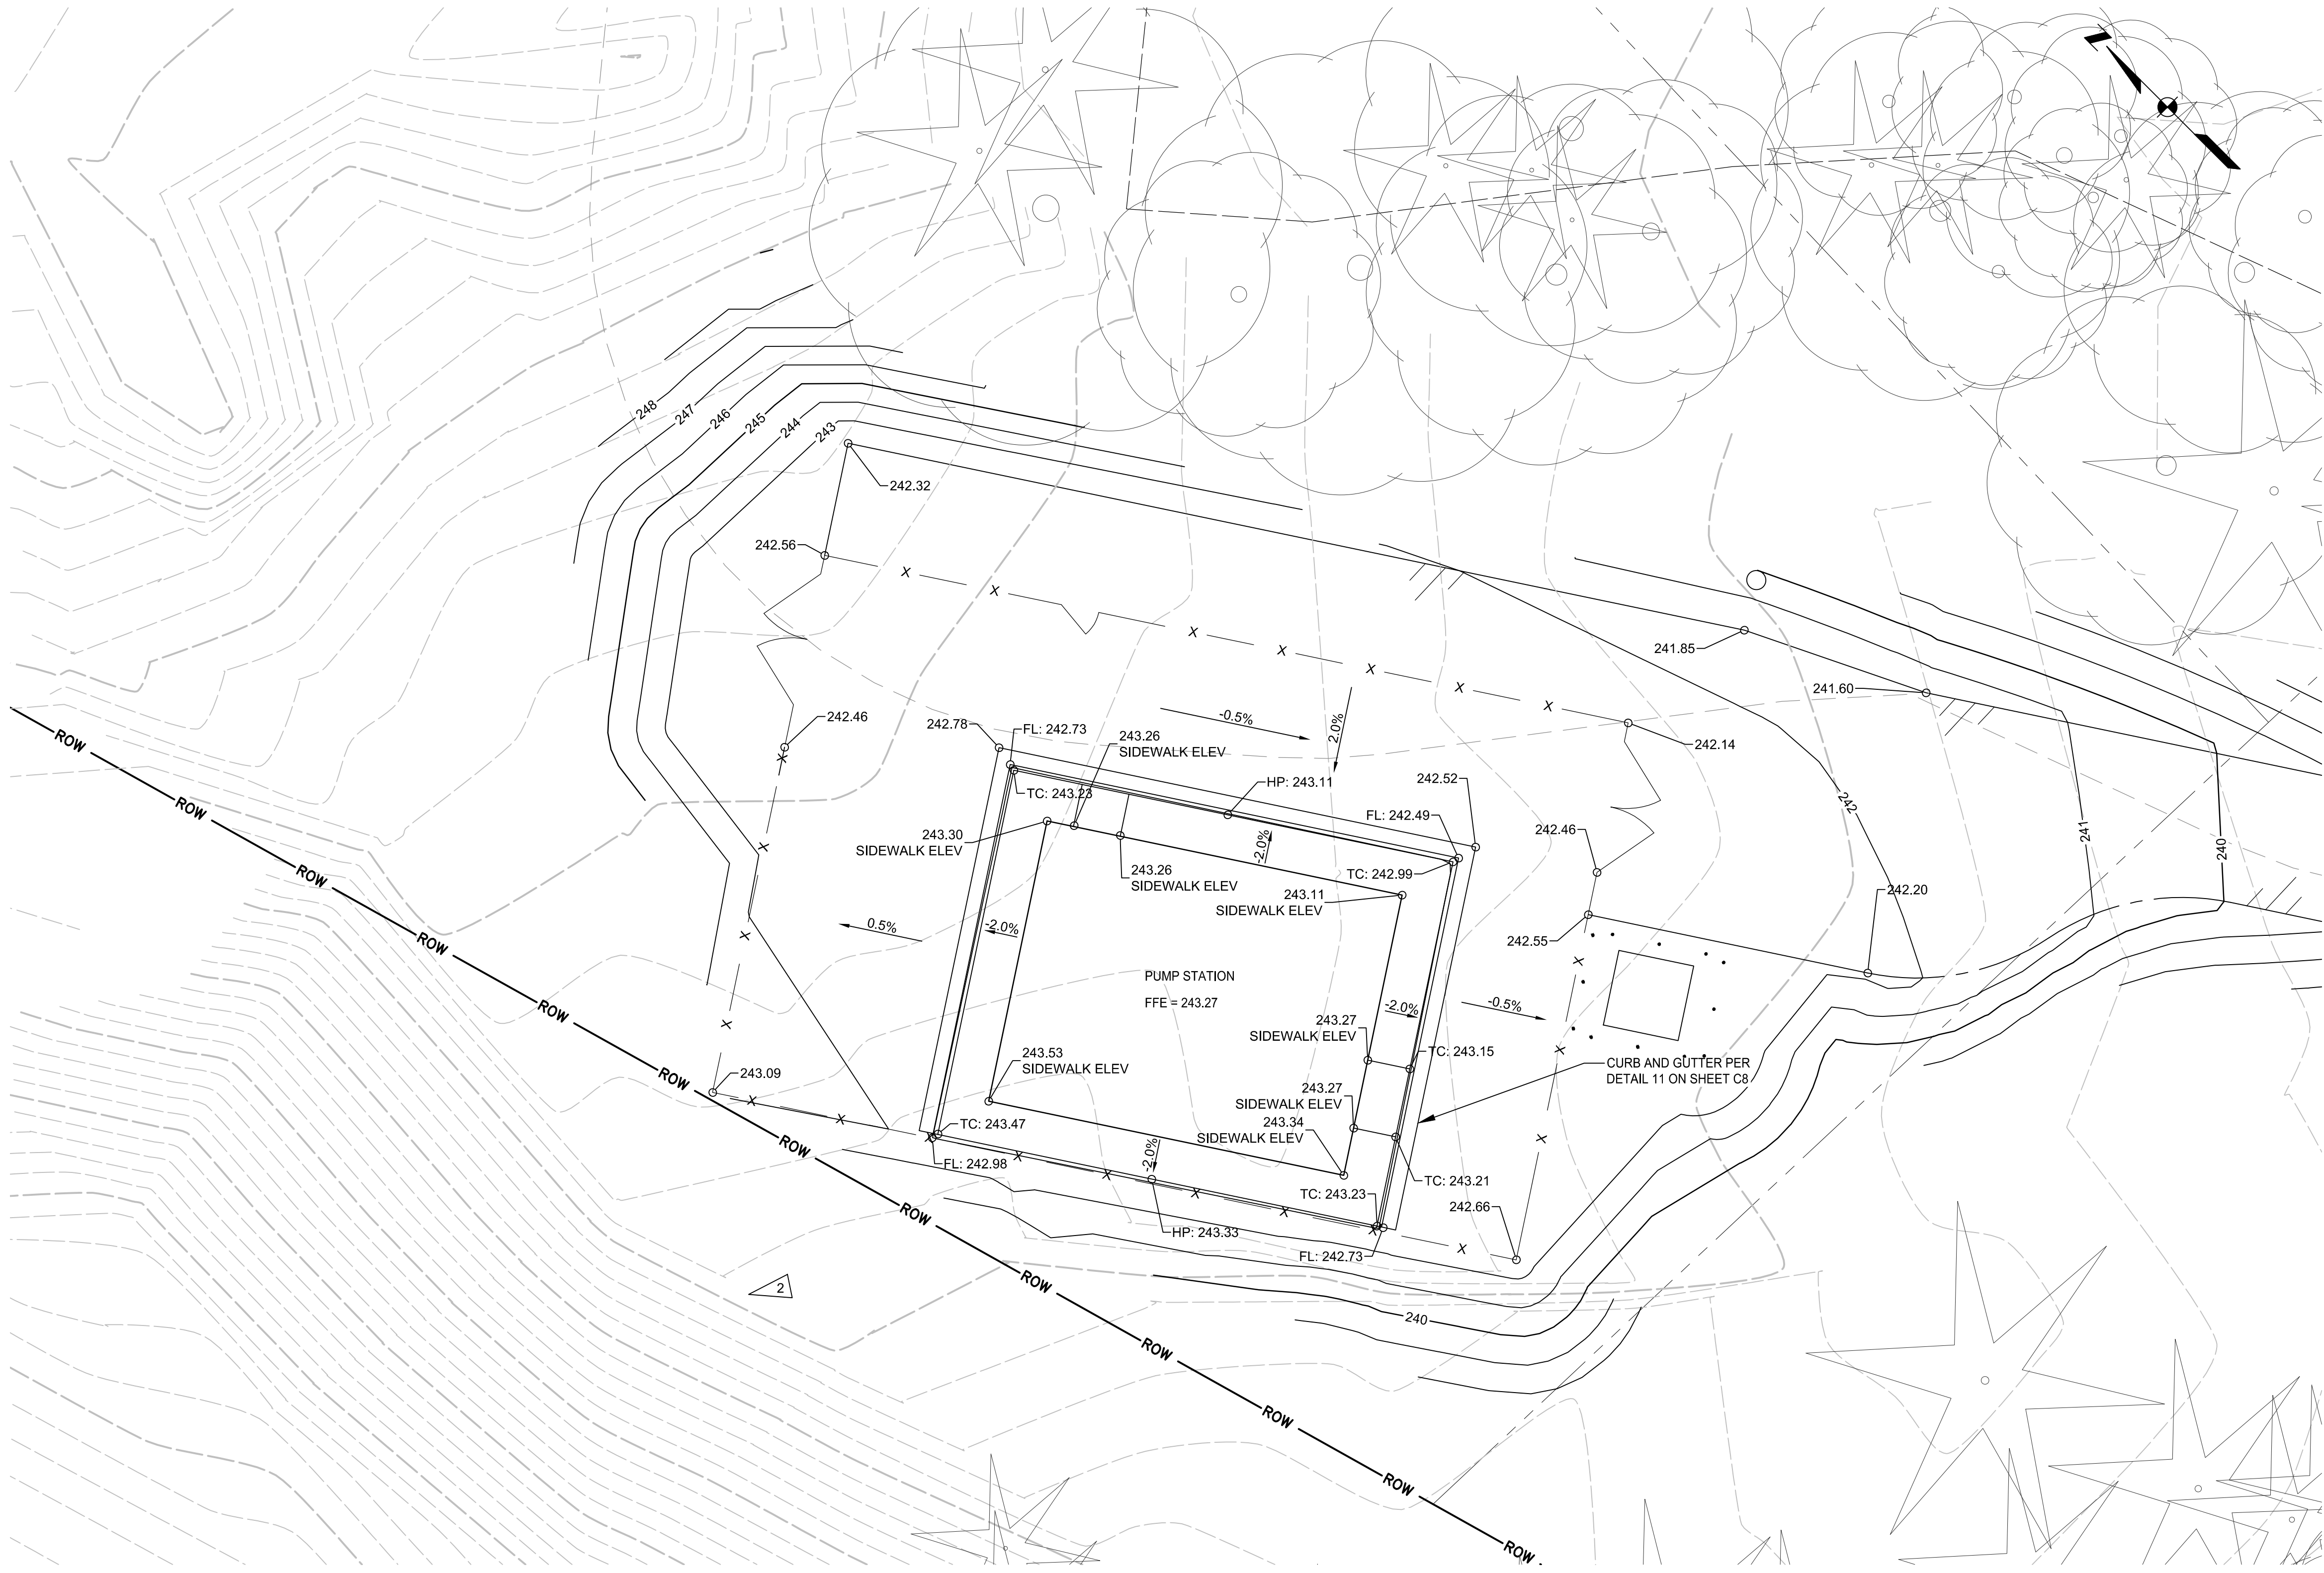

- NOTES:
- SEE SHEETS C3 AND C4 FOR ACCESS ROAD PLAN AND PROFILE.
 - MAINTAIN 30' MINIMUM CLEARANCE BETWEEN STRUCTURES AND STEEP SLOPE.

PARTIAL GRADING PLAN

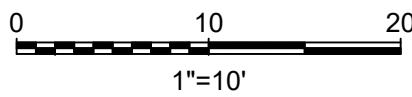

USE OF DOCUMENTS

THIS DOCUMENT, INCLUDING THE INCORPORATED DESIGNS, IS AN INSTRUMENT OF SERVICE FOR THIS PROJECT AND SHALL NOT BE USED FOR ANY OTHER PROJECT WITHOUT THE WRITTEN AUTHORIZATION OF KENNEDY/JENKS CONSULTANTS.

NO.	REVISION	DATE	BY

SCALES
0 1"
0 25mm
IF THIS BAR IS NOT
DIMENSION SHOWN,
ADJUST SCALES
ACCORDINGLY.



DESIGNED	KSP
DRAWN	LMM
CHECKED	MDL



CITY OF ISSAQUAH
ISSAQUAH, WASHINGTON
SOUTH SPAR BOOSTER PUMP STATION


Kennedy/Jenks Consultants
FEDERAL WAY, WASHINGTON

PUMP STATION GRADING PARTIAL PLAN

90% SUBMITTAL (REVISED 11/30/2020)


FILE NAME	139700500-C008.DWG
JOB NO.	1397005*00
DATE	NOVEMBER 2020
SHEET	30 OF 83
	C8

11/30/2020 10:14 PM
DANPHIPPS
\\jc.local\\JC-Rodrik-Office\\FWY\\CADCAD\\131397005.00_City_of_Issaquah\\139700500-C009.dwg

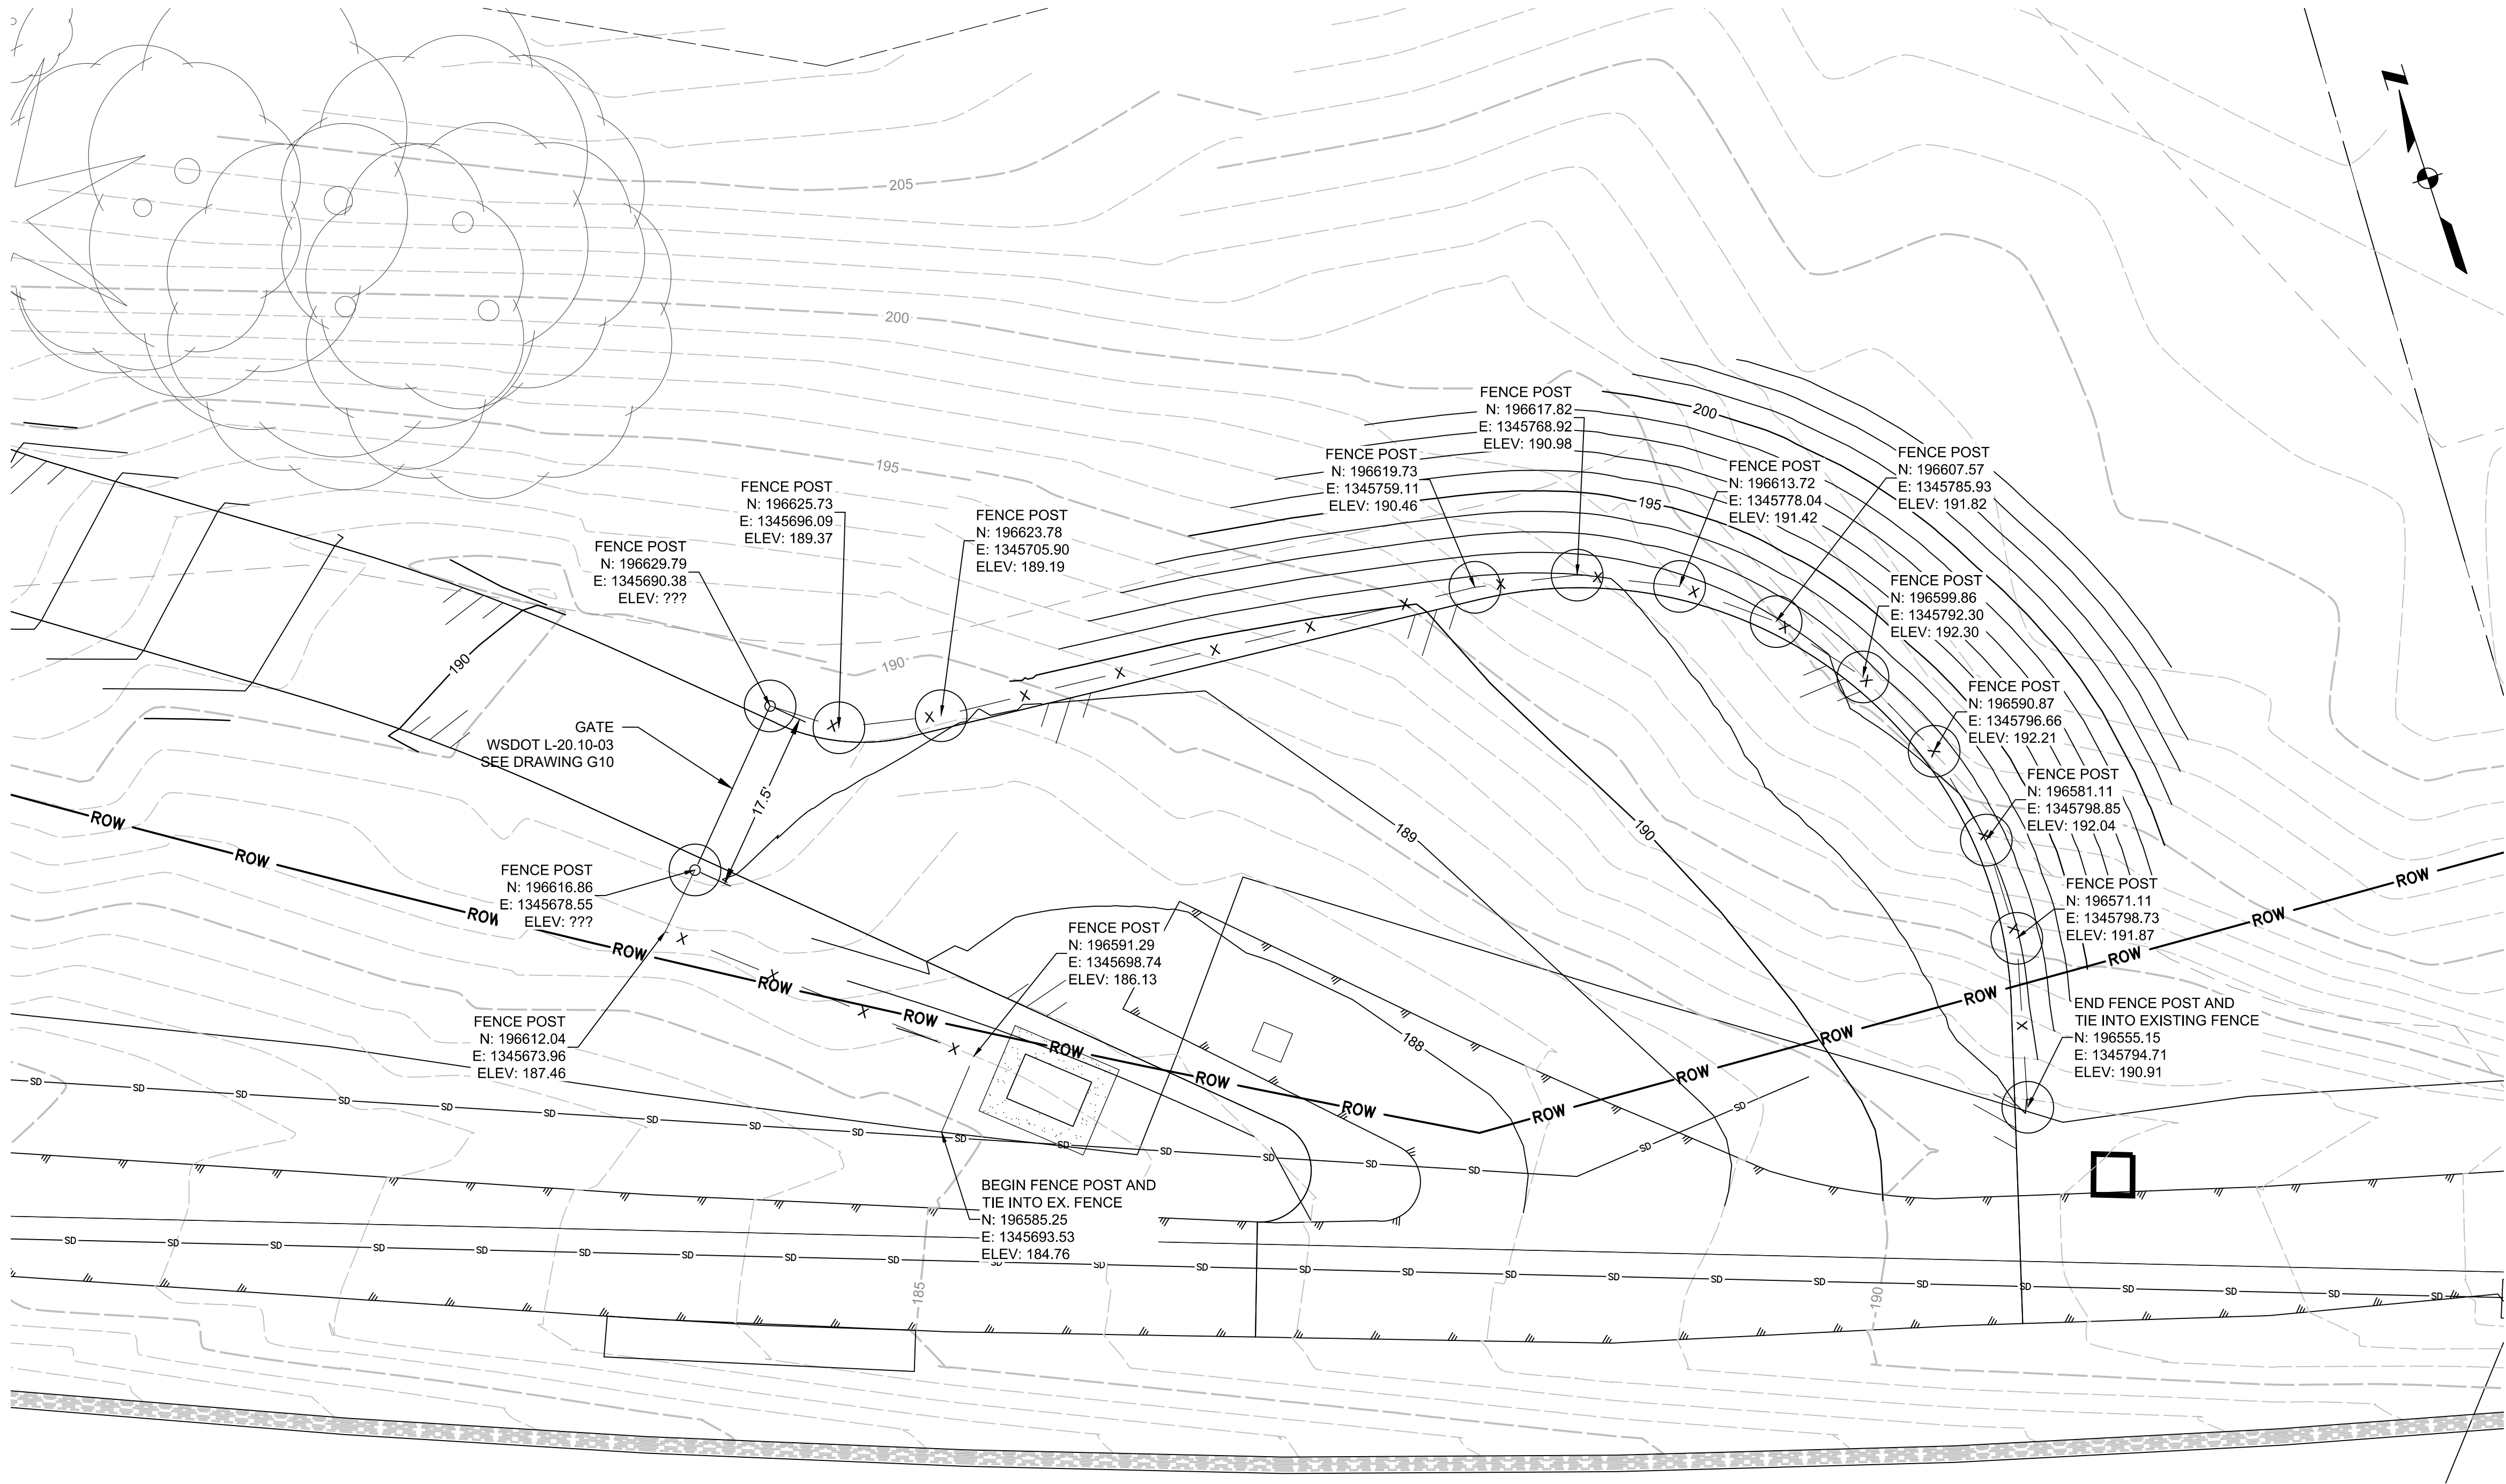

- NOTES:
1. INSTALL 6'-0" HEIGHT CHAIN LINK FENCE TYPE 3 PER WSDOT STANDARD PLAN L-20.10-03. SEE DRAWING G10.
 2. ELEVATIONS PROVIDED ARE FOR THE BASE OF THE 6'-0" FENCE


ACCESS ROAD GATE AND FENCE PLAN

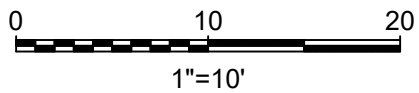

USE OF DOCUMENTS

THIS DOCUMENT, INCLUDING THE INCORPORATED DESIGNS, IS AN INSTRUMENT OF SERVICE FOR THIS PROJECT AND SHALL NOT BE USED FOR ANY OTHER PROJECT WITHOUT THE WRITTEN AUTHORIZATION OF KENNEDY/JENKS CONSULTANTS.

NO.	REVISION	DATE	BY

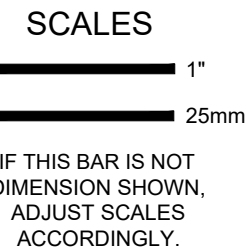

DESIGNED	KSP
DRAWN	LMM
CHECKED	MDL



CITY OF ISSAQUAH
ISSAQUAH, WASHINGTON
SOUTH SPAR BOOSTER PUMP STATION

Kennedy/Jenks Consultants
FEDERAL WAY, WASHINGTON

ACCESS ROAD GATE AND FENCE PLAN


90% SUBMITTAL (REVISED 11/30/2020)

FILE NAME	139700500-C009.DWG
JOB NO.	1397005'00
DATE	NOVEMBER 2020
SHEET	31 OF 83
	C9

P:\CAD\13\1397005_00_City_of_Issaquah\139700500-C010.dwg 7/2/2020 4:08 PM MIKEMARX




<div>USE OF DOCUMENTS</div> <div>THIS DOCUMENT, INCLUDING THE INCORPORATED DESIGNS, IS AN INSTRUMENT OF SERVICE FOR THIS PROJECT AND SHALL NOT BE USED FOR ANY OTHER PROJECT WITHOUT THE WRITTEN AUTHORIZATION OF KENNEDY/JENKS CONSULTANTS.</div>					<div>SCALES</div> <div><div>01"0</div><div>025mm</div></div> <div>IF THIS BAR IS NOT DIMENSION SHOWN, ADJUST SCALES ACCORDINGLY.</div>	<div></div>	DESIGNED	<div></div>	<div>CITY OF ISSAQUAH</div> <div>ISSAQUAH, WASHINGTON</div> <div>SOUTH SPAR BOOSTER PUMP STATION</div>	<div>SHEET NOT USED</div>	<div>FILE NAME</div> <div>139700500-C010.DWG</div> <div>JOB NO.</div> <div>1397005*00</div> <div>DATE</div> <div>JUNE 2020</div> <div>SHEET 32 OF 83</div> <div>C10</div>
							DRAWN				
							LMM				
							CHECKED				
							MDL				
	NO.	REVISION	DATE	BY			Kennedy/Jenks Consultants		FEDERAL WAY, WASHINGTON		

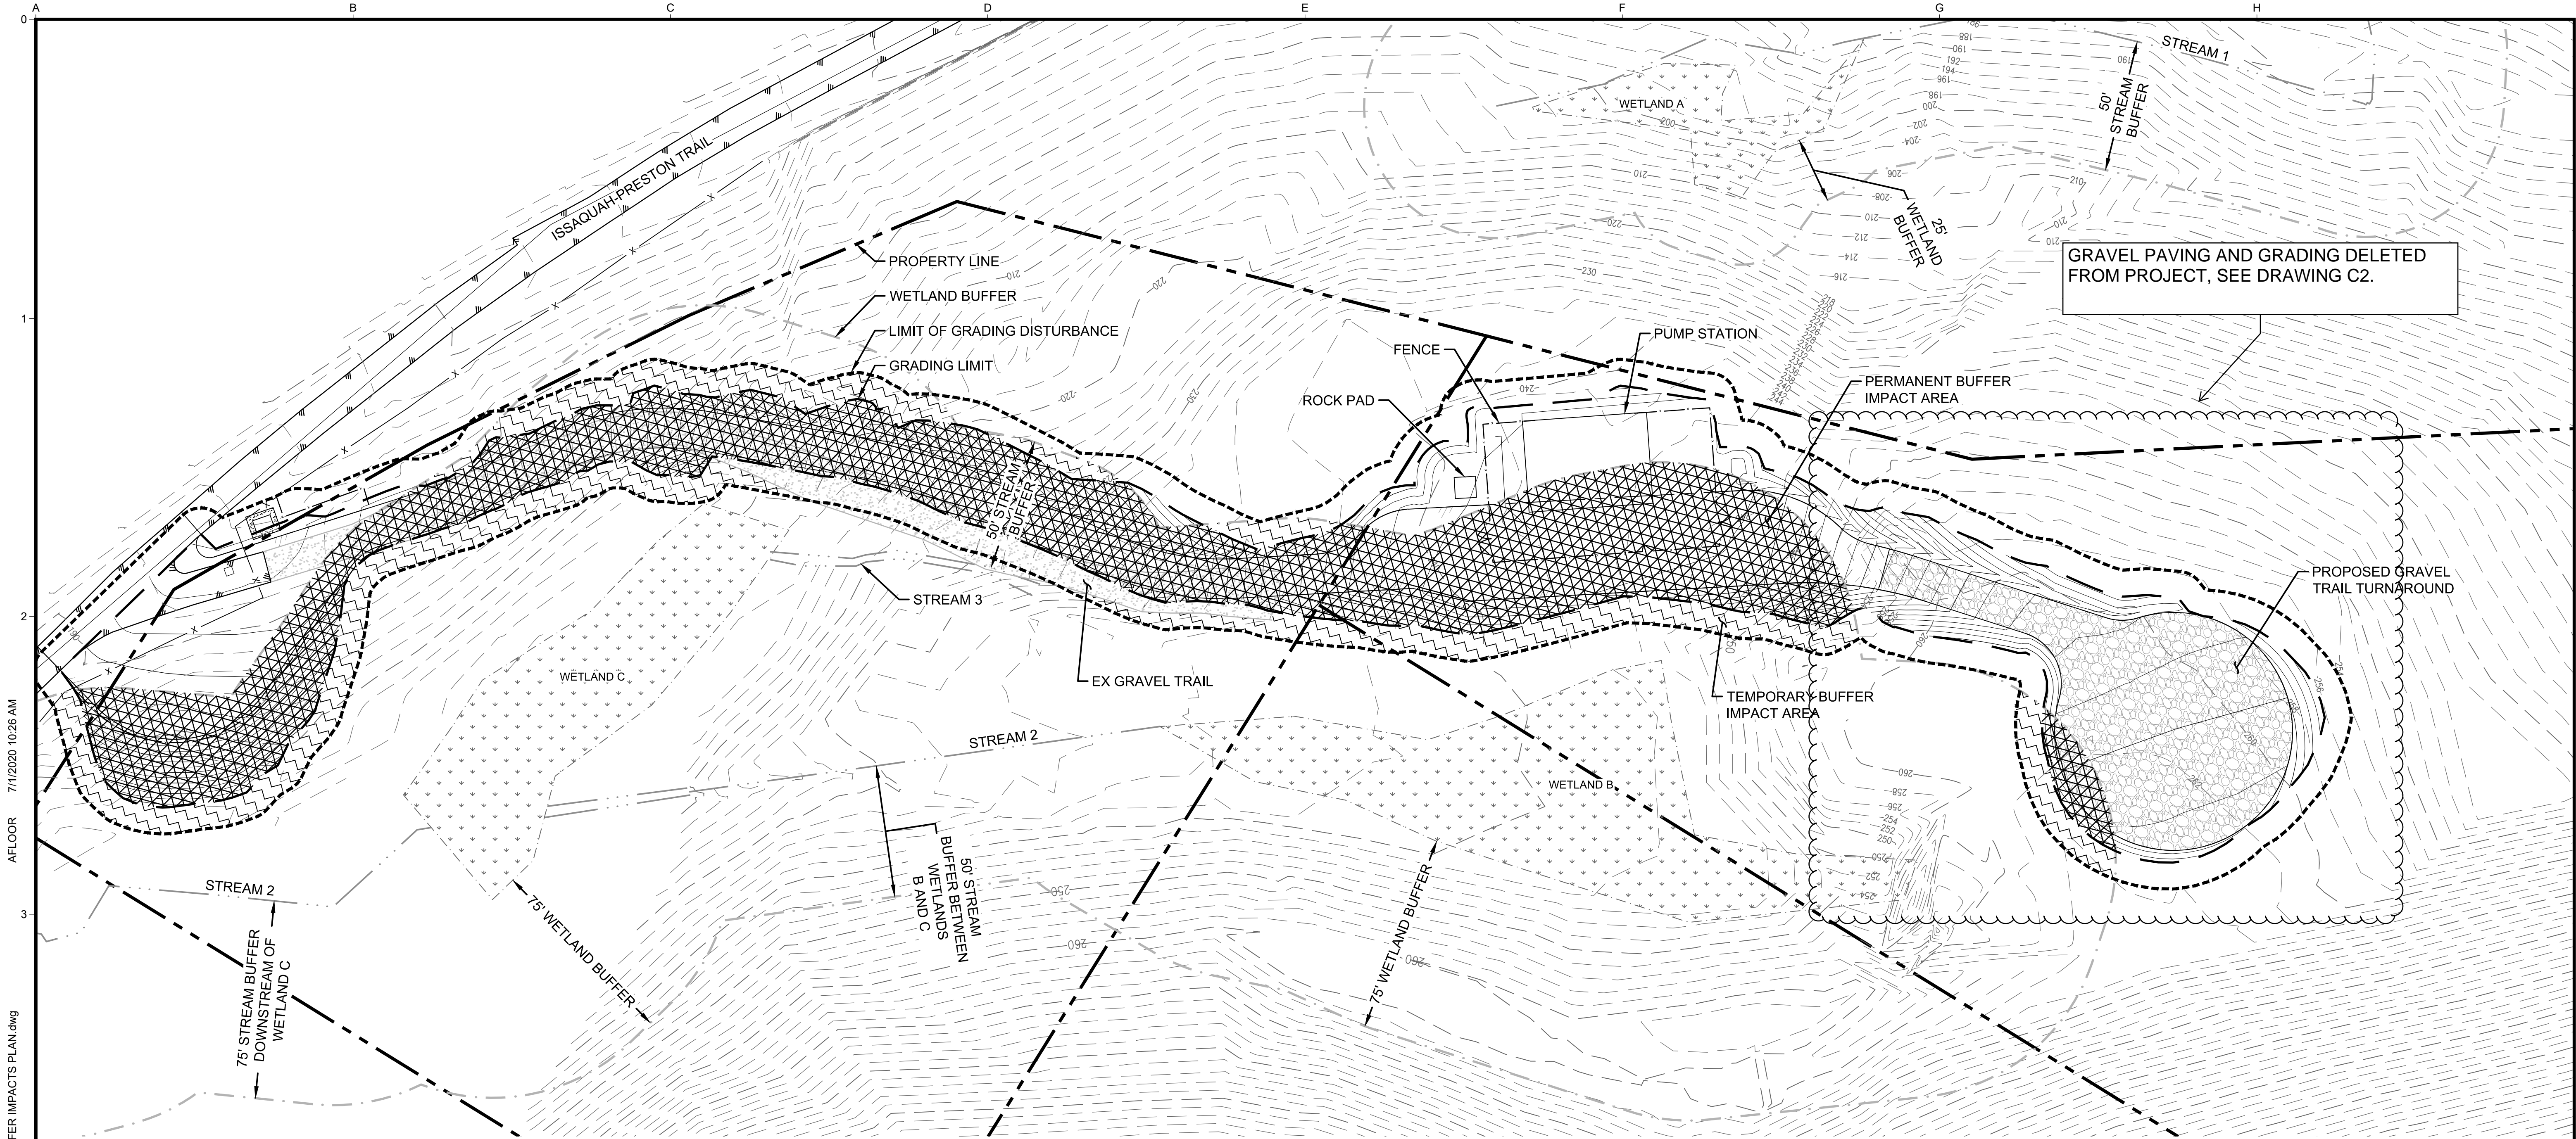

7/1/2020 10:26 AM
AFLOOR



U:\Projects\SEA\16xxxx\160917.00 S.SPABR Booster Pump Station\08_CADD\Drawings\90%_REVISED\L1_BUFFER IMPACTS PLAN.dwg

LEGEND

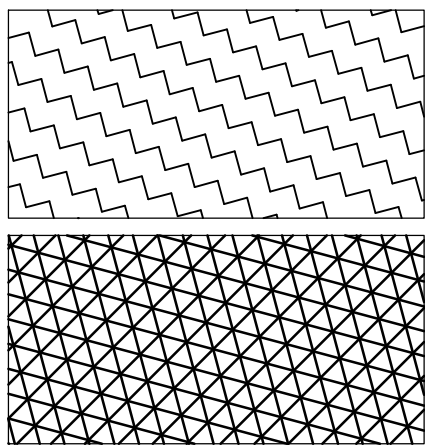

NOTES

- 1. SEE SHEET L2 FOR THE BUFFER MITIGATION PLAN.
- 2. SEE SHEET L3 FOR BUFFER MITIGATION PLANTING DETAILS, NOTES, AND SCHEDULES.

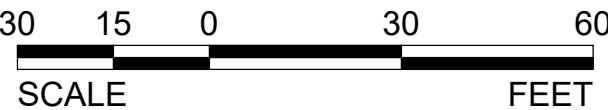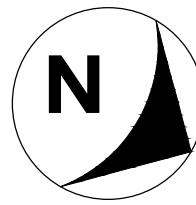

USE OF DOCUMENTS THIS DOCUMENT, INCLUDING THE INCORPORATED DESIGNS, IS AN INSTRUMENT OF SERVICE FOR THIS PROJECT AND SHALL NOT BE USED FOR ANY OTHER PROJECT WITHOUT THE WRITTEN AUTHORIZATION OF KENNEDY/JENKS CONSULTANTS.					
	NO.	REVISION	DATE	BY	

SCALES

0 1" 25mm

IF THIS BAR IS NOT DIMENSION SHOWN, ADJUST SCALES ACCORDINGLY.

DESIGNED	ABG
DRAWN	ABG
CHECKED	SAR

CITY OF ISSAQUAH
ISSAQUAH, WASHINGTON


SOUTH SPAR BOOSTER PUMP STATION

Environmental Science Associates
SEATTLE, WASHINGTON


90% SUBMITTAL (REVISED 7/1/2020)

FILE NAME	
JOB NO.	1397005*00
DATE	JUNE 2020
SHEET	OF
L1	


U:\Projects\SEA\16xxxx\160917.00_S.SPAR Booster Pump Station\08_CADD\Drawings\90%_REVISED\3 BUFFER MITIGATION DETAILS.dwg 10/26/2020 10:43 AM AGREENBERG

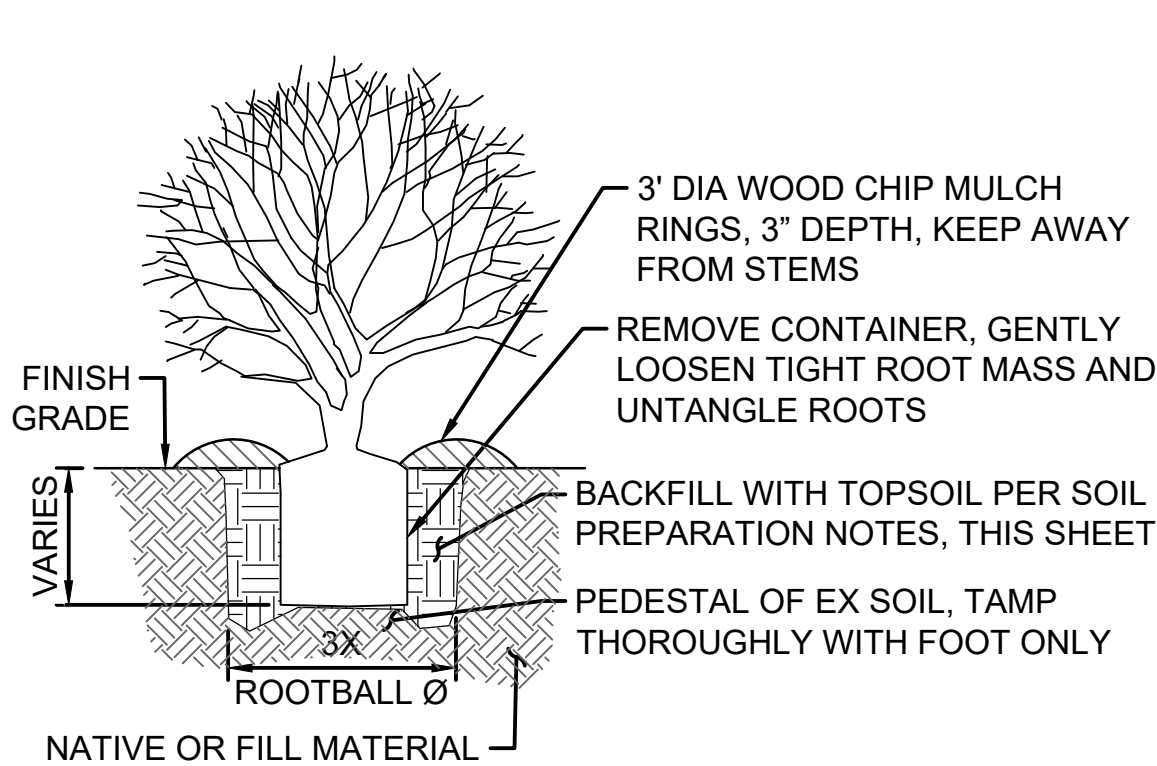

1 CONTAINER PLANTING
DETAIL SCALE: NTS

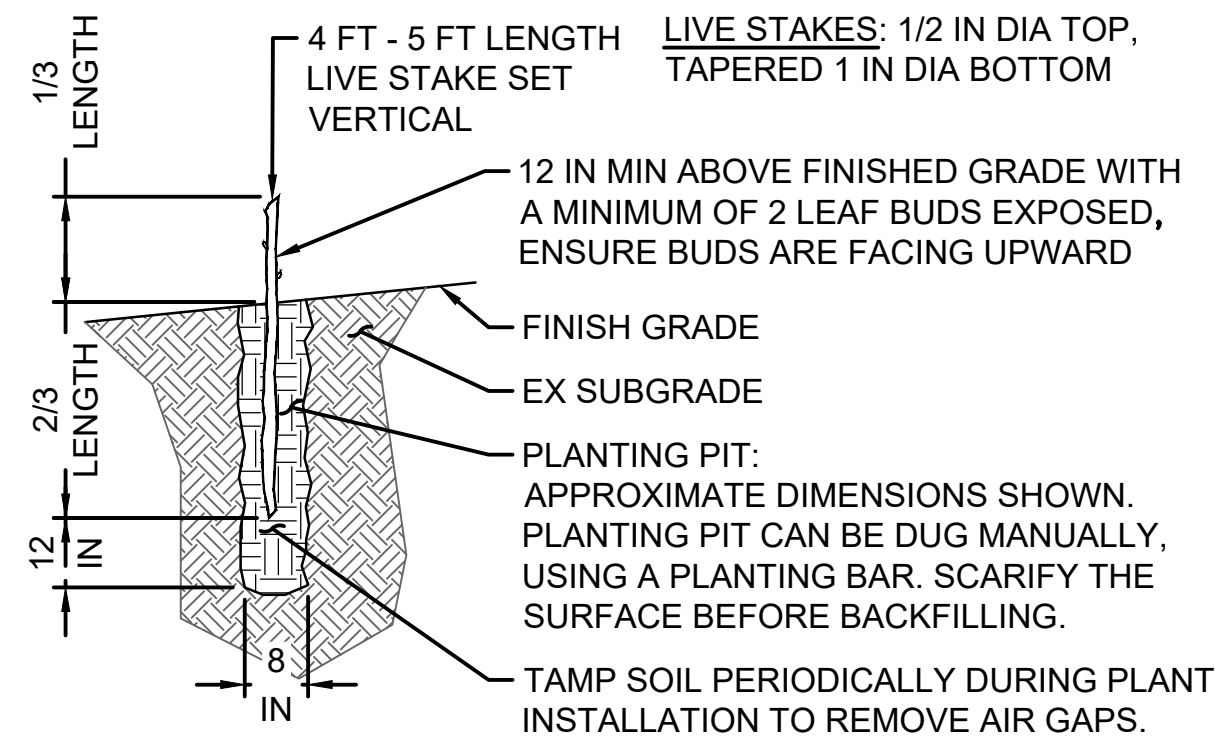


3 LIVESTAKE PLANTING
DETAIL SCALE: NTS

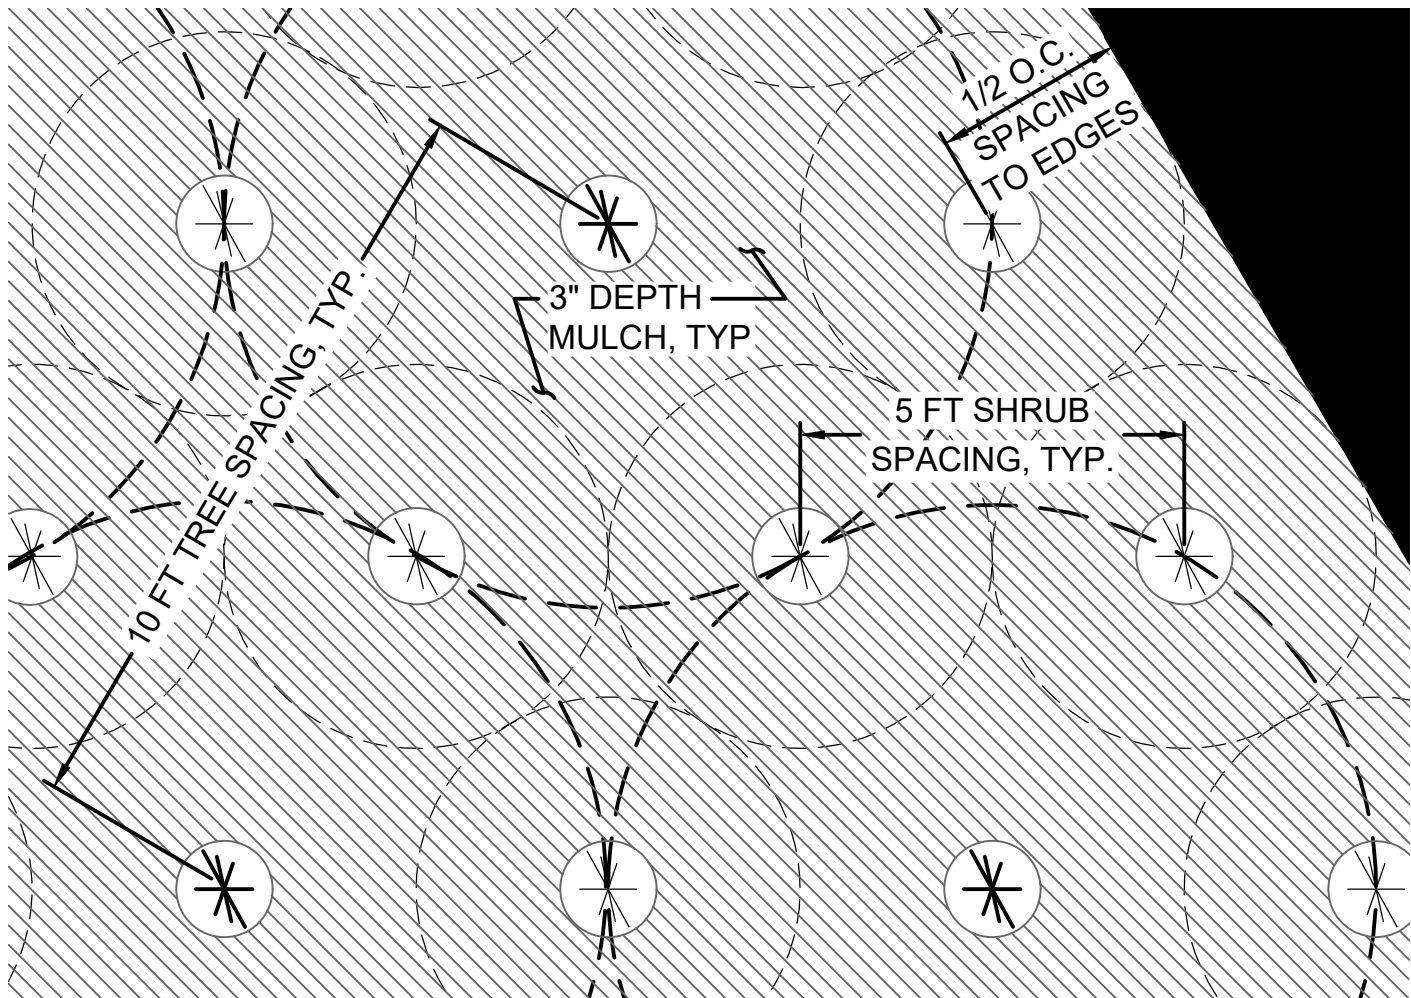


- NOTES:
1. PLANTING LAYOUT IS CONCEPTUAL AND INTENDED TO SHOW GROUPINGS OF SIMILAR SPECIES OF PLANTS.
 3. GROUP EACH SPECIES IN ODD-NUMBERED CLUSTERS OF 3 TO 9 EXCEPT WHERE NOTED OTHERWISE.
 4. PLANT LAYOUT AND TRIANGULAR SPACING MAY BE ADJUSTED TO MEET FIELD CONDITIONS WITH THE ACCEPTANCE OF THE ENGINEER.
 5. SURROUND EACH TREE WITH SHRUBS, RETAINING THE 5 FT O.C. SPACING OF THE SHRUBS AS SHOWN IN THIS DETAIL.

4 TYPICAL PLANTING LAYOUT
DETAIL SCALE: NTS

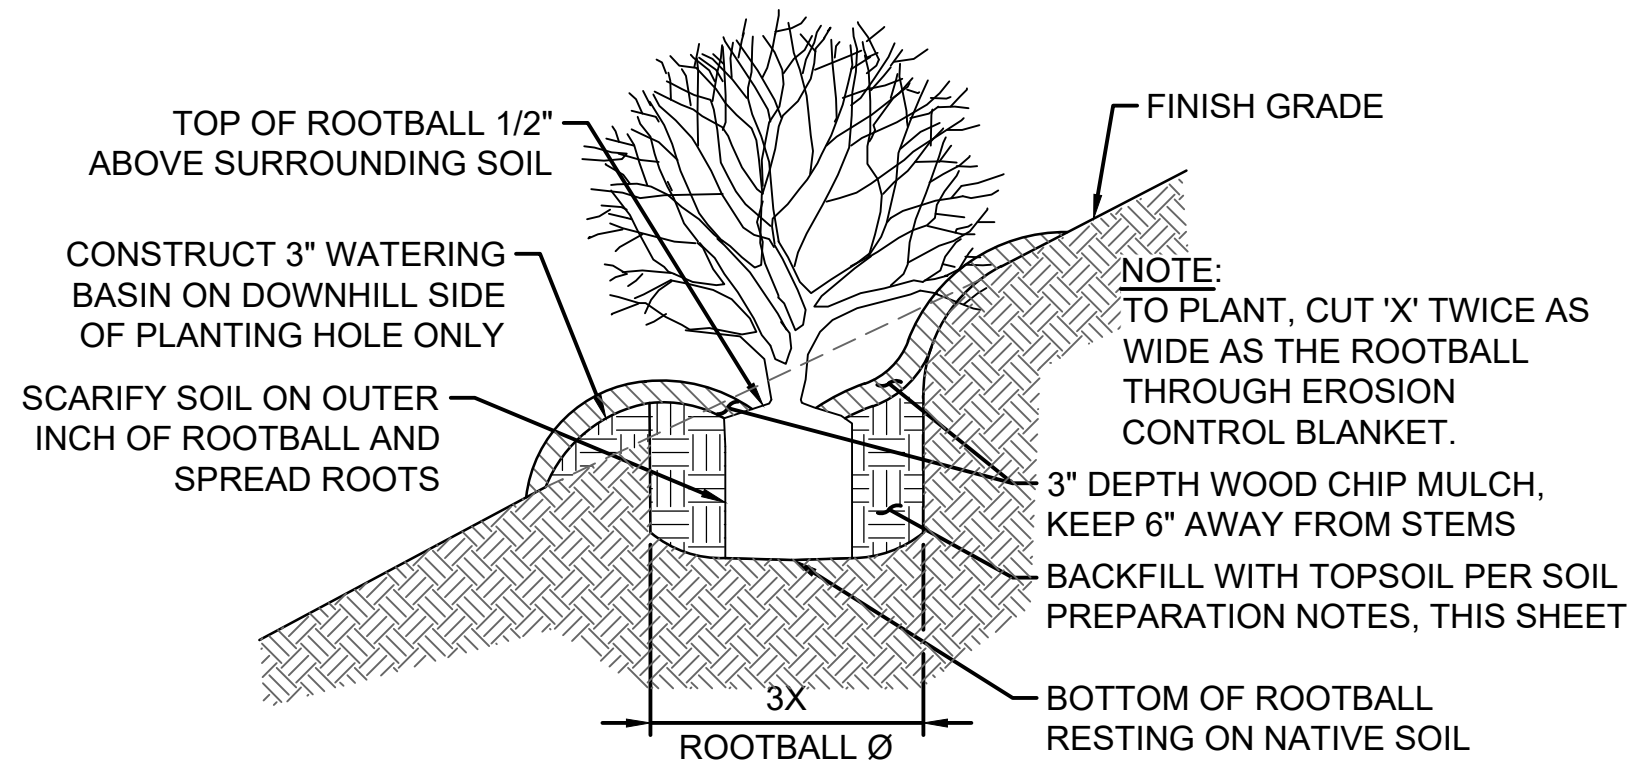

2 SLOPE PLANTING
DETAIL SCALE: NTS

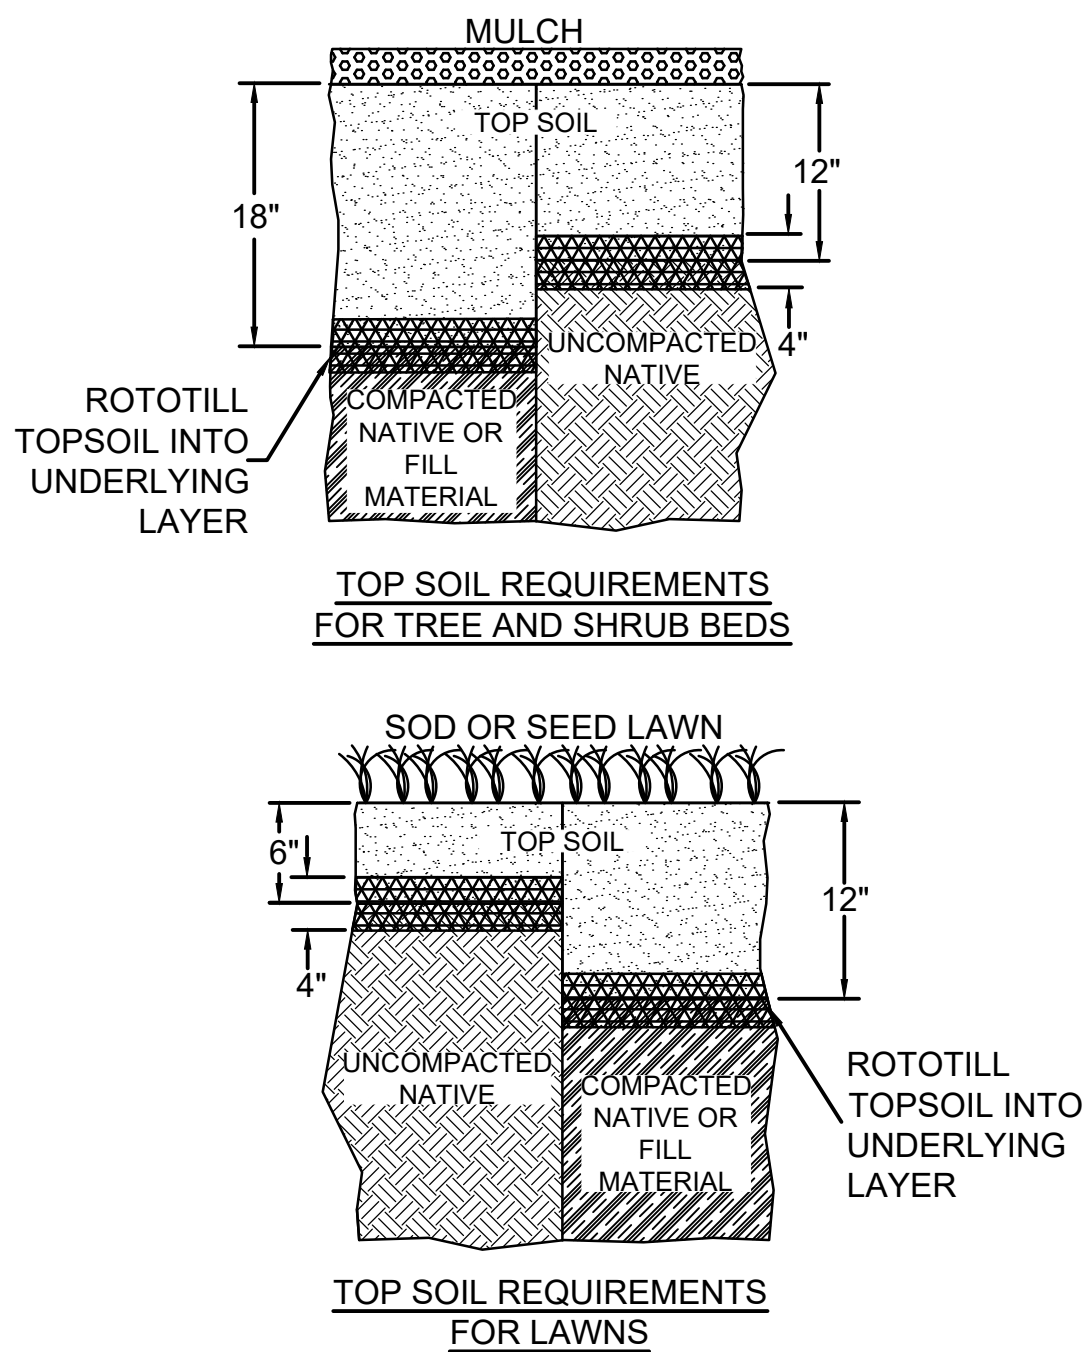

5 SOIL PREPARATION
DETAIL SCALE: NTS

SOIL PREPARATION NOTES

1. CLEAR AND GRUB ALL PLANTING AREAS WITHIN THE LIMIT OF GRADING DISTURBANCE. PLANTING AREAS OUTSIDE THE LIMIT OF GRADING DISTURBANCE SHALL BE CLEARED OF INVASIVE VEGETATION ONLY AS NEEDED WHILE PROTECTING EXISTING TREES TO BE RETAINED.
2. WITHIN THE LIMIT OF GRADING DISTURBANCE ADD TOPSOIL TYPE A TO AREAS TO BE PLANTED OR SEEDED AS SHOWN IN SOIL PREPARATION DETAILS, THIS SHEET. OUTSIDE THE LIMIT OF GRADING DISTURBANCE USE TOPSOIL TYPE B FOR INFILL PLANTING PITS ONLY. IF THERE IS INSUFFICIENT TOPSOIL TYPE B THEN TOPSOIL TYPE C MAY BE USED UPON APPROVAL FROM OWNER'S REPRESENTATIVE.
3. SEEDING
4. EROSION CONTROL BLANKET
5. CONTAINER PLANTING
6. INSTALL 3-FOOT DIAMETER, 3-INCH DEPTH MULCH RINGS FOR ALL CONTAINER PLANTS.

BUFFER ENHANCEMENT PLANTING SCHEDULE (23,982 SF)

BOTANICAL NAME	COMMON NAME	SIZE	SPACING	QUANTITY
TREES:				
PICEA SITCHENSIS	SITKA SPRUCE	1 GAL. CONTAINER	10' O.C.	53
PSEUDOTSUGA MENZIESII	DOUGLAS FIR	1 GAL. CONTAINER	10' O.C.	53
RHAMNUS PURSHIANA	CASCARA	1 GAL. CONTAINER	10' O.C.	52
SALIX LUCIDA	PACIFIC WILLOW	1 GAL. CONTAINER	10' O.C.	52
THUJA PLICATA	WESTERN RED CEDAR	1 GAL. CONTAINER	10' O.C.	53
SHRUBS:				
ACER CIRCINATUM	VINE MAPLE	1 GAL. CONTAINER	5' O.C.	131
LONICERA INVOLUCRATA	TWINBERRY	1 GAL. CONTAINER	5' O.C.	132
MAHONIA AQUIFOLIUM	TALL ORGEON GRAPE	1 GAL. CONTAINER	5' O.C.	131
OEMLERIA CERASIFORMIS	INDIAN PLUM	1 GAL. CONTAINER	5' O.C.	131
PHYSOCARPUS CAPITATUS	PACIFIC NINEBARK	1 GAL. CONTAINER	5' O.C.	131
RIBES LACUSTRE	PRICKLY CURRANT	1 GAL. CONTAINER	5' O.C.	131
LIVESTAKES:				
SALIX HOOKERIANA	HOOKER'S WILLOW	LIVESTAKE	3' O.C.	54
SALIX LASIANDRA	PACIFIC WILLOW	LIVESTAKE	3' O.C.	53
SALIX SITCHENSIS	SITKA WILLOW	LIVESTAKE	3' O.C.	54

BUFFER REVEGETATION SHRUB PLANTING SCHEDULE (5,569 SF)

BOTANICAL NAME	COMMON NAME	SIZE	SPACING	QUANTITY
SHRUBS:				
ACER CIRCINATUM	VINE MAPLE	1 GAL. CONTAINER	5' O.C.	30
LONICERA INVOLUCRATA	TWINBERRY	1 GAL. CONTAINER	5' O.C.	30
MAHONIA AQUIFOLIUM	TALL ORGEON GRAPE	1 GAL. CONTAINER	5' O.C.	30
OEMLERIA CERASIFORMIS	INDIAN PLUM	1 GAL. CONTAINER	5' O.C.	29
PHYSOCARPUS CAPITATUS	PACIFIC NINEBARK	1 GAL. CONTAINER	5' O.C.	30
POLYSTICHUM MUNITUM	SWORD FERN	1 GAL. CONTAINER	5' O.C.	30

BUFFER REVEGETATION SEED SCHEDULE (15,348 SF)

BOTANICAL NAME	COMMON NAME	DISTRIBUTION BY	
		WEIGHT	RATE
AGROSTIS EXARATA	SPIKE BENTGRASS	10%	APPLY 20 LBS. PER ACRE
DESCHAMPSIA CESPITOSA	TUFTED HAIRGRASS	15%	
DESCHAMPSIA ELONGATA	SLENDER HAIRGRASS	20%	
HORDEUM BRACHYANTHERUM	MEADOW BARLEY	55%	

BUFFER MITIGATION PLANTING NOTES

CLEARING AND TREE PROTECTION

1. REMOVE ALL INVASIVE SPECIES FROM THE MITIGATION AREAS PRIOR TO INSTALLATION USING METHODS APPROVED BY THE STATE OF WASHINGTON NOXIOUS WEED CONTROL BOARD AND AS INDICATED IN THE SPECIFICATIONS. SPECIFIC SPECIES TO BE REMOVED INCLUDE HIMALAYAN BLACKBERRY (RUBUS ARMENIACUS), ENGLISH IVY (HEDERA HELIX), ENGLISH HOLLY (ILEX AQUIFOLIUM), KNOTWEED (POLYGONUM SPP.), AND REED CANARYGRASS (PHALARIS ARUNDINACEA).
2. PRESERVE AND PROTECT ALL EXISTING VEGETATION NOT DESIGNATED FOR REMOVAL. PROVIDE, ERECT AND MAINTAIN TEMPORARY FENCING TO PREVENT ACCESS TO EXISTING WETLANDS OR WETLAND BUFFERS BY ANY VEHICLES. SEE SHEET EC8 FOR TREE PROTECTION DETAIL.
3. DO NOT DRIVE OR PARK ANY VEHICLES OR EQUIPMENT, STORE MATERIALS, STOCKPILE SOIL OR GRAVEL, OR DISPOSE OF ANY CONSTRUCTION OR WASTE MATERIAL WITHIN EXISTING WETLANDS OR WETLAND BUFFER OR NEAR NEWLY INSTALLED PLANTS. RESTRICT FOOT TRAFFIC WITHIN PROTECTED AREAS.

PLANTING

4. ASSUME TRIANGULAR SPACING FOR ALL PLANT SPACING ON PLANTING SCHEDULES.
5. PLANTING AREAS SHOULD BE STAKED IN THE FIELD FOR ACCEPTANCE BY THE ENGINEER PRIOR TO INSTALLATION.
6. PRIOR TO PLANTING, PLACE ALL PLANTS AS INDICATED ON THE PLANS, OR MARK EACH LOCATION WITH WOOD STAKES OR COLOR WIRE FLAGS MARKED WITH THE FIRST TWO LETTERS OF BOTH PLANT GENUS AND SPECIES (E.G. PHCA FOR PHYSOCARPUS CAPITATUS). NO PLANTING HOLES SHALL BE DUG OR BACKFILLED WITHOUT PRIOR APPROVAL OF ENGINEER. NOTIFY ENGINEER A MINIMUM OF 72 HOURS BEFORE PLANTING TO ALLOW AMPLE TIME TO ADJUST PLANT LOCATIONS. PROVIDE EXTRA STAKES OR FLAGS SUFFICIENT TO MARK LOCATIONS OF PLANTS NOT LOCATED ON PLAN.
7. APPLY BUFFER REVEGETATION SEED MIX ALONG ROADSIDE AREAS AS SHOWN ON PLANS AND IN BUFFER AREAS OUTSIDE OF SHOWN PLANTING REGIONS WHERE PLANTING WORK HAS IMPACTED EXISTING VEGETATION.
8. REMOVE PLANT TAGS AND CLEAN UP AREA PER SPECIFICATION 8-02.3(13).

USE OF DOCUMENTS

THIS DOCUMENT, INCLUDING THE INCORPORATED DESIGNS, IS AN INSTRUMENT OF SERVICE FOR THIS PROJECT AND SHALL NOT BE USED FOR ANY OTHER PROJECT WITHOUT THE WRITTEN AUTHORIZATION OF KENNEDY/JENKS CONSULTANTS.

NO.	REVISION	DATE	BY

SCALES
0 1"
0 25mm
IF THIS BAR IS NOT DIMENSION SHOWN, ADJUST SCALES ACCORDINGLY.



DESIGNED
ABG
DRAWN
ABG
CHECKED
SAR




CITY OF ISSAQUAH
ISSAQUAH, WASHINGTON
SOUTH SPAR BOOSTER PUMP STATION
Environmental Science Associates
SEATTLE, WASHINGTON

BUFFER MITIGATION DETAILS

90% SUBMITTAL (REVISED 7/1/2020)

FILE NAME
JOB NO.
1397005*00
DATE
JUNE 2020
SHEET
OF
L3

U:\Projects\SEA\16xxxx\160917.00 S.SPABR Booster Pump Station\08_CADD\Drawings\90%_REVISED\L4 TREE IMPACTS PLAN.dwg 11/5/2020 1:49 PM AGREENBERG

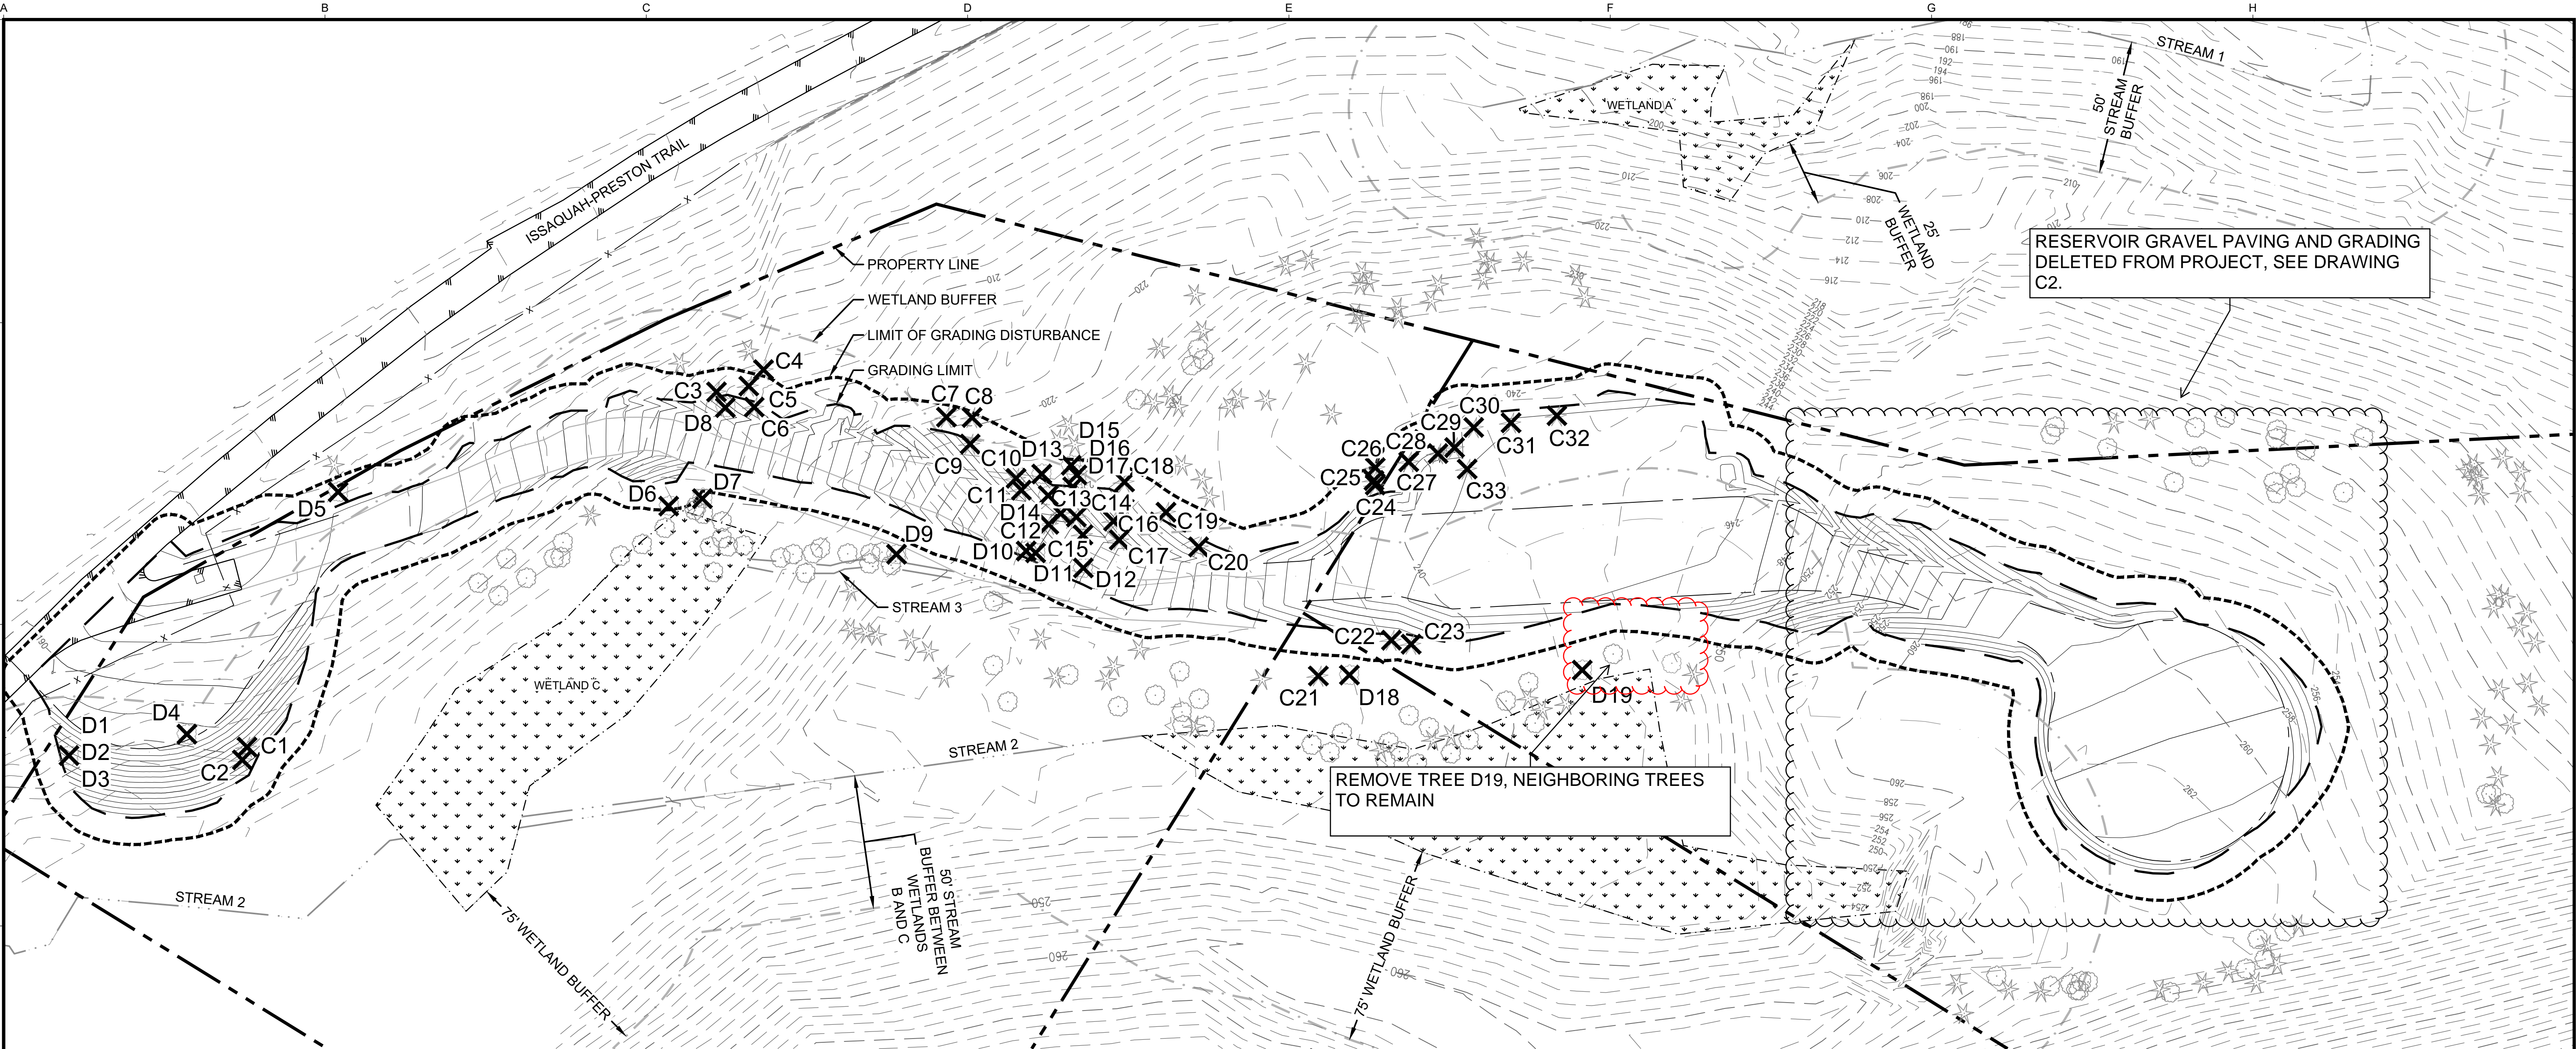

DECIDUOUS TREE REMOVAL TABLE

TREE #	SPECIES	SIZE (DBH)
D1	BIGLEAF MAPLE	7
D2	BIGLEAF MAPLE	5
D3	BIGLEAF MAPLE	4
D4	DECIDUOUS	22
D5	ALDER	6
D6	COTTONWOOD	14
D7	COTTONWOOD	18
D8	COTTONWOOD	20
D9	ALDER	7
D10	ALDER	7
D11	ALDER	6
D12	ALDER	6
D13	COTTONWOOD	7
D14	ALDER	7
D15	COTTONWOOD	23
D16	COTTONWOOD	13
D17	COTTONWOOD	19

DECIDUOUS TREE REMOVAL TABLE

TREE #	SPECIES	SIZE (DBH)
D18	COTTONWOOD	17
D19	ALDER	13
COMBINED DBH TOTAL:		221

CONIFEROUS TREE REMOVAL TABLE



TREE #	SPECIES	SIZE (DBH)
C1	DOUGLAS FIR	13
C2	DOUGLAS FIR	9
C3	DOUGLAS FIR	9
C4	DOUGLAS FIR	13
C5	DOUGLAS FIR	7
C6	DOUGLAS FIR	10
C7	DOUGLAS FIR	17
C8	DOUGLAS FIR	16
C9	DOUGLAS FIR	15
C10	DOUGLAS FIR	6
C11	DOUGLAS FIR	14
C12	DOUGLAS FIR	9
C13	DOUGLAS FIR	13
C14	DOUGLAS FIR	6
C15	DOUGLAS FIR	8
C16	DOUGLAS FIR	17
C17	DOUGLAS FIR	8

CONIFEROUS TREE REMOVAL TABLE

TREE #	SPECIES	SIZE (DBH)
C18	DOUGLAS FIR	6
C19	DOUGLAS FIR	10
C20	DOUGLAS FIR	19
C21	DOUGLAS FIR	18
C22	DOUGLAS FIR	25
C23	DOUGLAS FIR	12
C24	DOUGLAS FIR	12
C25	DOUGLAS FIR	9
C26	DOUGLAS FIR	13
C27	DOUGLAS FIR	13
C28	DOUGLAS FIR	14
C29	DOUGLAS FIR	12
C30	DOUGLAS FIR	15
C31	DOUGLAS FIR	9
C32	DOUGLAS FIR	17
C33	DOUGLAS FIR	16
COMBINED DBH TOTAL:		410

NOTES


- SEE SHEET L5 FOR TREE MITIGATION PLAN, PLANTING SCHEDULE, AND PLANTING NOTES.
- SEE SHEET L3 FOR PLANTING DETAILS AND SOIL PREPARATION NOTES.
- PER THE ROADSIDE POLICY MANUAL (WSDOT, 2015), EACH REPLACEMENT 1 GALLON CONTAINER TREE OFFSETS 1 INCH DBH REMOVED. 2 GALLON CONTAINERS EACH OFFSET 2 INCH DBH REMOVED.

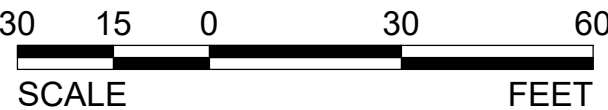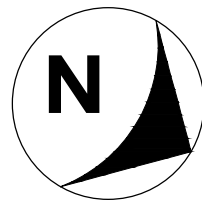

USE OF DOCUMENTS

THIS DOCUMENT, INCLUDING THE INCORPORATED DESIGNS, IS AN INSTRUMENT OF SERVICE FOR THIS PROJECT AND SHALL NOT BE USED FOR ANY OTHER PROJECT WITHOUT THE WRITTEN AUTHORIZATION OF KENNEDY/JENKS CONSULTANTS.

NO.	REVISION	DATE	BY

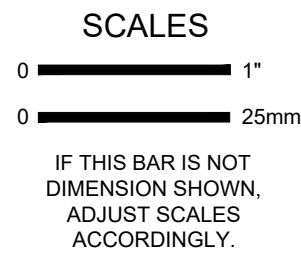

DESIGNED

ABG

DRAWN

ABG

CHECKED

SAR



CITY OF ISSAQUAH
ISSAQUAH, WASHINGTON
SOUTH SPAR BOOSTER PUMP STATION

Environmental Science Associates
SEATTLE, WASHINGTON

TREE IMPACTS PLAN

90% SUBMITTAL (REVISED 7/1/2020)

FILE NAME

JOB NO.


1397005*00

DATE

JUNE 2020

SHEET OF

L4

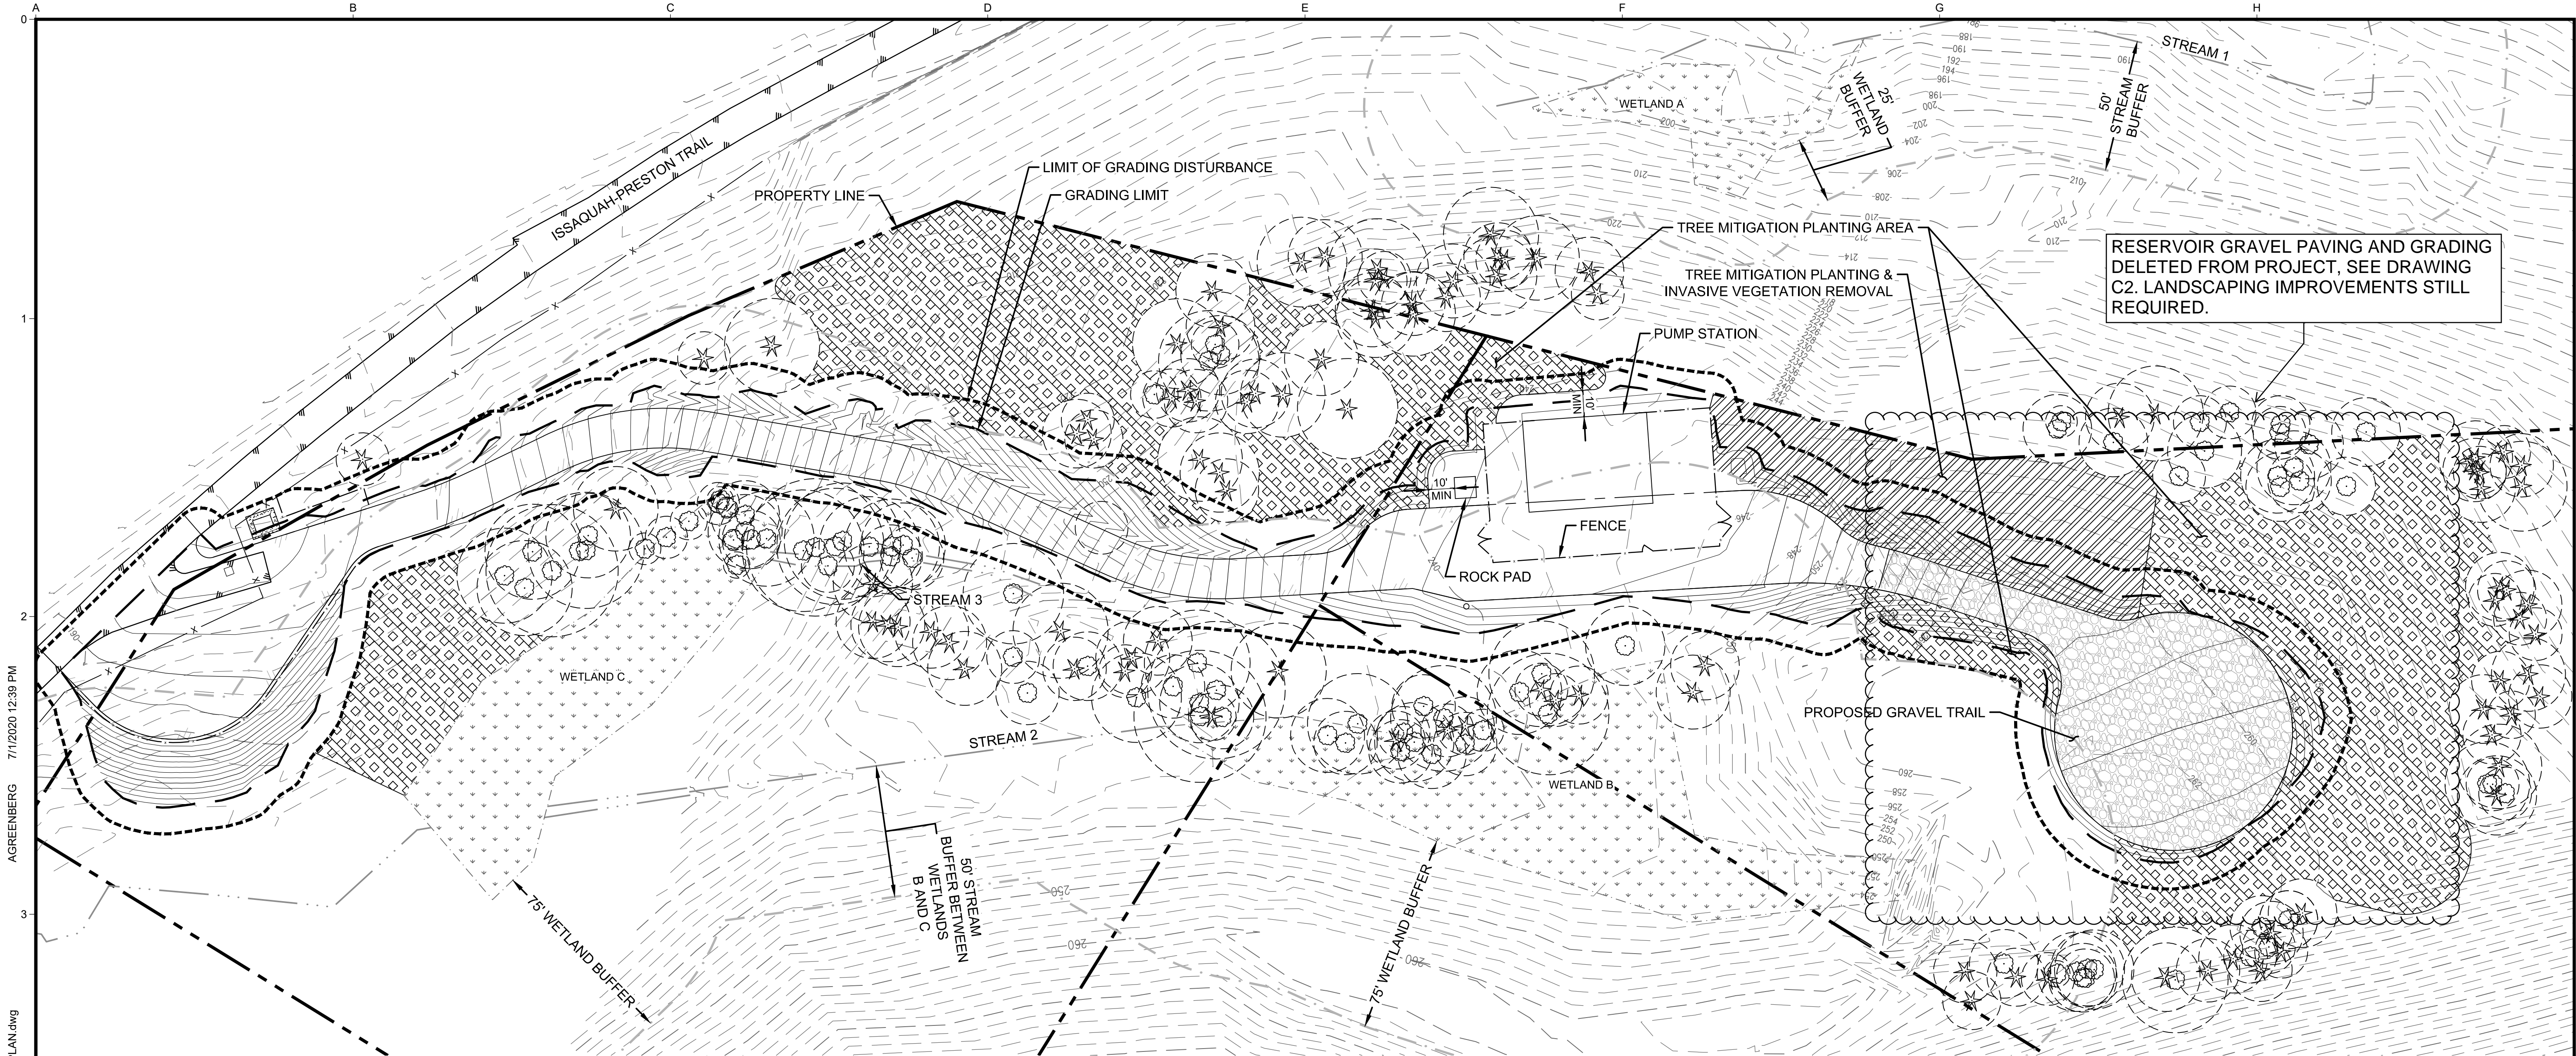

TREE MITIGATION PLANTING NOTES

1. SEE DETAILS ON SHEET L3 FOR PLANTING AND SOIL PREPARATION DETAILS.

2. REMOVE ALL INVASIVE SPECIES FROM THE TREE MITIGATION PLANTING AREAS PRIOR TO INSTALLATION USING METHODS APPROVED BY THE STATE OF WASHINGTON NOXIOUS WEED CONTROL BOARD AND AS INDICATED IN THE SPECIFICATIONS. SPECIFIC SPECIES TO BE REMOVED INCLUDE HIMALAYAN BLACKBERRY (RUBUS ARMENIACUS) AND SCOTCH BROOM (CYTISUS SCOPARIUS).

3. PRESERVE AND PROTECT ALL EXISTING VEGETATION NOT DESIGNATED FOR REMOVAL. PROVIDE, ERECT AND MAINTAIN TEMPORARY FENCING TO PREVENT ACCESS TO EXISTING WETLANDS OR WETLAND BUFFERS BY ANY VEHICLES.

4. DO NOT DRIVE OR PARK ANY VEHICLES OR EQUIPMENT, STORE MATERIALS, STOCKPILE SOIL OR GRAVEL, OR DISPOSE OF ANY CONSTRUCTION OR WASTE MATERIAL WITHIN EXISTING WETLANDS OR WETLAND BUFFER OR NEAR NEWLY INSTALLED PLANTS. RESTRICT FOOT TRAFFIC WITHIN PROTECTED AREAS.

5. SEED SOURCE MUST BE AS LOCAL AS POSSIBLE, AND PLANTS MUST BE NURSERY PROPAGATED UNLESS TRANSPLANTED FROM ON-SITE AREAS APPROVED FOR DISTURBANCE.
6. PLANTING AREAS AND GENERAL PLANT LAYOUT SHOULD BE CONFIRMED BY CONTRACTOR WITH CITY BIOLOGIST PRIOR TO PLANT INSTALLATION.

7. SUBSEQUENT TO PLANT DELIVERY, BUT PRIOR TO PLANT INSTALLATION, THE CITY WILL INSPECT THE PLANTS TO ENSURE PLANT QUANTITIES, SIZES, AND HEALTH ARE ADEQUATE AND PER THE PLANTING PLAN. UNLESS THE CITY SPECIFICALLY AUTHORIZES ANY CHANGES OR SUBSTITUTIONS, THE CONTRACTOR IS RESPONSIBLE FOR PROVIDING ALL PLANT TYPES AND NUMBERS PER THE PLANTING PLAN.

8. PLANT SIMILAR SPECIES TOGETHER IN CLUSTERS OF 3, 5, 7, OR 9. DO NOT PLANT ALL OF ONE SPECIES IN ANY PLANTING AREAS.

9. IMMEDIATELY AFTER PLANT INSTALLATION, ALL INDIVIDUAL TREES WILL BE MARKED WITH BRIGHTLY COLORED FLAGGING, TO ALLOW FOR EASY IDENTIFICATION DURING AS-BUILT INSPECTION AND SUBSEQUENT MONITORING EFFORTS.


10. IMMEDIATELY FOLLOWING PLANT INSTALLATION THE CITY WILL CONDUCT AN AS BUILT SURVEY TO ENSURE ALL TREE PLANTING WAS INSTALLED ACCORDING TO THE PLANTING PLAN. THE CONTRACTOR IS RESPONSIBLE FOR INSTALLING PLANT TYPES AND NUMBERS PER THE PLANTING PLAN.

LEGEND

- TREE MITIGATION PLANTING AREA
(34,801 SF)
- TREE MITIGATION PLANTING & INVASIVE VEGETATION REMOVAL
(7,155 SF)

TREE MITIGATION PLANTING SCHEDULE

BOTANICAL NAME	COMMON NAME	SIZE	SPACING	QUANTITY
ACER MACROPHYLLUM	BIG LEAF MAPLE	1 GAL. CONTAINER	10' O.C.	50
ACER MACROPHYLLUM	BIG LEAF MAPLE	2 GAL. CONTAINER	12' O.C.	50
PSEUDOTSUGA MENZIESII	DOUGLAS FIR	1 GAL. CONTAINER	10' O.C.	200
PSEUDOTSUGA MENZIESII	DOUGLAS FIR	2 GAL. CONTAINER	12' O.C.	110

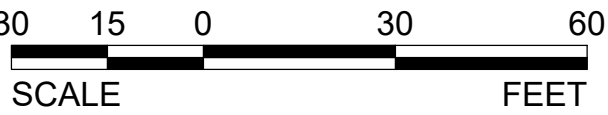

USE OF DOCUMENTS

THIS DOCUMENT, INCLUDING THE INCORPORATED DESIGNS, IS AN INSTRUMENT OF SERVICE FOR THIS PROJECT AND SHALL NOT BE USED FOR ANY OTHER PROJECT WITHOUT THE WRITTEN AUTHORIZATION OF KENNEDY/JENKS CONSULTANTS.

NO.	REVISION	DATE	BY

SCALES

0 1" 25mm

IF THIS BAR IS NOT DIMENSION SHOWN, ADJUST SCALES ACCORDINGLY.

STATE OF WASHINGTON

ALLISON B. GREENBERG

LANDSCAPE ARCHITECT

NO 1047 EXP. 2/28/2021

DESIGNED

ABG

DRAWN

ABG

CHECKED

SAR

CITY OF ISSAQUAH
ISSAQUAH, WASHINGTON
SOUTH SPAR BOOSTER PUMP STATION

Environmental Science Associates
SEATTLE, WASHINGTON

TREE MITIGATION PLAN



90% SUBMITTAL (REVISED 7/1/2020)





FILE NAME

JOB NO. 1397005*00



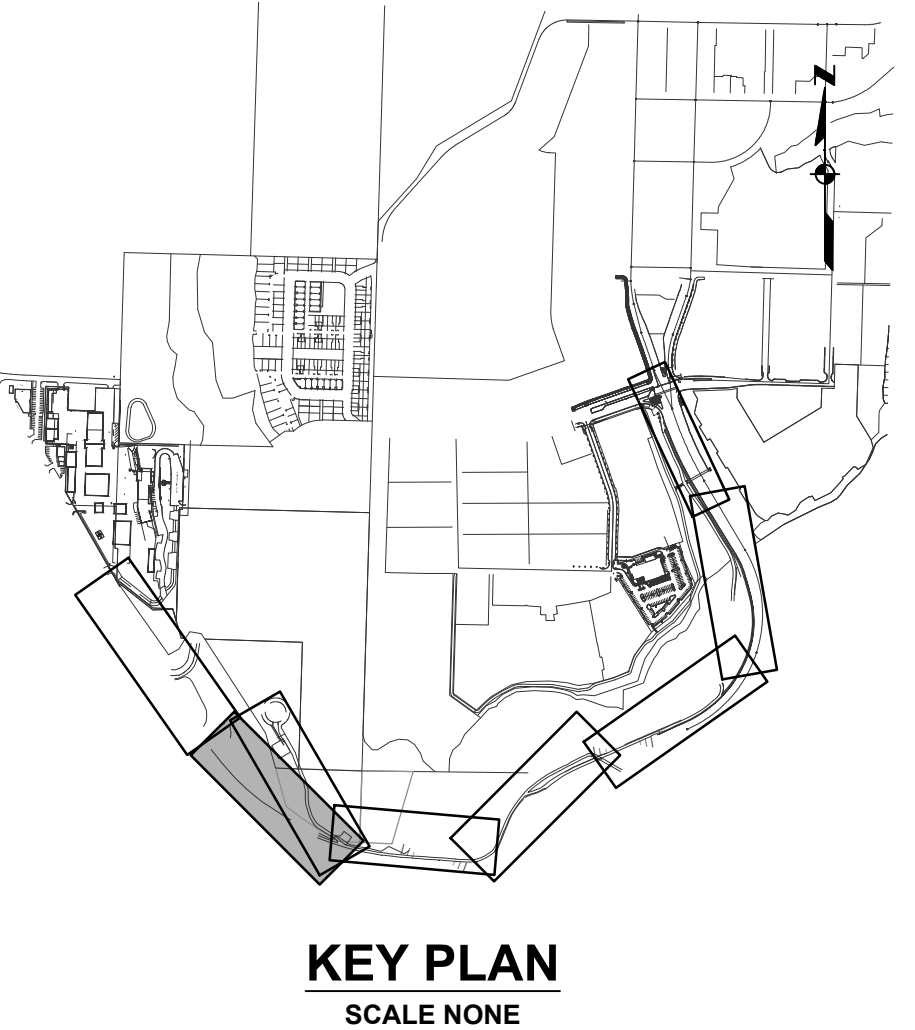
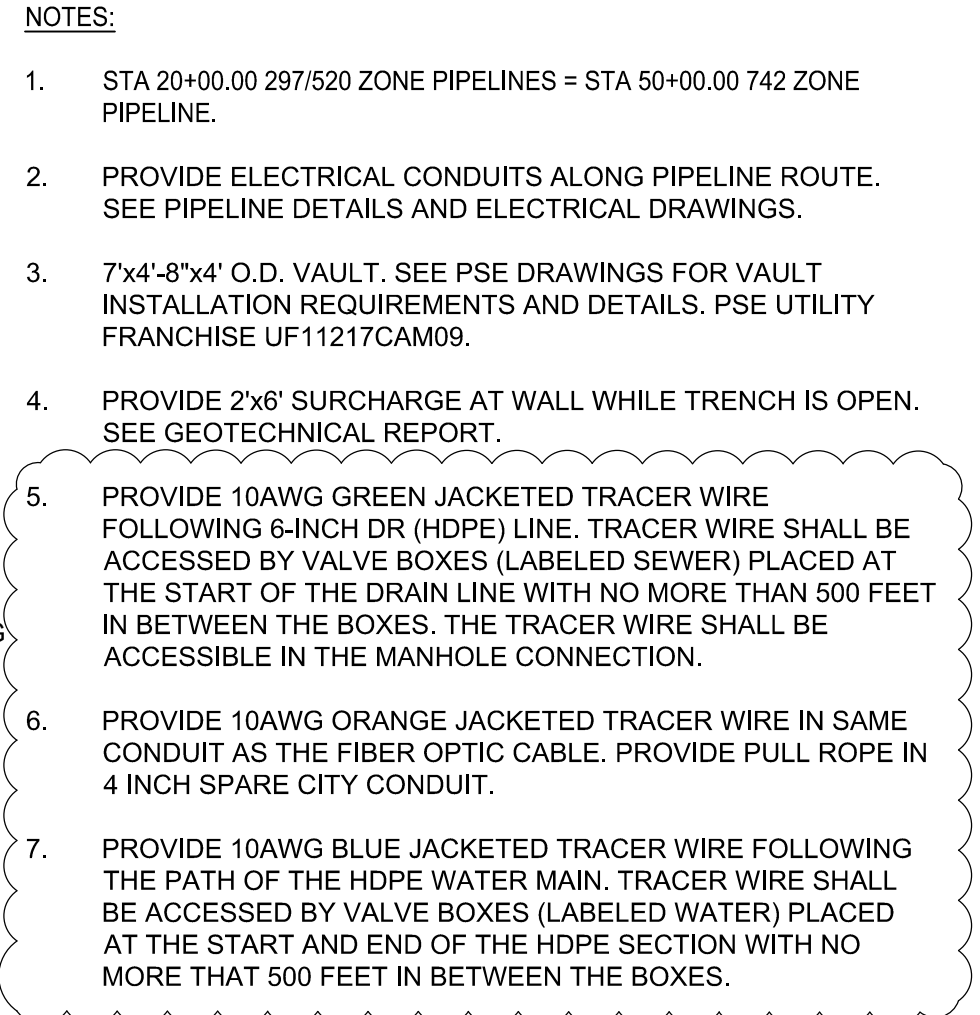
DATE JUNE 2020

SHEET OF L5




USE OF DOCUMENTS THIS DOCUMENT, INCLUDING THE INCORPORATED DESIGNS, IS AN INSTRUMENT OF SERVICE FOR THIS PROJECT AND SHALL NOT BE USED FOR ANY OTHER PROJECT WITHOUT THE WRITTEN AUTHORIZATION OF KENNEDY/JENKS CONSULTANTS.					<p>SCALES</p> <p>0  1"</p> <p>0  25mm</p> <p>IF THIS BAR IS NOT DIMENSION SHOWN, ADJUST SCALES ACCORDINGLY.</p>		DESIGNED		<p>CITY OF ISSAQUAH</p> <p>ISSAQUAH, WASHINGTON</p> <p>SOUTH SPAR BOOSTER PUMP STATION</p>	<p>297/520 ZONE PIPELINE</p> <p>PLAN AND PROFILE</p> <p>STA. 11+00 TO STA. 19+88.60</p>	FILE NAME	139700500-CP002.DWG	
							JOB NO.				1397005*00		
							CHECKED				MDL	DATE	NOVEMBER 2020
												SHEET	OF
												<p>90% SUBMITTAL (REVISED 11/30/2020)</p>	
NO.	REVISION	DATE	BY										

\\jc.local\KUC-Roof\K-Office\FWY\CAD\CAD131\397005.00_City_of_Issaquah\139700500-CP004.dwg 11/23/2020 4:39 PM NICOLASLOZANORDONEZ

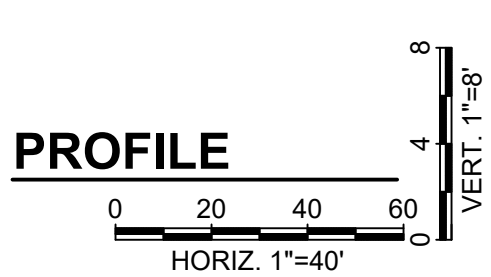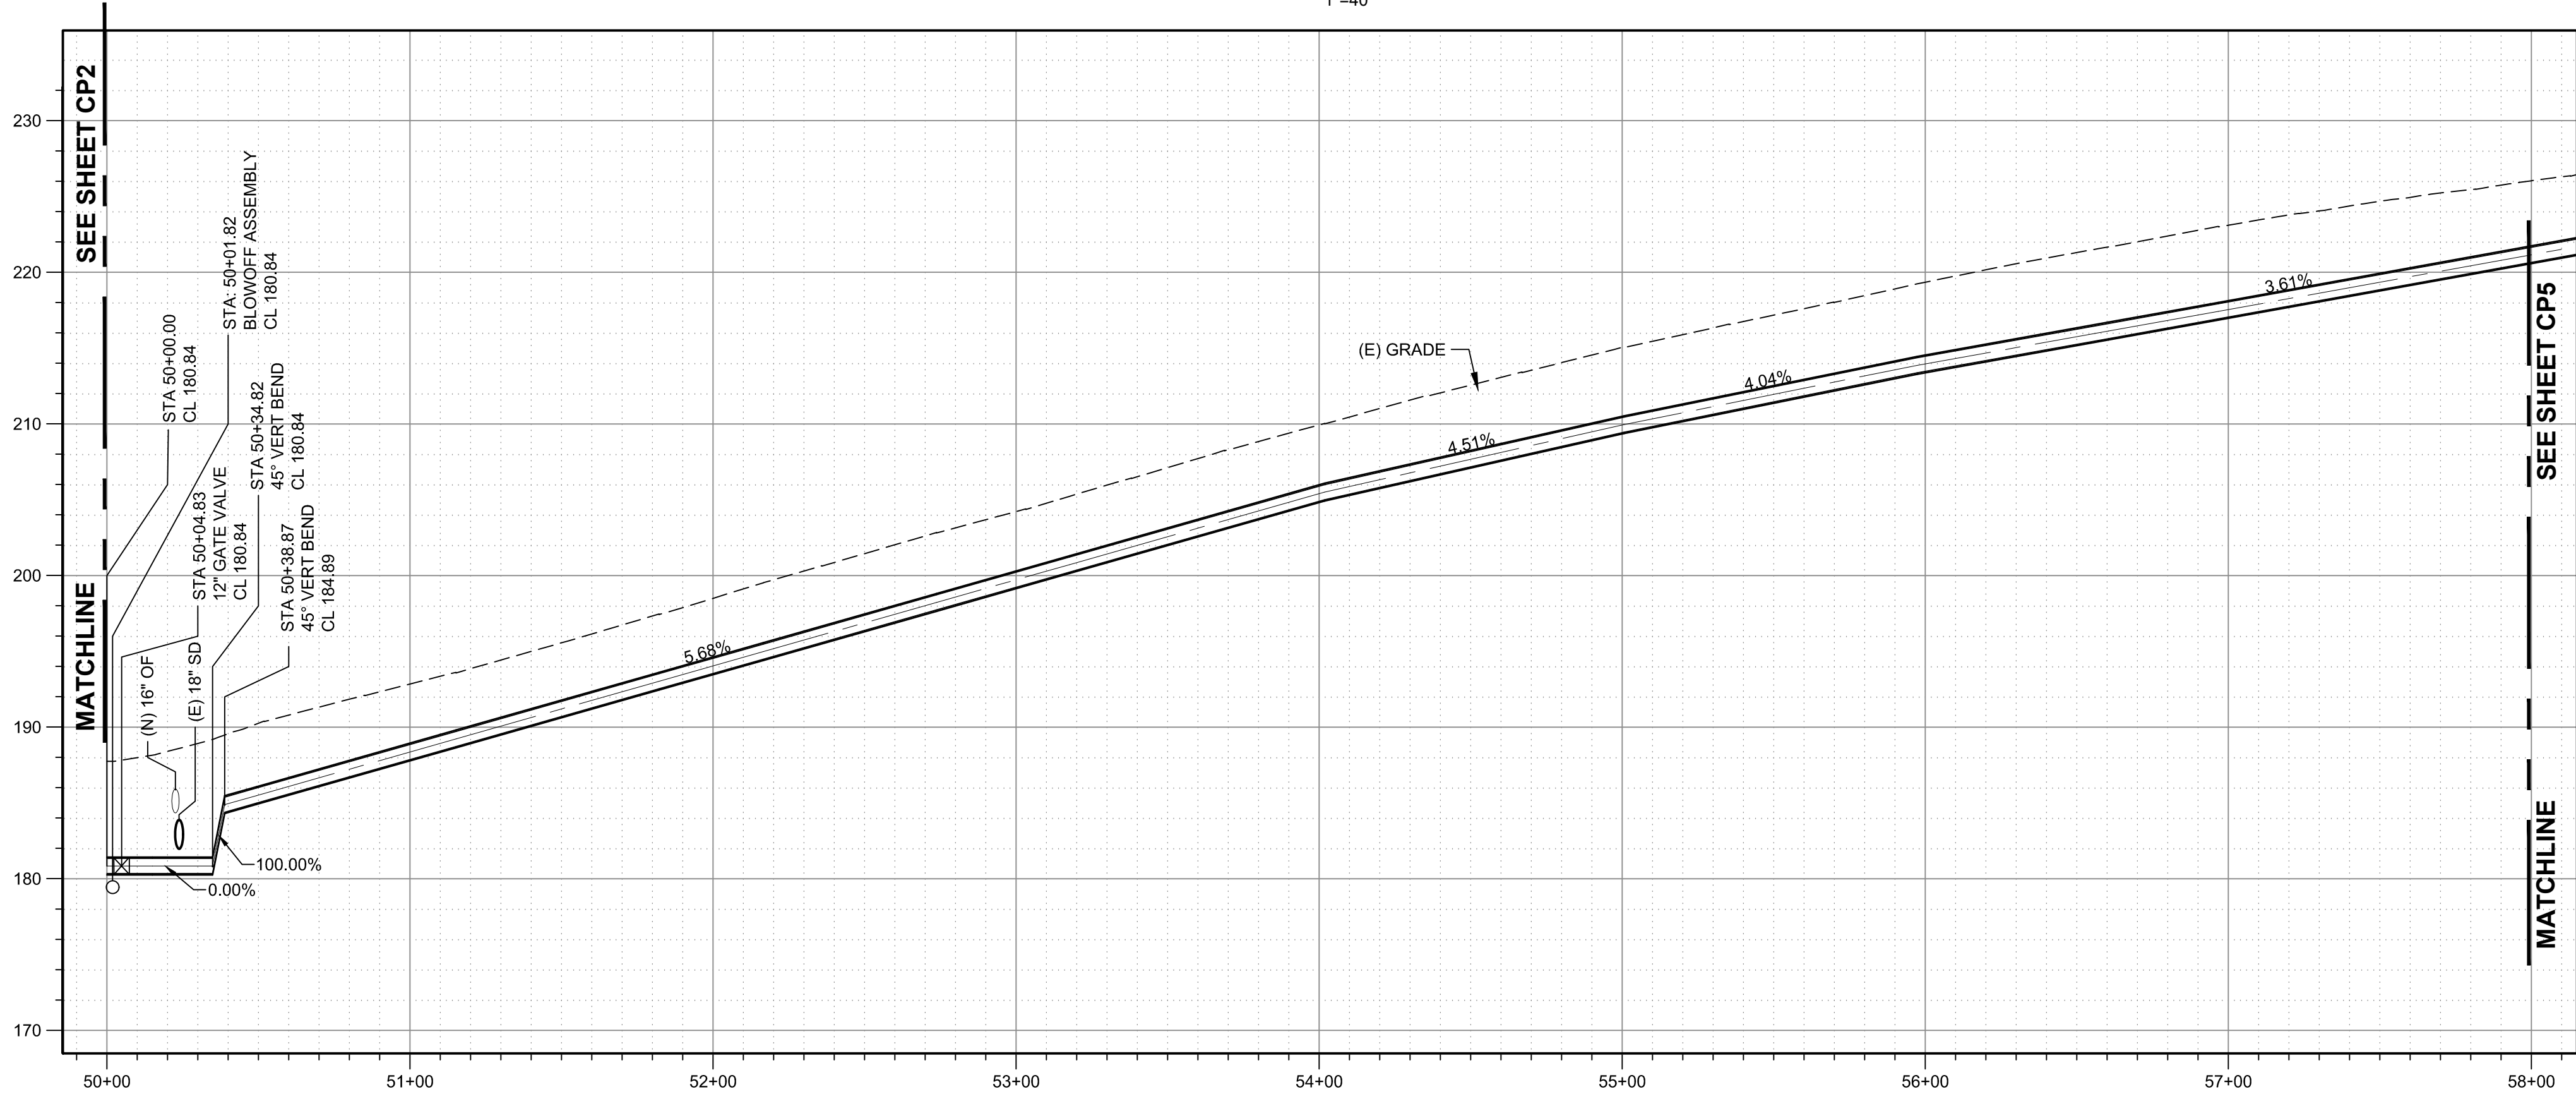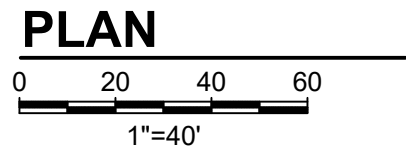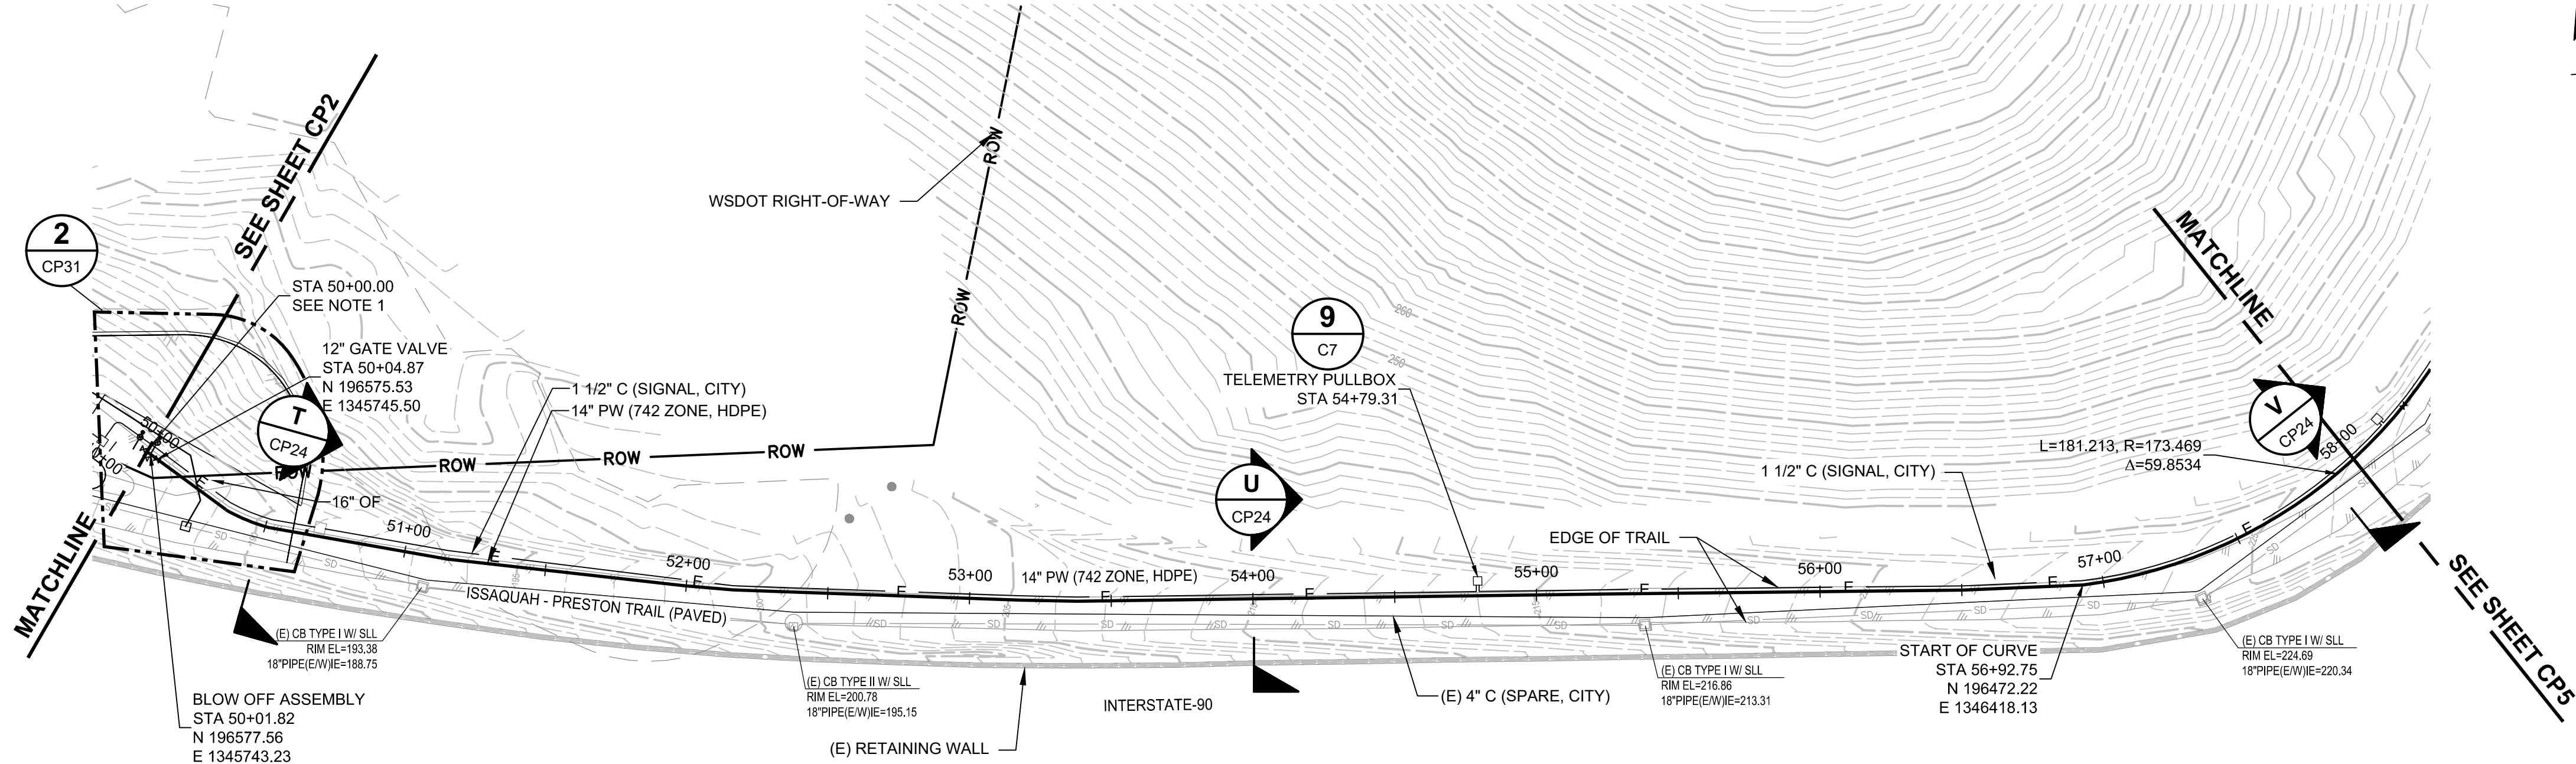

- NOTES:**
- STA 50+00.00 742 ZONE PIPELINE = STA 20+00.00 297/520 ZONE PIPELINE.
 - BLOW OFF ASSEMBLIES PER CITY STANDARD DETAIL W-04.
 - PROVIDE 10AWG BLUE JACKETED TRACER WIRE FOLLOWING THE PATH OF THE HDPE WATER MAIN. TRACER WIRE SHALL BE ACCESSED BY VALVE BOXES (LABELED WATER) PLACED AT THE START AND END OF THE HDPE SECTION WITH NO MORE THAT 500 FEET IN BETWEEN THE BOXES.

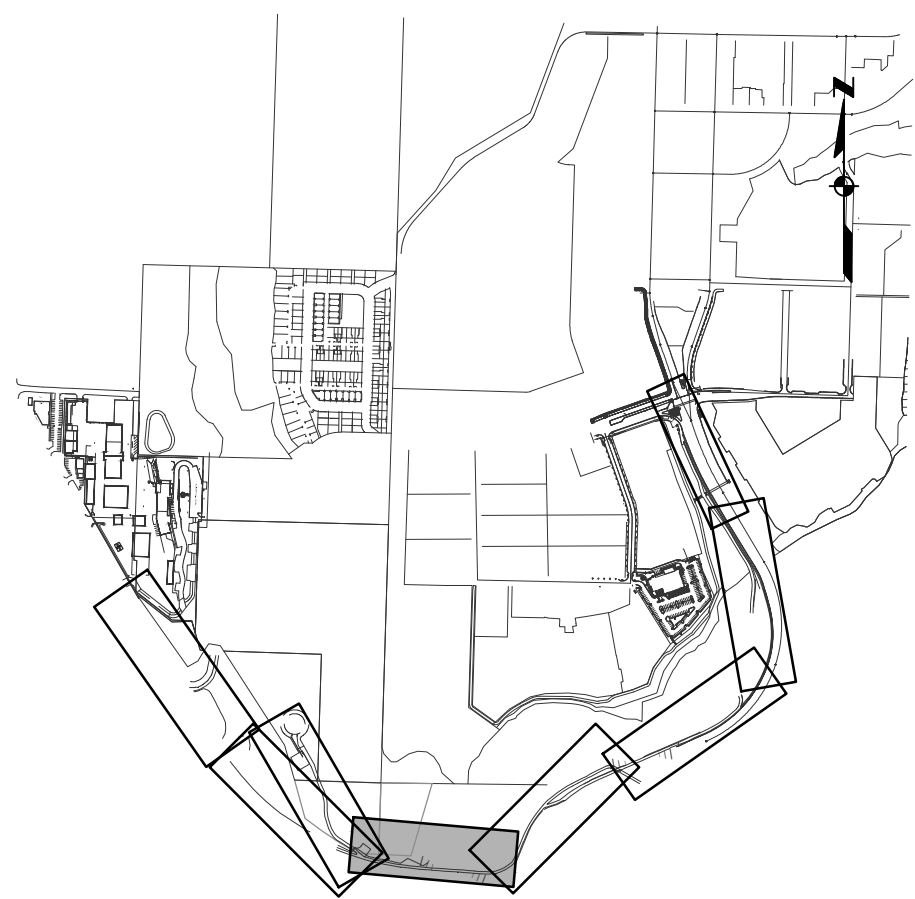

KEY PLAN
SCALE NONE

USE OF DOCUMENTS

THIS DOCUMENT, INCLUDING THE INCORPORATED DESIGNS, IS AN INSTRUMENT OF SERVICE FOR THIS PROJECT AND SHALL NOT BE USED FOR ANY OTHER PROJECT WITHOUT THE WRITTEN AUTHORIZATION OF KENNEDY/JENKS CONSULTANTS.

NO.	REVISION	DATE	BY
-----	----------	------	----

SCALES

0 1" 25mm

IF THIS BAR IS NOT DIMENSION SHOWN, ADJUST SCALES ACCORDINGLY.



DESIGNED	KSP
DRAWN	LMM
CHECKED	MDL



CITY OF ISSAQUAH
ISSAQUAH, WASHINGTON
SOUTH SPAR BOOSTER PUMP STATION


Kennedy/Jenks Consultants
FEDERAL WAY, WASHINGTON

742 ZONE PIPELINE
PLAN AND PROFILE
STA. 50+00 TO STA. 58+00



90% SUBMITTAL (REVISED 11/30/2020)

FILE NAME	139700500-CP004.DWG
JOB NO.	1397005'00
DATE	NOVEMBER 2020
SHEET	OF
CP4	

\\jc.local\KUC-Rodrik-Office\FW\CAD\CAD131397005.00_City_of_Issaquah\139700500-CP007.dwg 11/24/2020 7:04 PM NICOLASLOZANORDONEZ

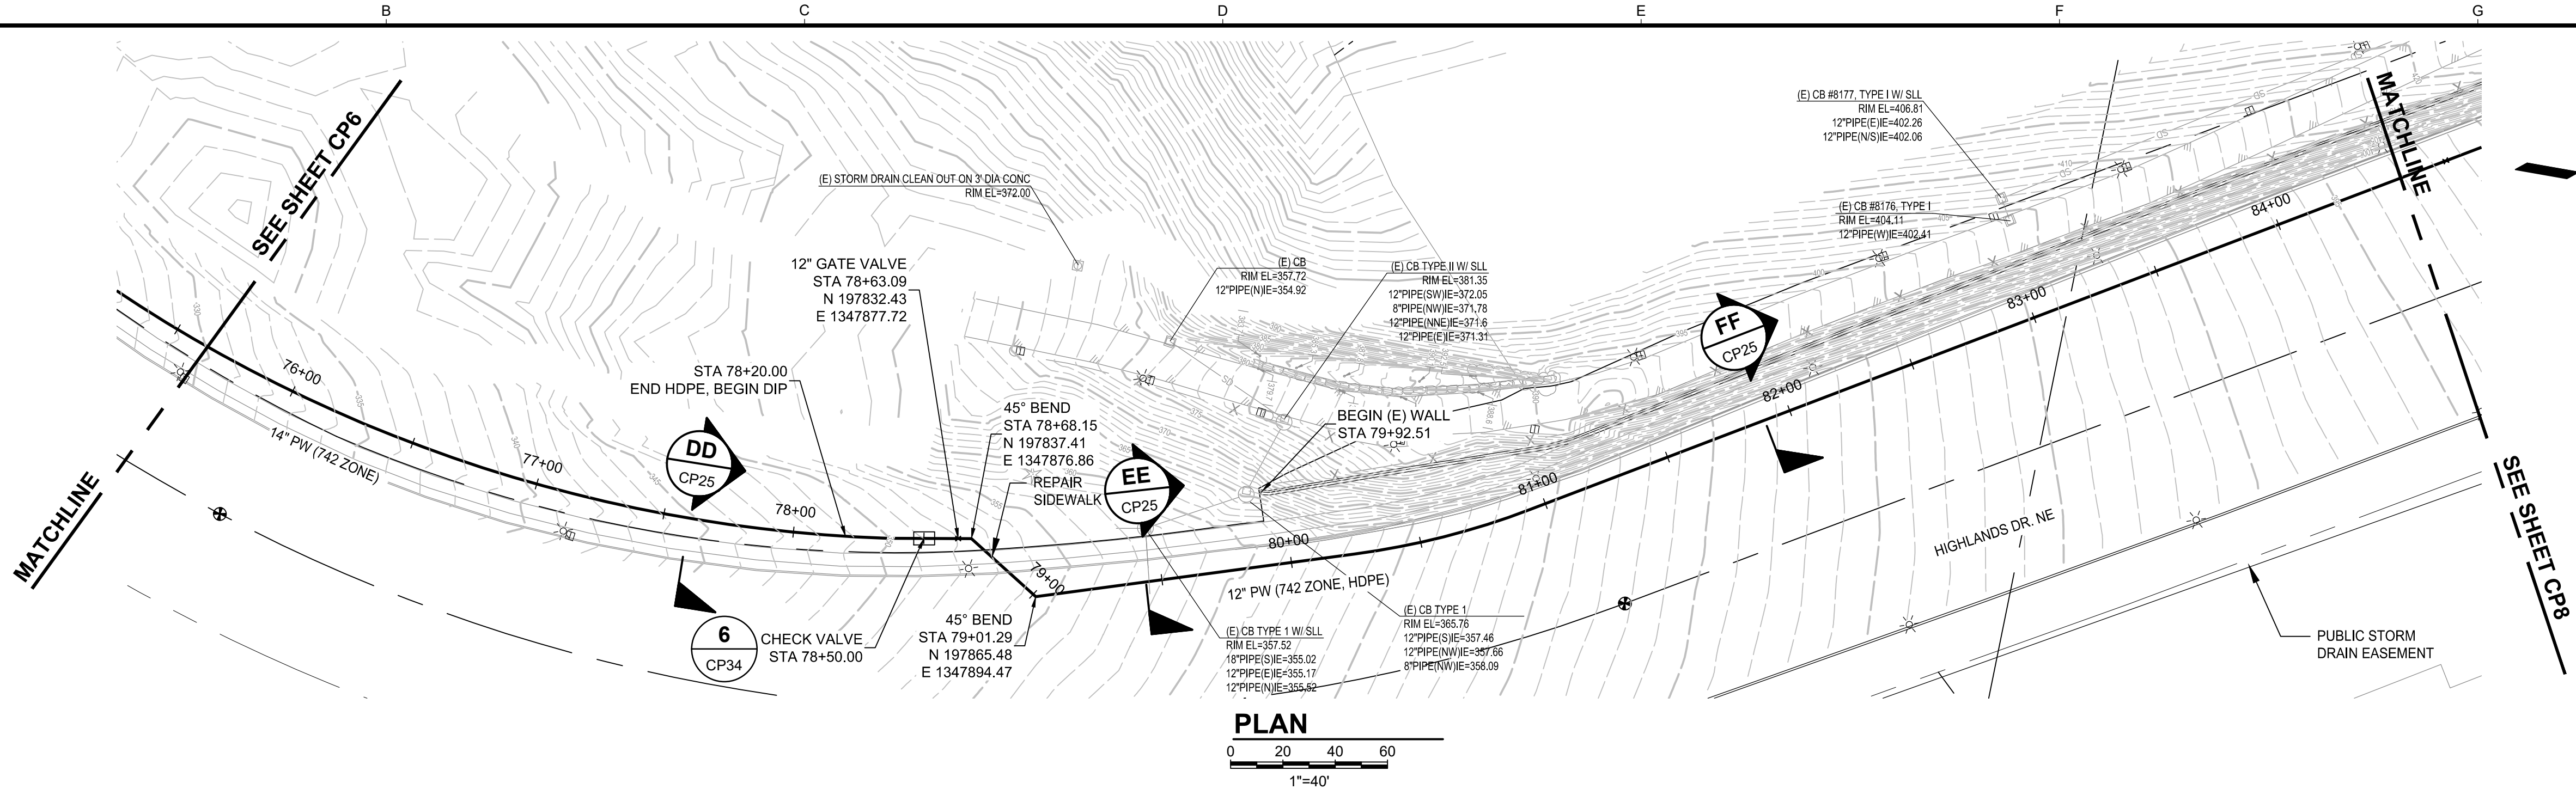


- NOTES:
1. PROVIDE 10AWG BLUE JACKETED TRACER WIRE FOLLOWING THE PATH OF THE HDPE WATER MAIN. TRACER WIRE SHALL BE ACCESSED BY VALVE BOXES (LABELED WATER) PLACED AT THE START AND END OF THE HDPE SECTION WITH NO MORE THAT 500 FEET IN BETWEEN THE BOXES.

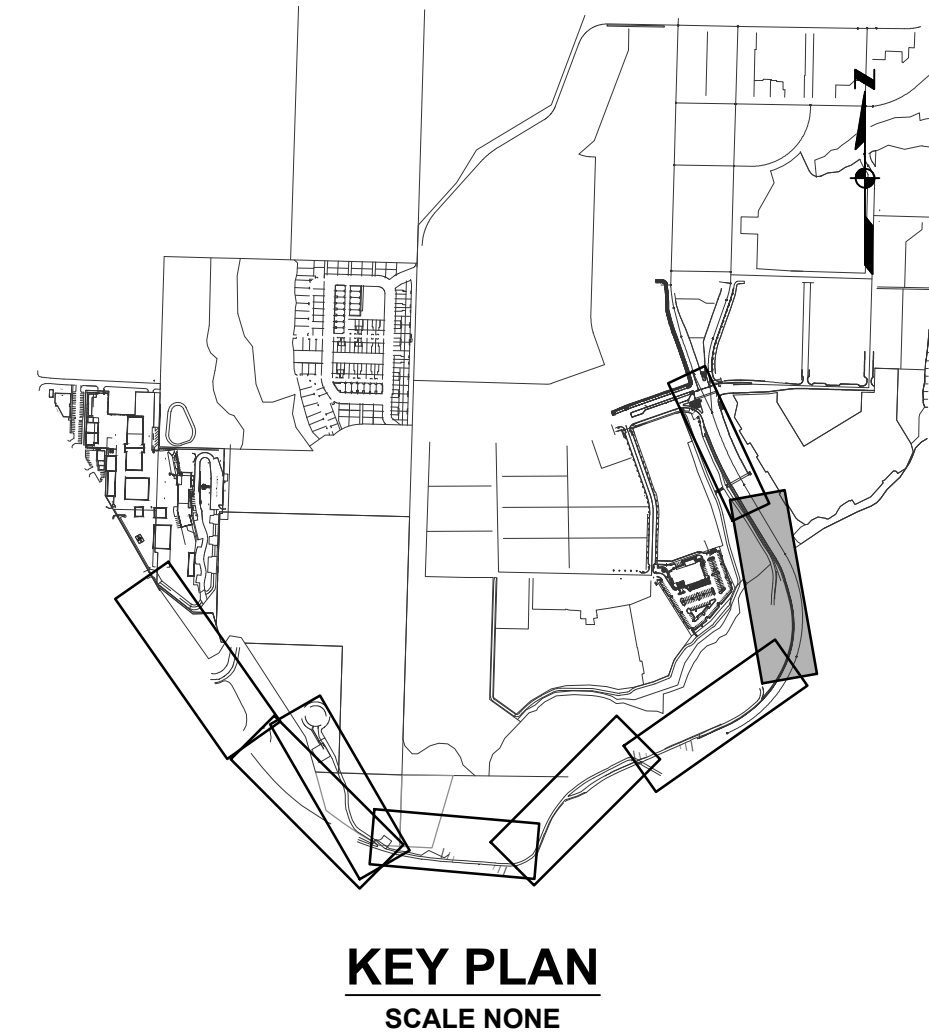
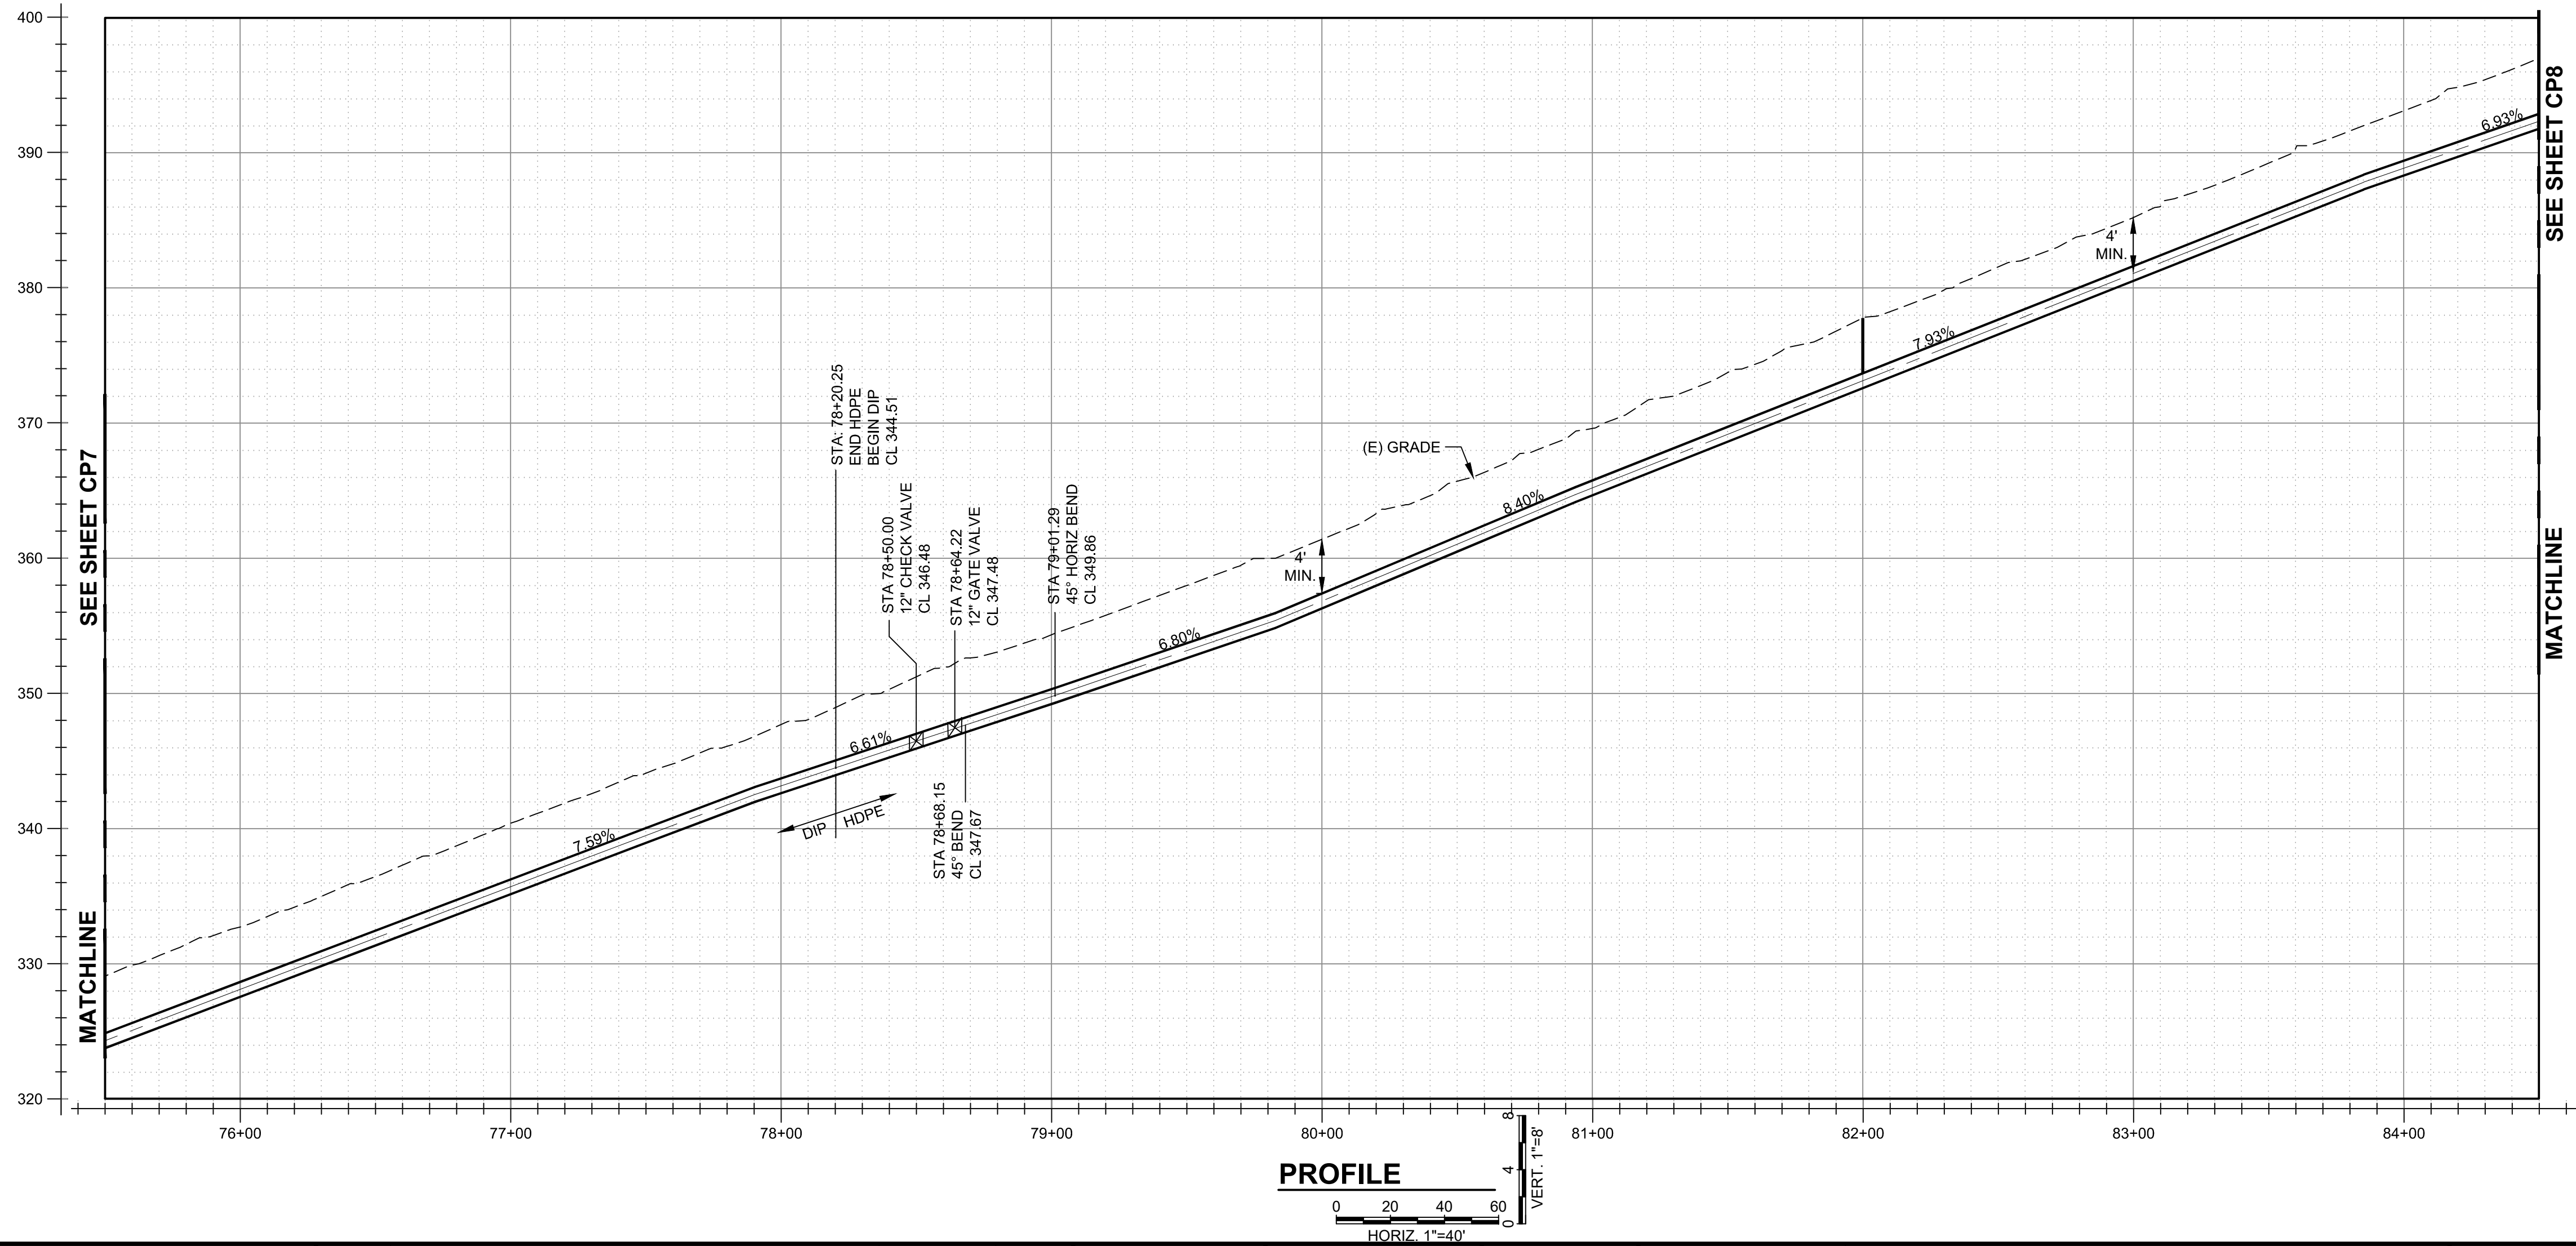


<p>USE OF DOCUMENTS</p> <p>THIS DOCUMENT, INCLUDING THE INCORPORATED DESIGNS, IS AN INSTRUMENT OF SERVICE FOR THIS PROJECT AND SHALL NOT BE USED FOR ANY OTHER PROJECT WITHOUT THE WRITTEN AUTHORIZATION OF KENNEDY/JENKS CONSULTANTS.</p>				<p>NO.</p> <p>REVISION</p> <p>DATE</p> <p>BY</p>				<p>DESIGNED</p> <p>KSP</p> <p>DRAWN</p> <p>LMM</p> <p>CHECKED</p> <p>MDL</p>				<p>CITY OF ISSAQUAH</p> <p>ISSAQUAH, WASHINGTON</p> <p>SOUTH SPAR BOOSTER PUMP STATION</p> <p>Kennedy/Jenks Consultants</p> <p>FEDERAL WAY, WASHINGTON</p>				<p>742 ZONE PIPELINE</p> <p>PLAN AND PROFILE</p> <p>STA. 75+50 TO STA. 84+50</p> <p>90% SUBMITTAL (REVISED 11/30/2020)</p>				<p>FILE NAME</p> <p>139700500-CP007.DWG</p> <p>JOB NO.</p> <p>1397005'00</p> <p>DATE</p> <p>NOVEMBER 2020</p> <p>SHEET</p> <p>OF</p> <p>CP7</p>			
--	--	--	--	--	--	--	--	--	--	--	--	--	--	--	--	--	--	--	--	---	--	--	--

P:\CAD\13\1397005.00_City_of_Issaquah\139700500-CP008.dwg 12/19/2019 1:13 PM MIKEMARX

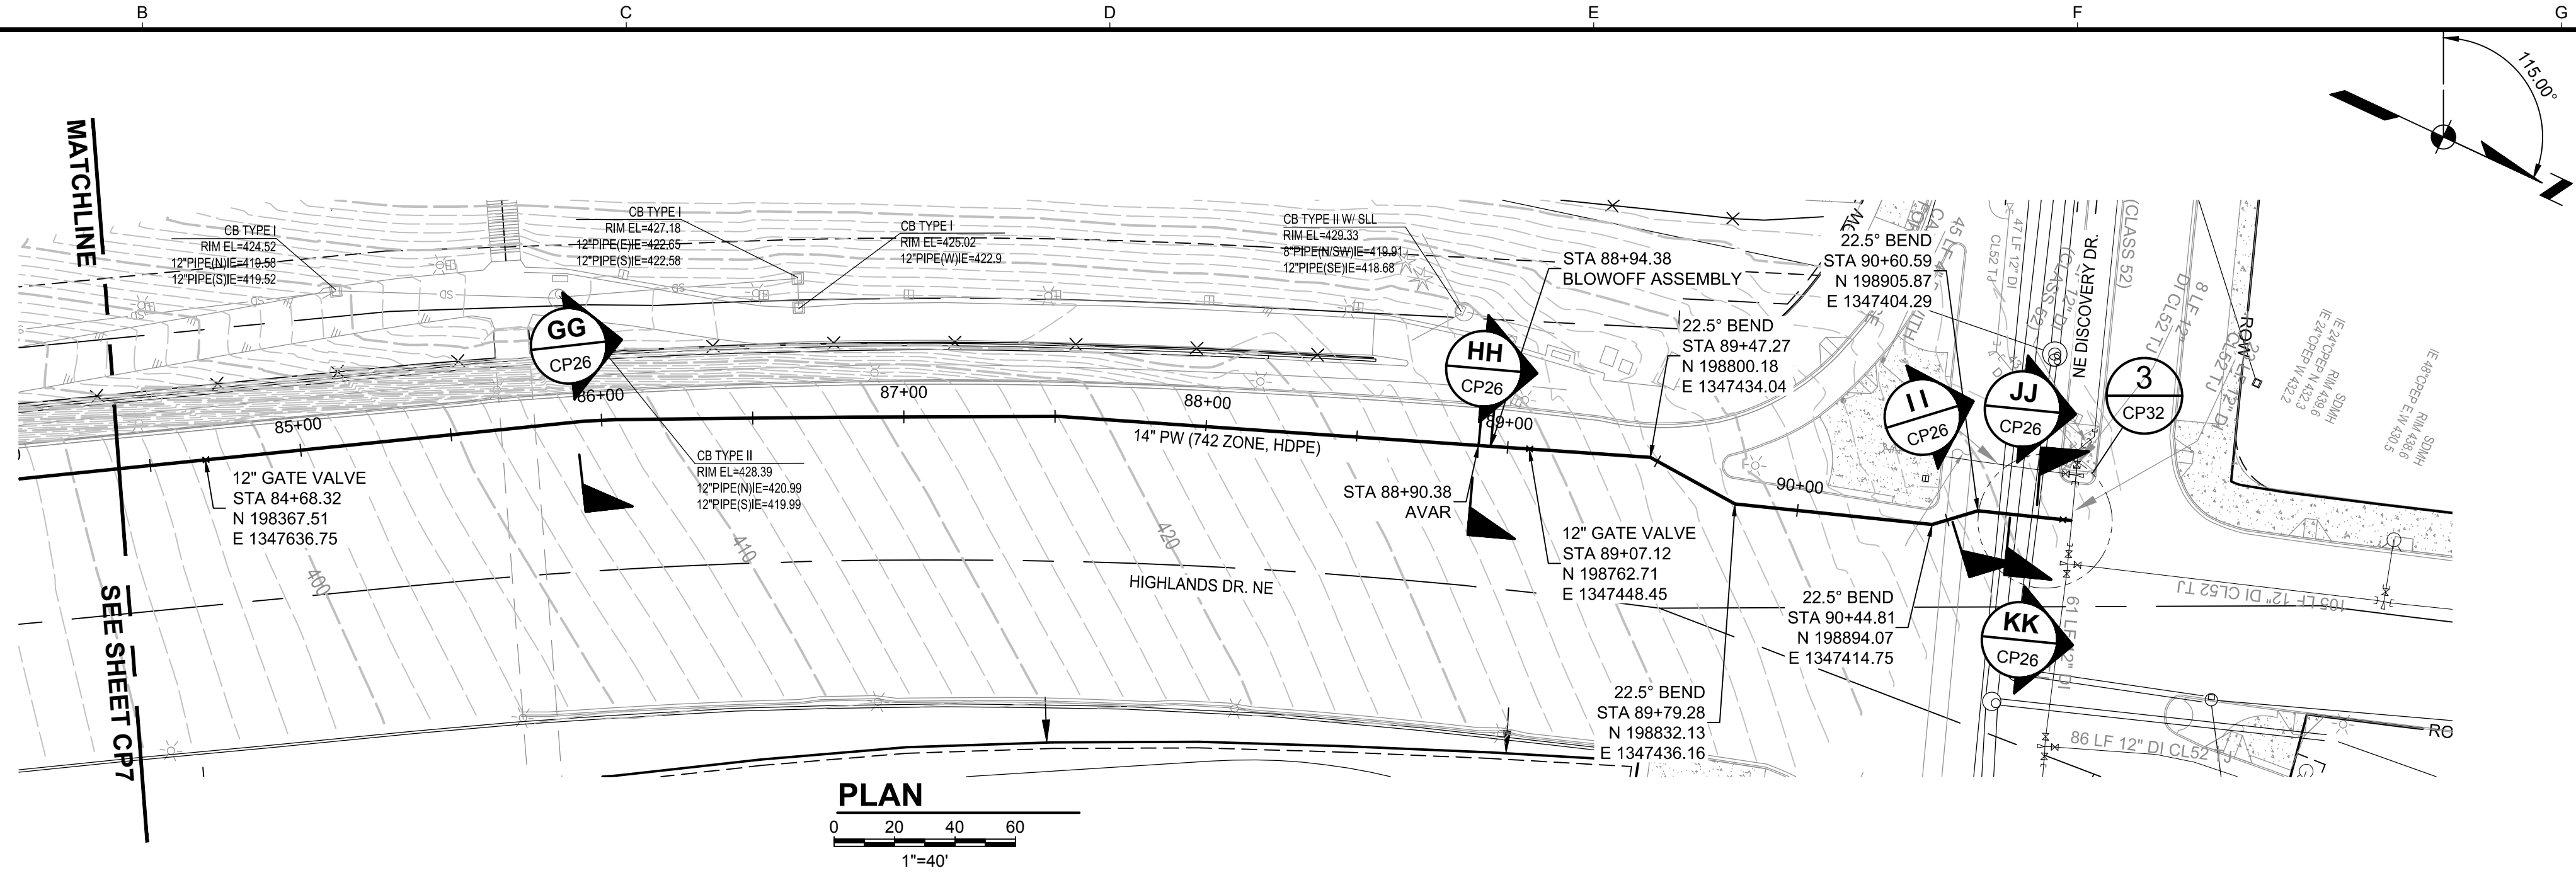

- NOTES:
- CONTRACTOR SHALL REPLACE TRAFFIC LOOPS AT INTERSECTION.
 - BLOWOFF ASSEMBLY PER CITY STANDARD DETAIL W-04. AVAR PER CITY STANDARD DETAIL W-07.

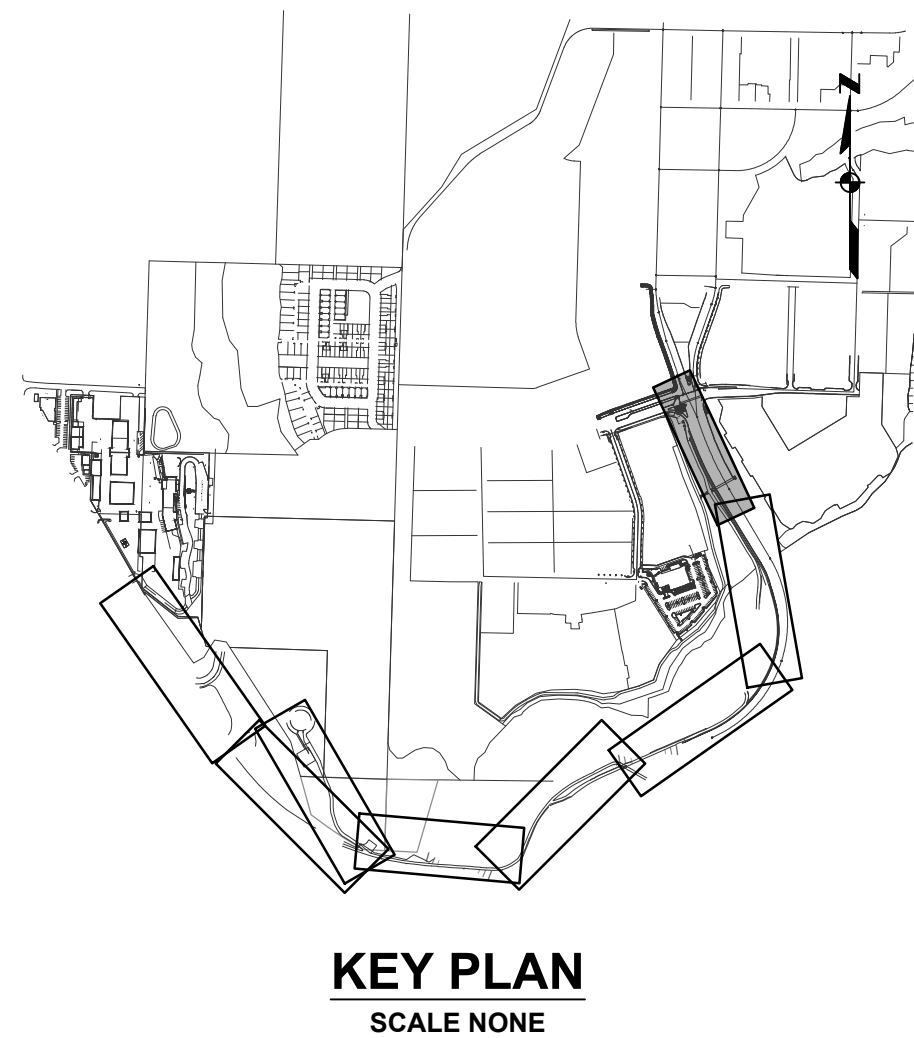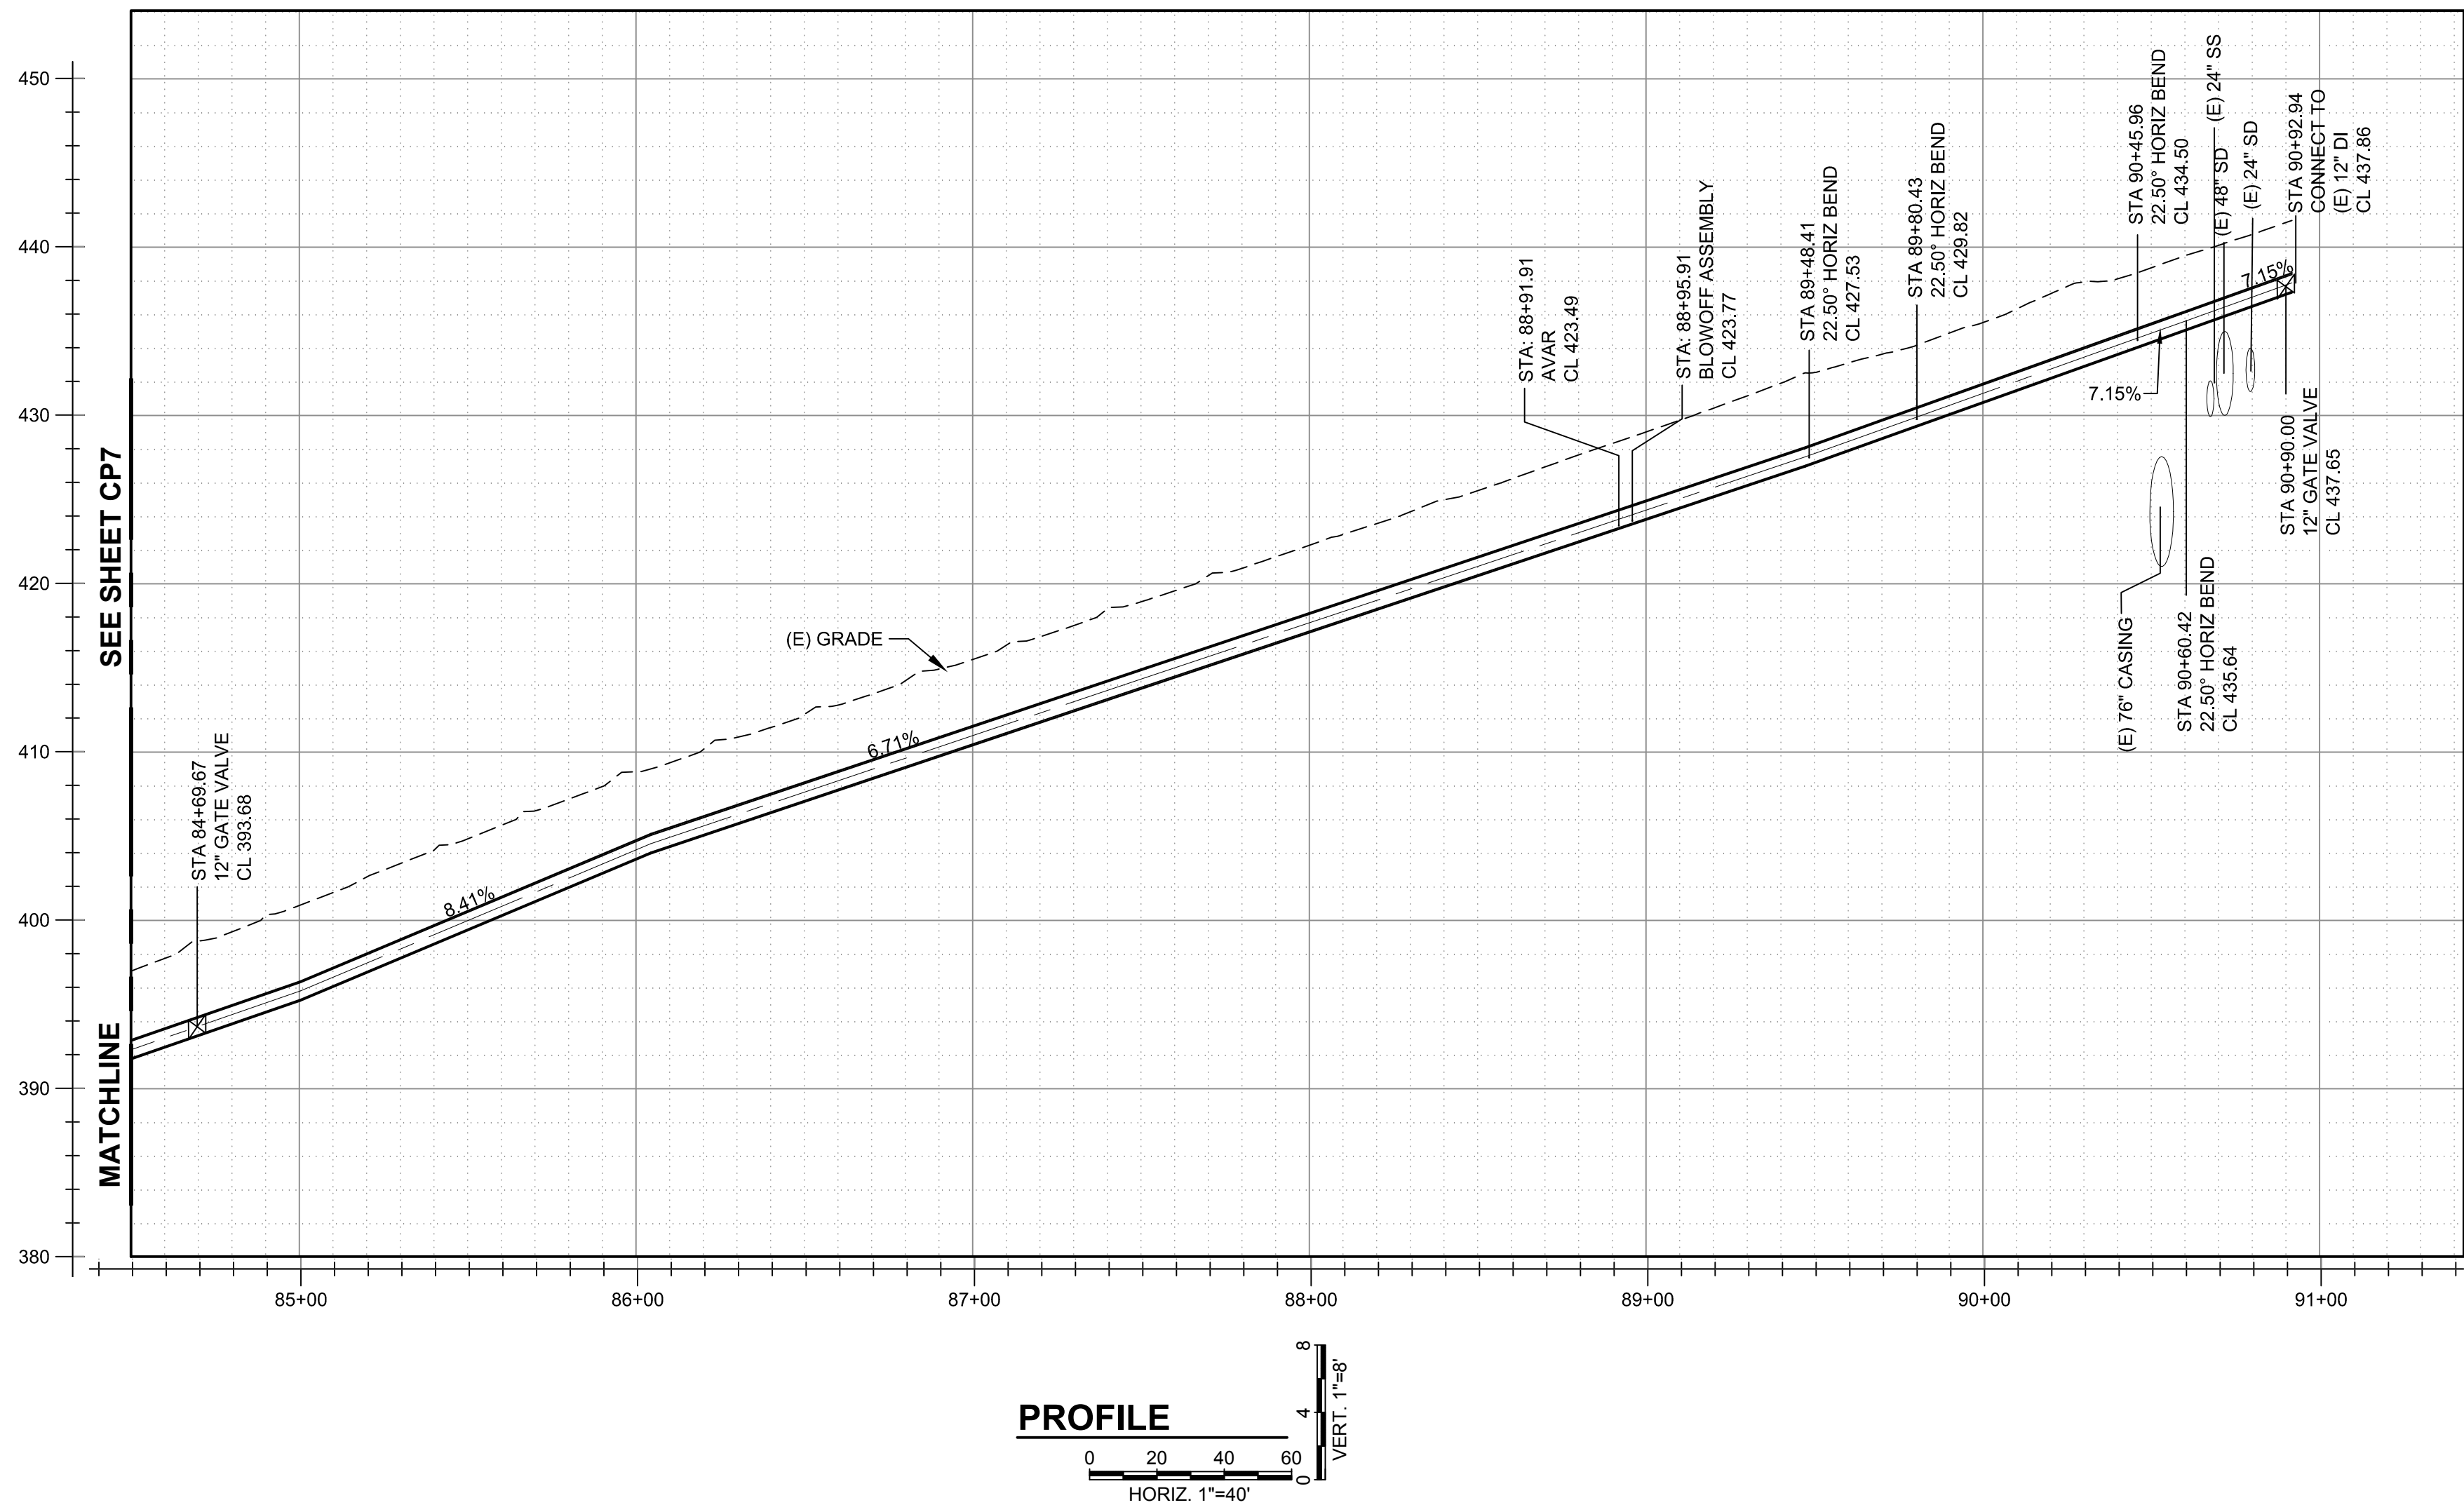

<p>USE OF DOCUMENTS</p> <p>THIS DOCUMENT, INCLUDING THE INCORPORATED DESIGNS, IS AN INSTRUMENT OF SERVICE FOR THIS PROJECT AND SHALL NOT BE USED FOR ANY OTHER PROJECT WITHOUT THE WRITTEN AUTHORIZATION OF KENNEDY/JENKS CONSULTANTS.</p>				<p>NO.</p> <p>REVISION</p> <p>DATE</p> <p>BY</p>		<p>SCALES</p> <p>0 1" 25mm</p> <p>IF THIS BAR IS NOT DIMENSION SHOWN, ADJUST SCALES ACCORDINGLY.</p>		<p>JEFFREY M. FORAY</p> <p>STATE OF WASHINGTON</p> <p>REGISTERED PROFESSIONAL ENGINEER</p> <p>34536</p>		<p>DESIGNED</p> <p>KSP</p> <p>DRAWN</p> <p>LMM</p> <p>CHECKED</p> <p>MDL</p>	<p>CITY OF ISSAQUAH</p> <p>ISSAQUAH, WASHINGTON</p> <p>SOUTH SPAR BOOSTER PUMP STATION</p> <p>Kennedy/Jenks Consultants</p> <p>FEDERAL WAY, WASHINGTON</p>	<p>742 ZONE PIPELINE</p> <p>PLAN AND PROFILE</p> <p>STA. 85+00 TO STA. 91+00</p> <p>90% SUBMITTAL (REVISED 7/1/2020)</p>		<p>FILE NAME</p> <p>139700500-CP008.DWG</p> <p>JOB NO.</p> <p>1397005'00</p> <p>DATE</p> <p>JUNE 2020</p> <p>SHEET</p> <p>45 OF 83</p> <p>CP8</p>
--	--	--	--	--	--	--	--	---	--	--	---	--	--	--

\\jc.local\KUC-Rodrik-Office\FWY\CAD\CAD131\397005.00_City_of_Issaquah\139700500-CP020.dwg 12/10/2020 7:31 AM NICOLASLOZANORDONEZ

A

B

C

D

E

F

G

H

1


2

3

4


NOTES:

1. INSTALL LOCATE WIRE PER CITY STANDARD DETAIL W-06.
2. INSTALL PIPE BEDDING AND TRENCH BACKFILL PER WSDOT OPEN CUT DETAIL B-55.20-02 AS SHOWN ON DRAWING G-8, UNLESS OTHERWISE NOTED.
3. CONTRACTOR TO PREPARE SHORING PLAN, PROVIDE SHORING FOR TRENCH DEPTHS GREATER THAN 4'.

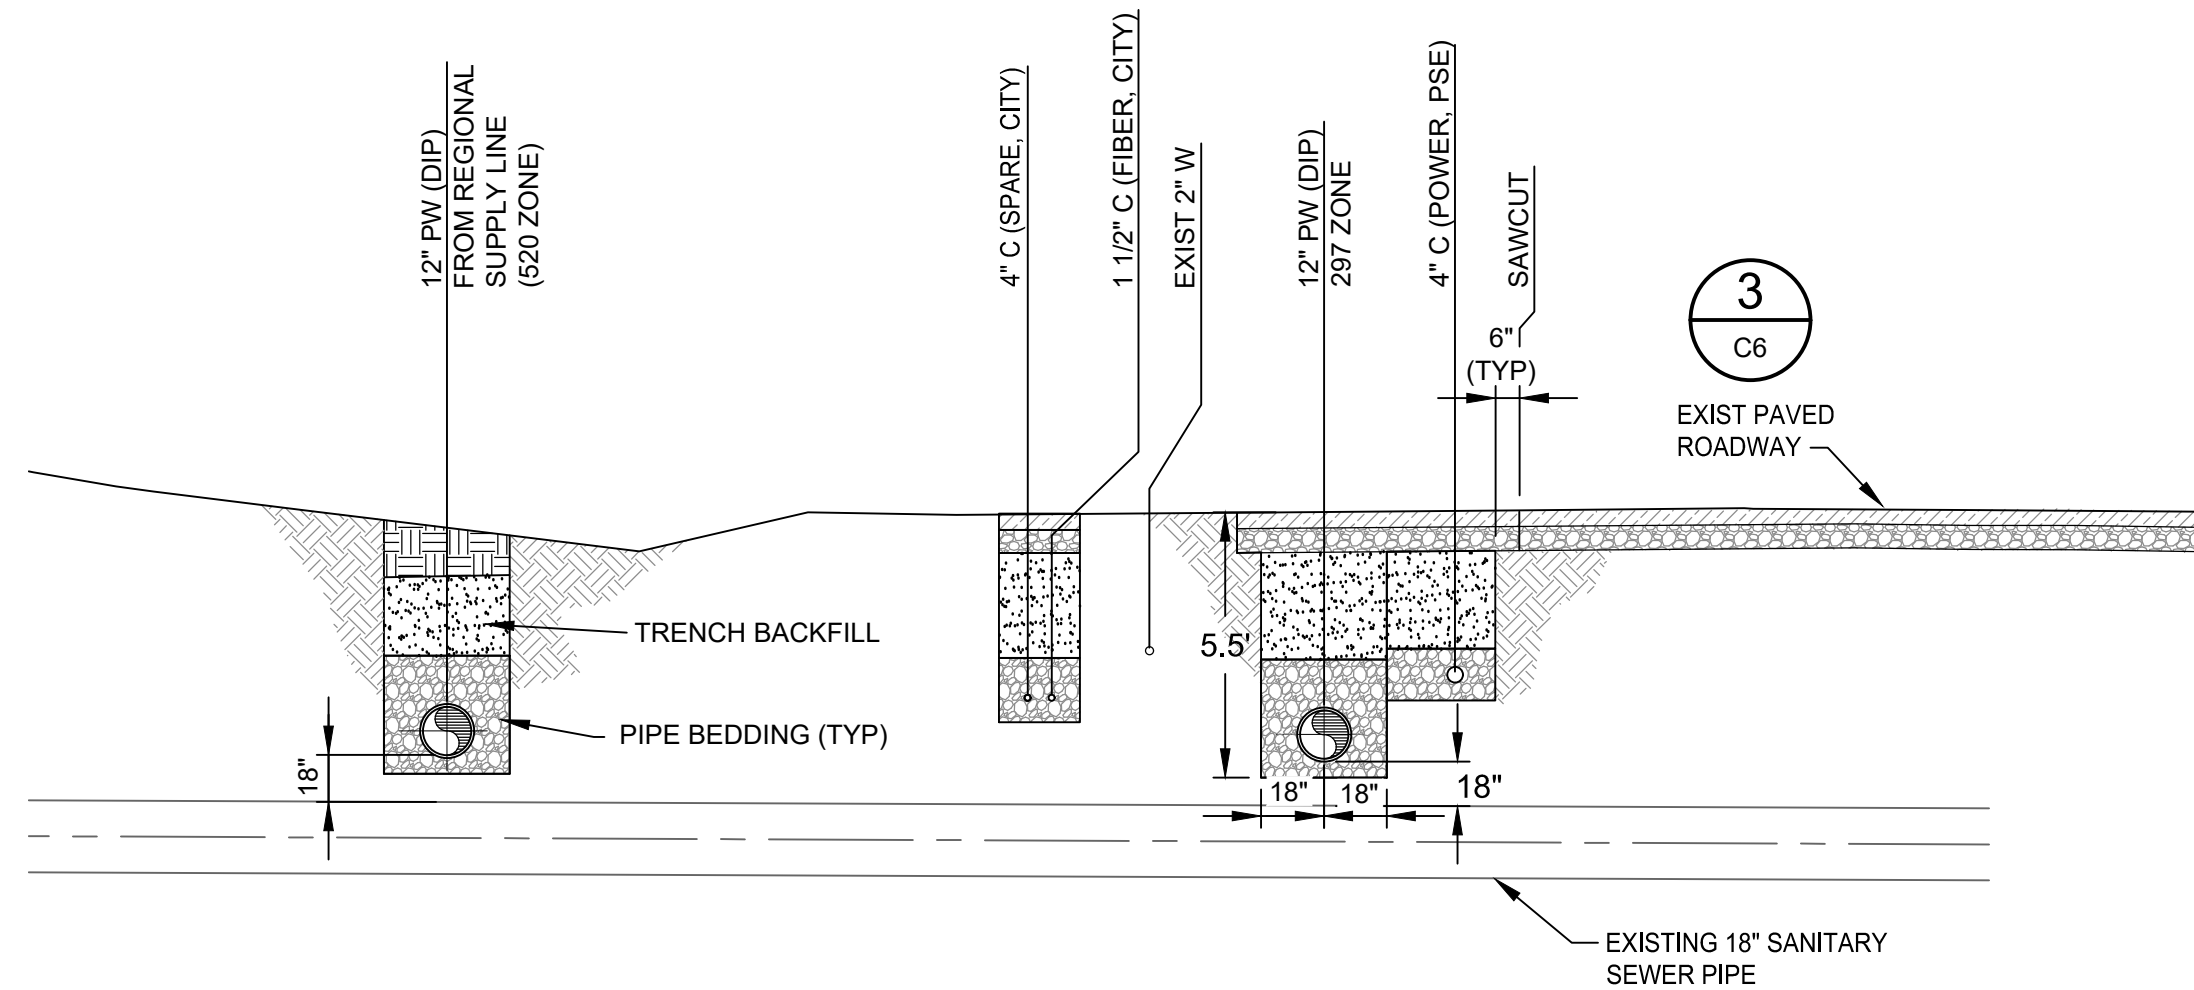


STA 1+00 TO 2+00 297/520 ZONE SECTION

A
CP1

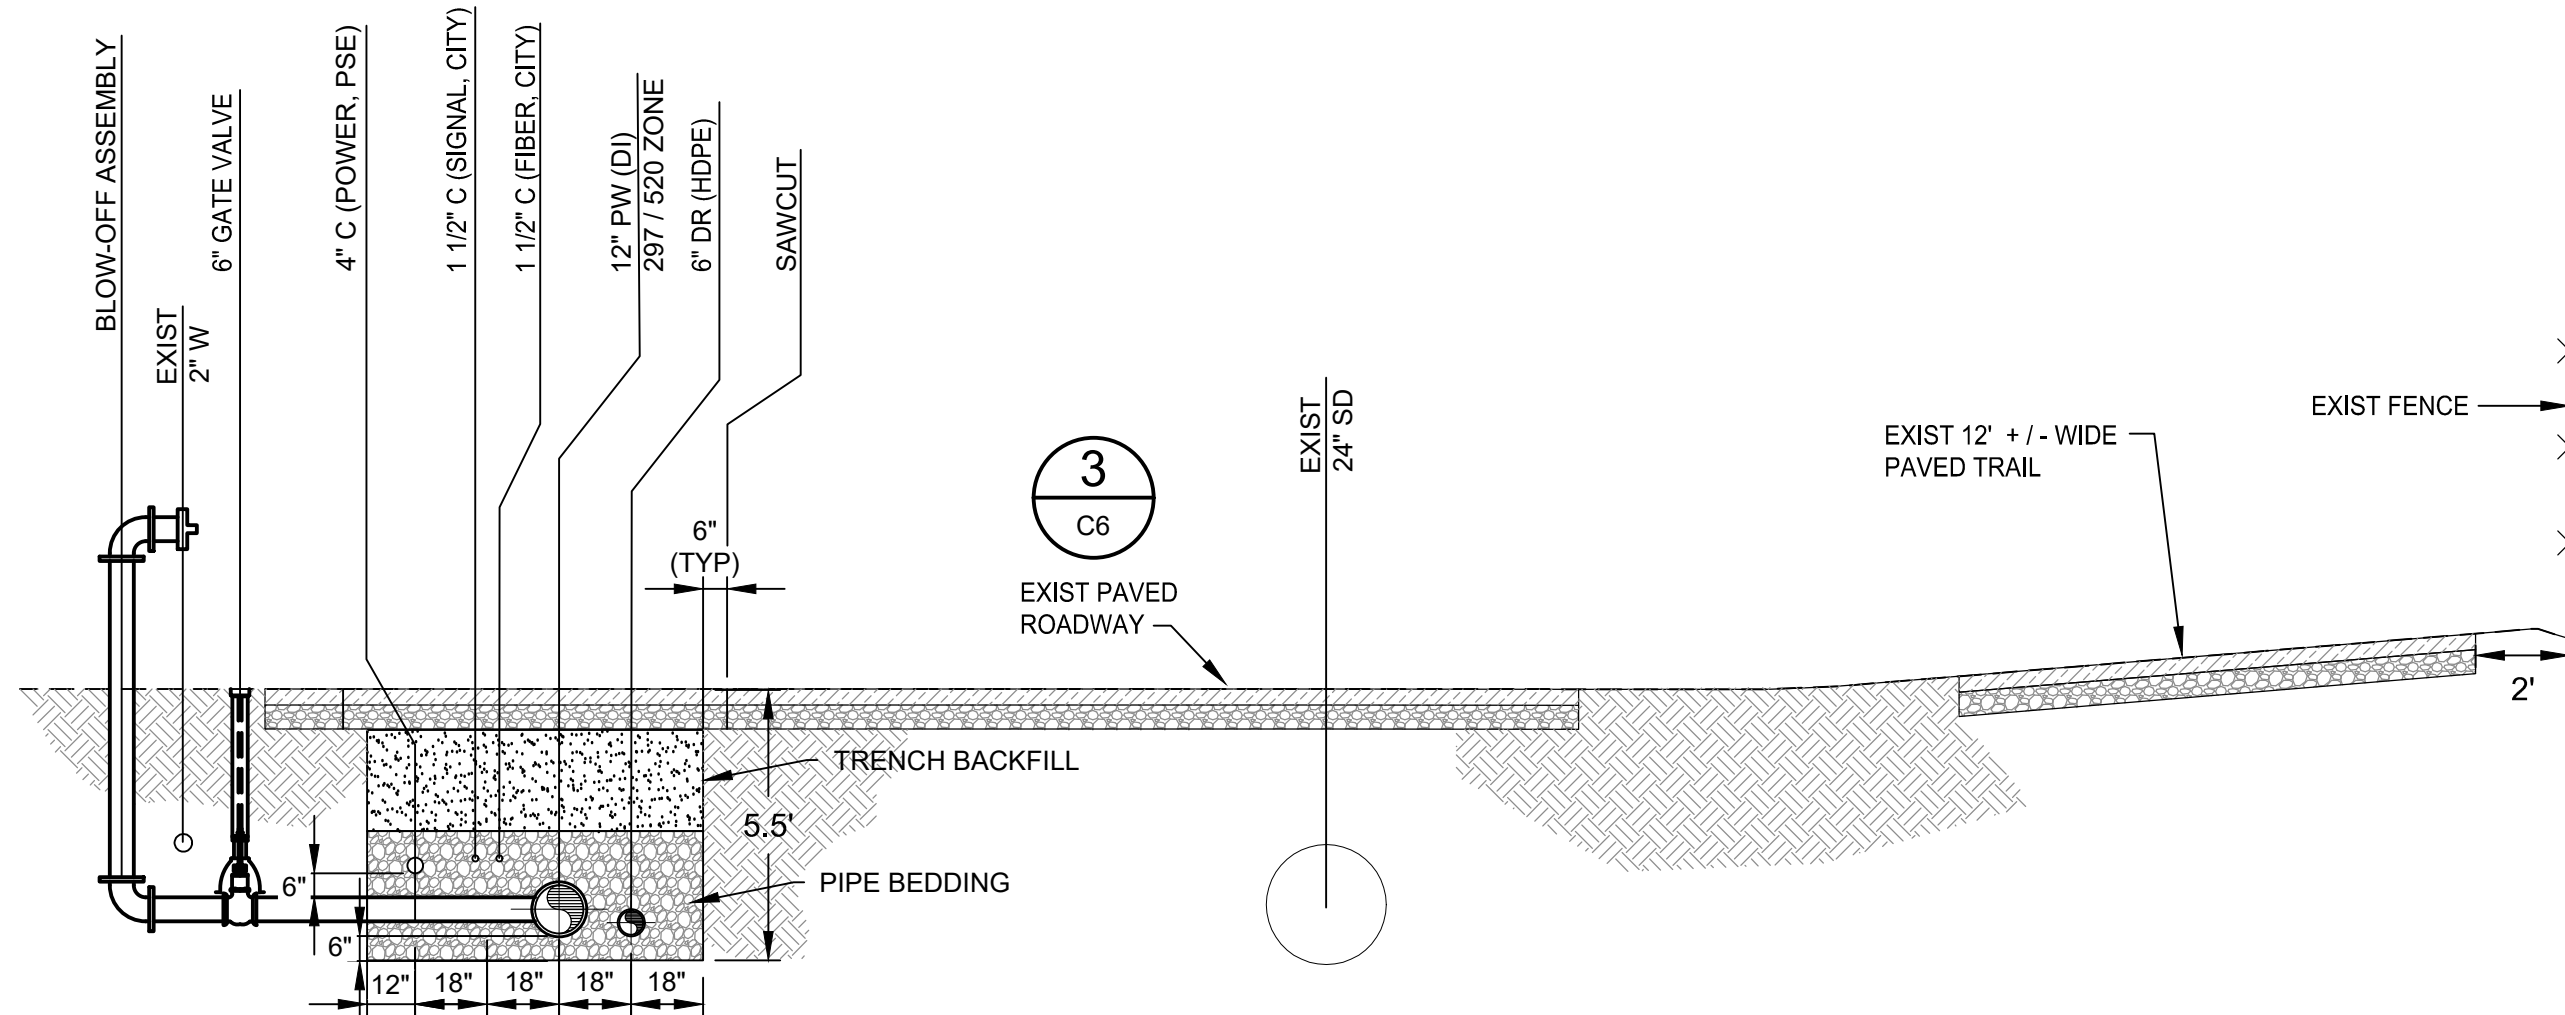


STA 2+00 TO 5+38 297/520 ZONE SECTION

B
CP1

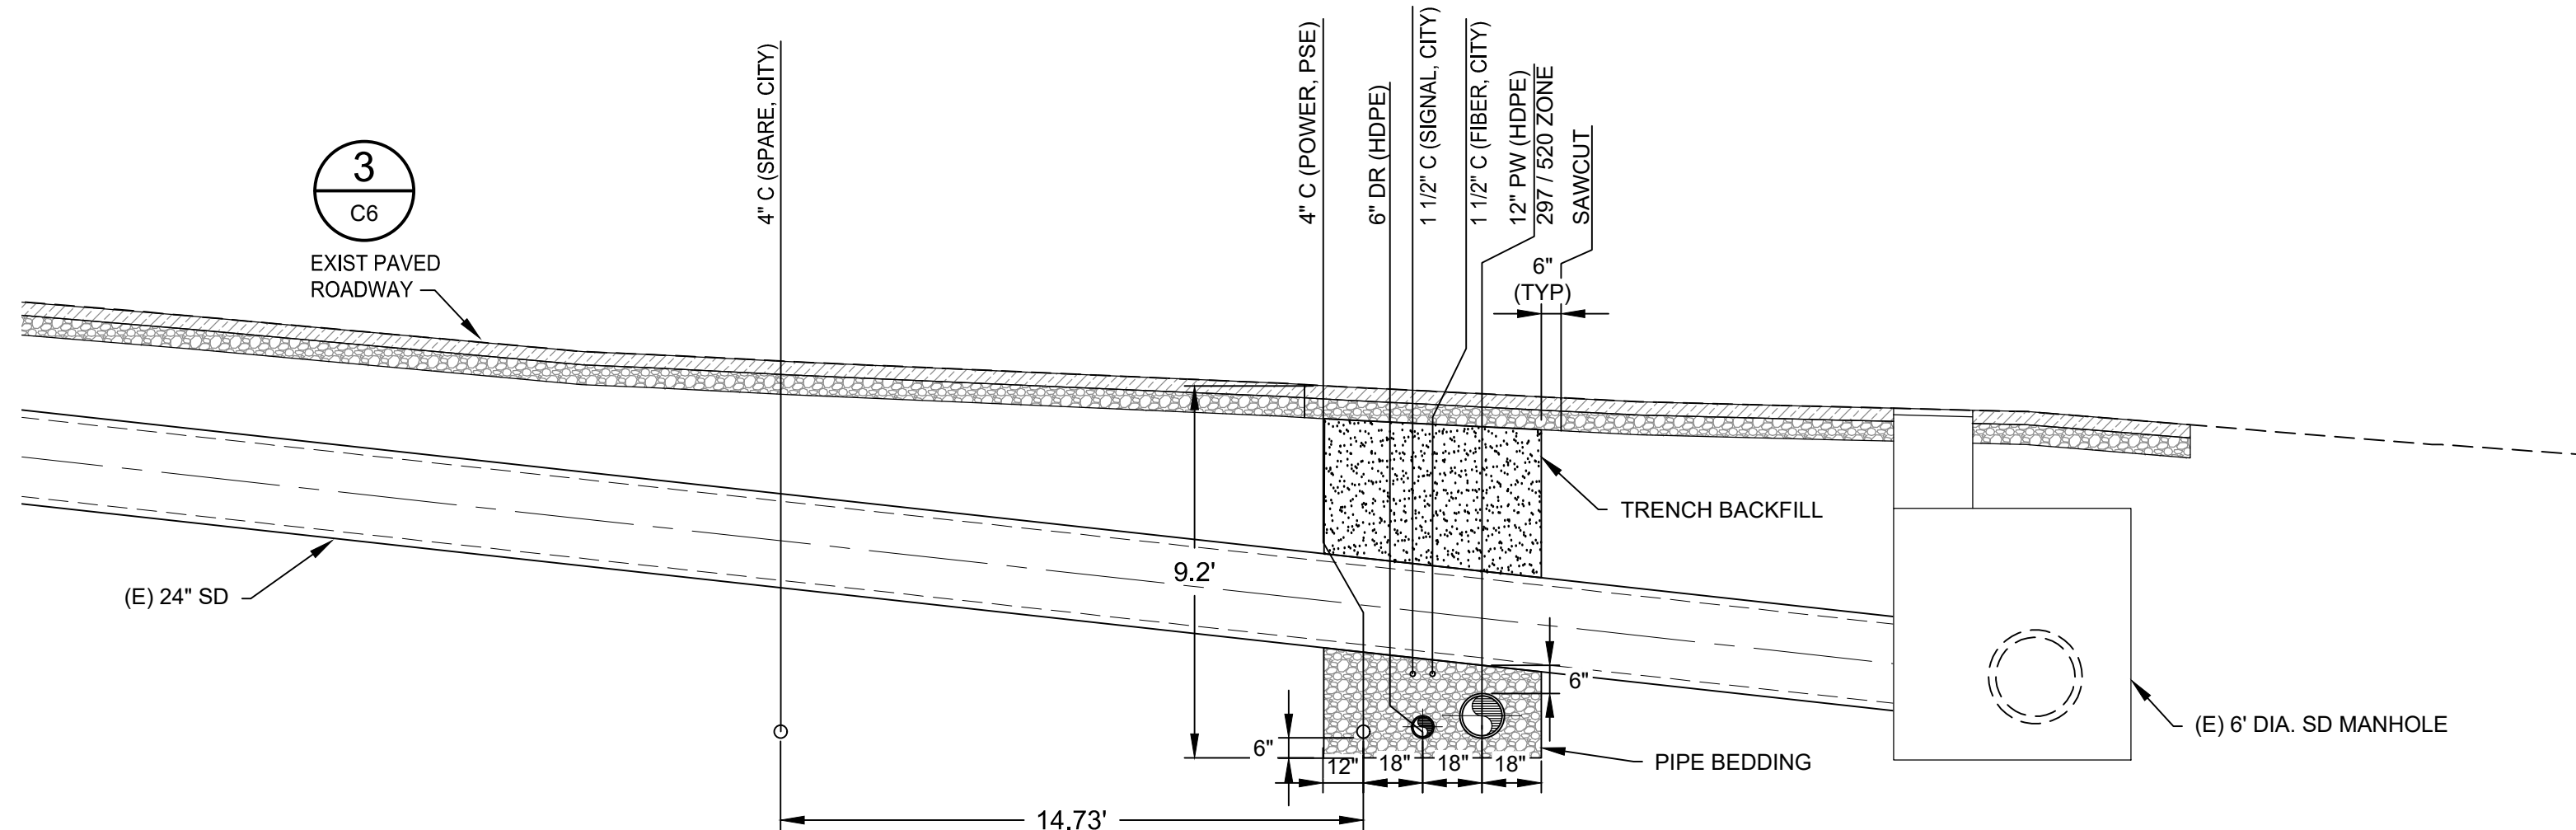

STA 6+05 TO 6+20 297/520 ZONE SECTION

C
CP1

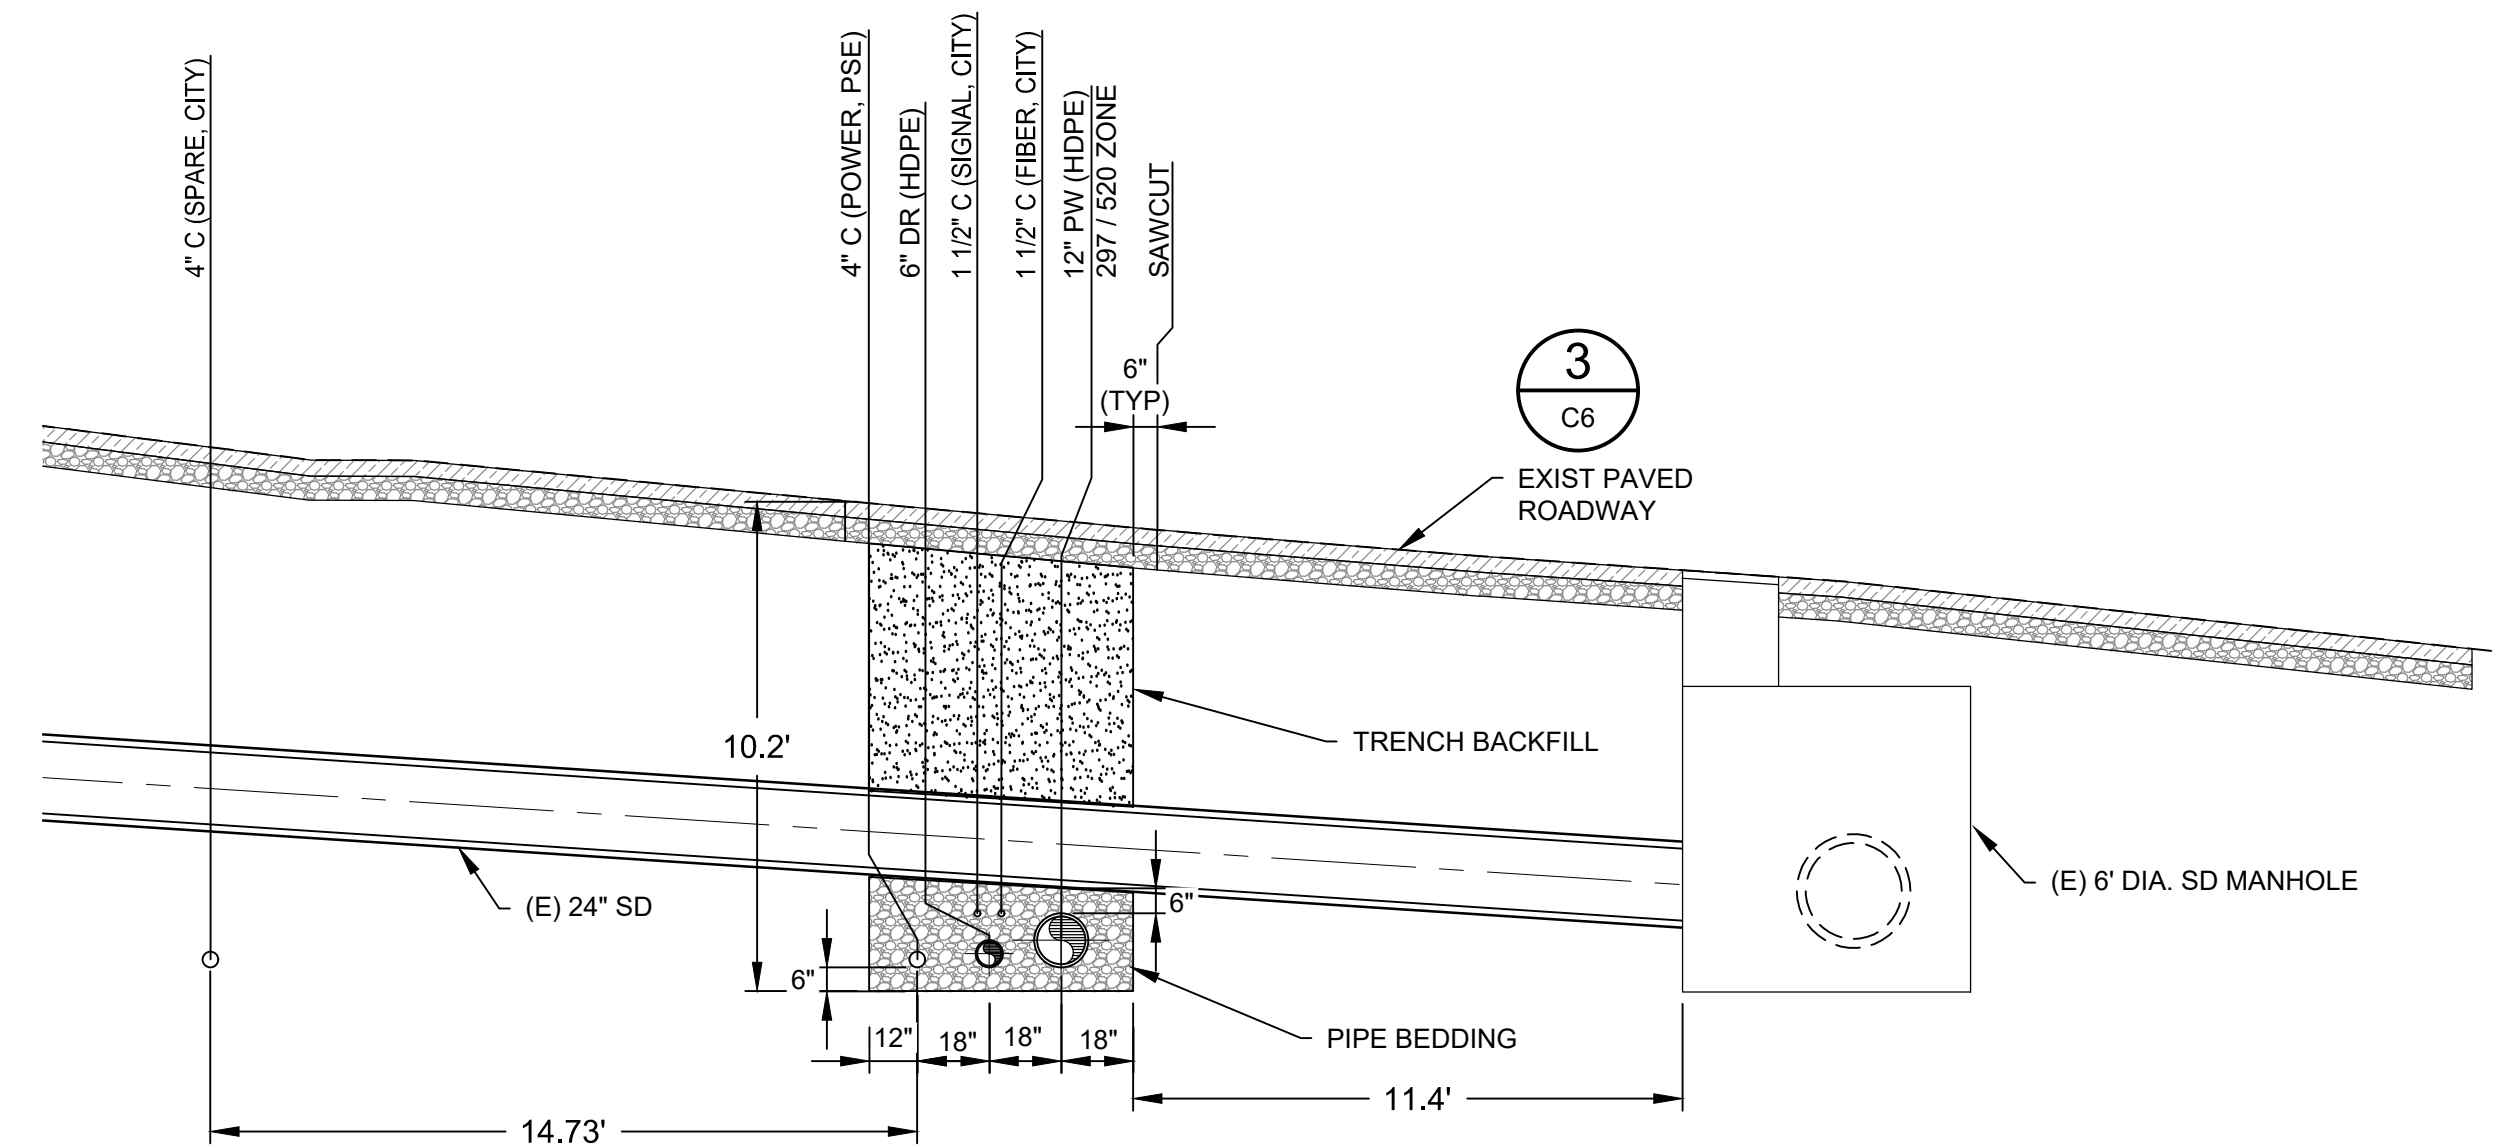

STA 6+20 TO 6+90 297/520 ZONE SECTION


D
CP1

USE OF DOCUMENTS

THIS DOCUMENT, INCLUDING THE INCORPORATED DESIGNS, IS AN INSTRUMENT OF SERVICE FOR THIS PROJECT AND SHALL NOT BE USED FOR ANY OTHER PROJECT WITHOUT THE WRITTEN AUTHORIZATION OF KENNEDY/JENKS CONSULTANTS.

SCALES

1" = 4'
25mm
IF THIS BAR IS NOT DIMENSION SHOWN, ADJUST SCALES ACCORDINGLY.

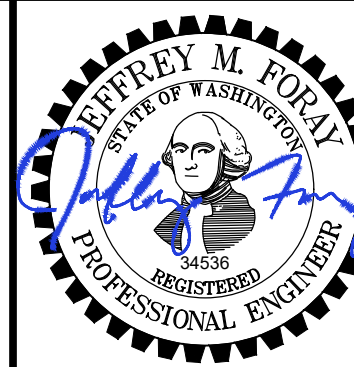

DESIGNED

KSP

DRAWN

RJS

CHECKED

MDL



CITY OF ISSAQUAH
ISSAQUAH, WASHINGTON
SOUTH SPAR BOOSTER PUMP STATION


Kennedy/Jenks Consultants
FEDERAL WAY, WASHINGTON

PIPELINE SECTIONS - 1



90% SUBMITTAL (REVISED 11/30/2020)

FILE NAME
139700500-CP020.DWG
JOB NO.
1397005*00
DATE
NOVEMBER 2020
SHEET
OF
CP20



\\jc.local\KUC-Rodrik-Office\FWY\CAD\CAD13\1397005.00_City_of_Issaquah\139700500-CP021.dwg 12/10/2020 7:33 AM NICOLASIOZANORDONEZ

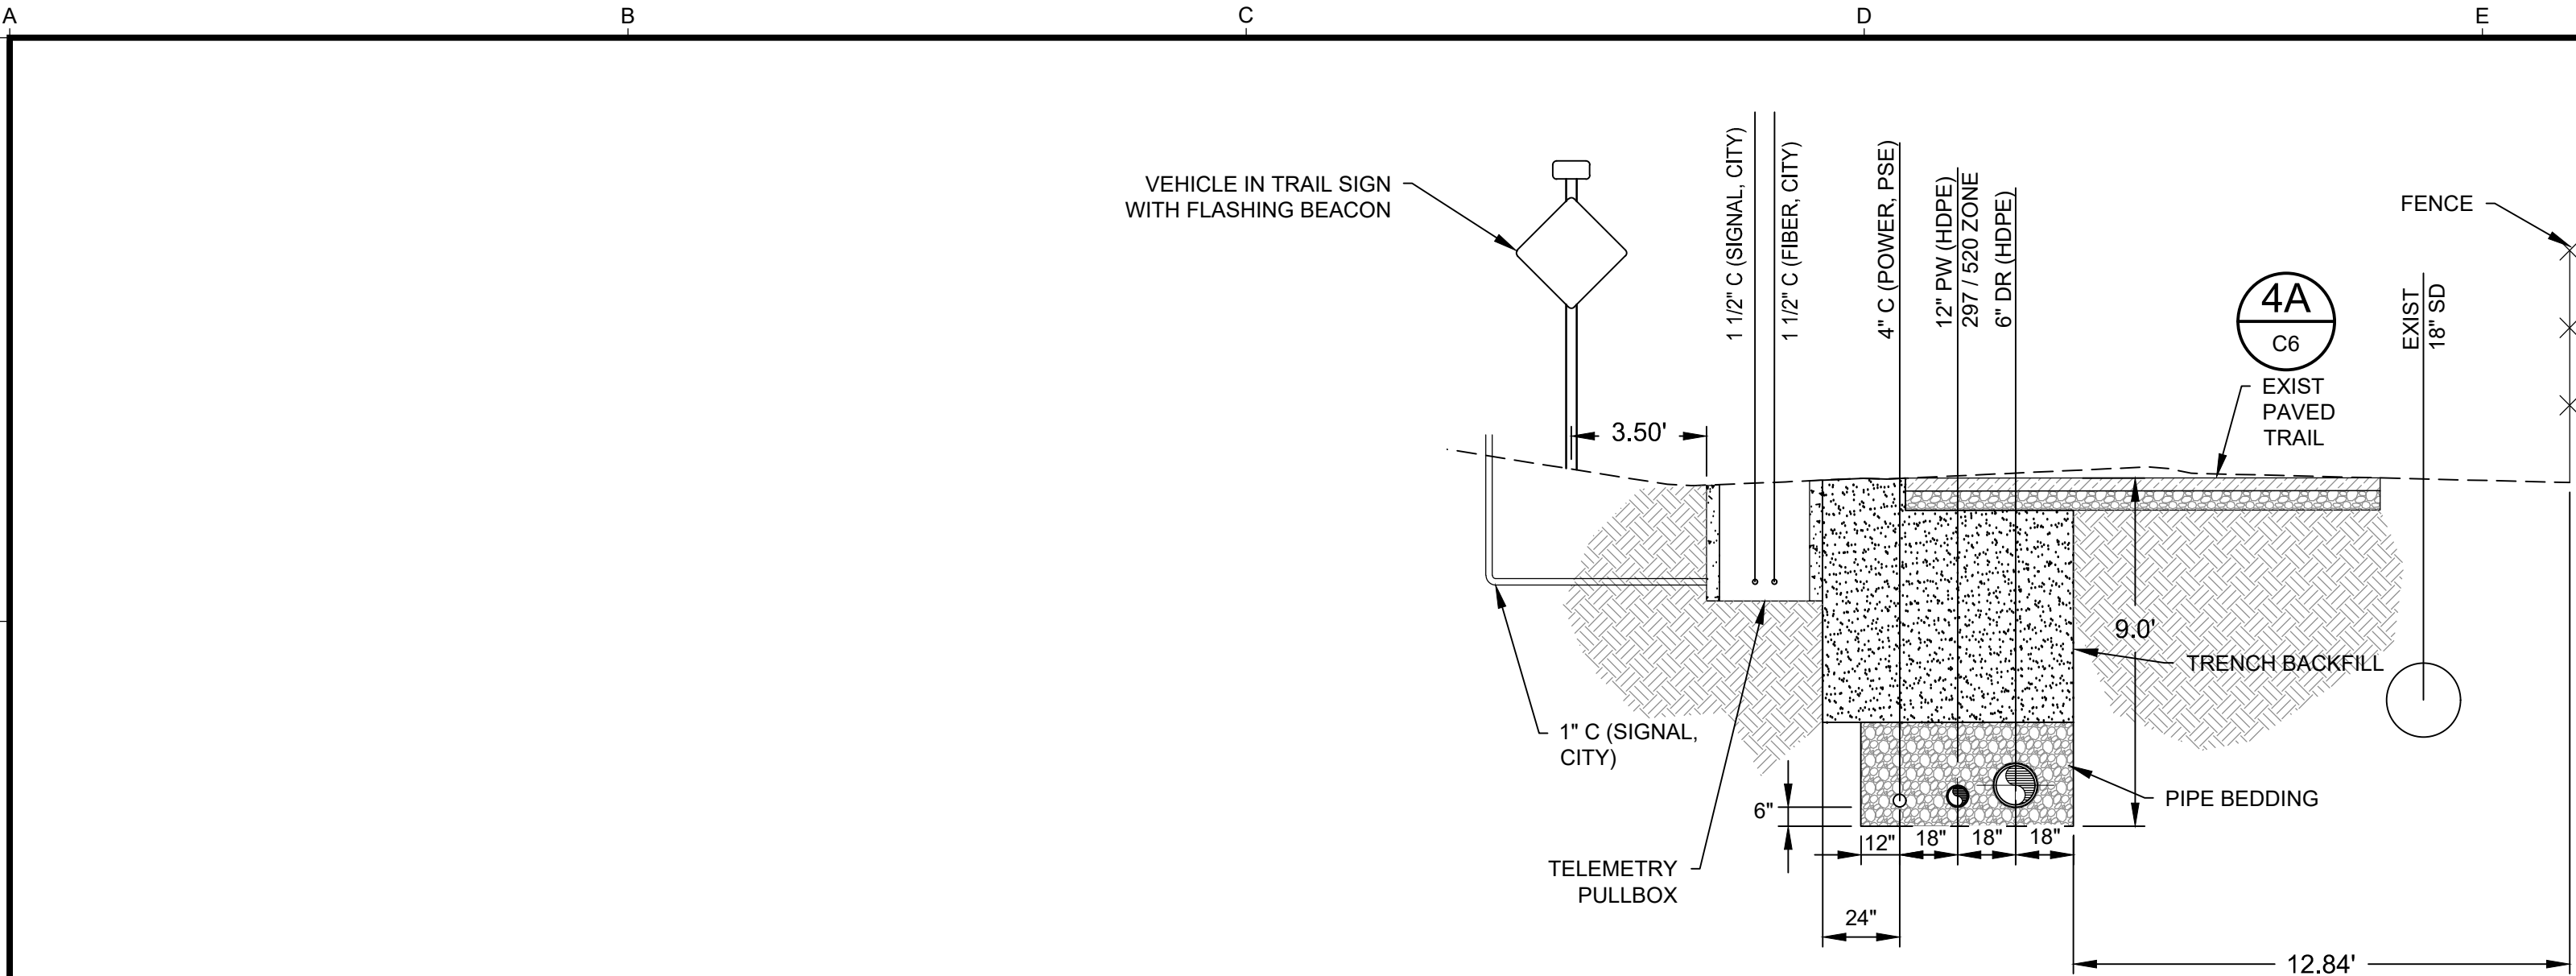


STA 6+95 TO 7+00 297/520 ZONE SECTION E

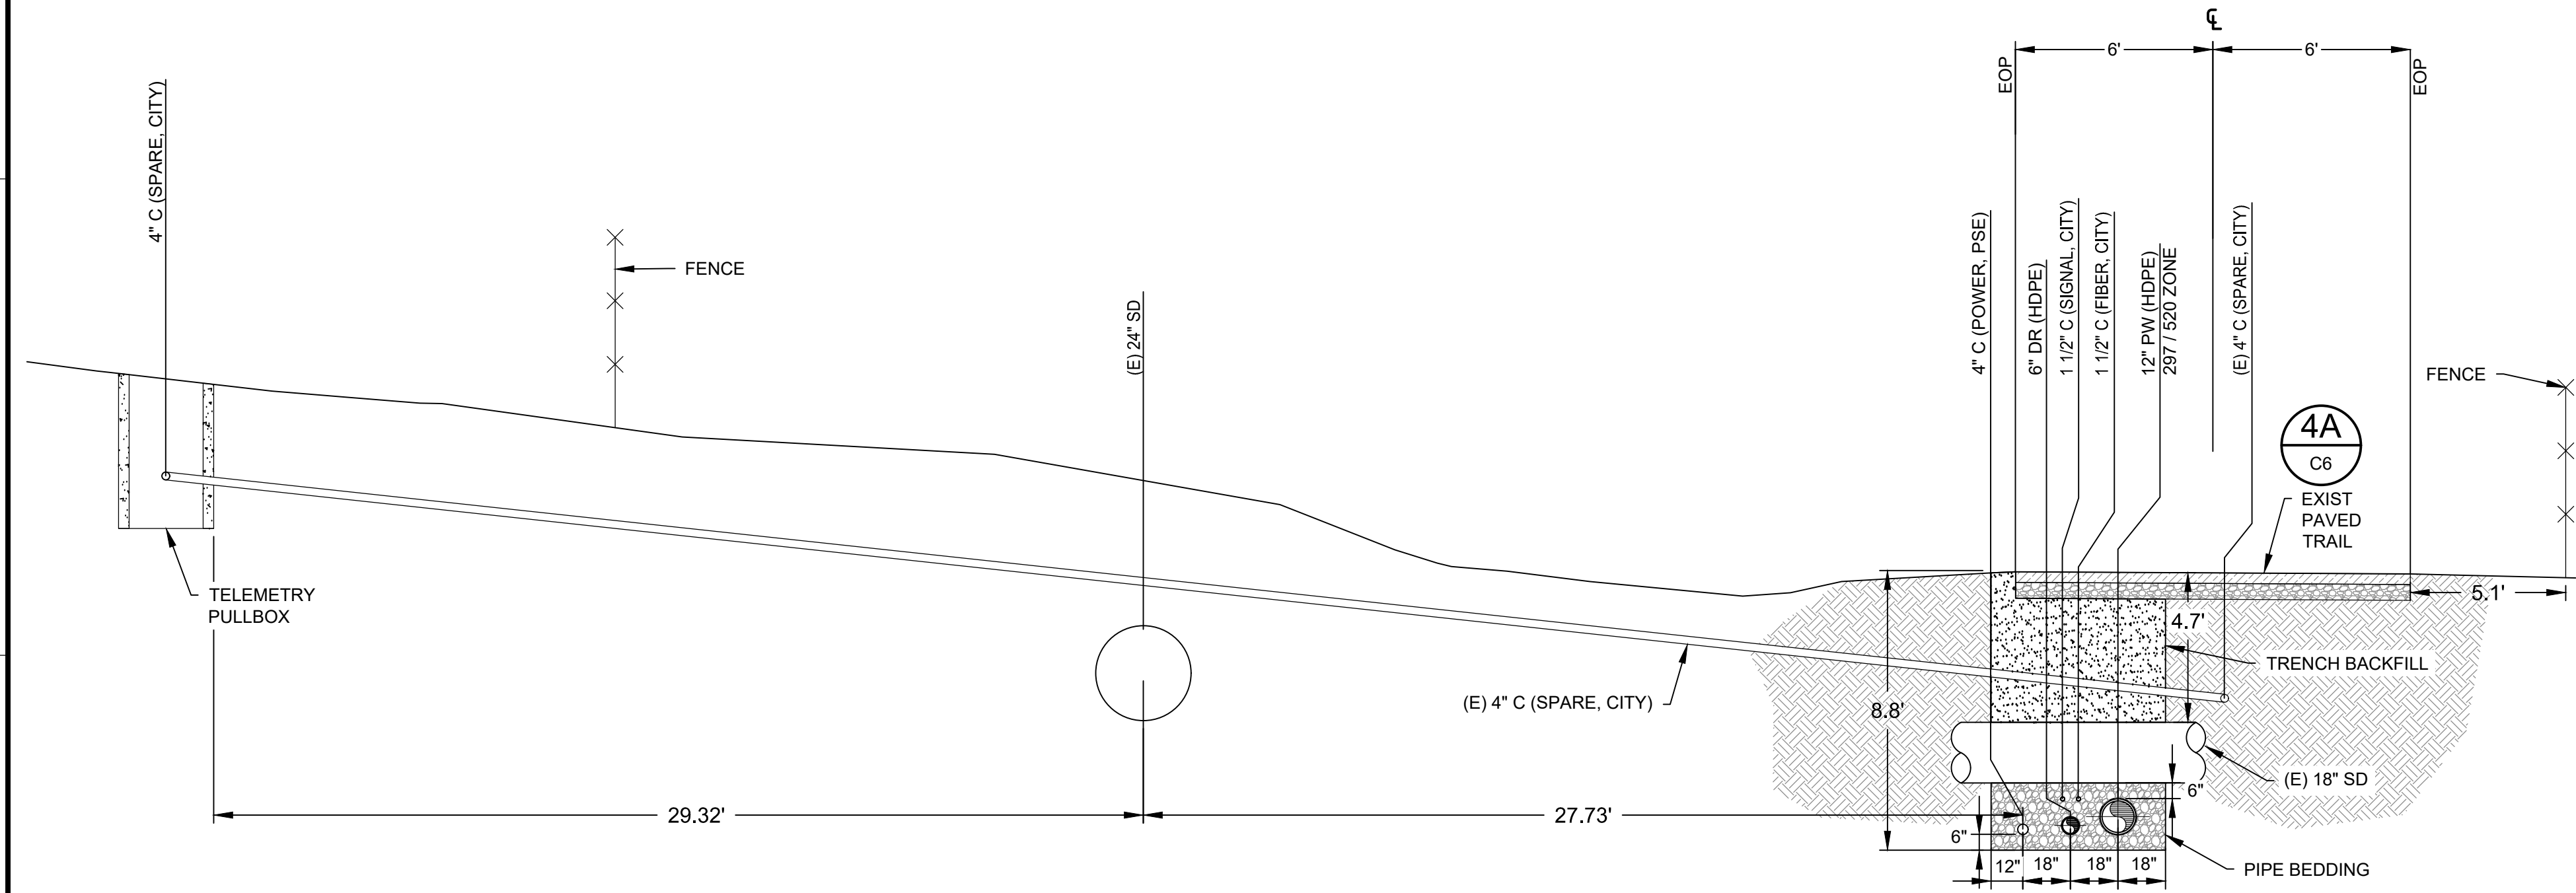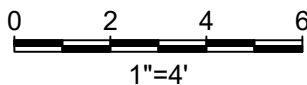

STA 7+00 TO 7+23 297/520 ZONE SECTION F

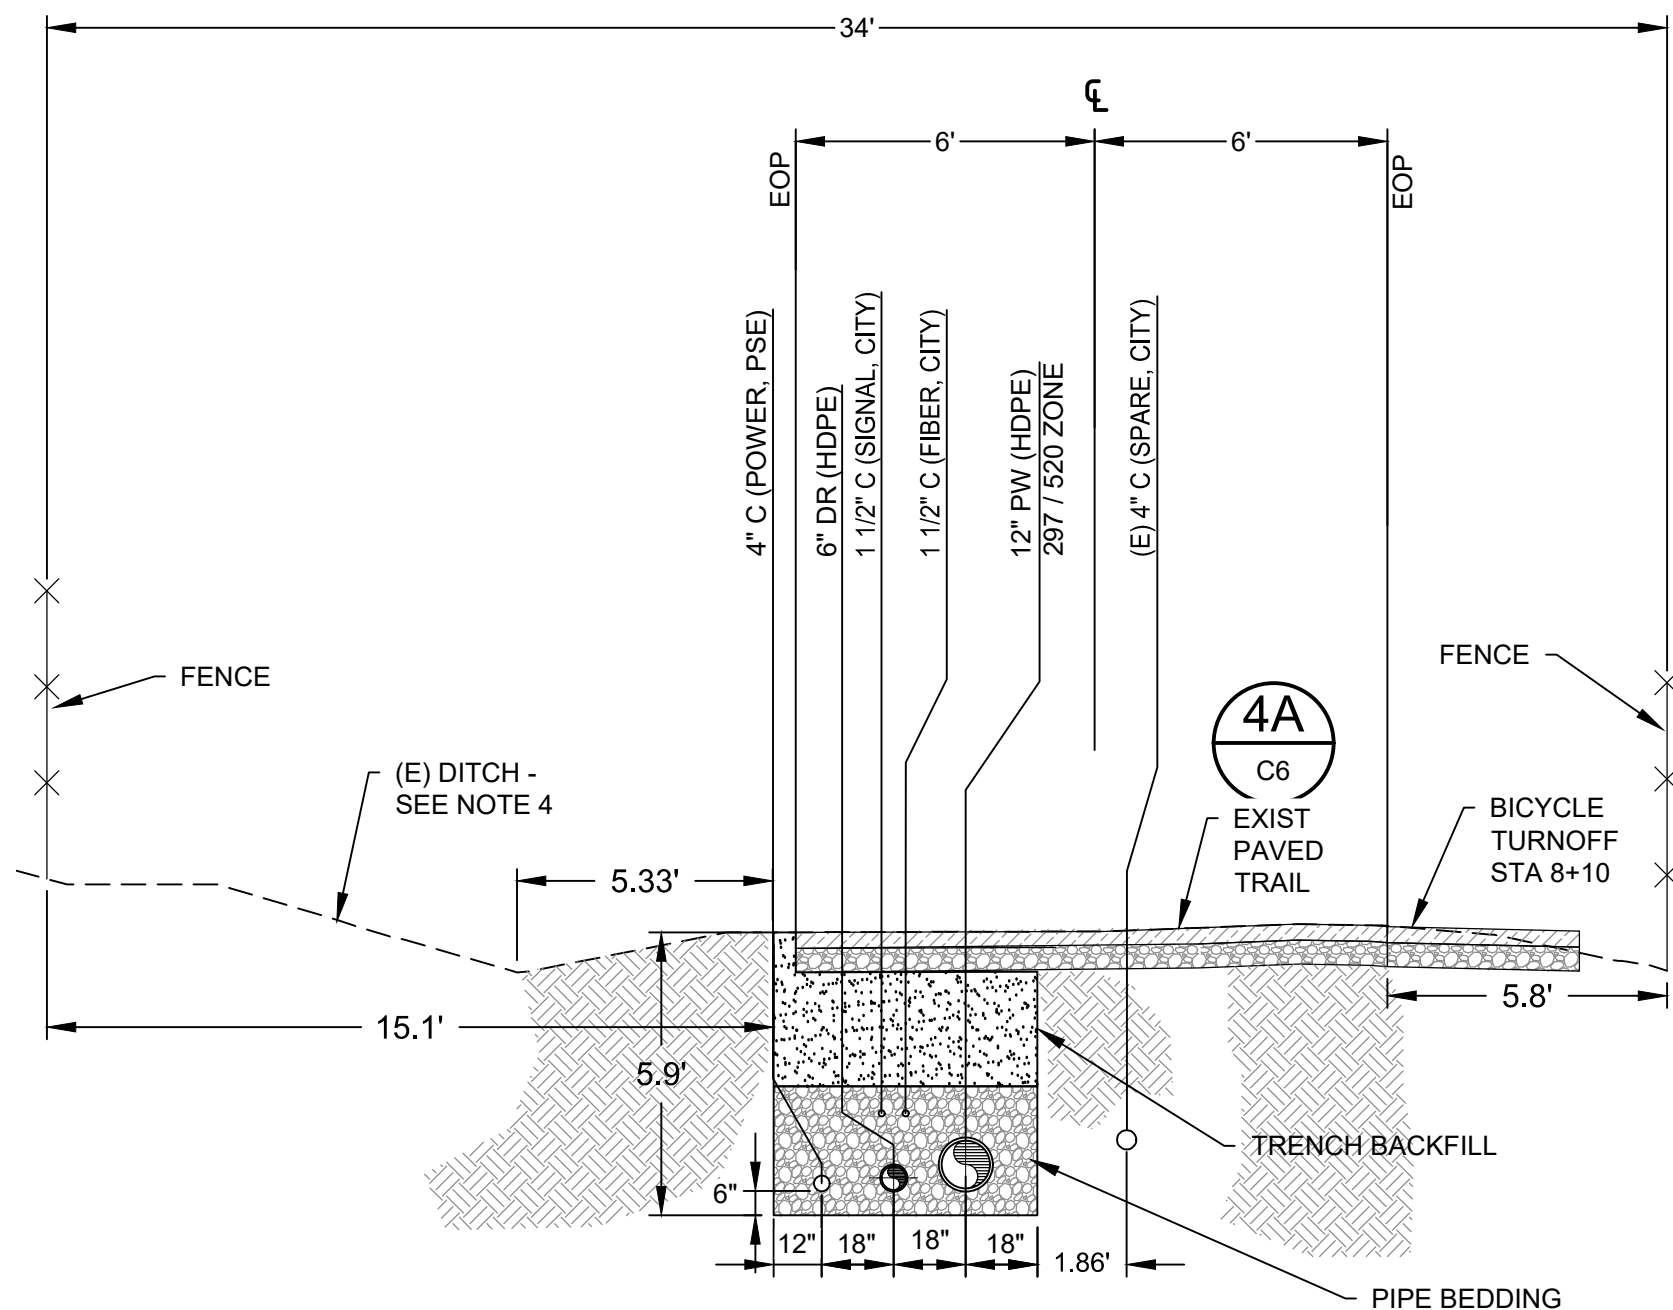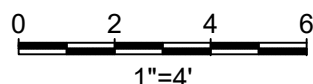

STA 7+23 TO 9+85 297/520 ZONE SECTION G

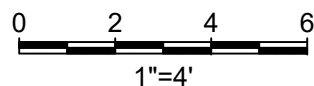

NOTES:

1. INSTALL LOCATE WIRE PER CITY STANDARD DETAIL W-06.
2. INSTALL PIPE BEDDING AND TRENCH BACKFILL PER WSDOT OPEN CUT DETAIL B-55.20-02 AS SHOWN ON DRAWING G-8, UNLESS OTHERWISE NOTED.
3. CONTRACTOR TO PREPARE SHORING PLAN, PROVIDE SHORING FOR TRENCH DEPTHS GREATER THAN 4'
4. PRESERVE FEATURES OF EXISTING DITCH, RESTORE TO ORIGINAL CONDITION AFTER CONSTRUCTION.

USE OF DOCUMENTS

THIS DOCUMENT, INCLUDING THE INCORPORATED DESIGNS, IS AN INSTRUMENT OF SERVICE FOR THIS PROJECT AND SHALL NOT BE USED FOR ANY OTHER PROJECT WITHOUT THE WRITTEN AUTHORIZATION OF KENNEDY/JENKS CONSULTANTS.

NO.	REVISION	DATE	BY
-----	----------	------	----

SCALES

0 1" 25mm
IF THIS BAR IS NOT DIMENSION SHOWN, ADJUST SCALES ACCORDINGLY.



DESIGNED	KSP
DRAWN	RJS
CHECKED	MDL




CITY OF ISSAQUAH
ISSAQUAH, WASHINGTON
SOUTH SPAR BOOSTER PUMP STATION

Kennedy/Jenks Consultants
FEDERAL WAY, WASHINGTON


PIPELINE SECTIONS - 2

90% SUBMITTAL (REVISED 11/30/2020)


FILE NAME	139700500-CP021.DWG
JOB NO.	1397005*00
DATE	NOVEMBER 2020
SHEET	OF
CP21	

USE OF DOCUMENTS THIS DOCUMENT, INCLUDING THE INCORPORATED DESIGNS, IS AN INSTRUMENT OF SERVICE FOR THIS PROJECT AND SHALL NOT BE USED FOR ANY OTHER PROJECT WITHOUT THE WRITTEN AUTHORIZATION OF KENNEDY/JENKS CONSULTANTS.					<div>SCALES</div> <div><div>01"25mm</div></div> <div>IF THIS BAR IS NOT DIMENSION SHOWN, ADJUST SCALES ACCORDINGLY.</div>	<div>JEFFREY M. FORAY STATE OF WASHINGTON REGISTERED PROFESSIONAL ENGINEER 34536</div>	DESIGNED	<div></div> <div>CITY OF ISSAQUAH ISSAQUAH, WASHINGTON</div> <div>SOUTH SPAR BOOSTER PUMP STATION</div>	<div>PIPELINE SECTIONS - 3</div> <div>90% SUBMITTAL (REVISED 11/30/2020)</div>	FILE NAME
							139700500-CP022.DWG			
							JOB NO.			
							1397005*00			
							DATE			
									NOVEMBER 2020	
										SHEET OF
										CP22
	NO.	REVISION	DATE	BY				Kennedy/Jenks Consultants FEDERAL WAY, WASHINGTON		

\\jc.local\KUC-Rodrik-Office\FWY\CAD\CAD131\397005.00_City_of_Issaquah\139700500-CP023.dwg 12/10/2020 8:39 AM NICOLASLOZANORDONEZ

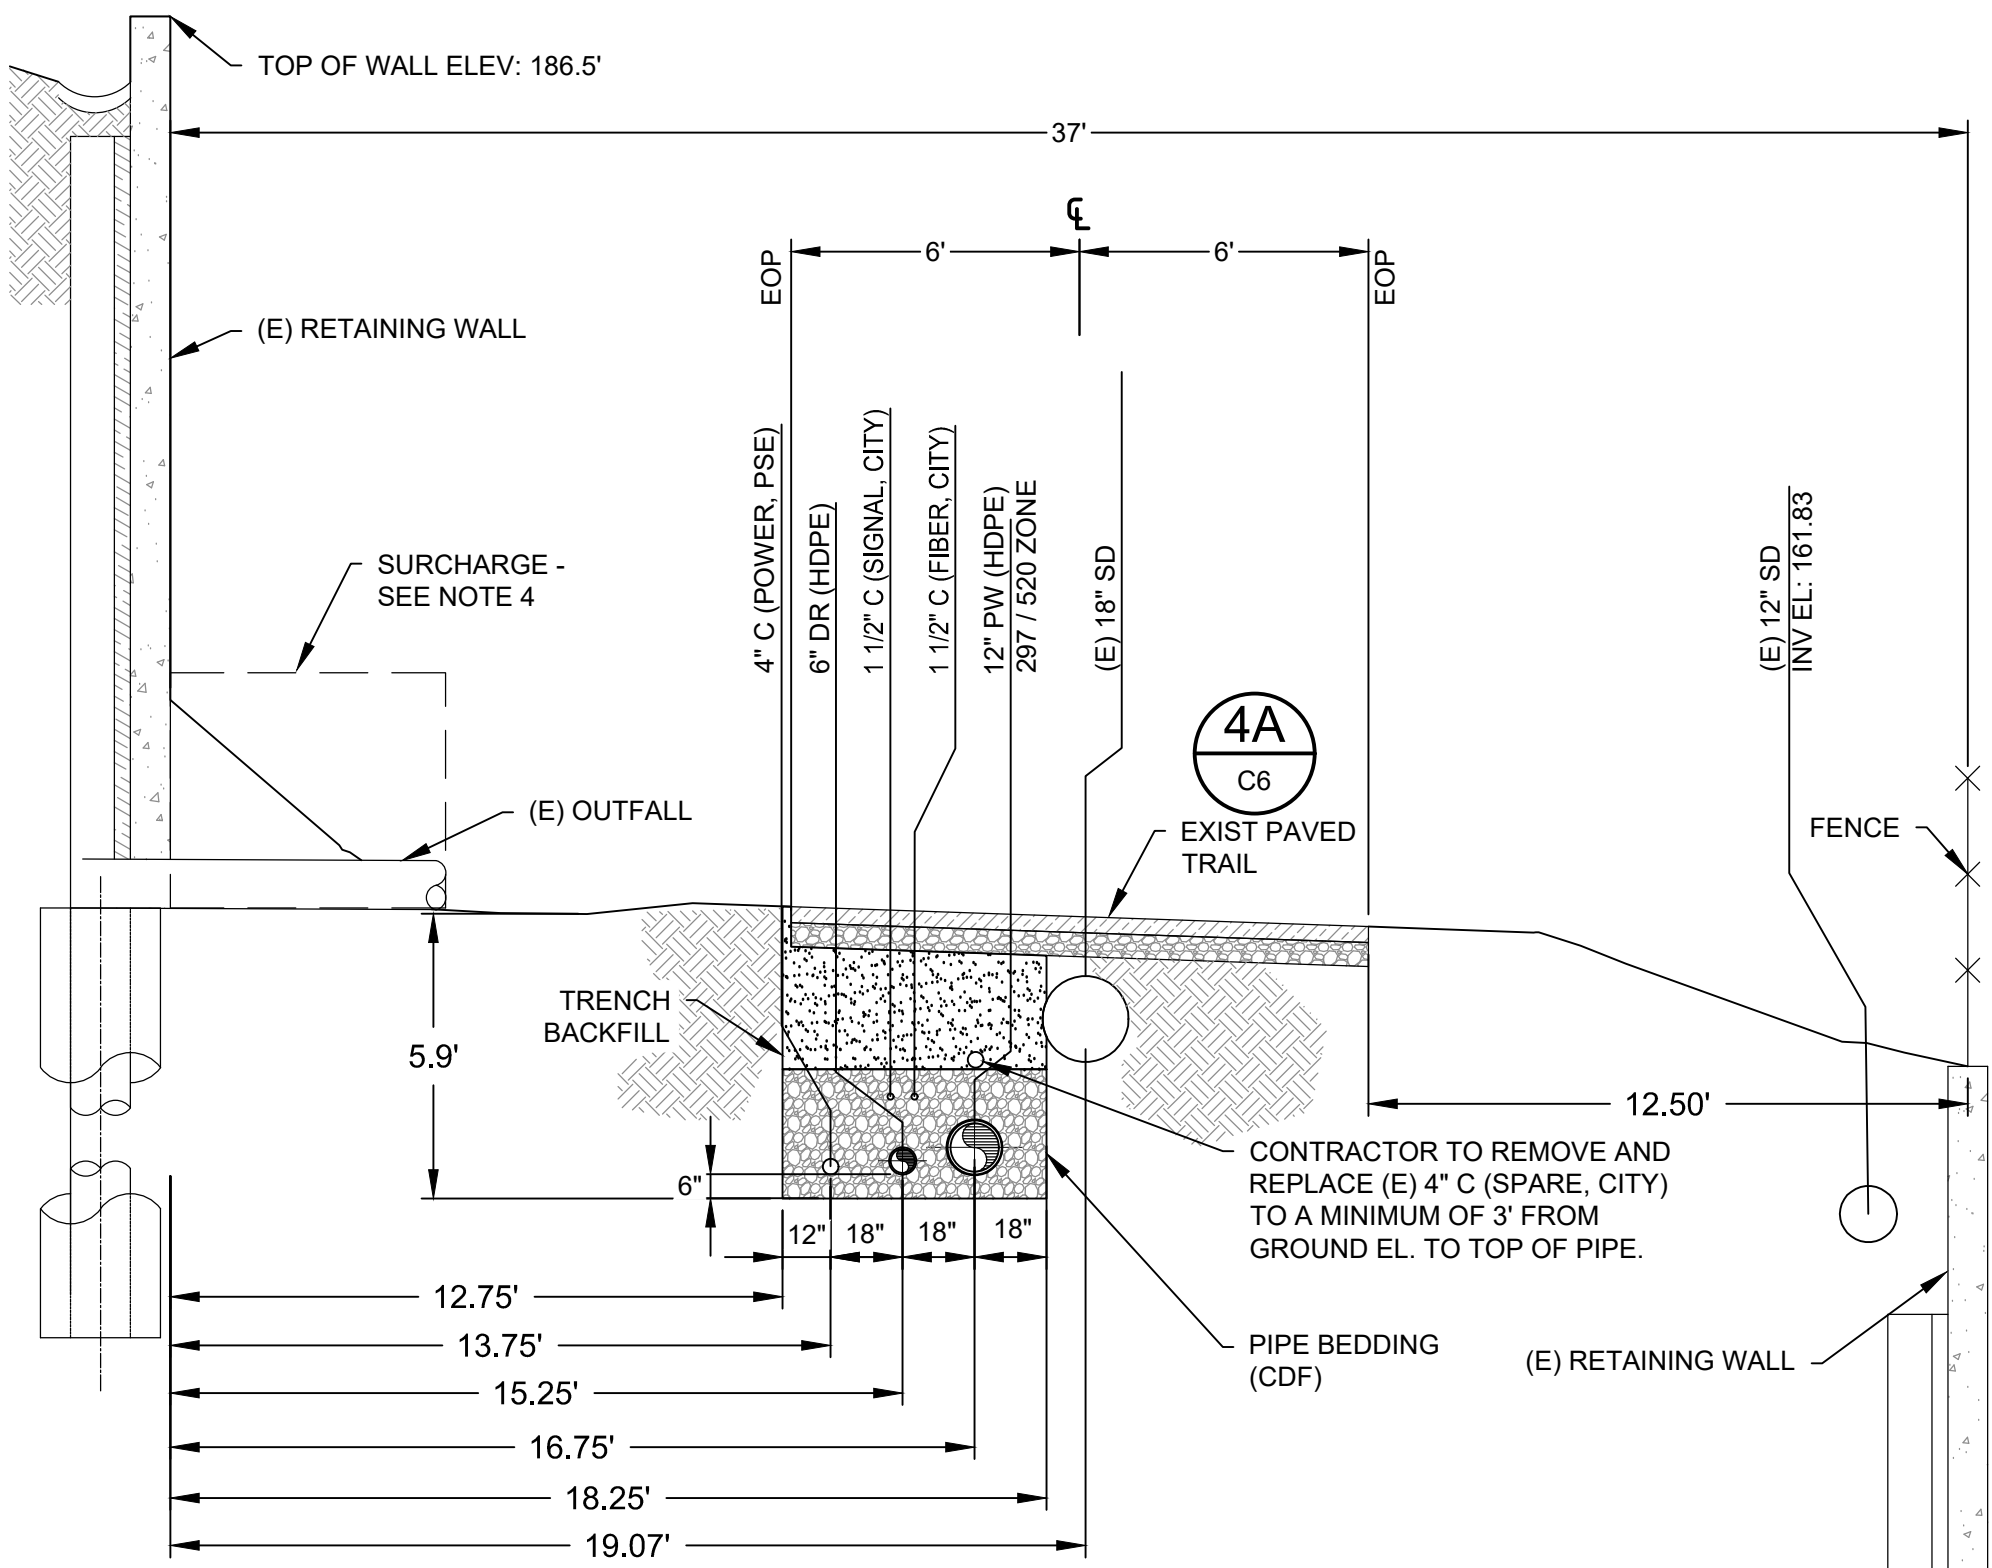


STA 16+23 TO 17+08 297/520 ZONE SECTION N
CP2
1"=4'

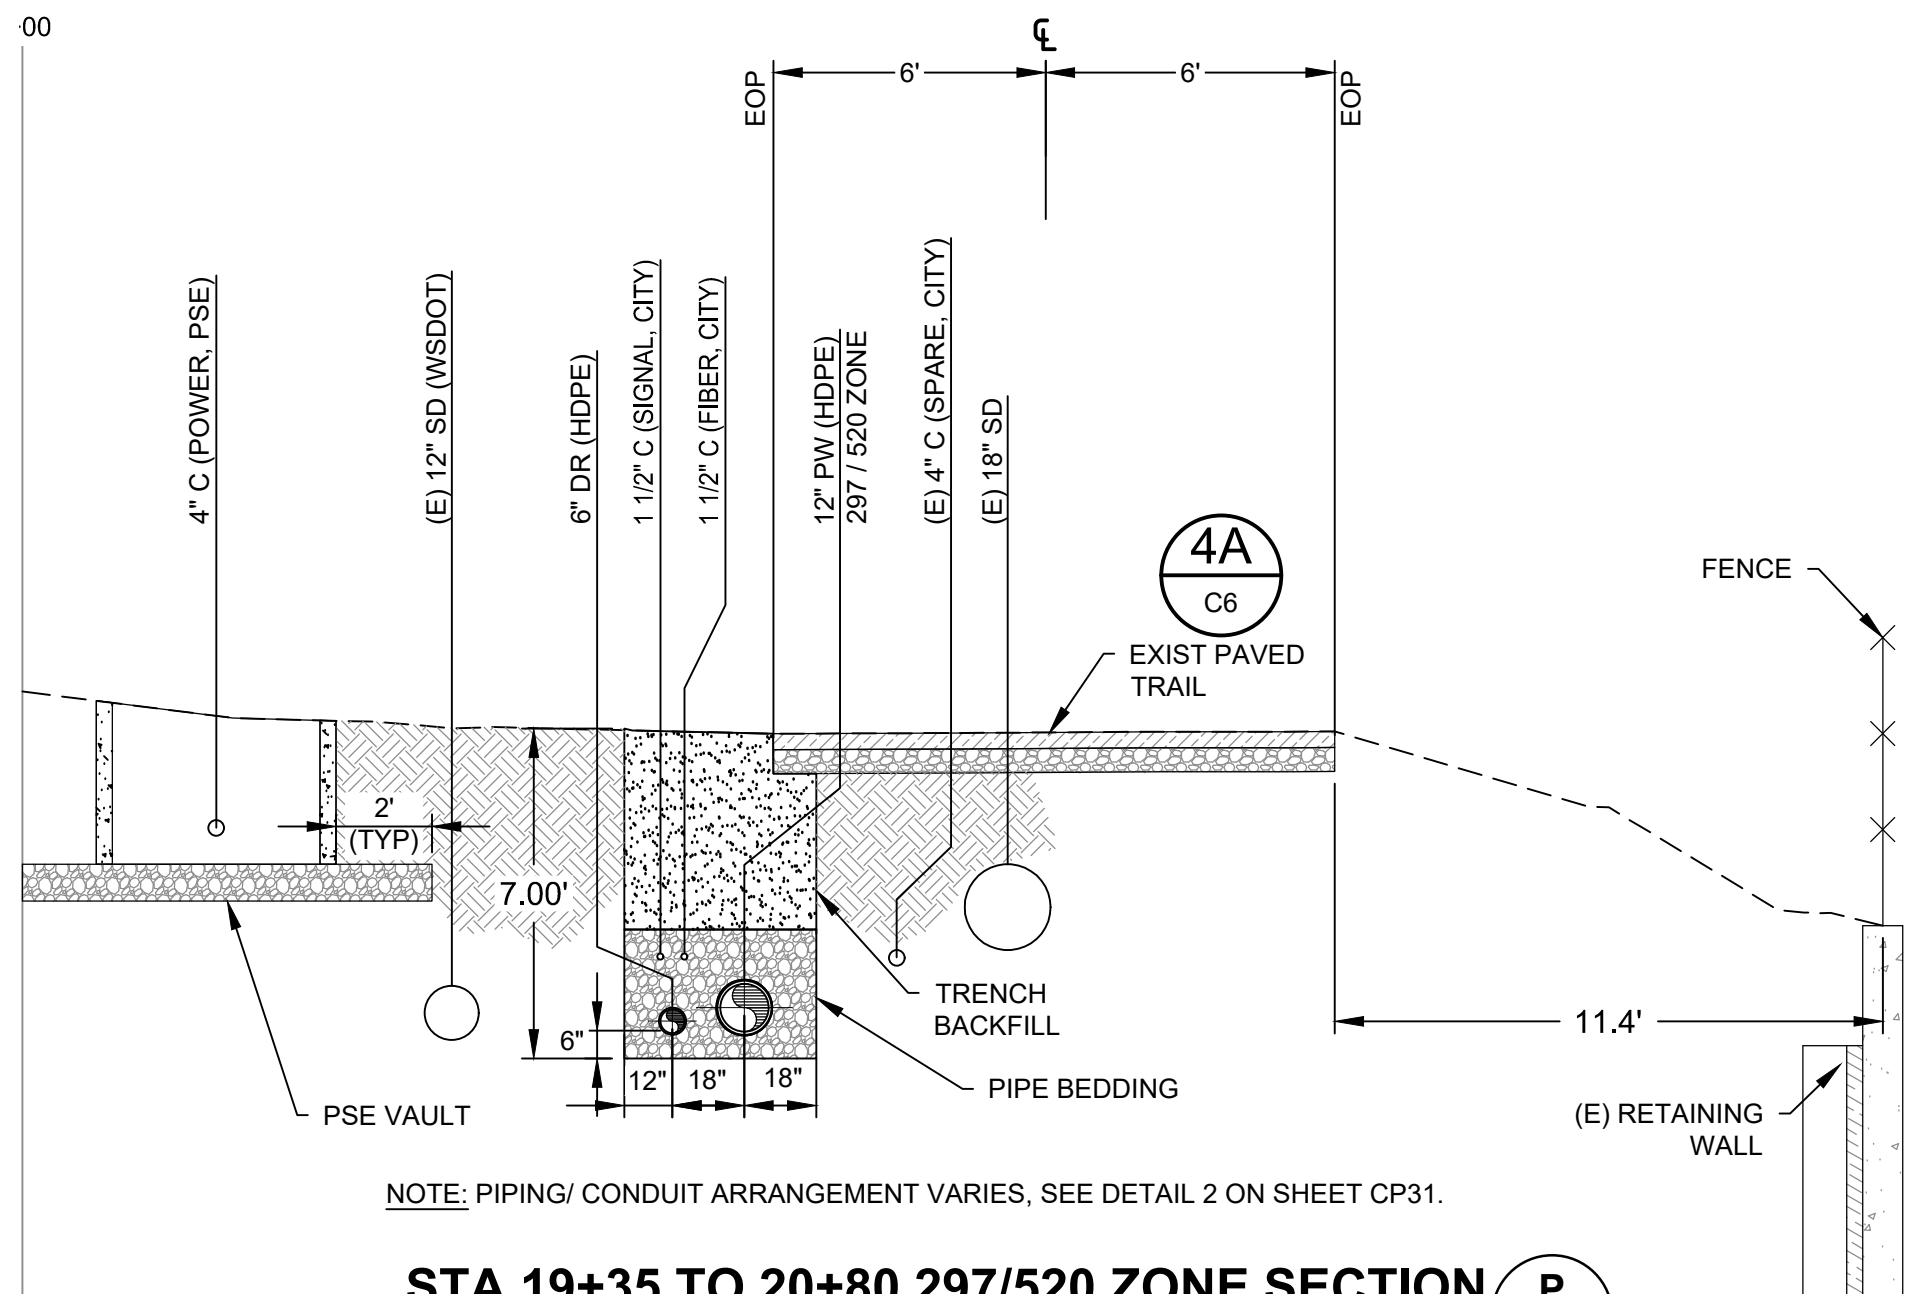


NOTE: PIPING/ CONDUIT ARRANGEMENT VARIES, SEE DETAIL 2 ON SHEET CP31.


STA 19+35 TO 20+80 297/520 ZONE SECTION P
CP2
1"=4'

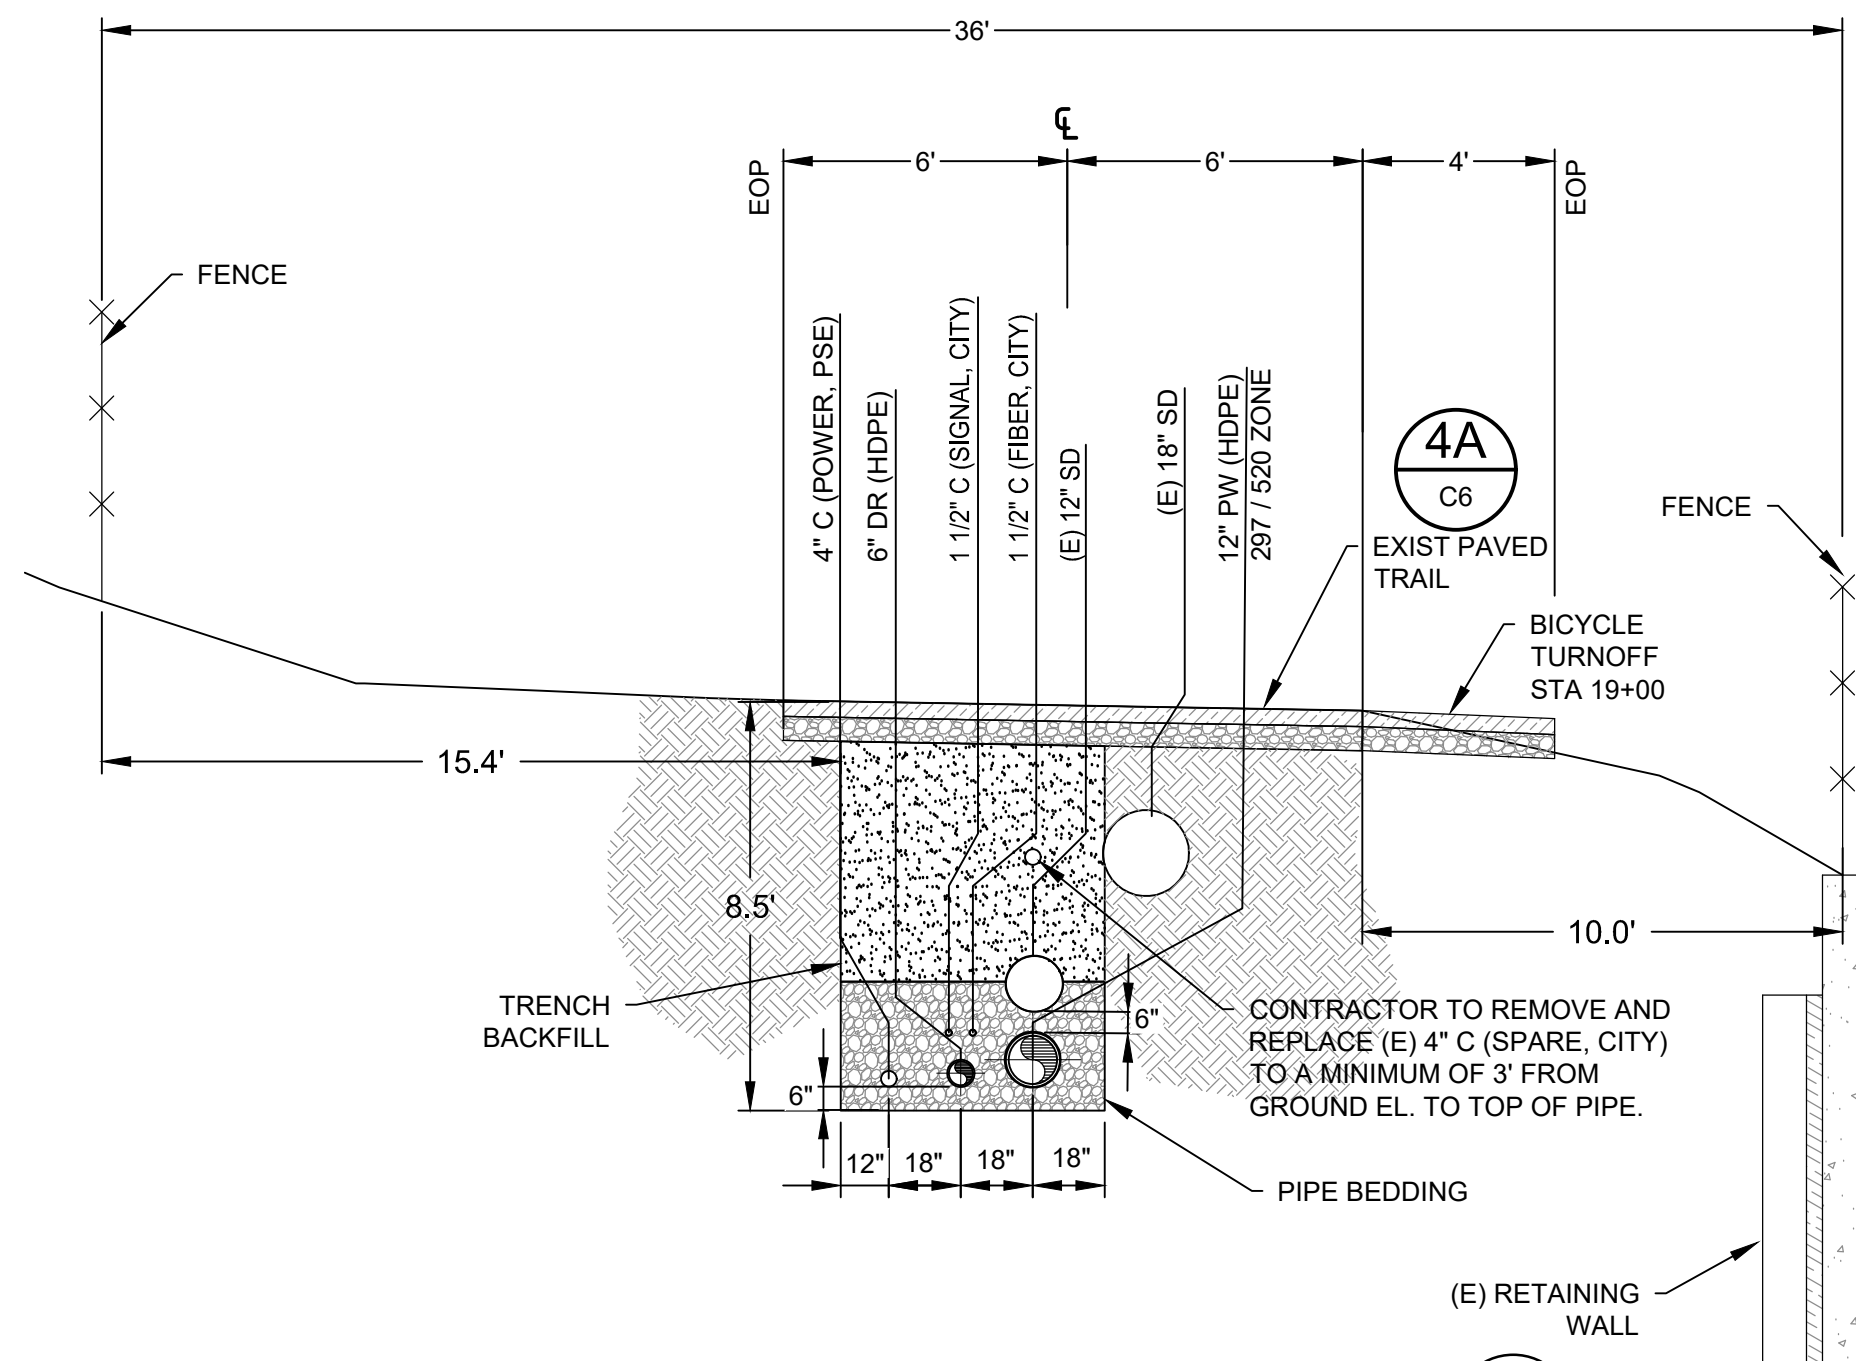

STA 17+08 TO 19+35 297/520 ZONE SECTION O
CP2
1"=4'

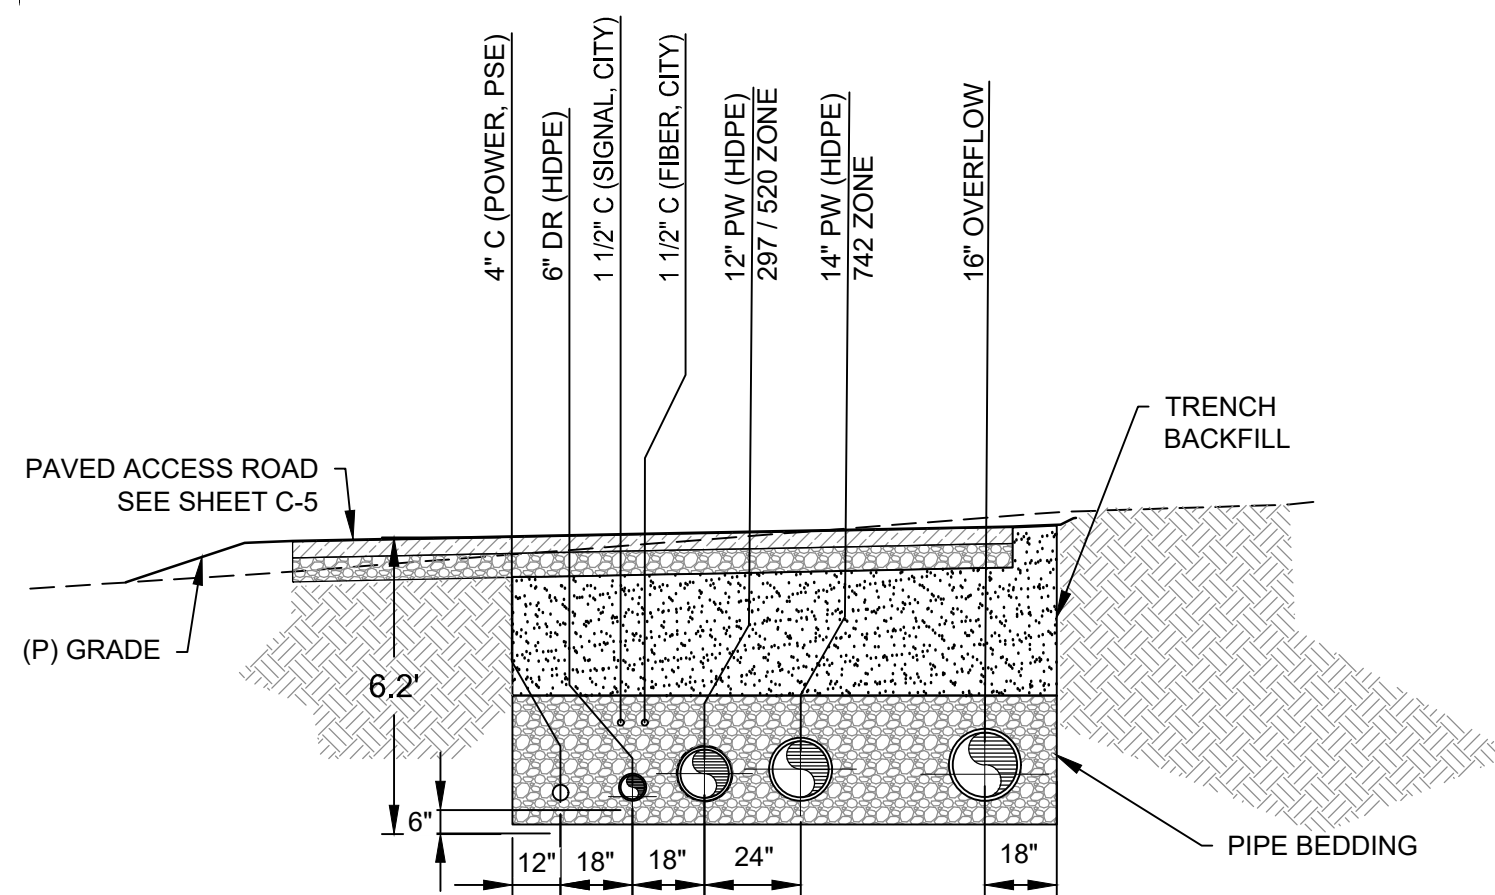

STA 20+80 TO STA 24+00 297/520/742 ZONE SECTION Q
CP3
1"=4'

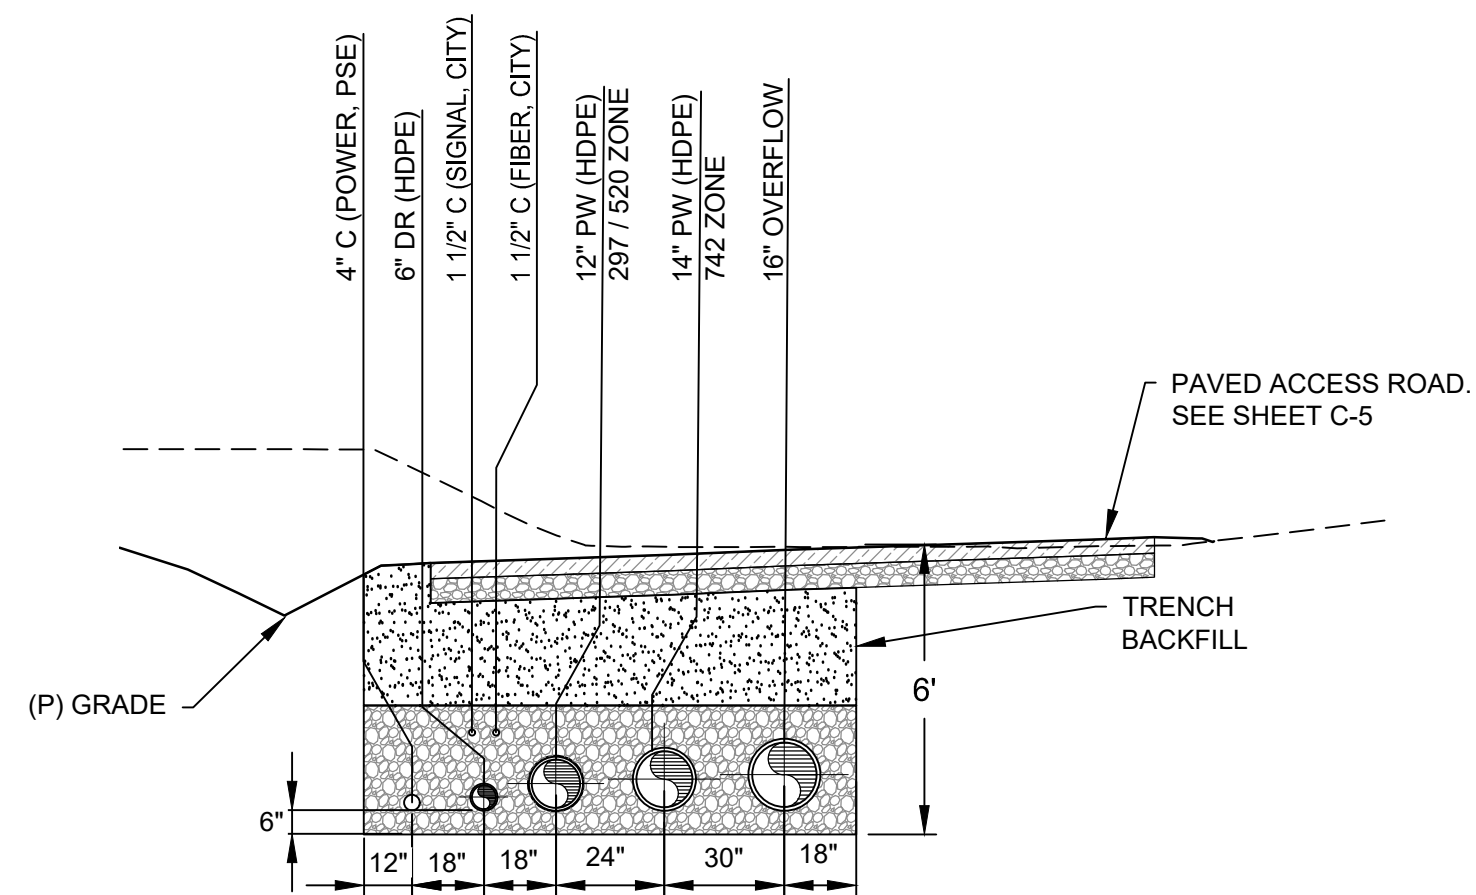

STA 24+00 TO 25+05 297/520/742 ZONE SECTION R
CP3
1"=4'

NOTES:


1. INSTALL LOCATE WIRE PER CITY STANDARD DETAIL W-06.
2. INSTALL PIPE BEDDING AND TRENCH BACKFILL PER WSDOT OPEN CUT DETAIL B-55.20-02 AS SHOWN ON DRAWING G-8, UNLESS OTHERWISE NOTED.
3. CONTRACTOR TO PREPARE SHORING PLAN, PROVIDE SHORING FOR TRENCH DEPTHS GREATER THAN 4'.
4. PROVIDE 4FT X 6FT SURCHARGE AT WALL WHILE TRENCH IS OPEN. SEE GEOTECHNICAL REPORT.

USE OF DOCUMENTS

THIS DOCUMENT, INCLUDING THE INCORPORATED DESIGNS, IS AN INSTRUMENT OF SERVICE FOR THIS PROJECT AND SHALL NOT BE USED FOR ANY OTHER PROJECT WITHOUT THE WRITTEN AUTHORIZATION OF KENNEDY/JENKS CONSULTANTS.

SCALES

0 1" 25mm
IF THIS BAR IS NOT DIMENSION SHOWN, ADJUST SCALES ACCORDINGLY.

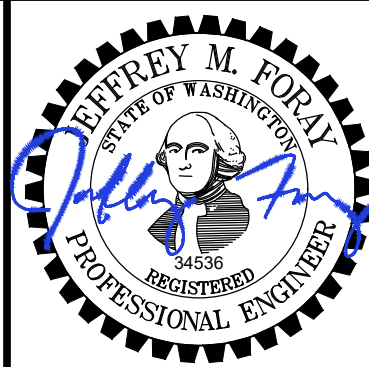

DESIGNED

KSP

DRAWN

RJS

CHECKED

MDL



CITY OF ISSAQUAH
ISSAQUAH, WASHINGTON

SOUTH SPAR BOOSTER PUMP STATION



Kennedy/Jenks Consultants
FEDERAL WAY, WASHINGTON

PIPELINE SECTIONS - 4

90% SUBMITTAL (REVISED 11/30/2020)

FILE NAME
139700500-CP023.DWG
JOB NO.
139700500
DATE
NOVEMBER 2020
SHEET
OF
CP23

\\jc.local\KUC-Roof\K-Office\FWY\CAD\CAD131\397005.00_City_of_Issaquah\139700500-CP024.dwg 12/10/2020 8:41 AM NICOLASLOZANORDONEZ

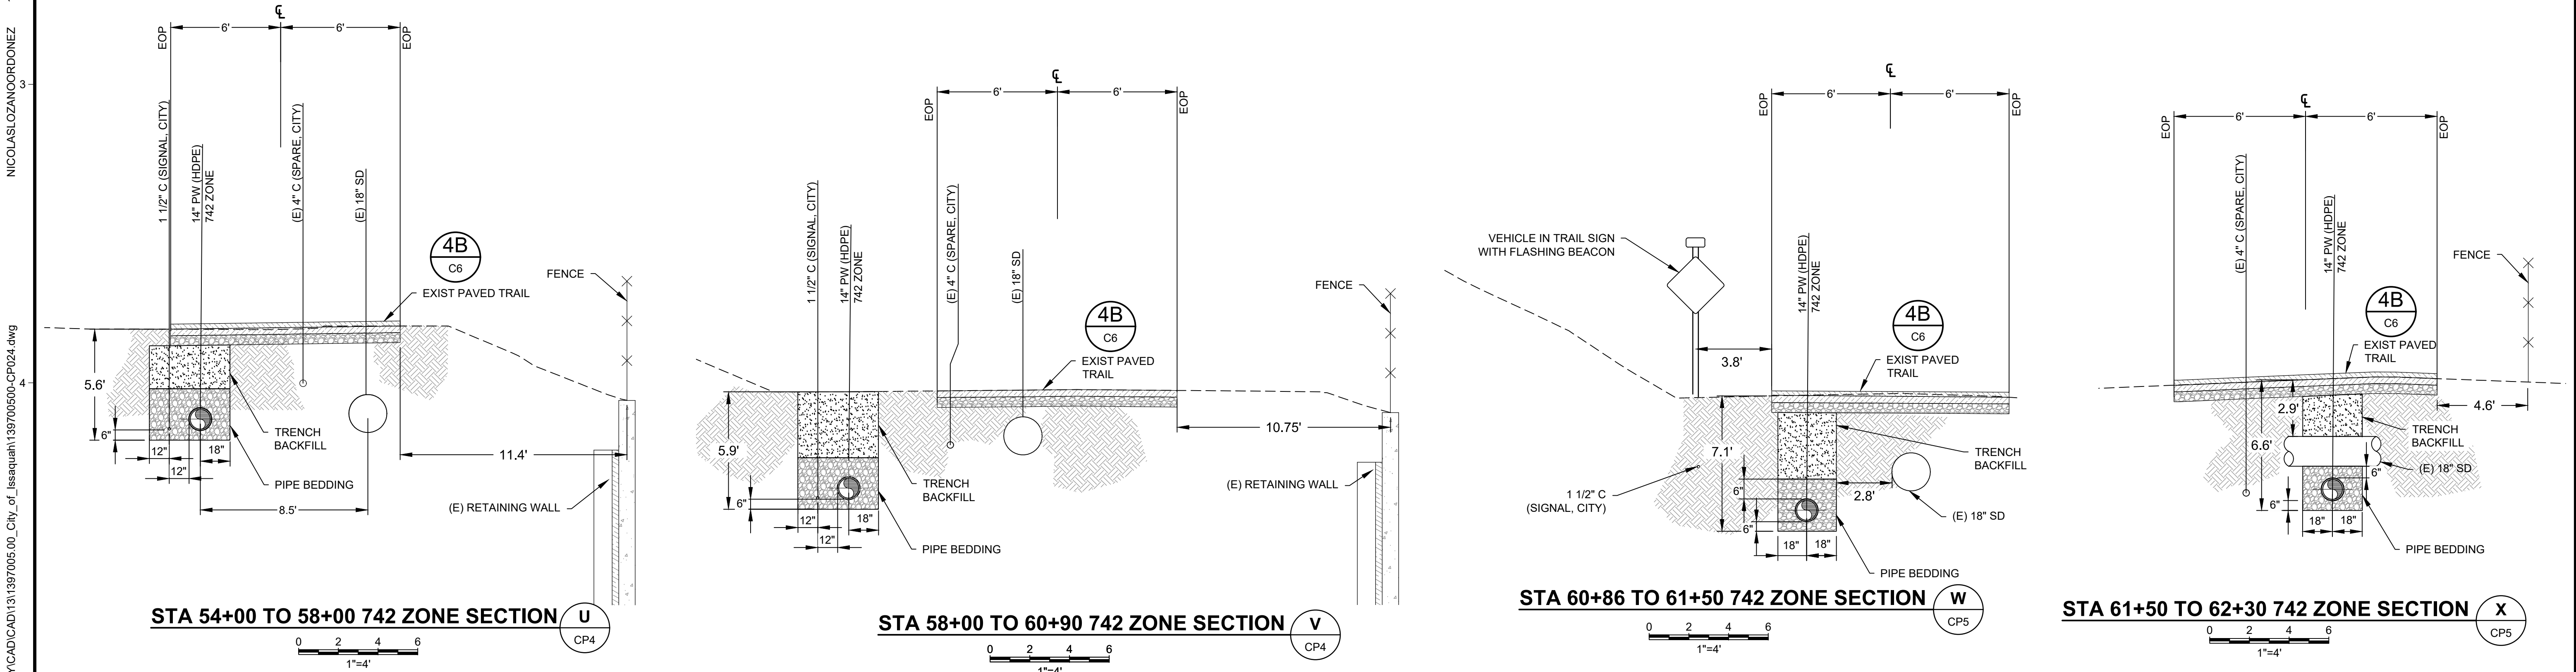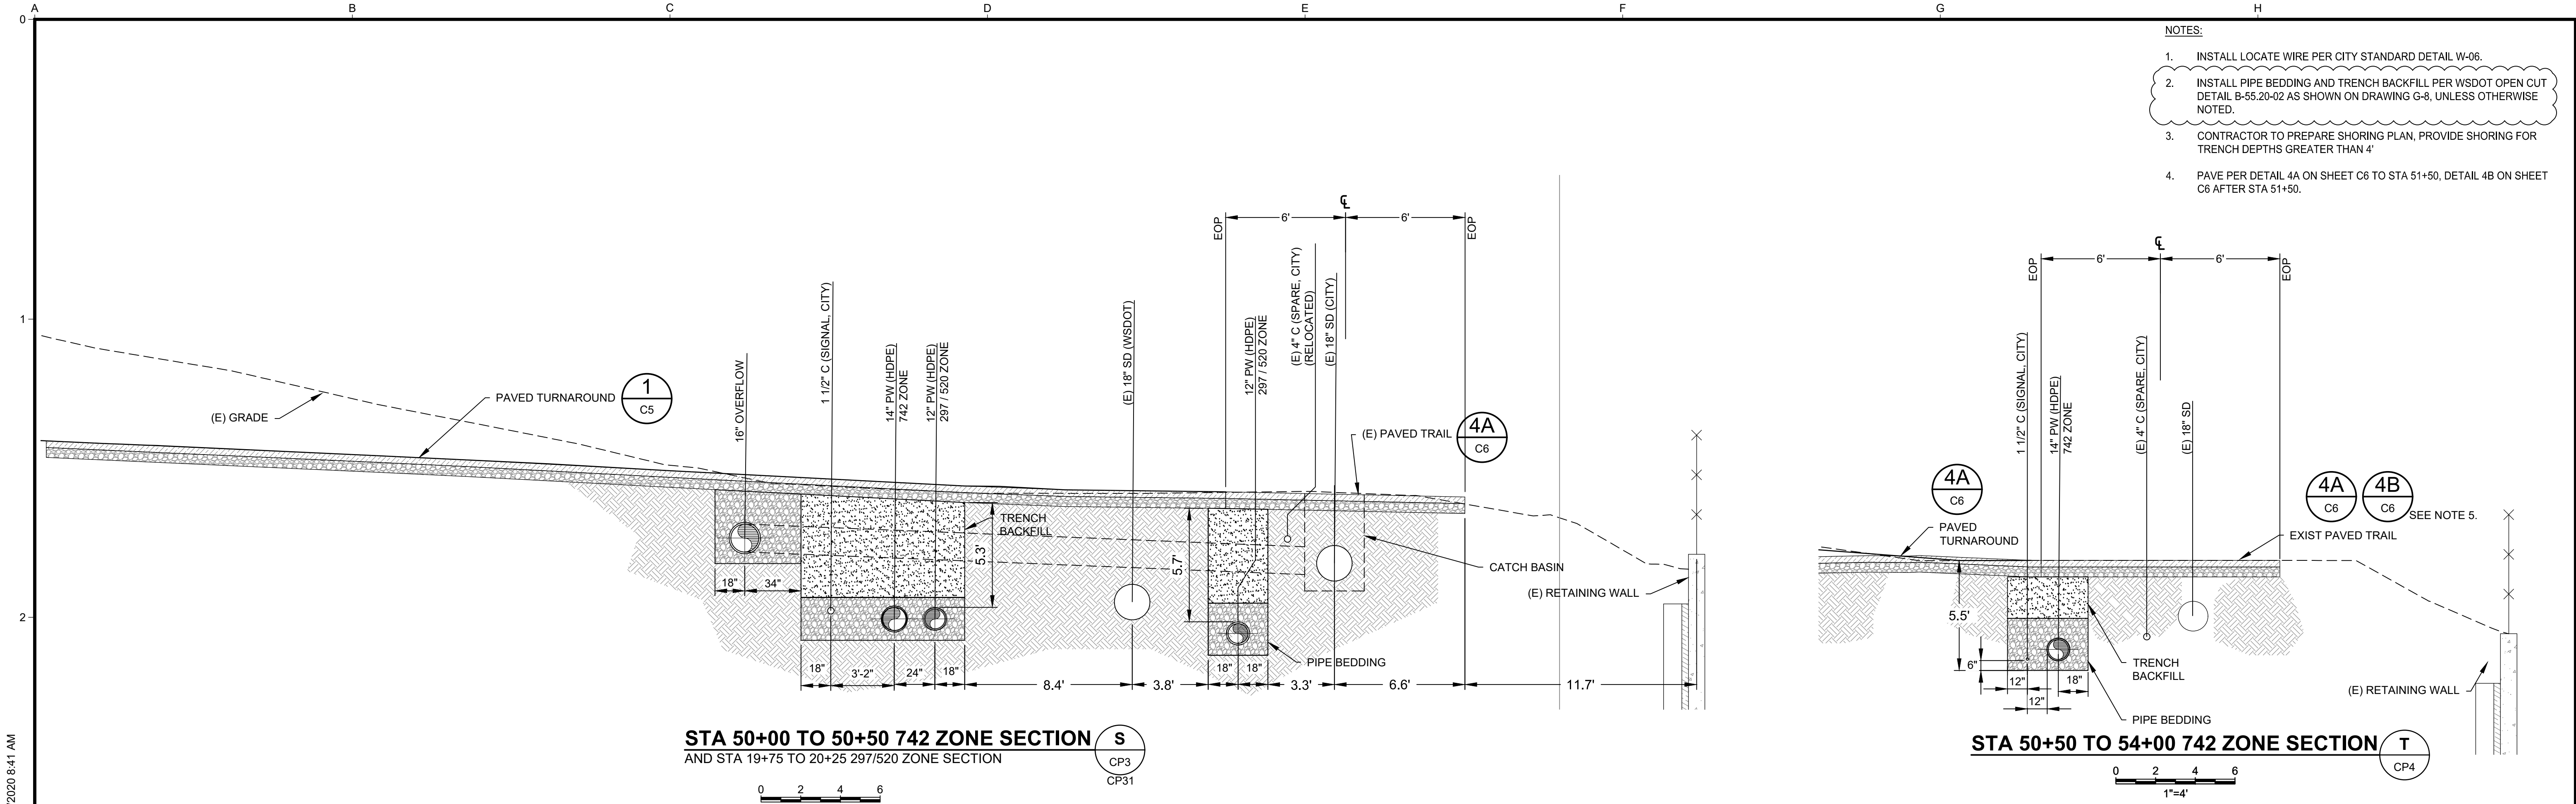

USE OF DOCUMENTS

THIS DOCUMENT, INCLUDING THE INCORPORATED DESIGNS, IS AN INSTRUMENT OF SERVICE FOR THIS PROJECT AND SHALL NOT BE USED FOR ANY OTHER PROJECT WITHOUT THE WRITTEN AUTHORIZATION OF KENNEDY/JENKS CONSULTANTS.

NO.	REVISION	DATE	BY

SCALES

0 1" 25mm

IF THIS BAR IS NOT DIMENSION SHOWN, ADJUST SCALES ACCORDINGLY.



DESIGNED

KSP

DRAWN

RJS

CHECKED

MDL



CITY OF ISSAQUAH
ISSAQUAH, WASHINGTON
SOUTH SPAR BOOSTER PUMP STATION


Kennedy/Jenks Consultants
FEDERAL WAY, WASHINGTON

PIPELINE SECTIONS - 5


90% SUBMITTAL (REVISED 11/30/2020)

FILE NAME
139700500-CP024.DWG
JOB NO.
1397005'00
DATE
NOVEMBER 2020
SHEET
OF
CP24


12/10/2020 9:38 AM
NICOLASLOZANORDONEZ
\\jc.local\KUC-Roof\K-Office\FWY\CAD\CAD13\1397005.00_City_of_Issaquah\139700500-CP025.dwg

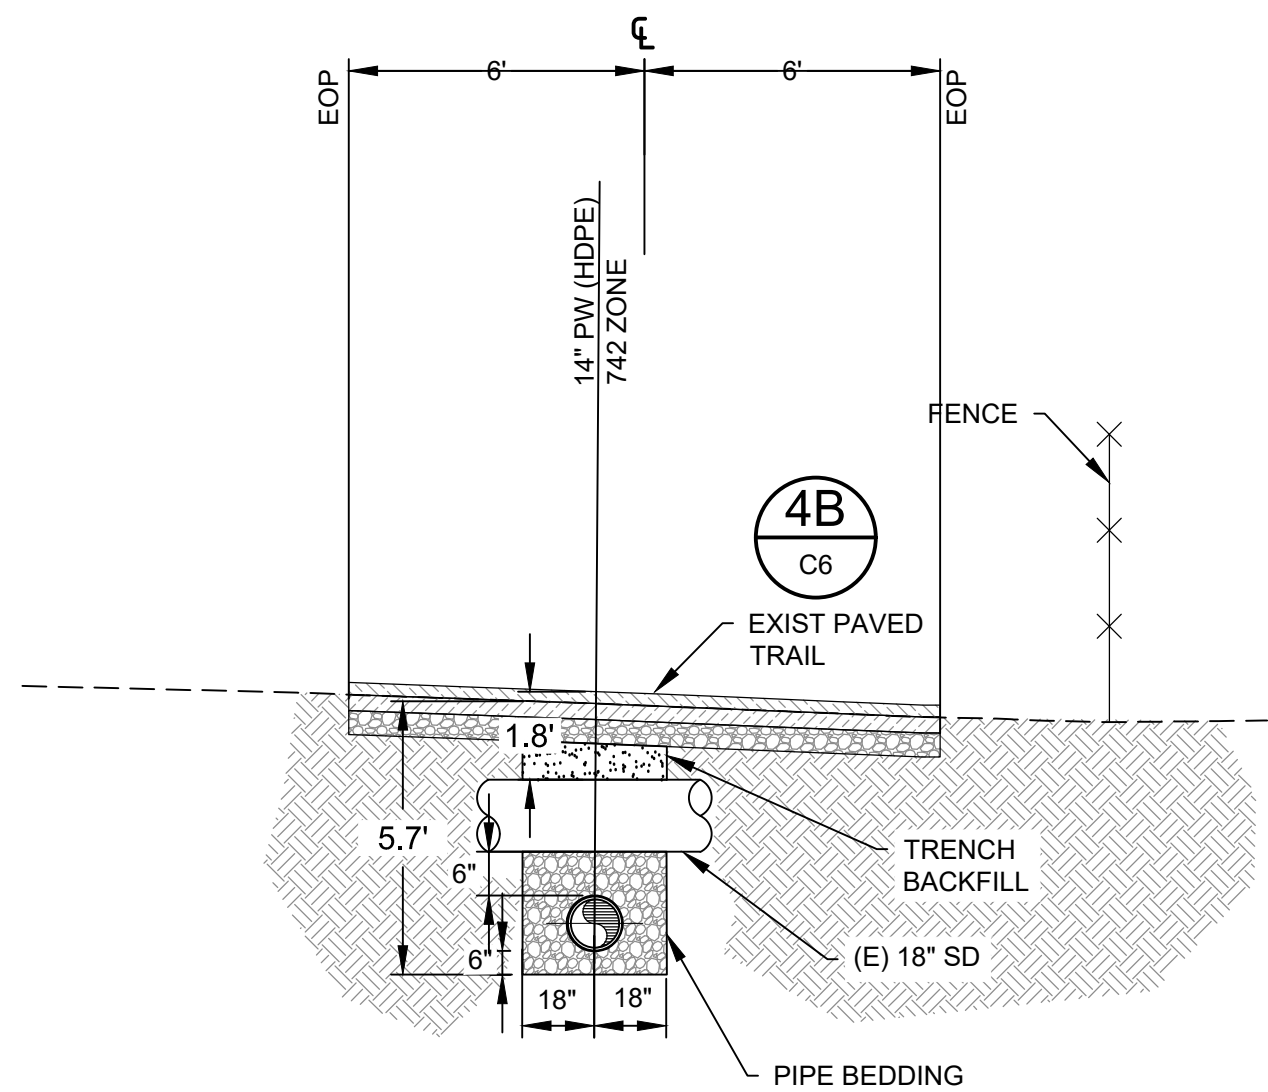


STA 62+30 TO 64+60 742 ZONE SECTION Y
CP5
1"=4'

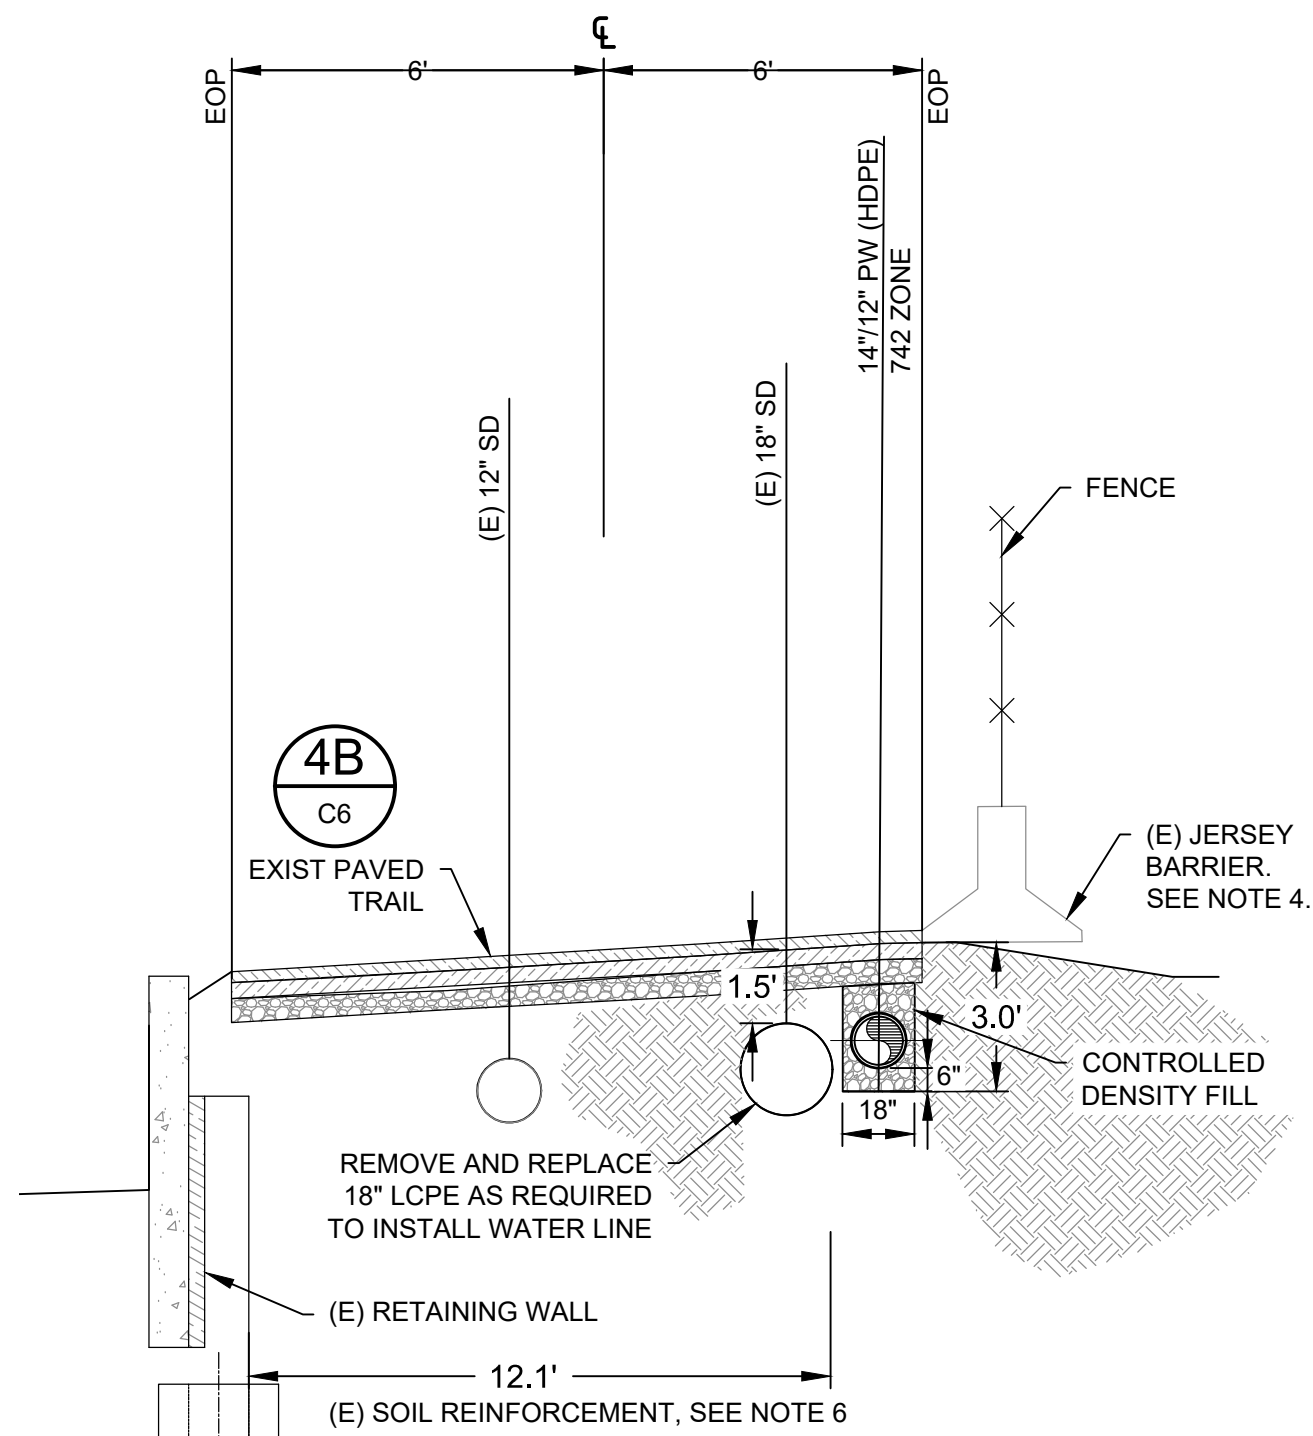


STA 64+60 TO 66+10 742 ZONE SECTION Z
CP5
1"=4'

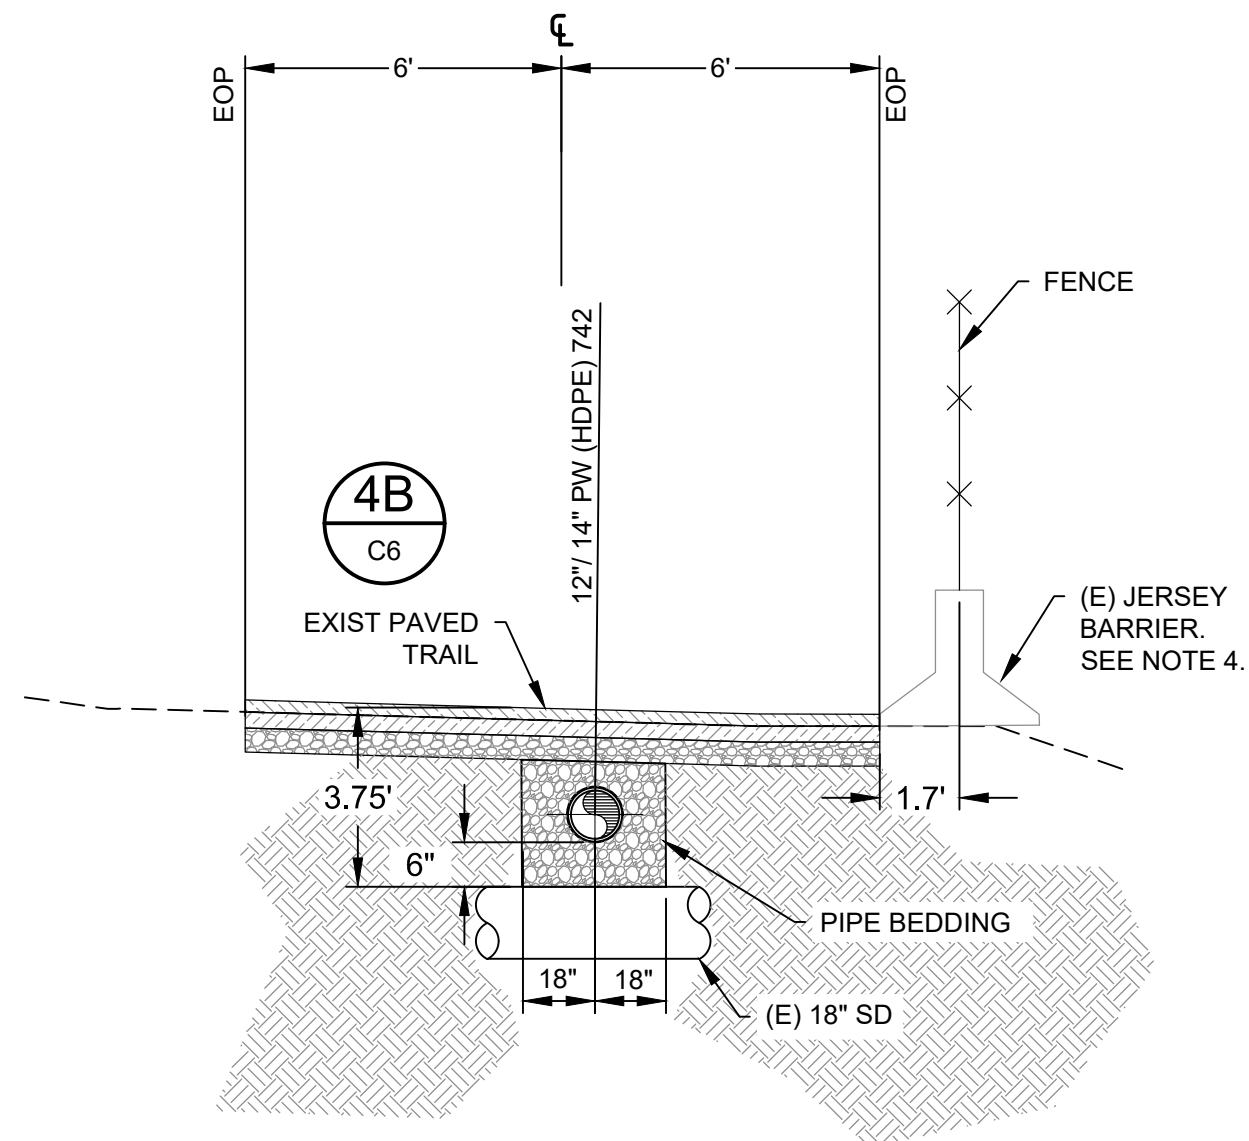


STA 66+60 TO 69+50 742 ZONE SECTION AA
CP5
1"=4'

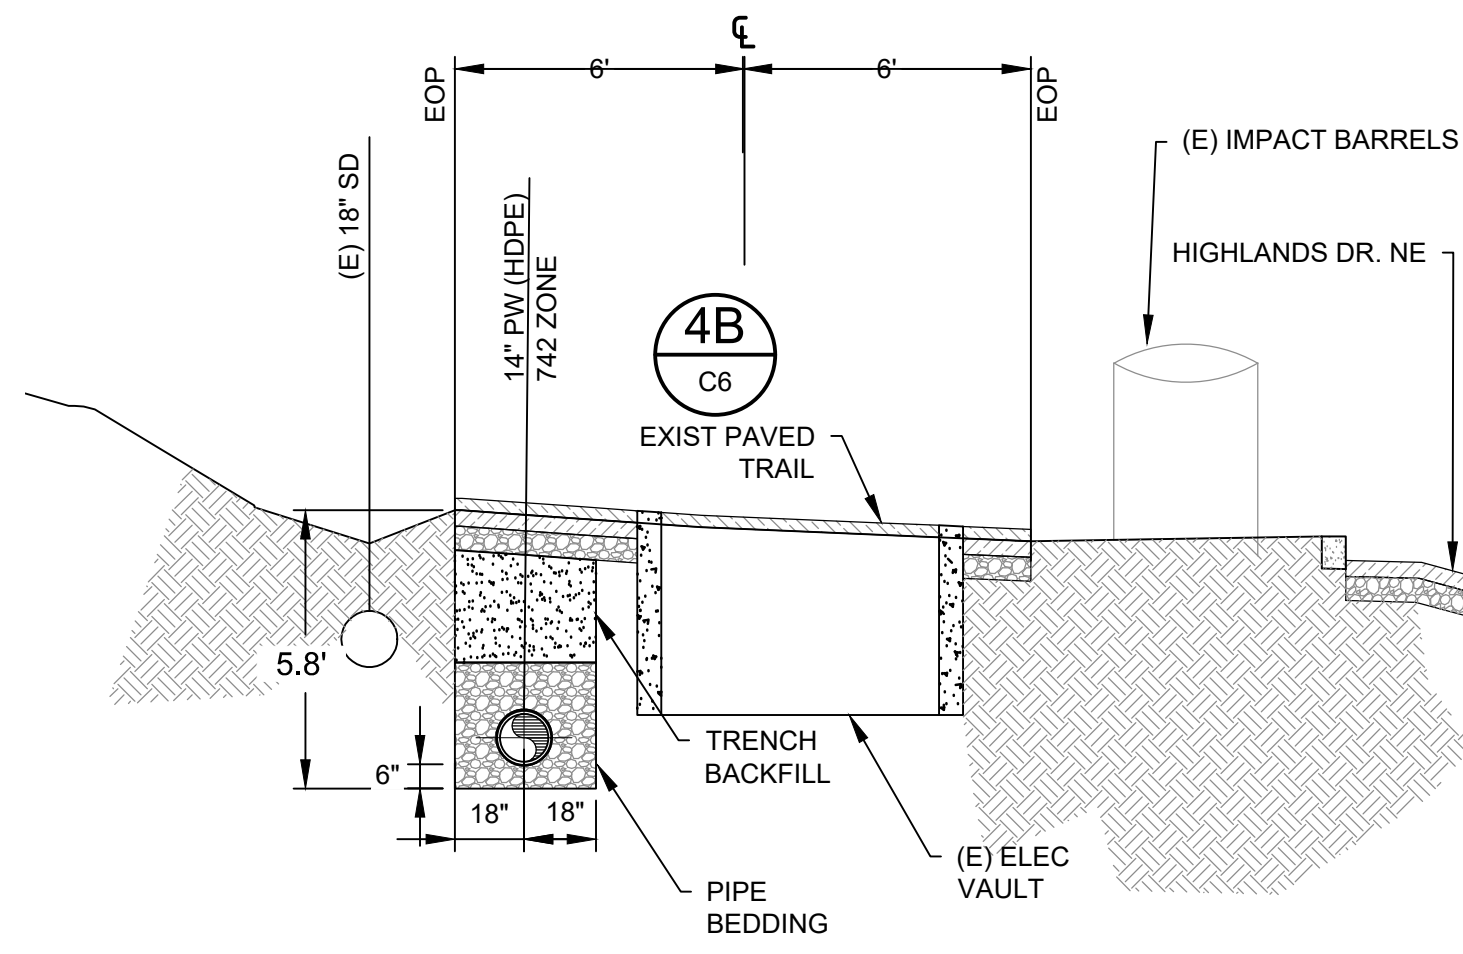


STA 69+50 TO 73+75 742 ZONE SECTION BB
CP6
1"=4'

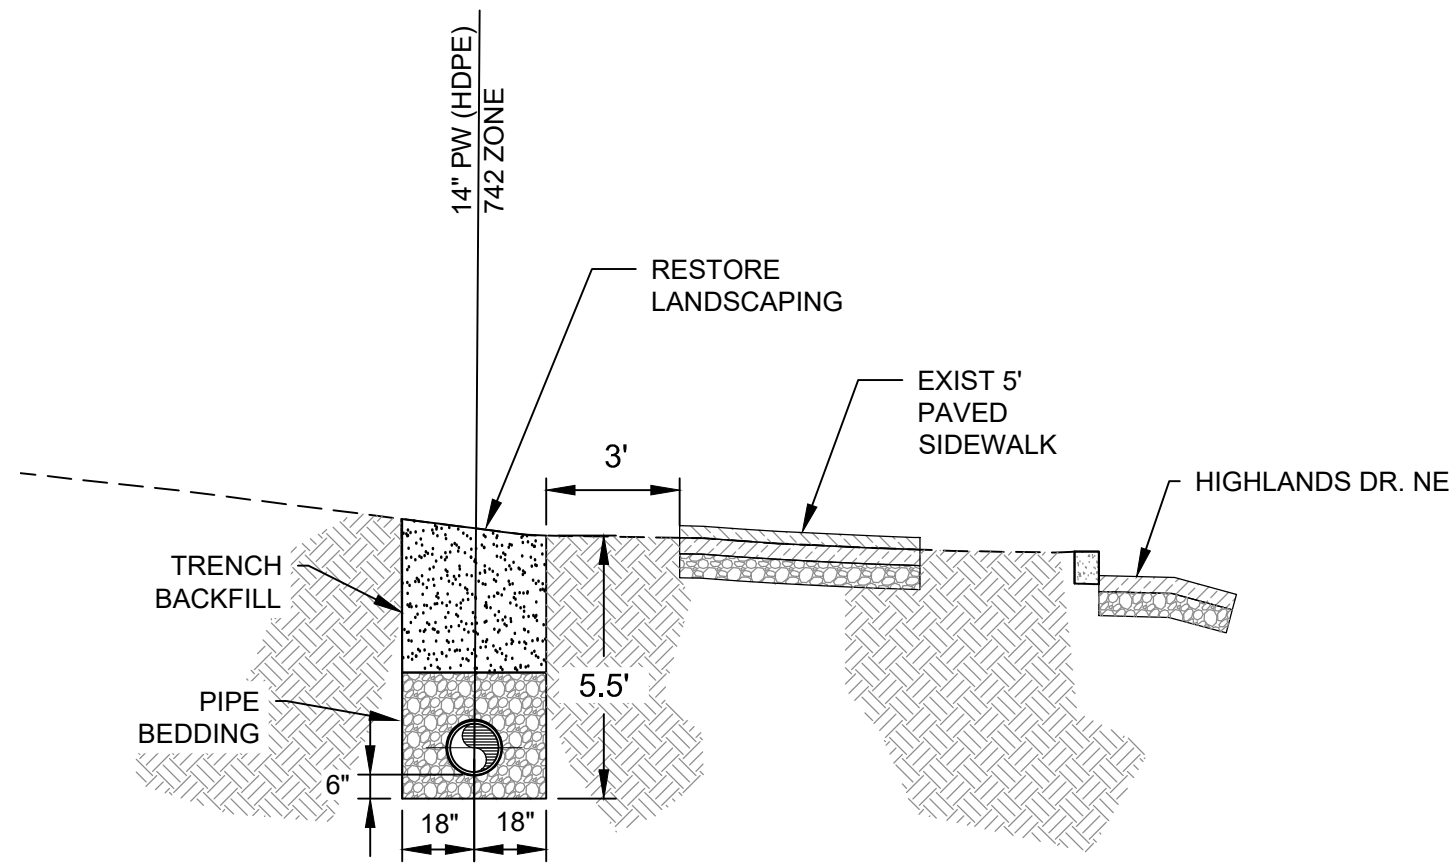


STA 73+75 TO 77+70 742 ZONE SECTION CC
CP6
1"=4'

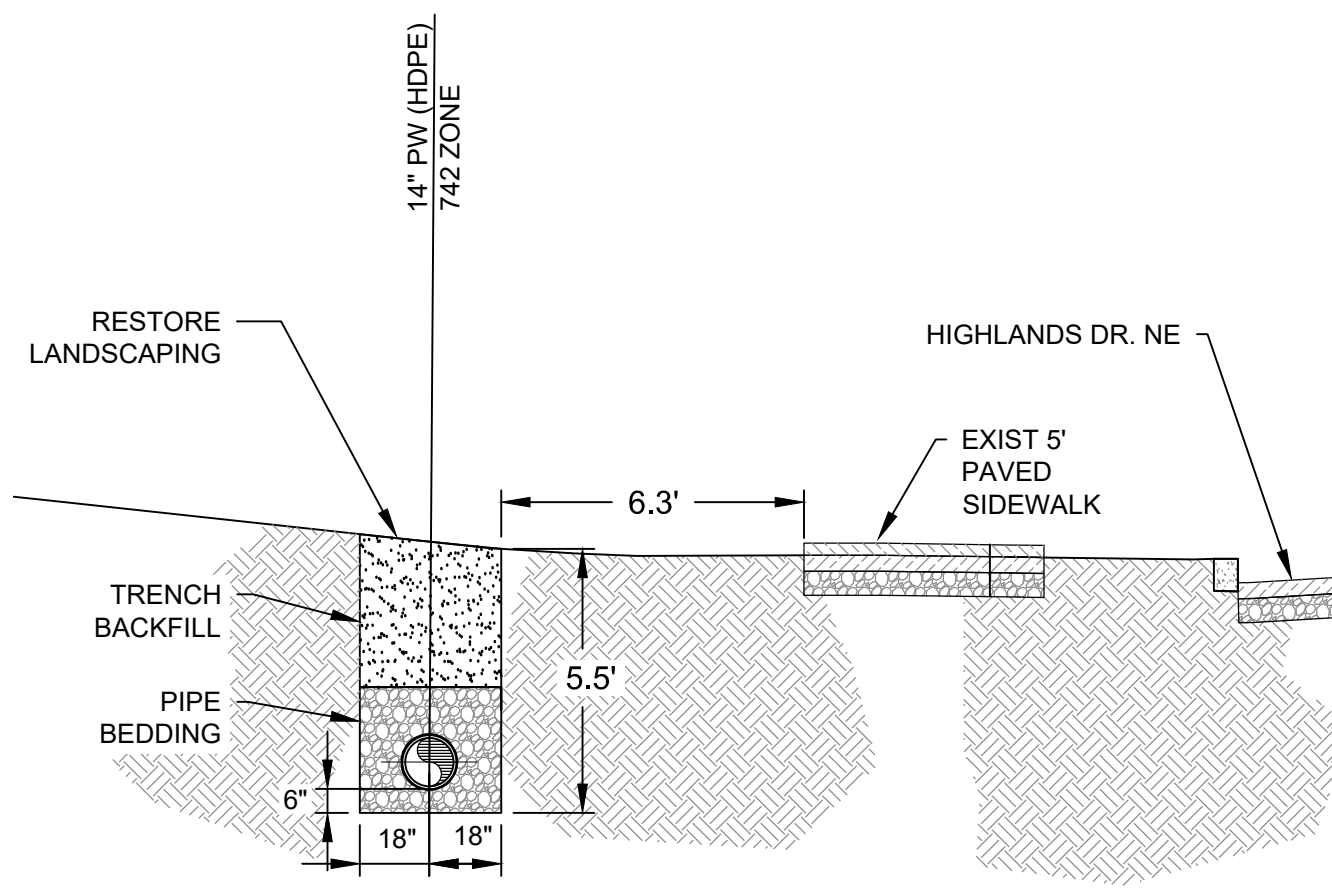

STA 77+70 TO 82+00 742 ZONE SECTION DD
CP7
1"=4'

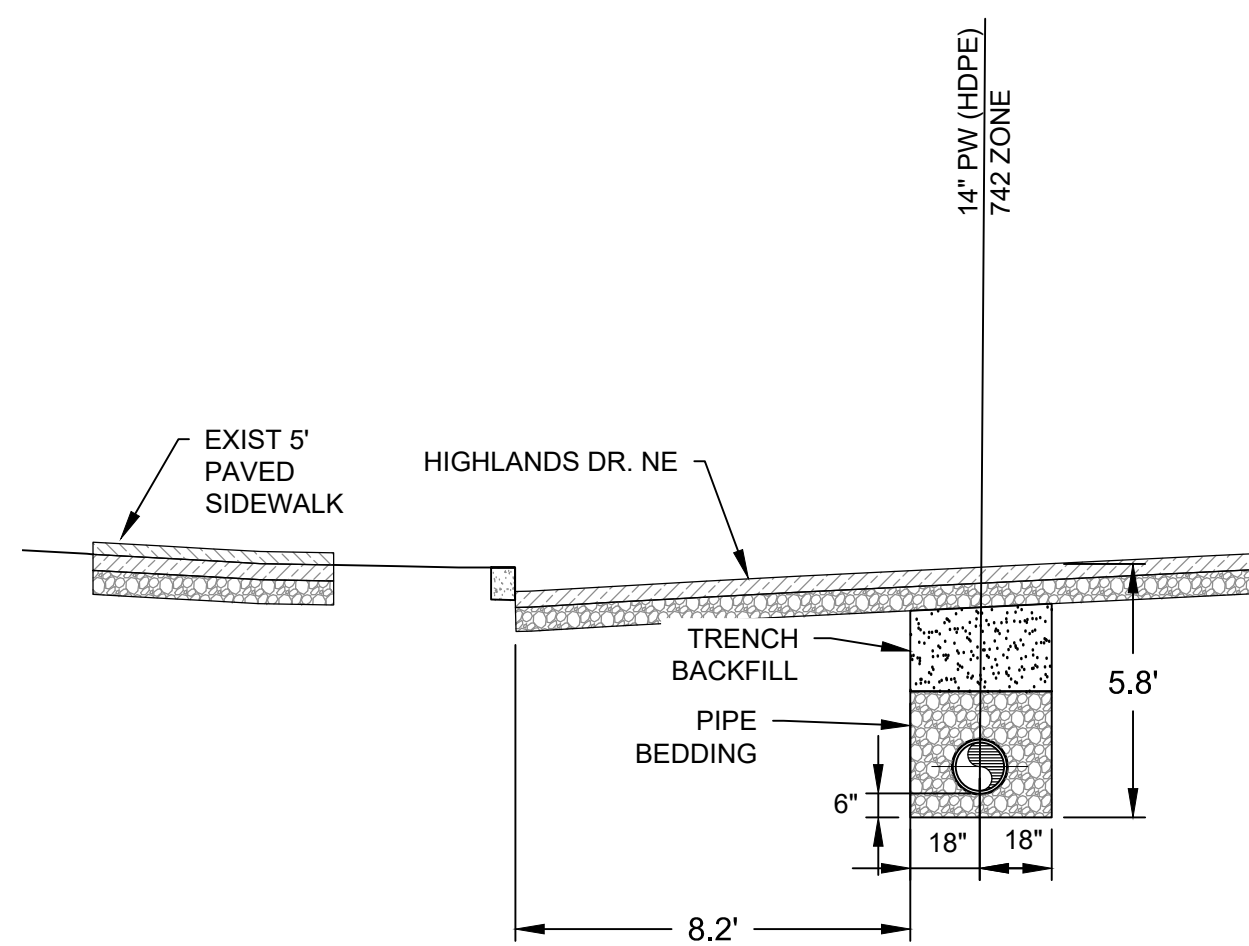

STA 77+70 TO 82+00 742 ZONE SECTION EE
CP7
1"=4'

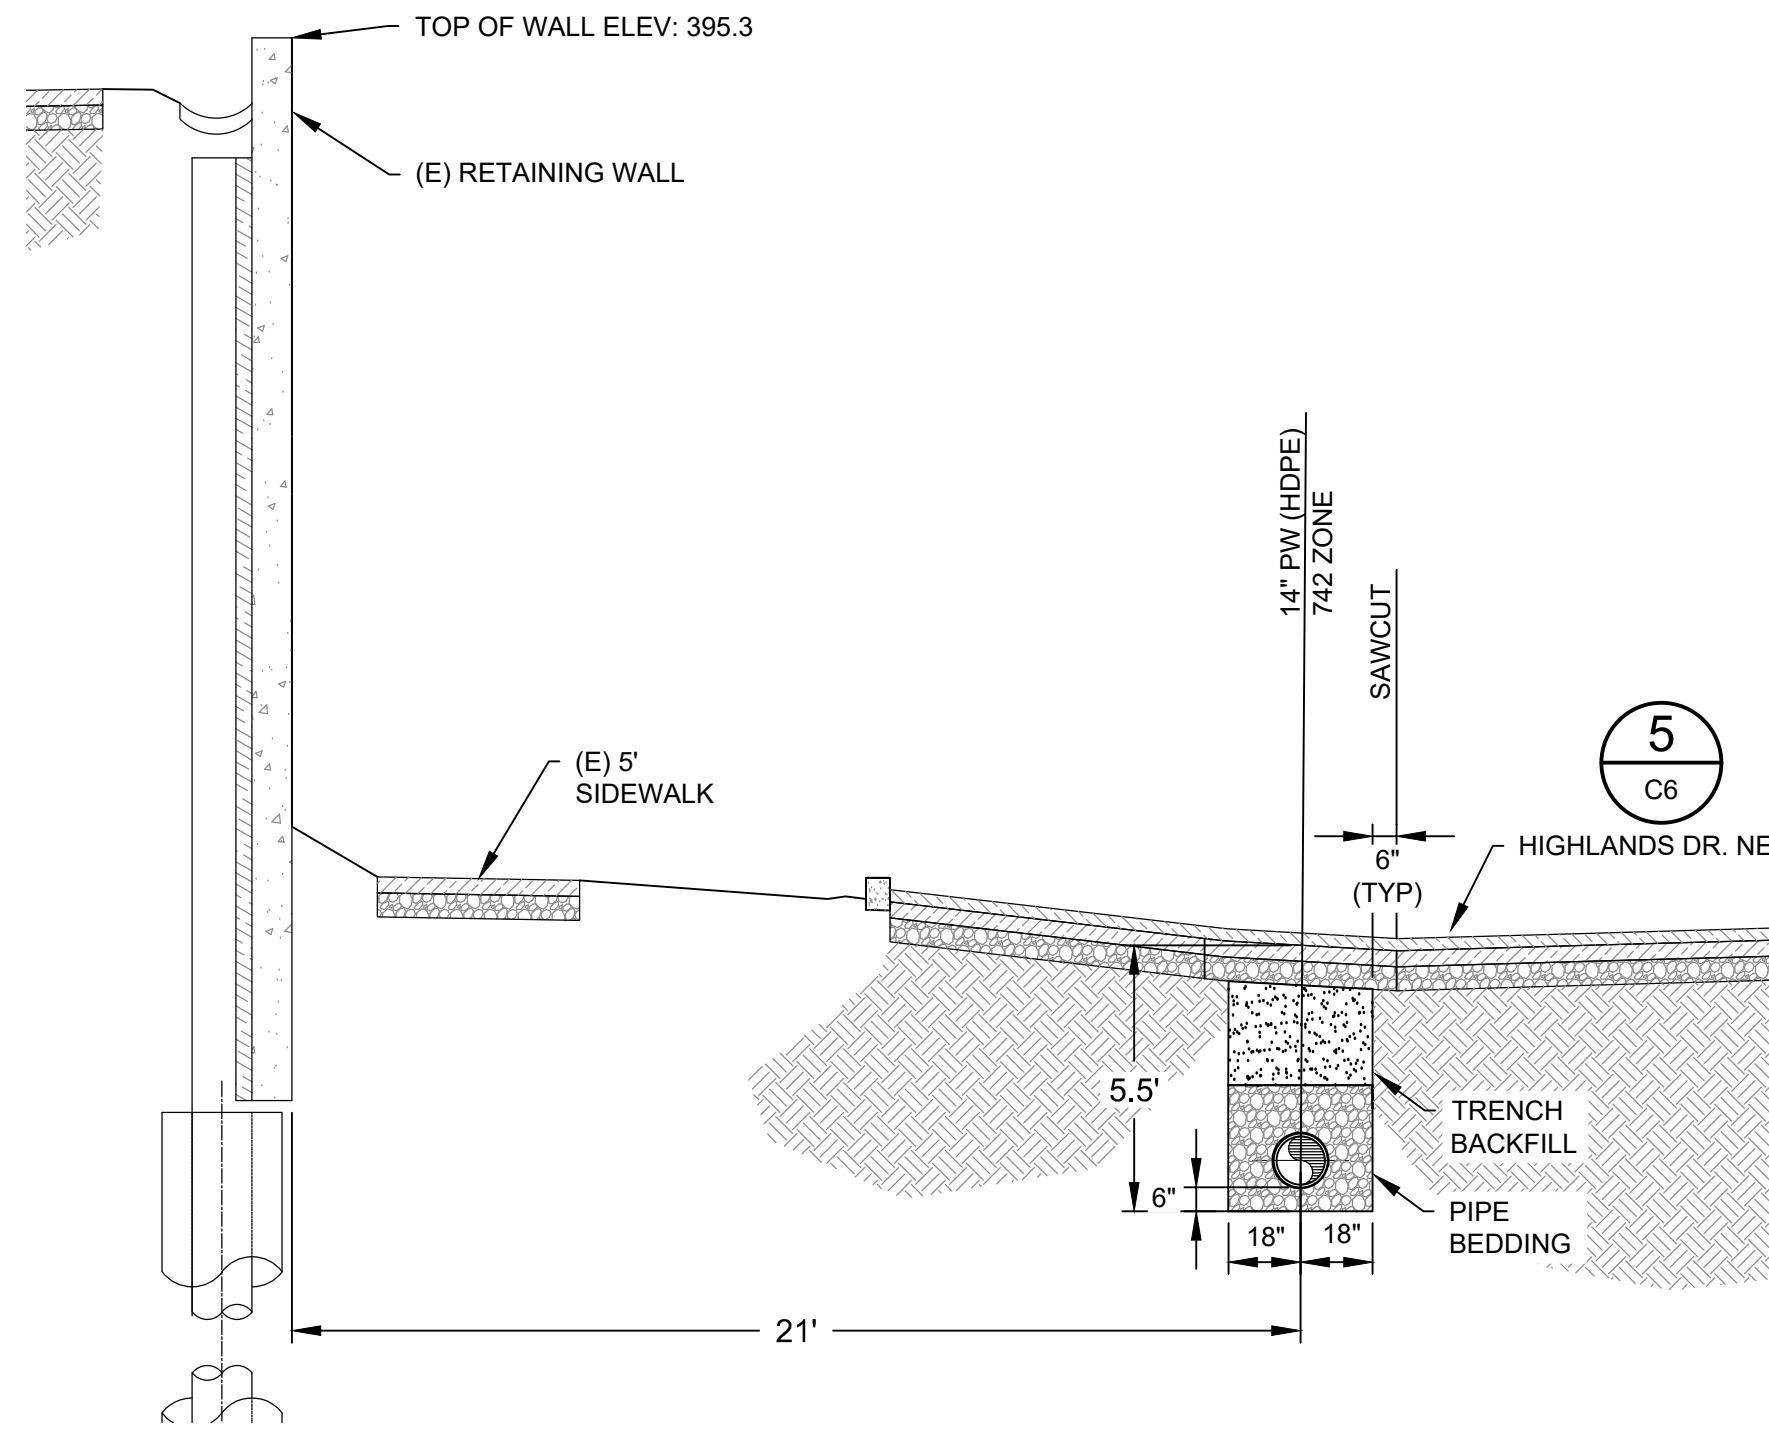

STA 82+00 TO 86+00 742 ZONE SECTION FF
CP7
1"=4'

NOTES:

1. INSTALL LOCATE WIRE PER CITY STANDARD DETAIL W-06.
2. INSTALL PIPE BEDDING AND TRENCH BACKFILL PER WSDOT OPEN CUT DETAIL B-55-20-02 AS SHOWN ON DRAWING G-8, UNLESS OTHERWISE NOTED.
3. CONTRACTOR TO PREPARE SHORING PLAN, PROVIDE SHORING FOR TRENCH DEPTHS GREATER THAN 4'.
4. RESET TRAFFIC BARRIERS FOR CONSTRUCTION PER TRAFFIC CONTROL PLAN, STA 62+80 TO 66+47.
5. SOIL REINFORCEMENT (GEOGRID) IS PRESENT IN THIS AREA. CUTTING OF GEOGRID IS PROHIBITED.

USE OF DOCUMENTS

THIS DOCUMENT, INCLUDING THE INCORPORATED DESIGNS, IS AN INSTRUMENT OF SERVICE FOR THIS PROJECT AND SHALL NOT BE USED FOR ANY OTHER PROJECT WITHOUT THE WRITTEN AUTHORIZATION OF KENNEDY/JENKS CONSULTANTS.

NO. REVISION DATE BY

SCALES
1"=25mm
IF THIS BAR IS NOT DIMENSION SHOWN, ADJUST SCALES ACCORDINGLY.



DESIGNED KSP
DRAWN RJS
CHECKED MDL






CITY OF ISSAQUAH
ISSAQUAH, WASHINGTON
SOUTH SPAR BOOSTER PUMP STATION

Kennedy/Jenks Consultants
FEDERAL WAY, WASHINGTON


PIPELINE SECTIONS - 6

90% SUBMITTAL (REVISED 11/30/2020)


FILE NAME
139700500-CP025.DWG
JOB NO.
1397005*00
DATE
NOVEMBER 2020
SHEET OF
CP25

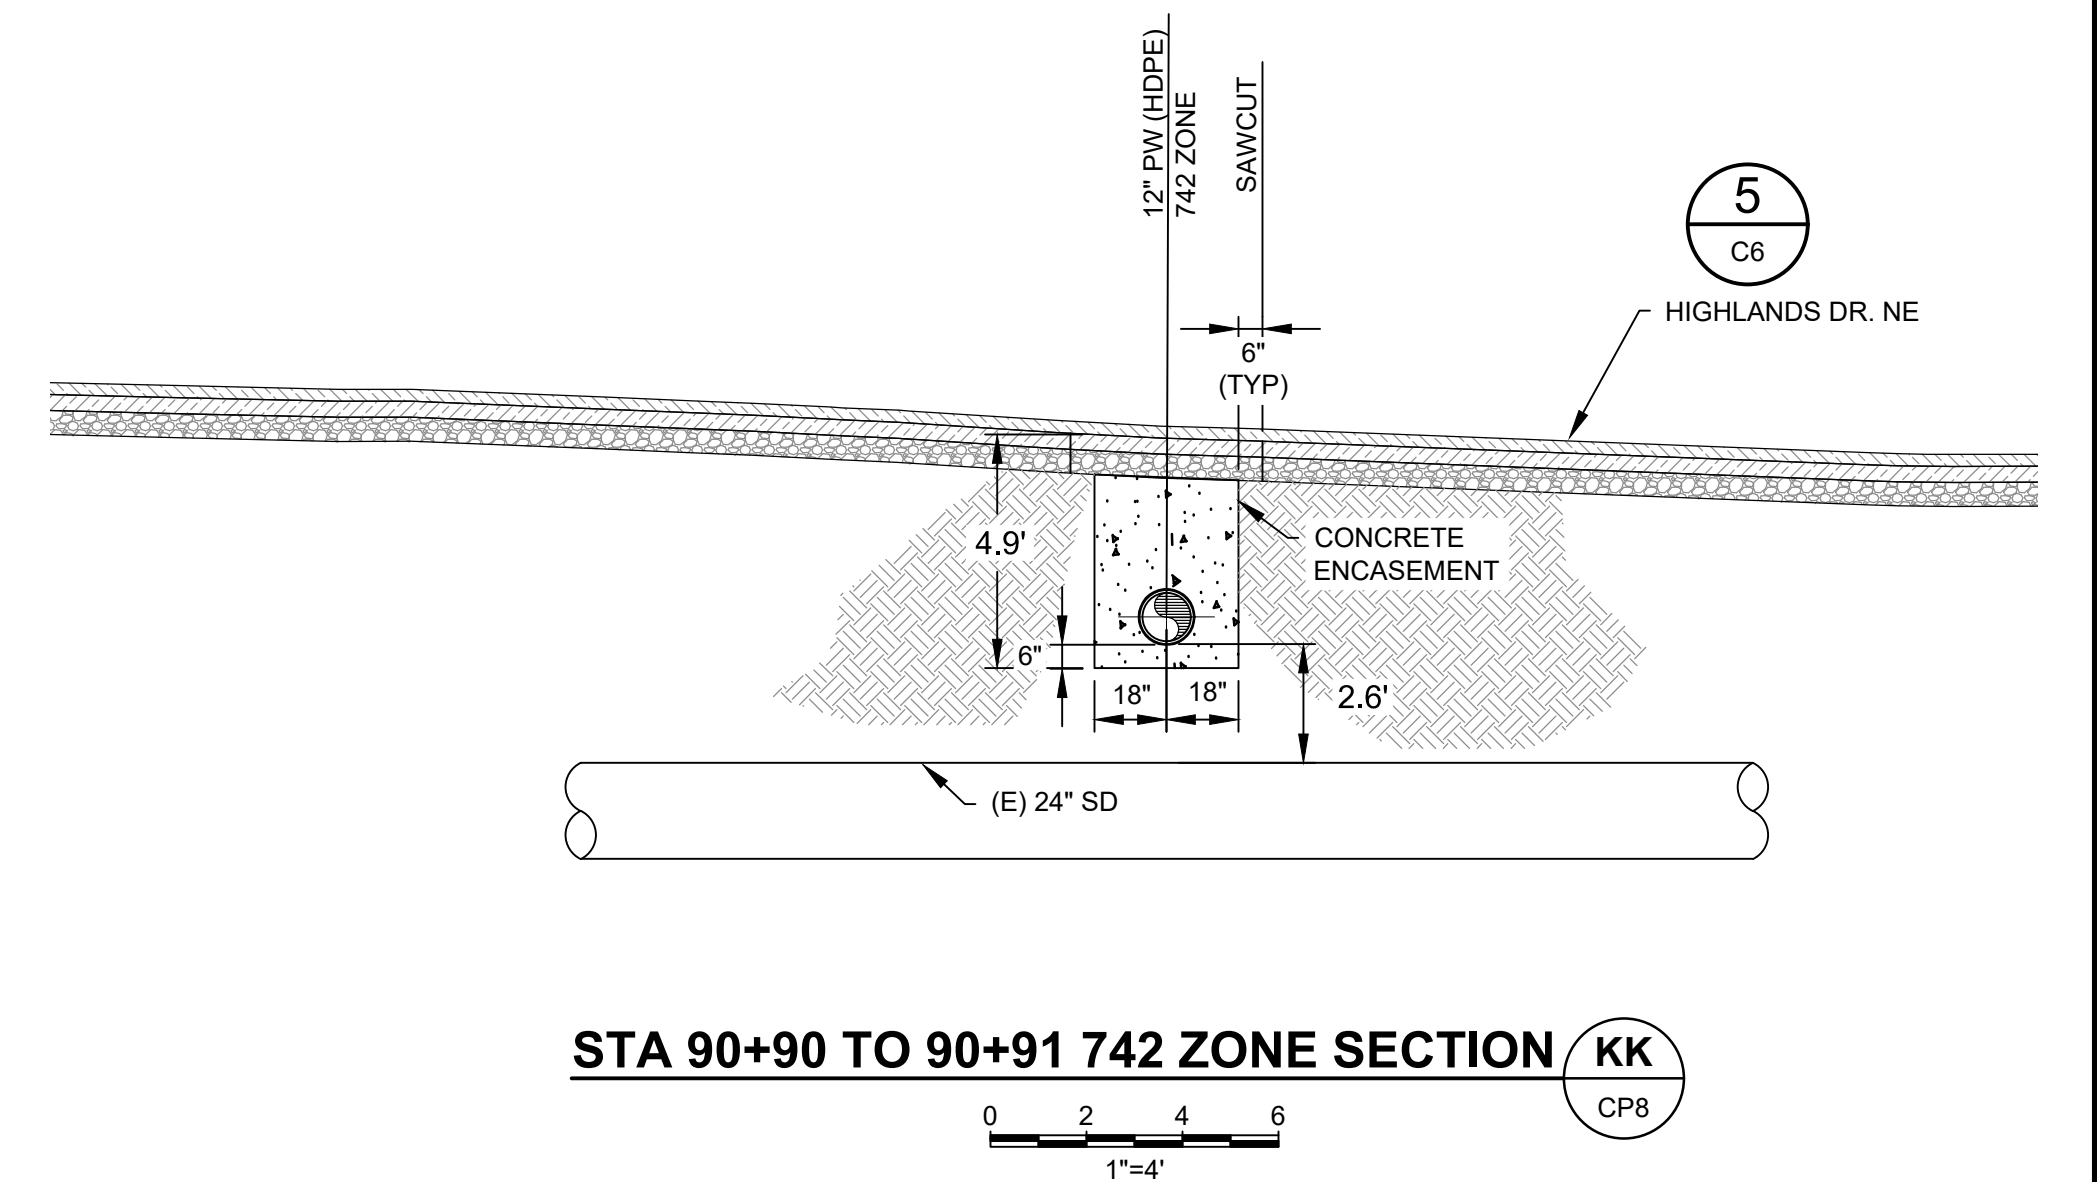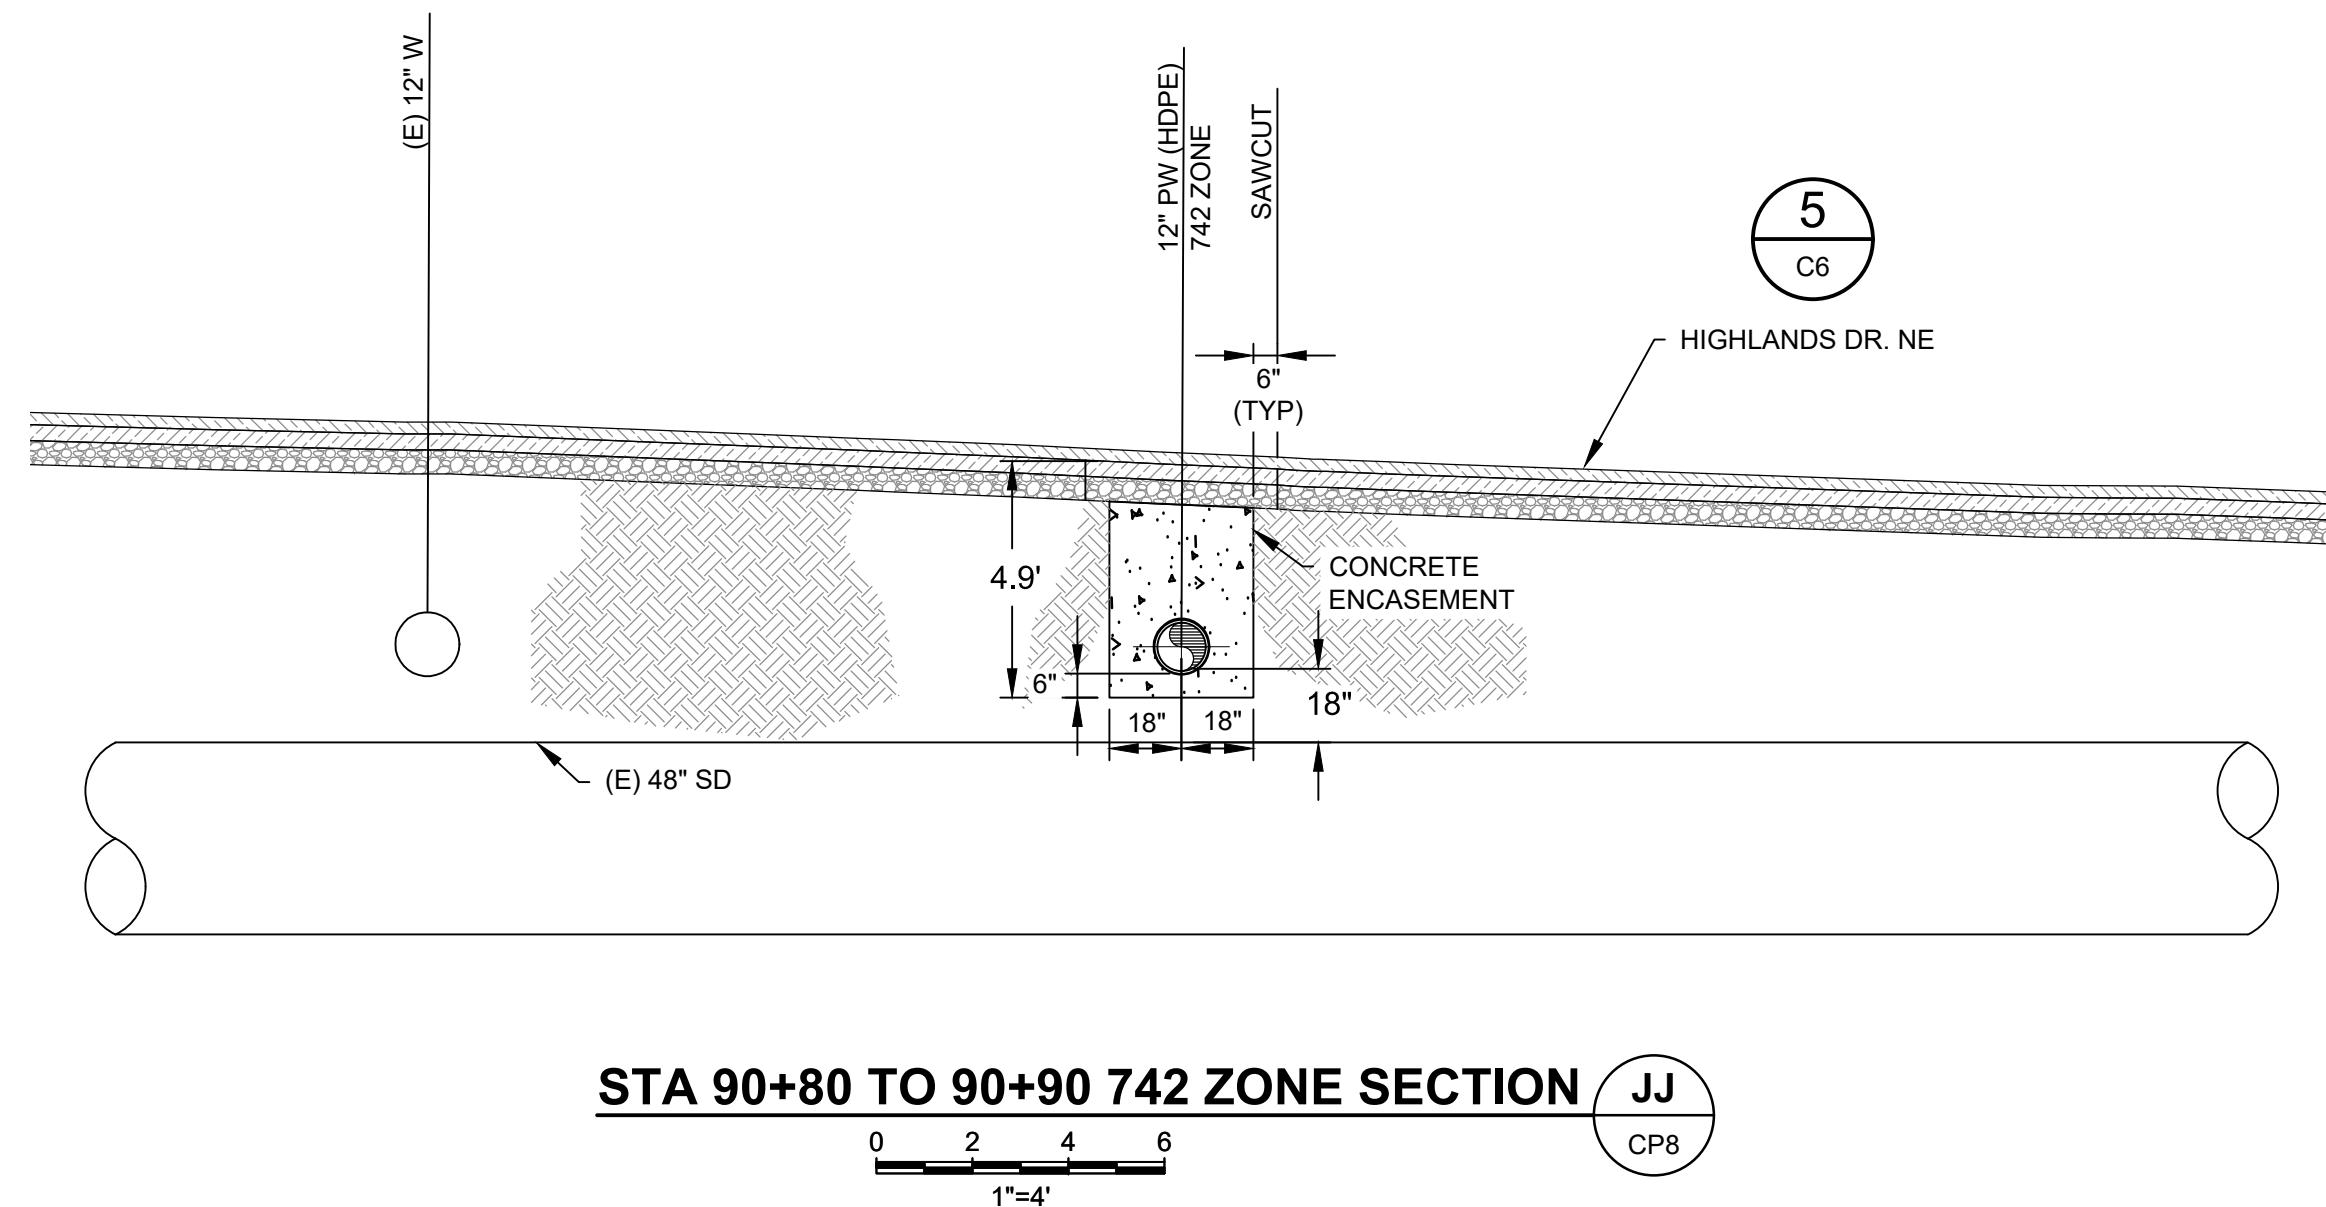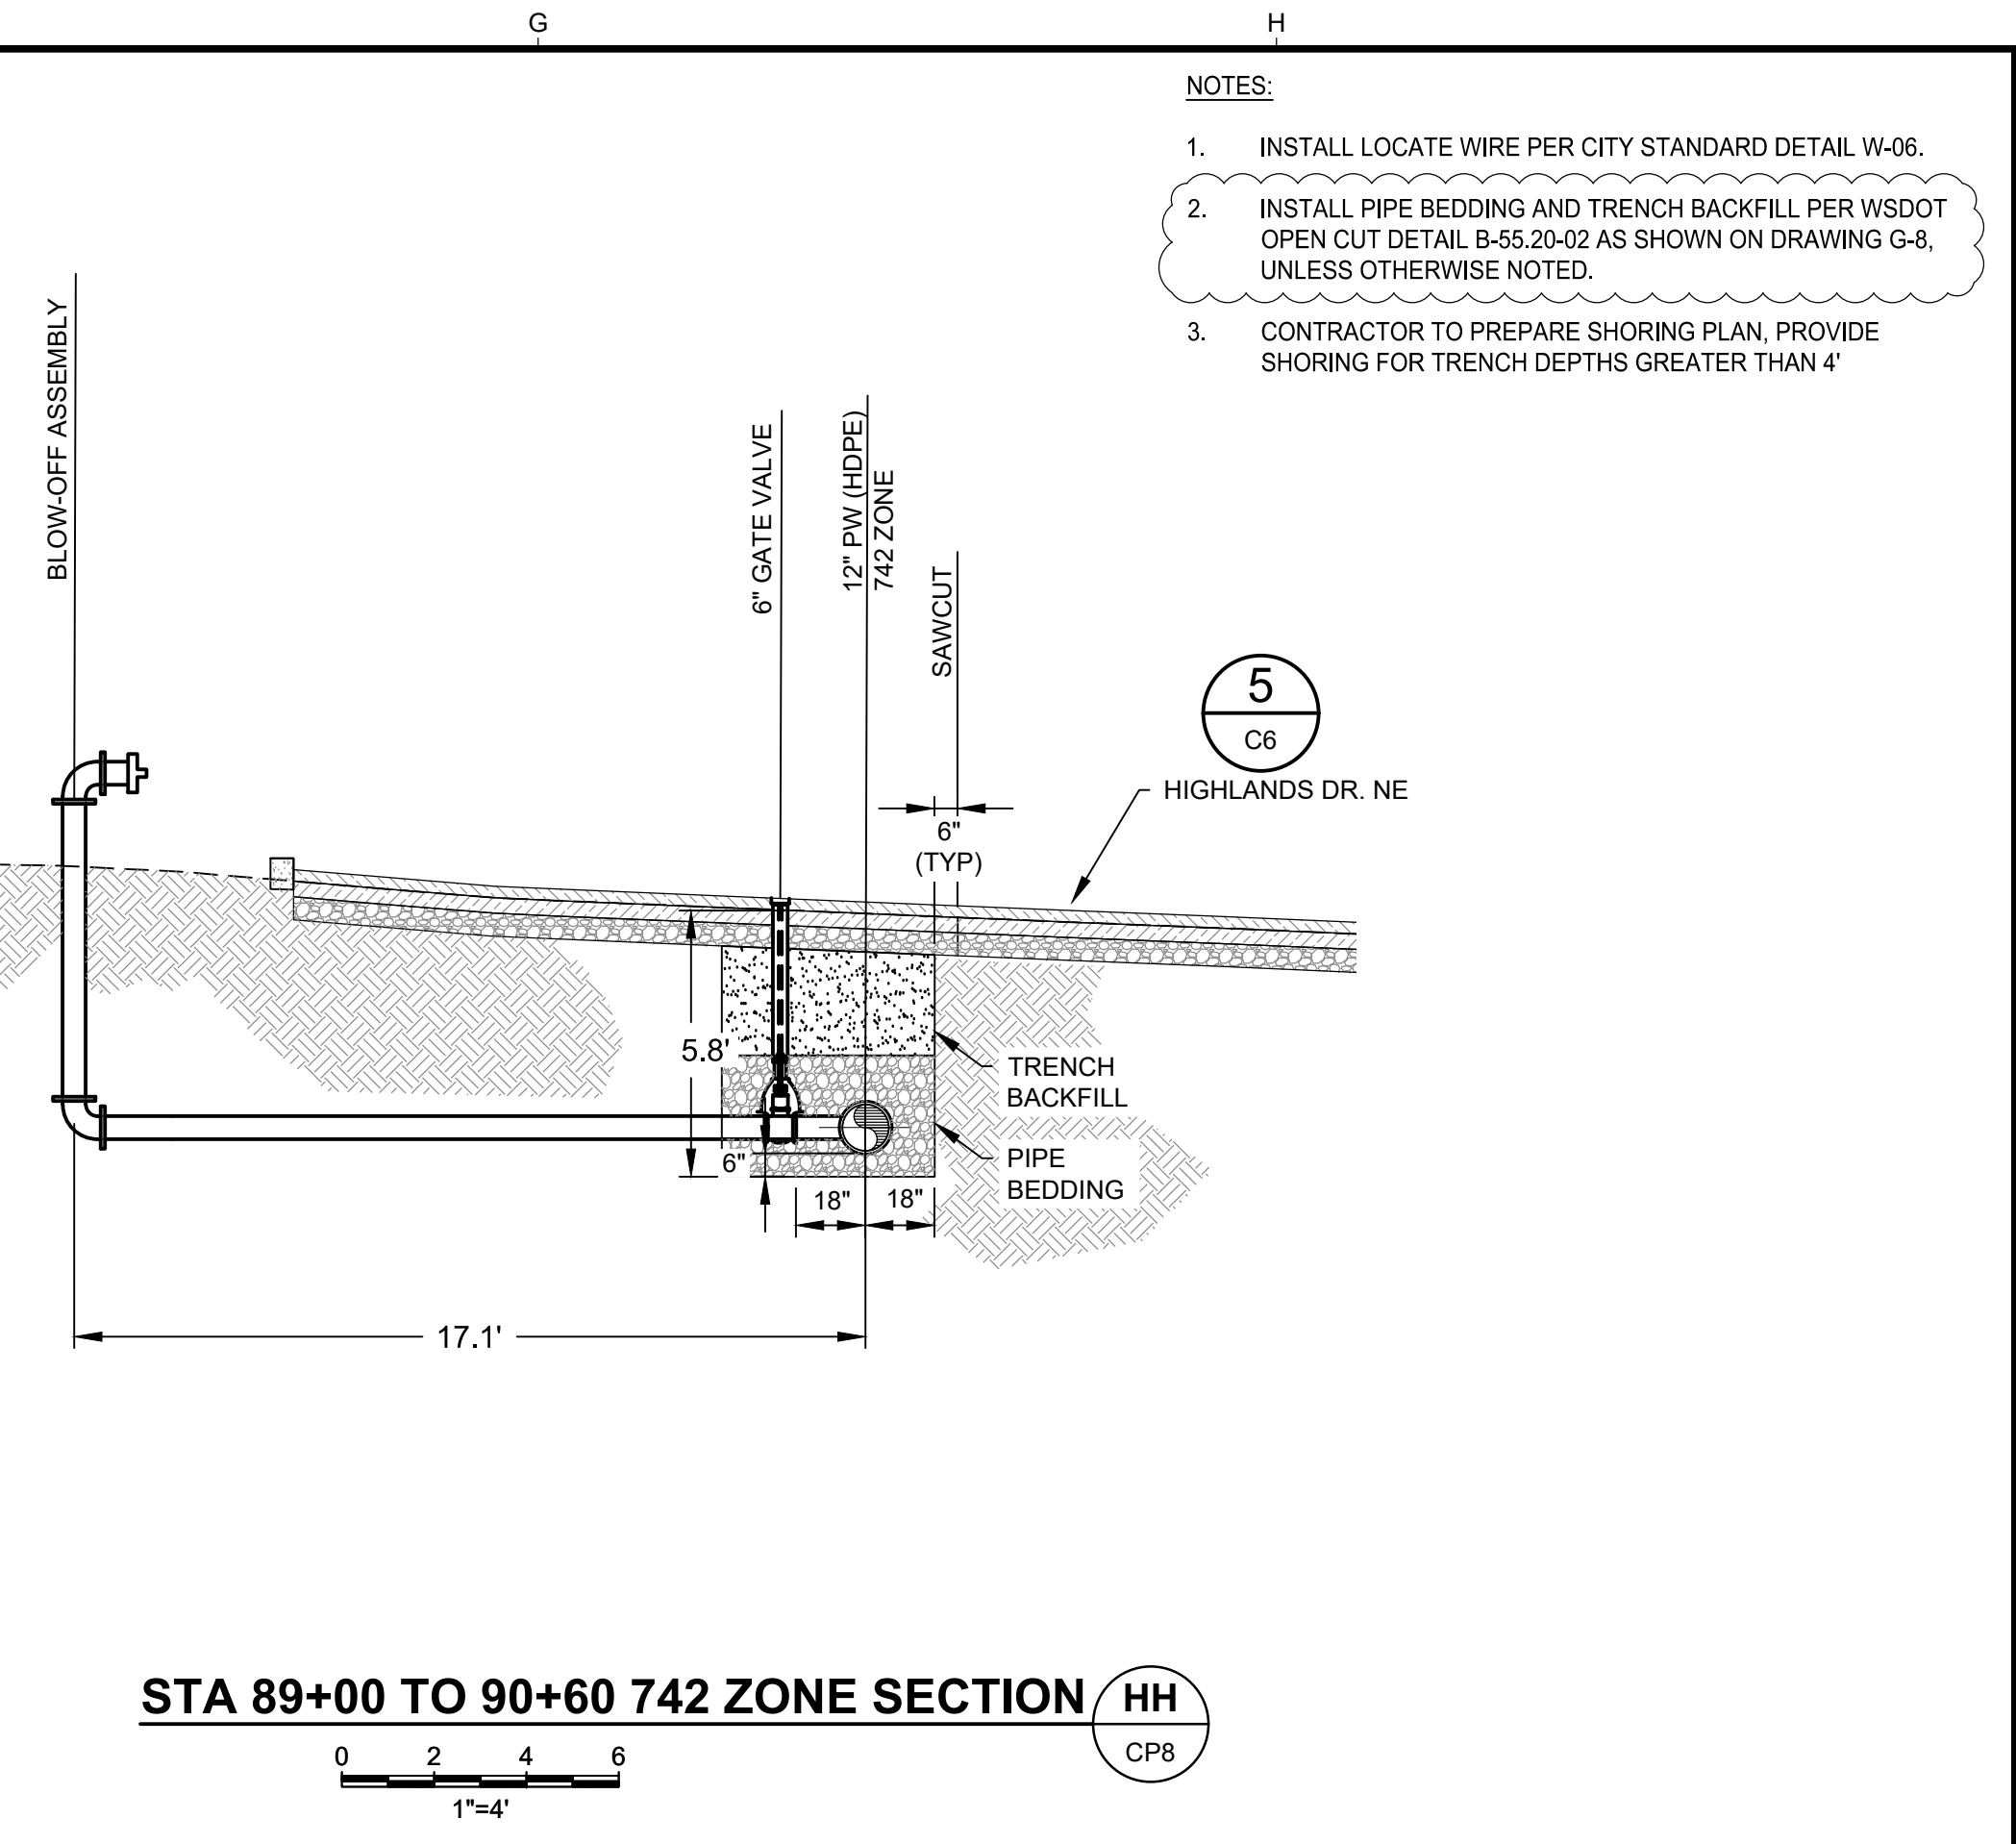

USE OF DOCUMENTS THIS DOCUMENT, INCLUDING THE INCORPORATED DESIGNS, IS AN INSTRUMENT OF SERVICE FOR THIS PROJECT AND SHALL NOT BE USED FOR ANY OTHER PROJECT WITHOUT THE WRITTEN AUTHORIZATION OF KENNEDY/JENKS CONSULTANTS.					<div>SCALES</div> <div><div>01"025mm</div></div> <div>IF THIS BAR IS NOT DIMENSION SHOWN, ADJUST SCALES ACCORDINGLY.</div>	<div><div>JEFFREY M. FORAY</div><div>STATE OF WASHINGTON</div><div></div><div>REGISTERED PROFESSIONAL ENGINEER</div></div>	DESIGNED	<div></div> <div>CITY OF ISSAQUAH</div> <div>ISSAQUAH, WASHINGTON</div> <div>SOUTH SPAR BOOSTER PUMP STATION</div> <div>Kennedy/Jenks Consultants</div> <div>FEDERAL WAY, WASHINGTON</div>	<div>PIPELINE SECTIONS - 7</div> <div>90% SUBMITTAL (REVISED 11/30/2020)</div>	FILE NAME	139700500-CP026.DWG
							JOB NO.			1397005'00	
							DATE			NOVEMBER 2020	
							SHEET			OF	
							CP26				
	NO.	REVISION	DATE	BY			DRAWN				
							RJS				
							CHECKED				
							MDL				

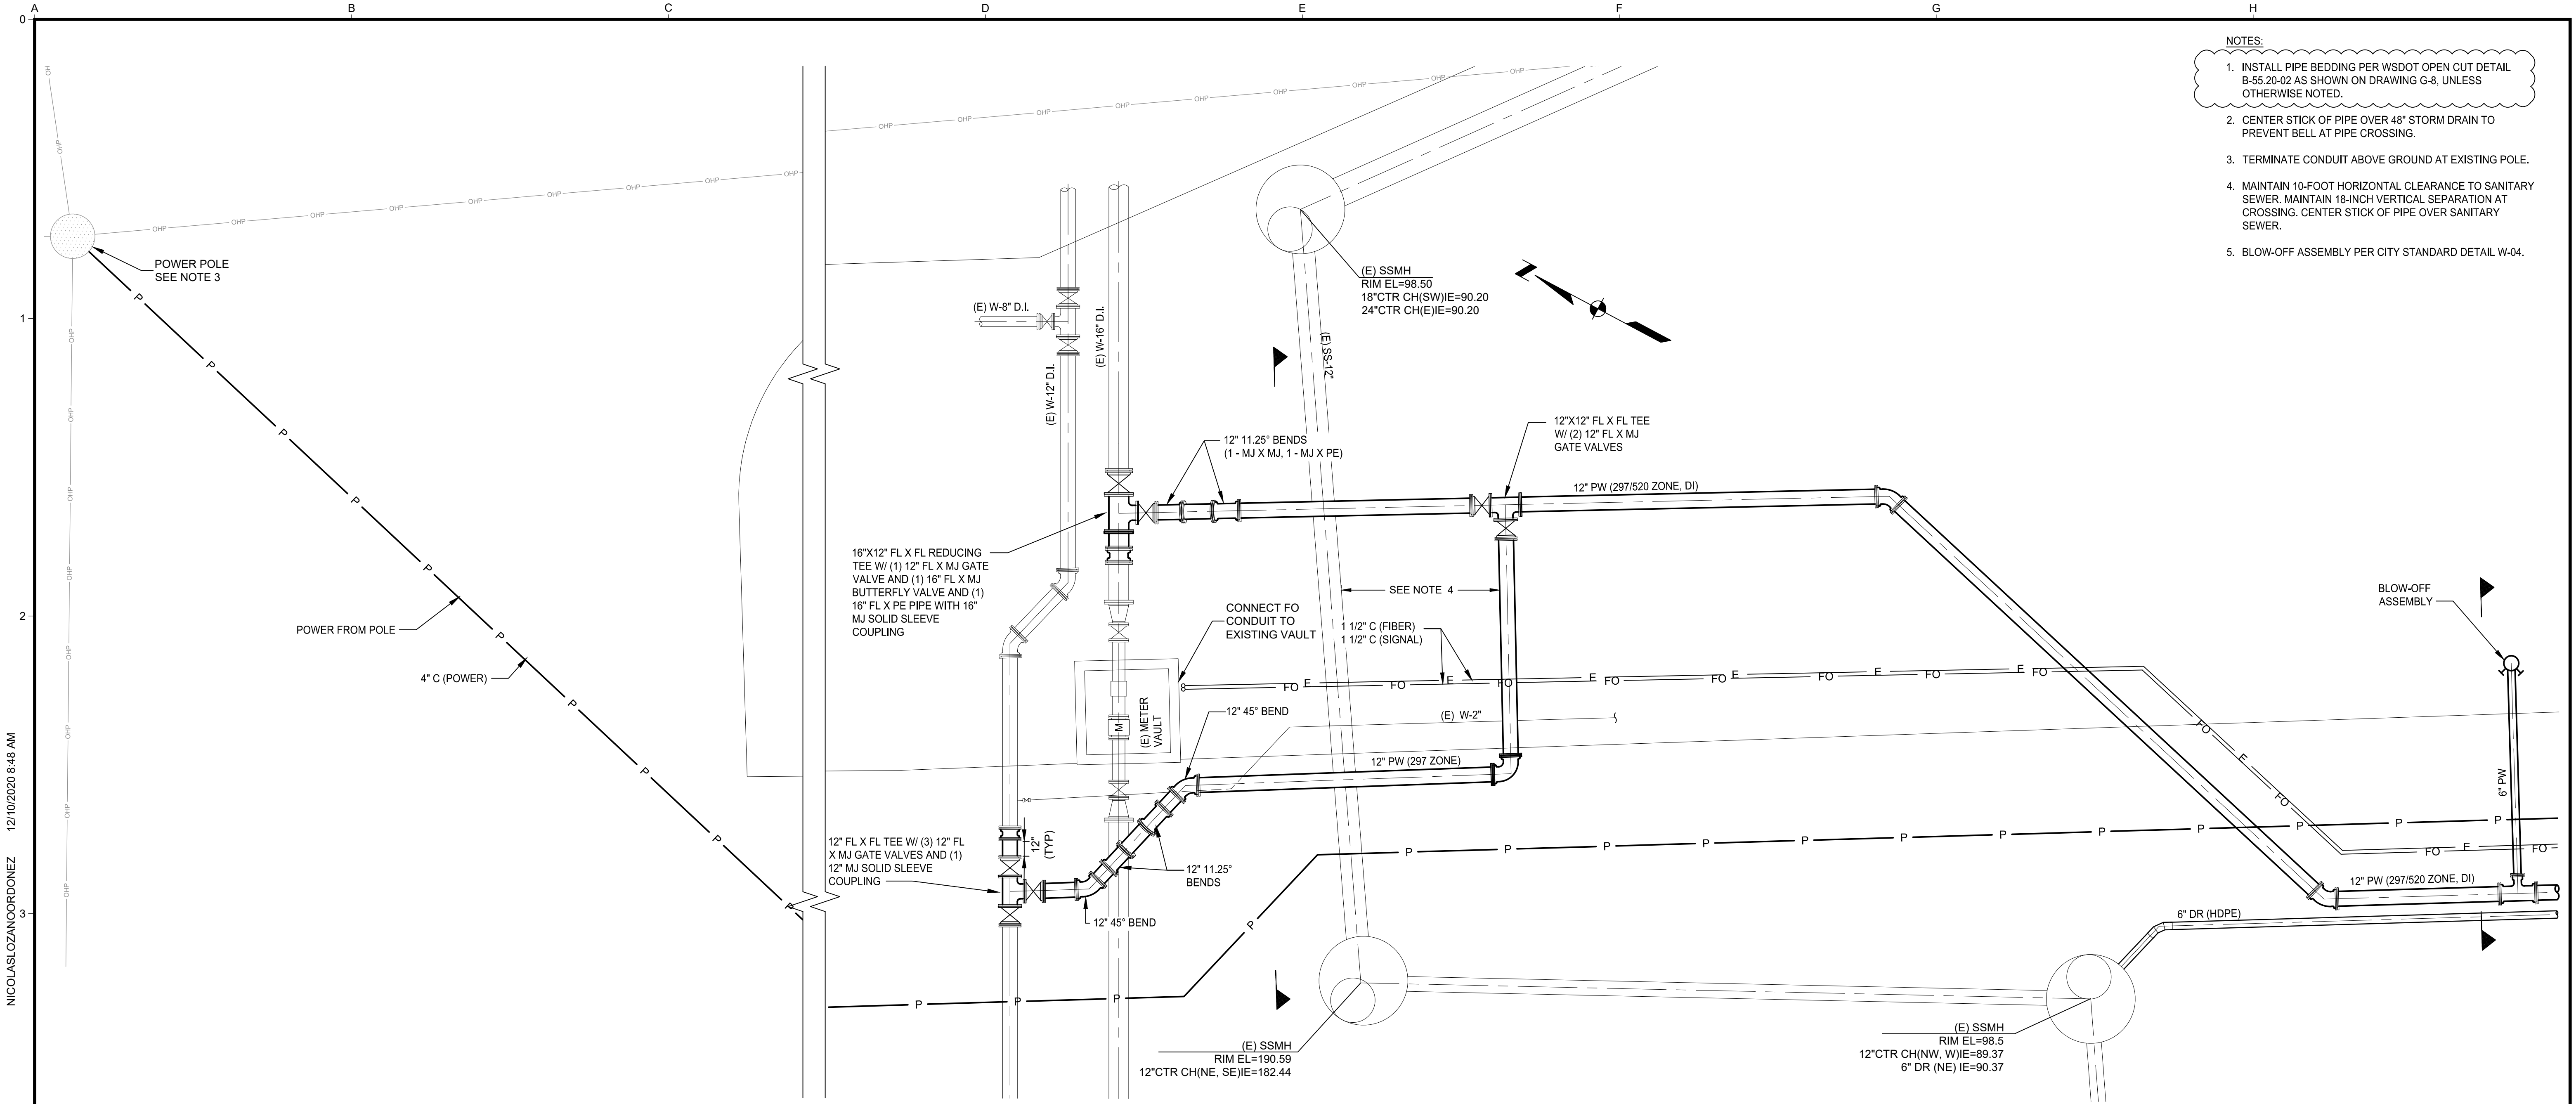


- NOTES:
1. INSTALL PIPE BEDDING PER WSDOT OPEN CUT DETAIL B-55.20-02 AS SHOWN ON DRAWING G-8, UNLESS OTHERWISE NOTED.
 2. CENTER STICK OF PIPE OVER 48\"/>
 3. TERMINATE CONDUIT ABOVE GROUND AT EXISTING POLE.
 4. MAINTAIN 10-FOOT HORIZONTAL CLEARANCE TO SANITARY SEWER. MAINTAIN 18-INCH VERTICAL SEPARATION AT CROSSING. CENTER STICK OF PIPE OVER SANITARY SEWER.
 5. BLOW-OFF ASSEMBLY PER CITY STANDARD DETAIL W-04.

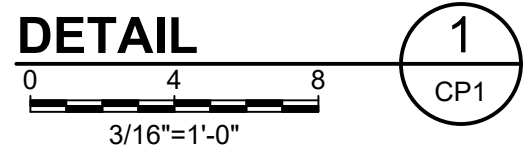

12/10/2020 8:48 AM
NICOLAS LOZANORDONEZ

\\jc.local\KUC-Rodrik-Office\FWY\CAD\CAD131\397005.00_City_of_Issaquah\139700500-CP030.dwg

USE OF DOCUMENTS THIS DOCUMENT, INCLUDING THE INCORPORATED DESIGNS, IS AN INSTRUMENT OF SERVICE FOR THIS PROJECT AND SHALL NOT BE USED FOR ANY OTHER PROJECT WITHOUT THE WRITTEN AUTHORIZATION OF KENNEDY/JENKS CONSULTANTS.					<div>SCALES</div> <div>0 1" 25mm</div> <div>IF THIS BAR IS NOT DIMENSION SHOWN, ADJUST SCALES ACCORDINGLY.</div>	<div></div>	DESIGNED	<div></div> <div>CITY OF ISSAQUAH ISSAQUAH, WASHINGTON SOUTH SPAR BOOSTER PUMP STATION</div> <div>Kennedy/Jenks Consultants FEDERAL WAY, WASHINGTON</div>	PIPELINE DETAILS - 1			FILE NAME
	DP/JMF	139700500-CP030.DWG										
	DRAWN	JOB NO.										
	LMM	1397005*00										
	CHECKED	DATE										
MDL	NOVEMBER 2020											
											SHEET OF	
	NO.	REVISION	DATE	BY						90% SUBMITTAL (REVISED 11/30/2020)	CP30	

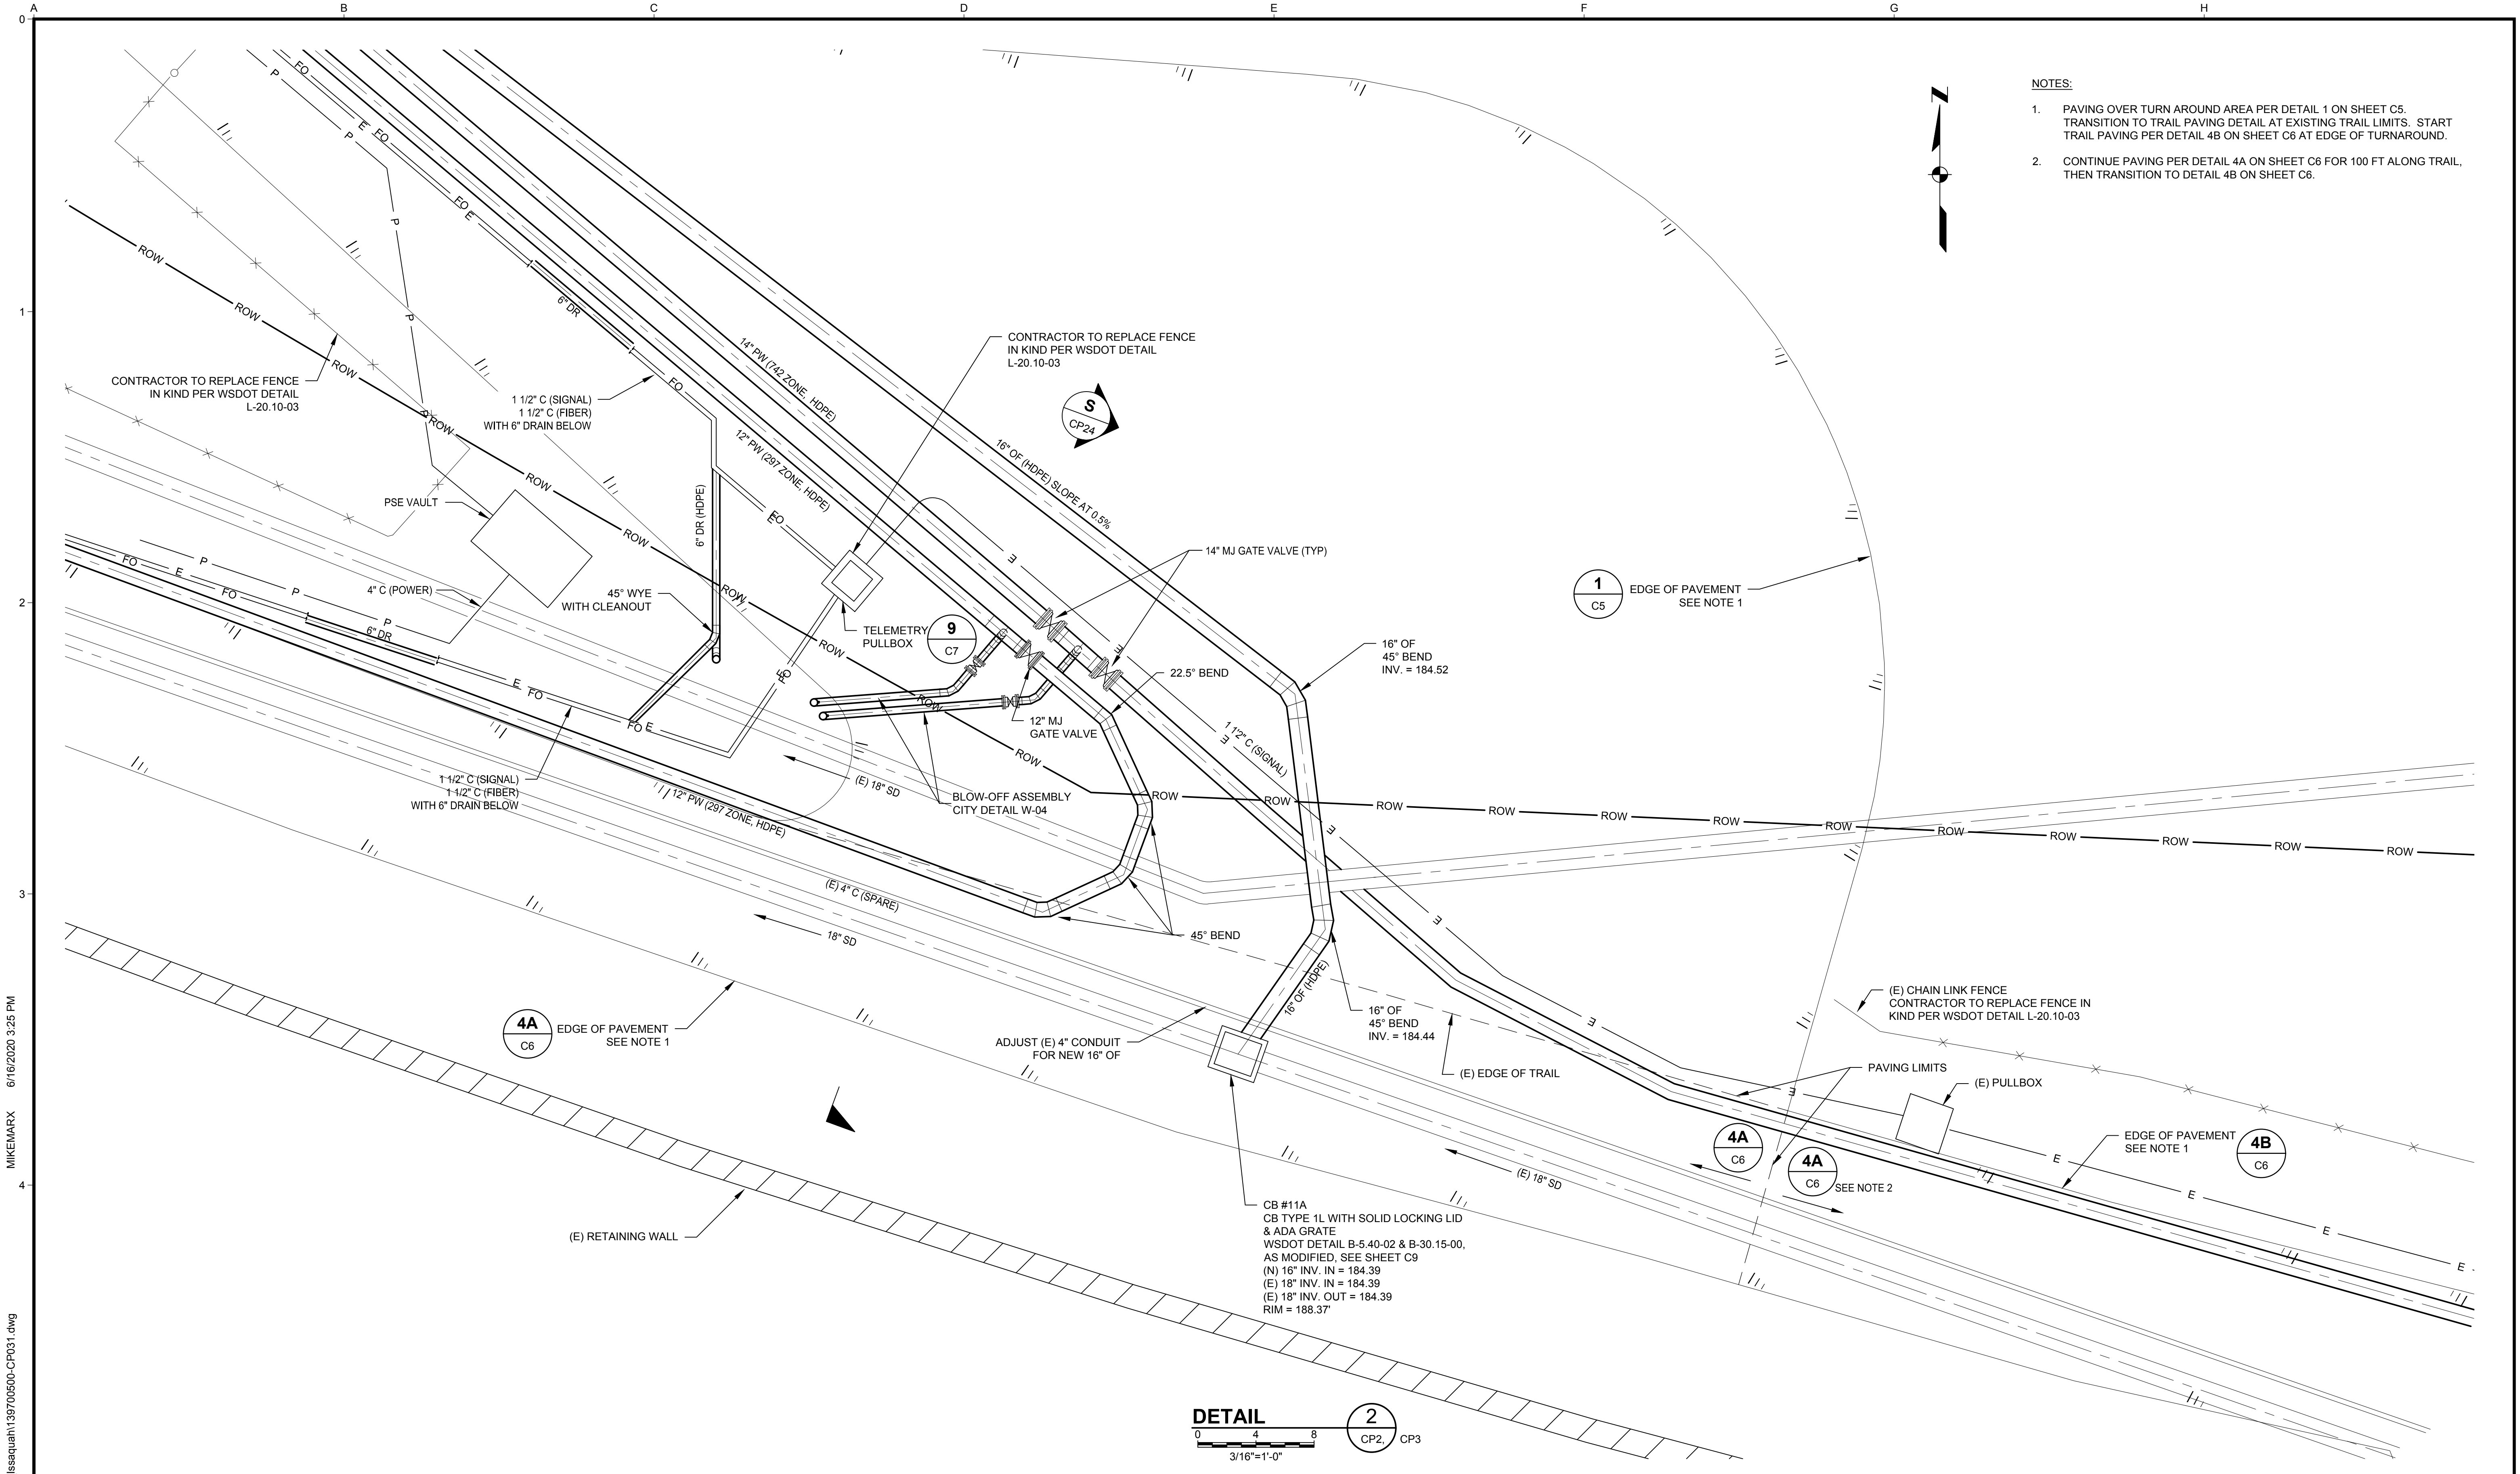

MIKEMARX 6/16/2020 3:25 PM


P:\CAD\13\1397005_00_City_of_Issaquah\139700500-CP031.dwg

USE OF DOCUMENTS				
THIS DOCUMENT, INCLUDING THE INCORPORATED DESIGNS, IS AN INSTRUMENT OF SERVICE FOR THIS PROJECT AND SHALL NOT BE USED FOR ANY OTHER PROJECT WITHOUT THE WRITTEN AUTHORIZATION OF KENNEDY/JENKS CONSULTANTS.				
NO.	REVISION	DATE	BY	


SCALES

0 1" 25mm

IF THIS BAR IS NOT DIMENSION SHOWN, ADJUST SCALES ACCORDINGLY.

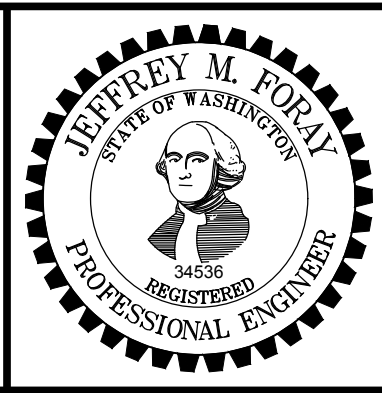

DESIGNED	KSP
DRAWN	LMM
CHECKED	MDL

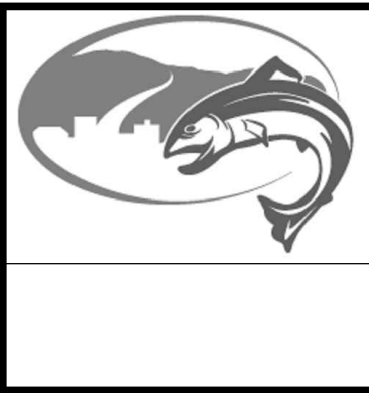

CITY OF ISSAQUAH
ISSAQUAH, WASHINGTON

SOUTH SPAR BOOSTER PUMP STATION




Kennedy/Jenks Consultants
FEDERAL WAY, WASHINGTON

PIPELINE DETAILS - 2

90% SUBMITTAL (REVISED 7/1/2020)

FILE NAME	139700500-CP031.DWG
JOB NO.	1397005'00
DATE	JUNE 2020
SHEET	54 OF 83
	CP31


P:\CAD\13\1397005_00_City_of_Issaquah\139700500-CP032.dwg 10/23/2019 8:43 AM MIKEMARX

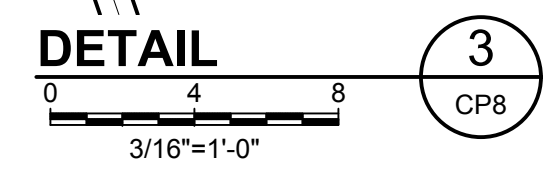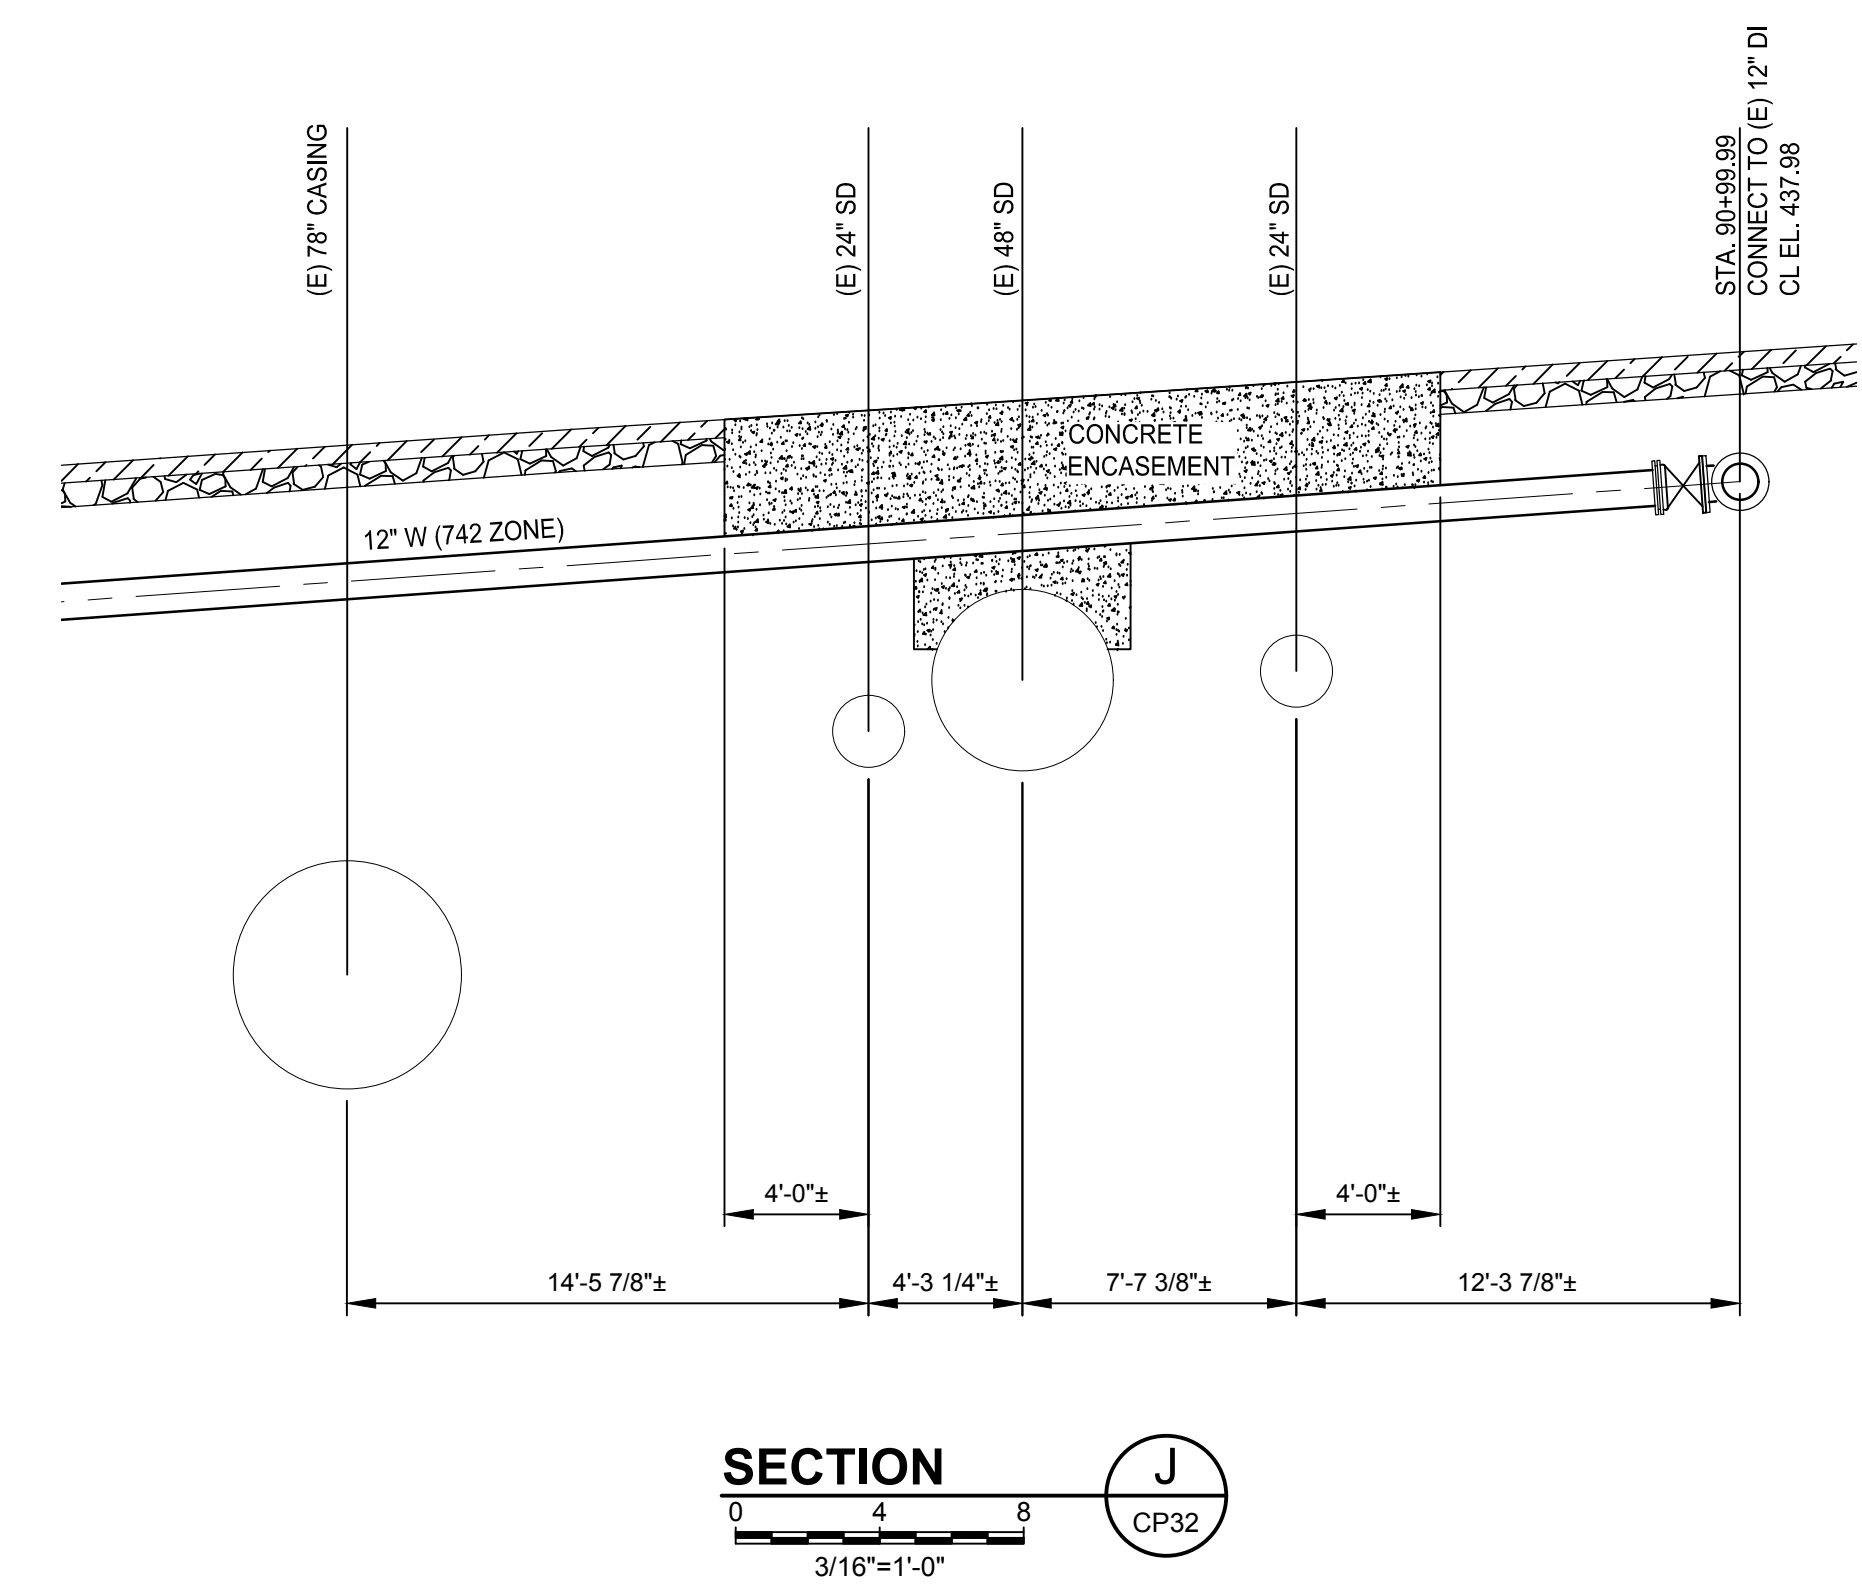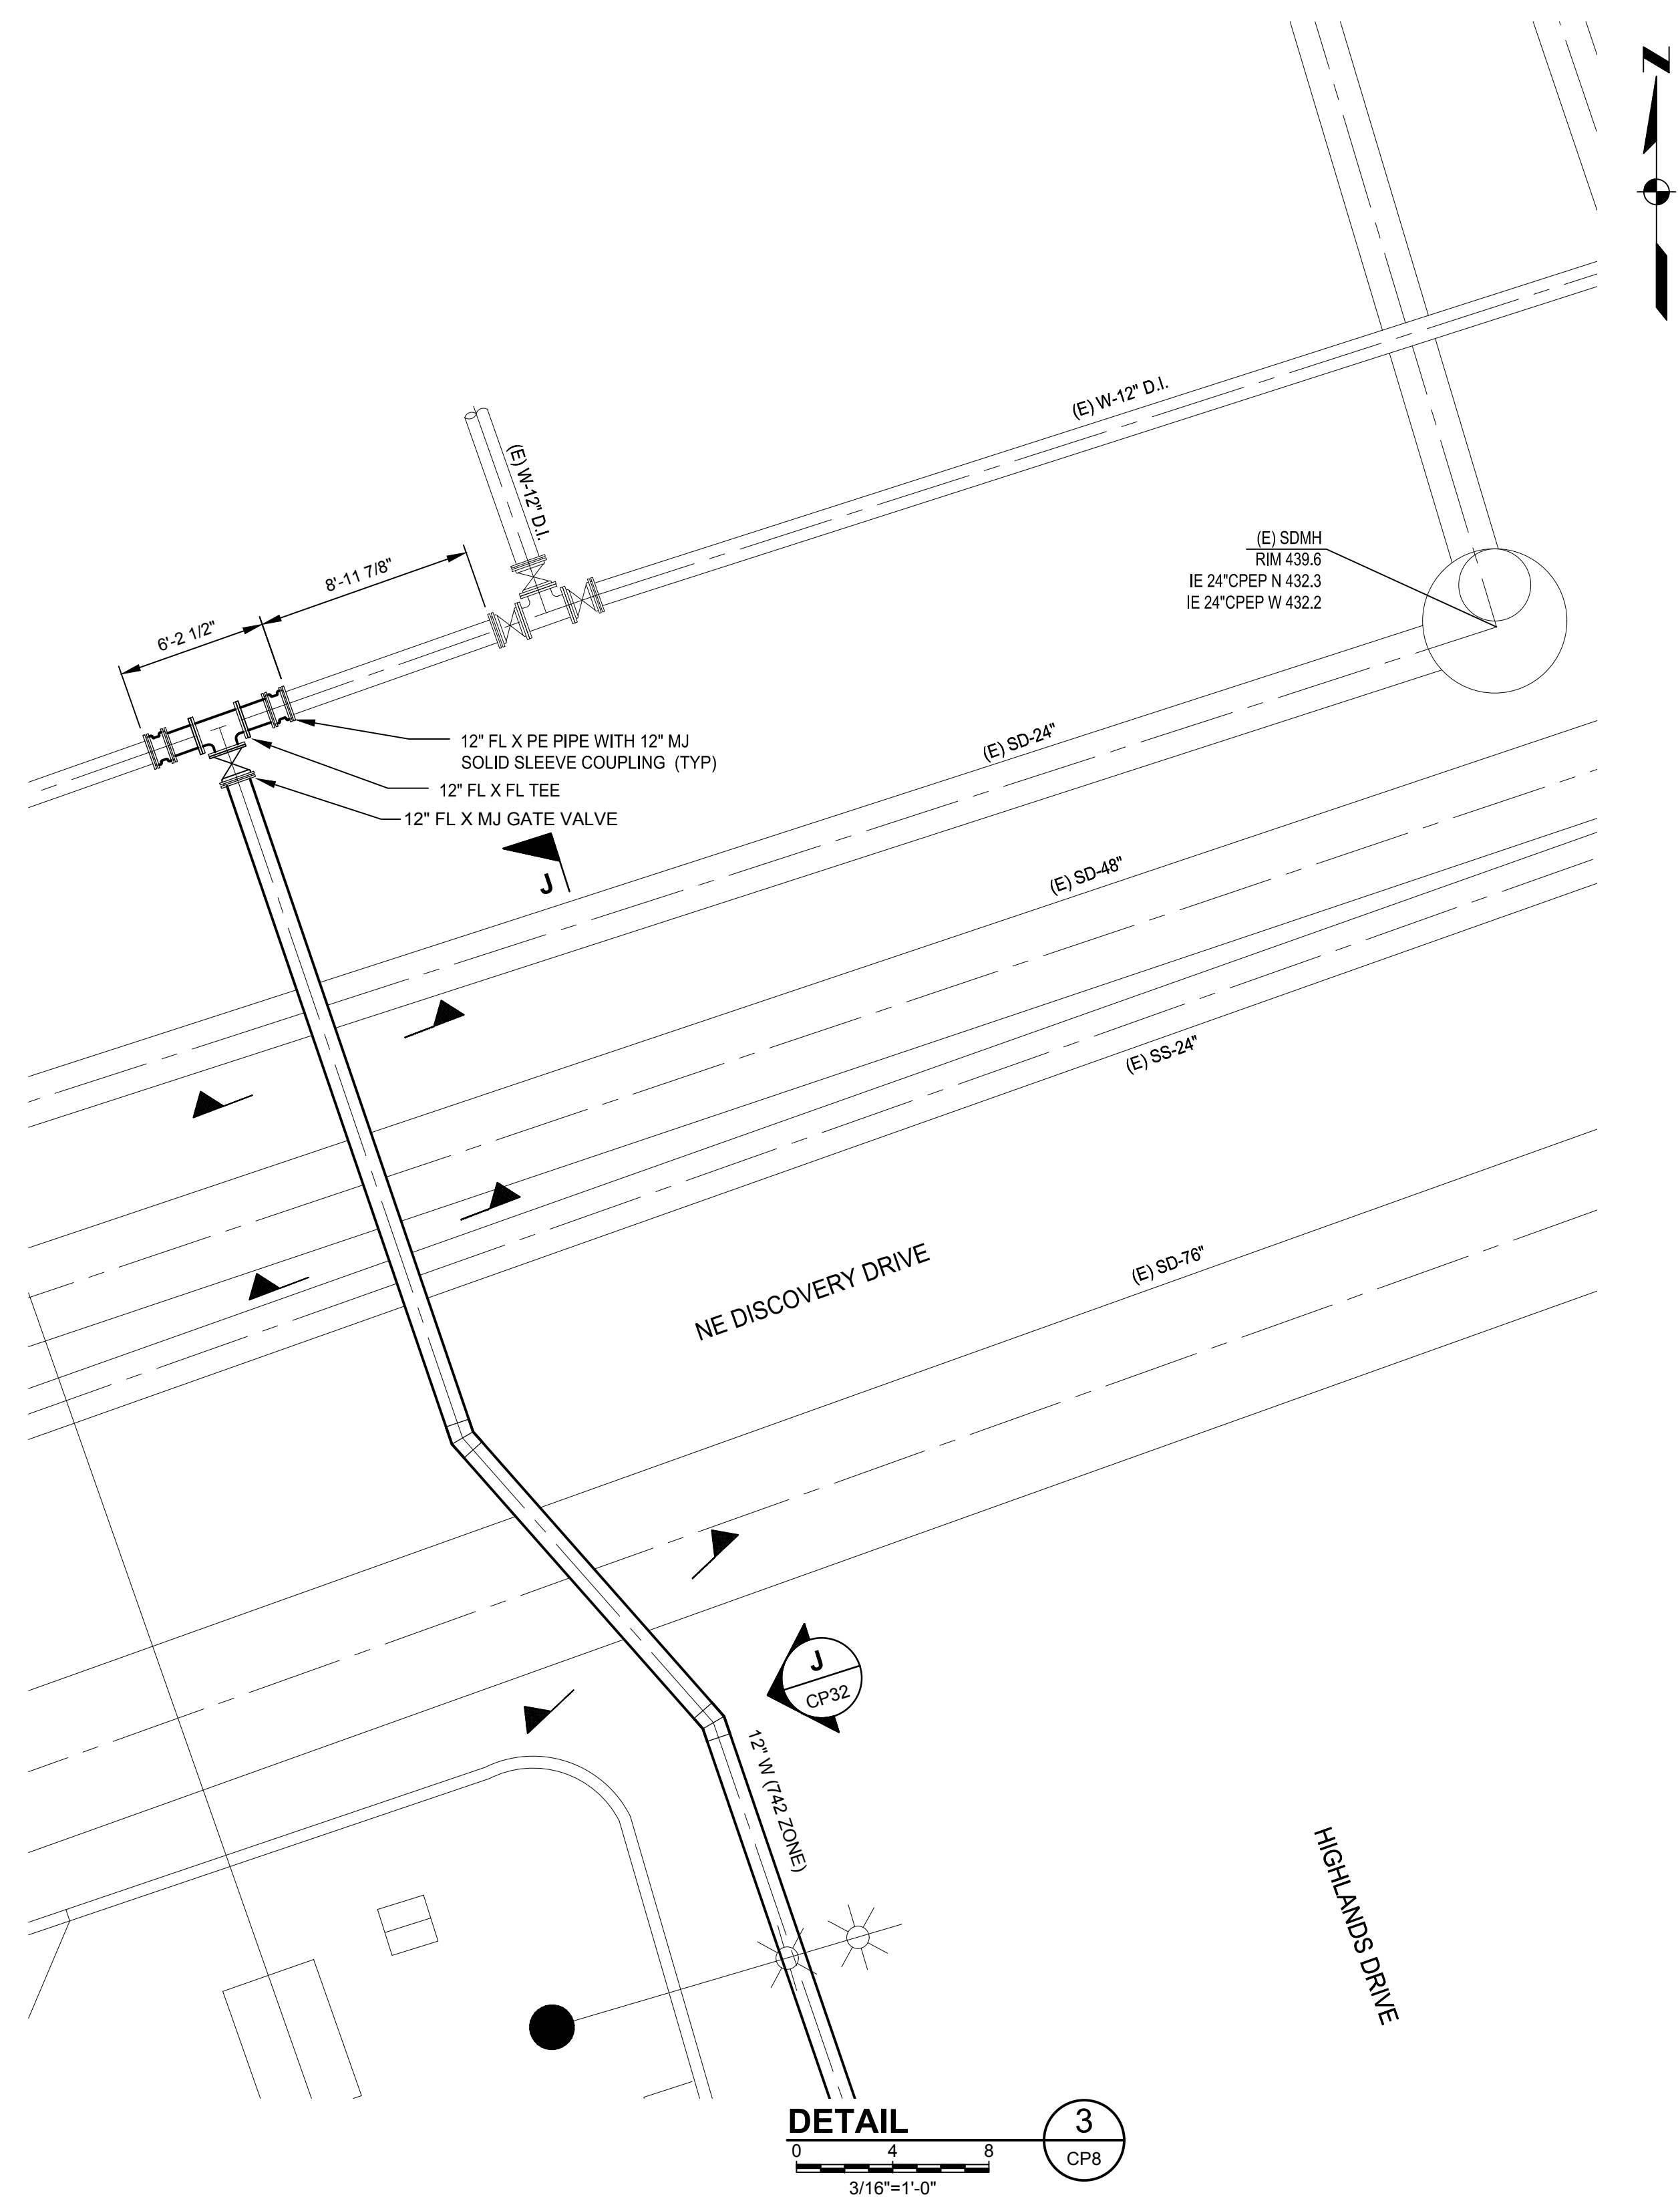

USE OF DOCUMENTS
THIS DOCUMENT, INCLUDING THE INCORPORATED DESIGNS, IS AN INSTRUMENT OF SERVICE FOR THIS PROJECT AND SHALL NOT BE USED FOR ANY OTHER PROJECT WITHOUT THE WRITTEN AUTHORIZATION OF KENNEDY/JENKS CONSULTANTS.

NO.	REVISION	DATE	BY

SCALES
1" = 25mm
IF THIS BAR IS NOT DIMENSION SHOWN, ADJUST SCALES ACCORDINGLY.

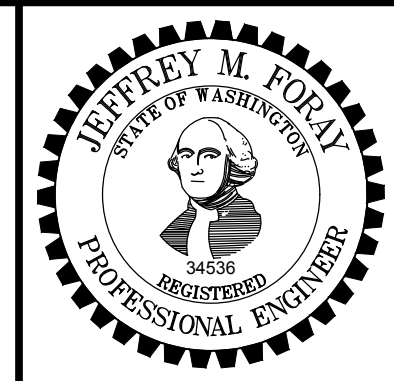

DESIGNED	KSP
DRAWN	DRP
CHECKED	MDL




CITY OF ISSAQUAH
ISSAQUAH, WASHINGTON
SOUTH SPAR BOOSTER PUMP STATION
Kennedy/Jenks Consultants
FEDERAL WAY, WASHINGTON


PIPELINE DETAILS - 3
90% SUBMITTAL (REVISED 7/1/2020)

FILE NAME	139700500-CP032.DWG
JOB NO.	1397005*00
DATE	JUNE 2020
SHEET	55 OF 83
CP32	


P:\CAD\131\1397005_00_City_of_Issaquah\139700500-CP033.dwg
MIKEMARX 2/17/2020 8:04 AM

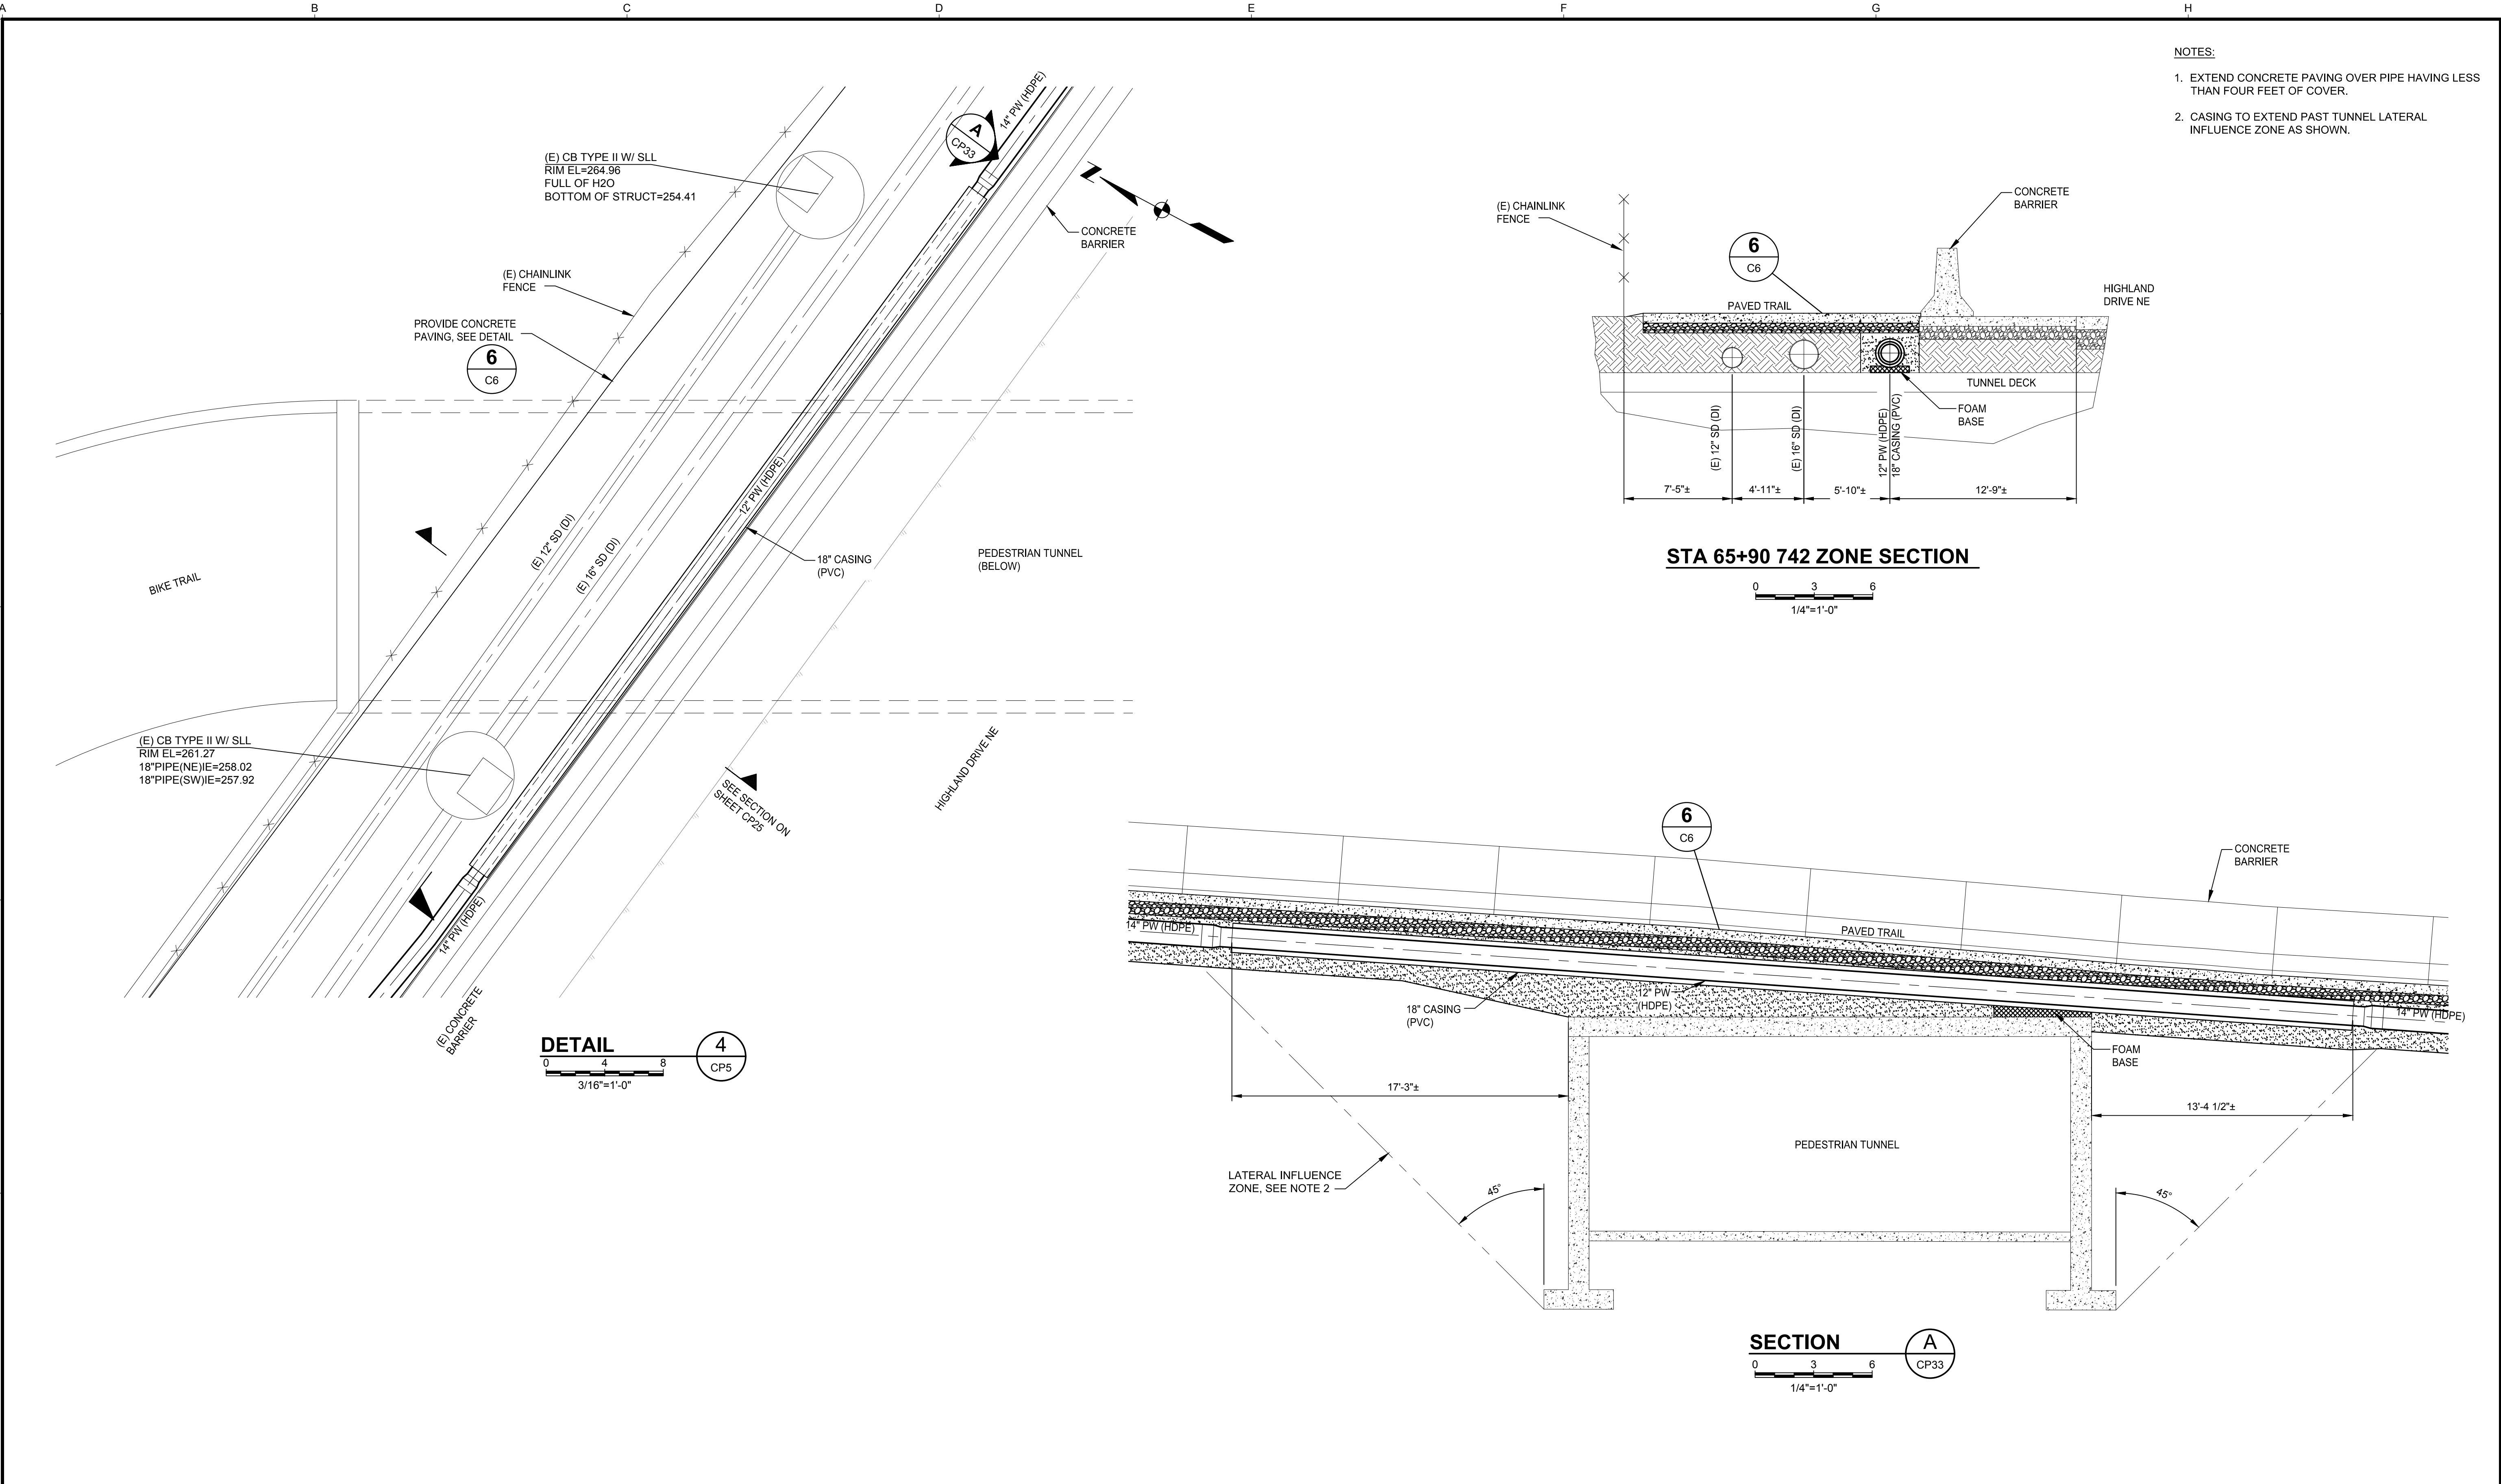


USE OF DOCUMENTS THIS DOCUMENT, INCLUDING THE INCORPORATED DESIGNS, IS AN INSTRUMENT OF SERVICE FOR THIS PROJECT AND SHALL NOT BE USED FOR ANY OTHER PROJECT WITHOUT THE WRITTEN AUTHORIZATION OF KENNEDY/JENKS CONSULTANTS.					<div>SCALES</div> <div><div>0</div><div>1"</div></div> <div><div>0</div><div>25mm</div></div> <div>IF THIS BAR IS NOT DIMENSION SHOWN, ADJUST SCALES ACCORDINGLY.</div>	<div><div>JEFFREY M. FORNEY</div><div>STATE OF WASHINGTON</div><div>34536</div><div>REGISTERED</div><div>PROFESSIONAL ENGINEER</div></div>	DESIGNED	<div></div>	<div>CITY OF ISSAQUAH</div> <div>ISSAQUAH, WASHINGTON</div> <div>SOUTH SPAR BOOSTER PUMP STATION</div>	<div>PIPELINE DETAILS - 4</div> <div>90% SUBMITTAL (REVISED 7/1/2020)</div>	FILE NAME
							139700500-CP033.DWG				
							JOB NO.				
							1397005*00				
							DATE				
										JUNE 2020	
											SHEET
											56 OF 83
											CP33
NO.	REVISION	DATE	BY								
			</								

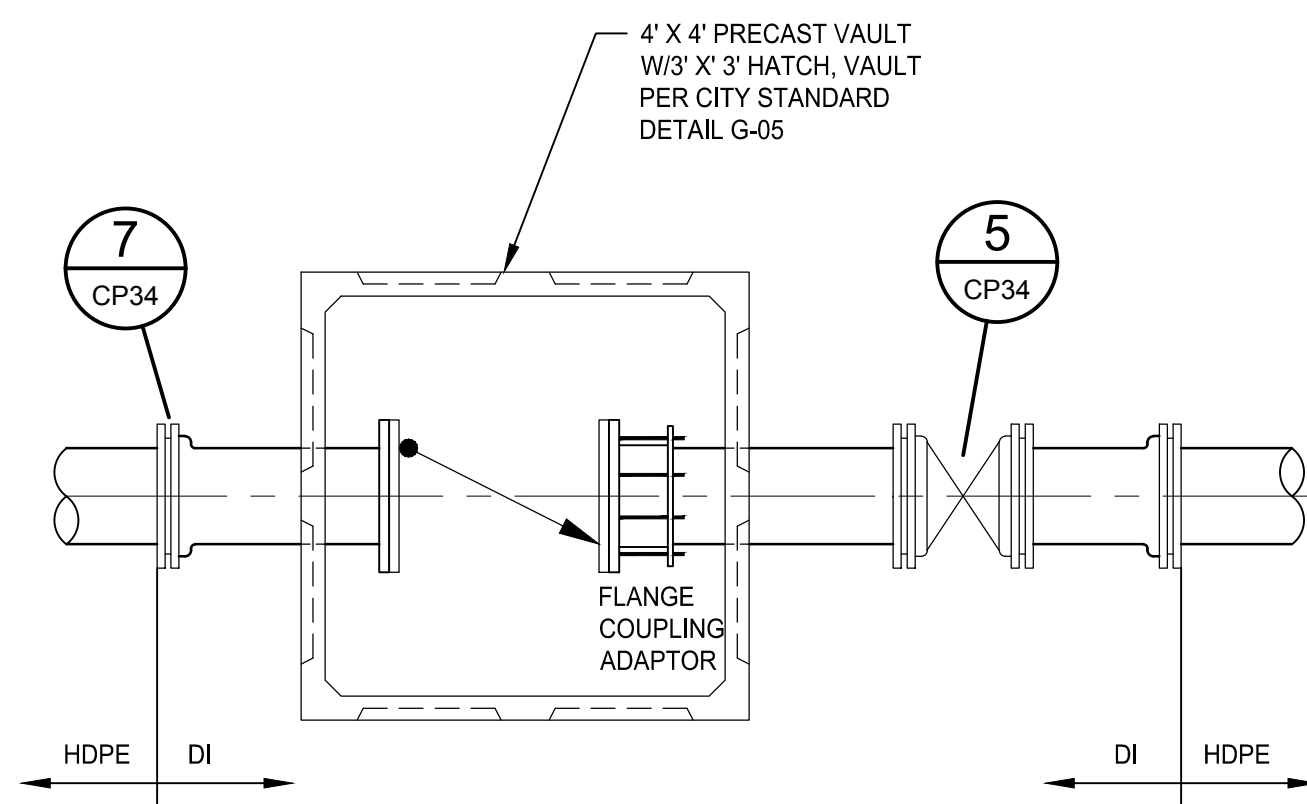

CHECK VALVE IN HDPE MAIN 6
SCALE: NONE CP34

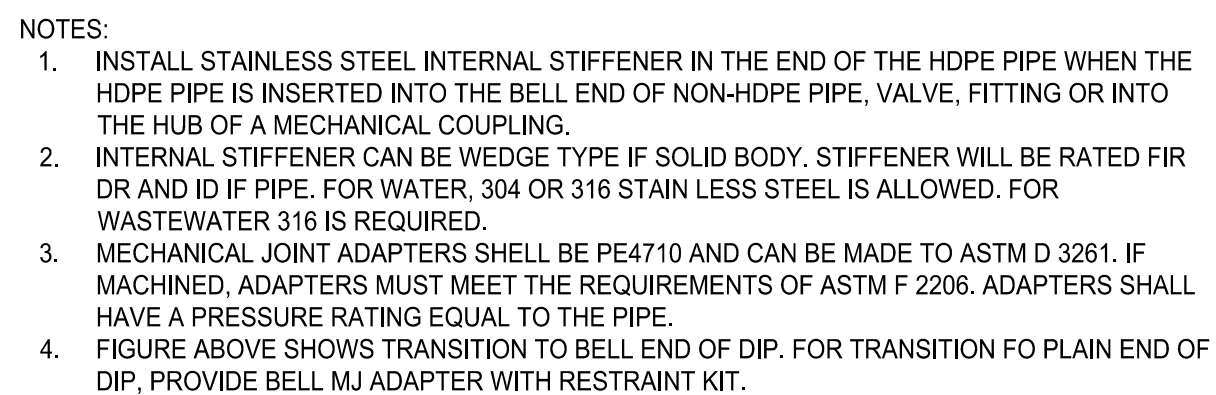

HDPE TO DUCTILE IRON TRANSITION ASSEMBLY 7
SCALE: NONE CP34

<div>USE OF DOCUMENTS</div> <div>THIS DOCUMENT, INCLUDING THE INCORPORATED DESIGNS, IS AN INSTRUMENT OF SERVICE FOR THIS PROJECT AND SHALL NOT BE USED FOR ANY OTHER PROJECT WITHOUT THE WRITTEN AUTHORIZATION OF KENNEDY/JENKS CONSULTANTS.</div>					<div>SCALES</div> <div><div>01"25mm</div></div> <div>IF THIS BAR IS NOT DIMENSION SHOWN, ADJUST SCALES ACCORDINGLY.</div>	<div><div>JEFFREY M. FORAY</div><div>STATE OF WASHINGTON</div><div><div>34530</div><div>REGISTERED</div></div><div>PROFESSIONAL ENGINEER</div></div>	DESIGNED	<div></div> <div><div>CITY OF ISSAQUAH</div><div>ISSAQUAH, WASHINGTON</div><div>SOUTH SPAR BOOSTER PUMP STATION</div></div>	<div>PIPELINE DETAILS - 5</div> <div>90% SUBMITTAL (REVISED 7/1/2020)</div>	FILE NAME	
	JMF	139700500-CP034.DWG									
	DRAWN	JOB NO.									
	DRP	1397005'00									
	CHECKED	DATE									
MDL	JUNE 2020										
	NO.	REVISION	DATE	BY				Kennedy/Jenks Consultants			SHEET 57 OF 82
								FEDERAL WAY, WASHINGTON			CP34

11/30/2020 9:47 AM
MARKPRESTON
P:\CAD\131\1397005.00_City_of_Issaquah\139700500-A001.dwg

ISSAQUAH PUMP STATION CODE SUMMARY

CODES USED IN ANALYSIS:

- BUILDING CODE - WASHINGTON STATE BUILDING CODE BASED ON 2015 INTERNATIONAL BUILDING CODE (IBC)
- PLUMBING CODE - WASHINGTON STATE PLUMBING CODE BASED ON THE 2015 UNIFORM PLUMBING CODE (UPC)
- MECHNICAL CODE - WASHINGTON STATE MECHANICAL CODE BASED ON THE 2015 INTERNATIONAL MECHANICAL CODE (IMC)
- ELECTRICAL CODE - NEC 2014
- FIRE/LIFE SAFETY CODE - WASHINGTON STATE FIRE CODE BASED ON THE 2015 INTERNATIONAL FIRE CODE (IFC)
- ENERGY CODE - 2015 WASHINGTON STATE ENERGY CODE
- KING COUNTY CODE - TITLES 16 and 17
- WISHA (RCW 49.17) STANDARDS

CLIMATE ZONE:

4C

JURISDICTION:

- CITY OF ISSAQUAH, WASHINGTON
CITY HALL NORTHWEST
1775 12th AVENUE NORTHWEST
ISSAQUAH, WASHINGTON 98027
PH (425) 837-3100

BUILDING DESCRIPTION/OCCUPANCY

- THE BUILDING IS A PROCESS FACILITY, SINGLE OCCUPANCY, CLASSIFICATION F-1.
- THIS IS A ONE-STORY CMU BUILDING WITH PRE-ENGINEERED WOOD TRUSS ROOF FRAMING AND METAL ROOF.

AREA

- GROSS AREA IS 1,140 SQUARE FEET ON A SINGLE FLOOR.
ALLOWABLE AREA IS 8,500 SQUARE FEET PER FLOOR PER TABLE 506.2.

HEIGHT

- 20'-0"± TO TOP OF ROOF. 40'-0" IS ALLOWED PER TABLE 504.3.

CONSTRUCTION

- TYPE VB PER IBC SECTION 602.5 AND TABLE 503.

CHEMICAL STORAGE

- NONE

ACCESSIBILITY

- NOT REQUIRED FOR EQUIPMENT SPACES. SPACES FREQUENTED ONLY BY SERVICE PERSONNEL FOR MAINTENANCE, REPAIR OR OCCASIONAL MONITORING OF EQUIPMENT ARE NOT REQUIRED TO BE ACCESSIBLE PER IBC 1103.2.9

EXITS REQUIRED

- 1 ALLOWED PER IBC 10006.2.1.

FIRE SPRINKLERS


- NOT REQUIRED PER IBC 903.2.4

FIRE RESISTANCE / DISTANCE TO PROPERTY LINE

- MORE THAN 10'-0" TO PROPERTY LINE, NO FIRE RESISTANCE RATING REQUIRED PER TABLE 602.

NOTES


1. FOR SITE INFORMATION SEE CIVIL DRAWINGS
2. PROCESS EQUIPMENT IS NOT SHOWN FOR CLARITY. SEE MECHANICAL DRAWINGS.

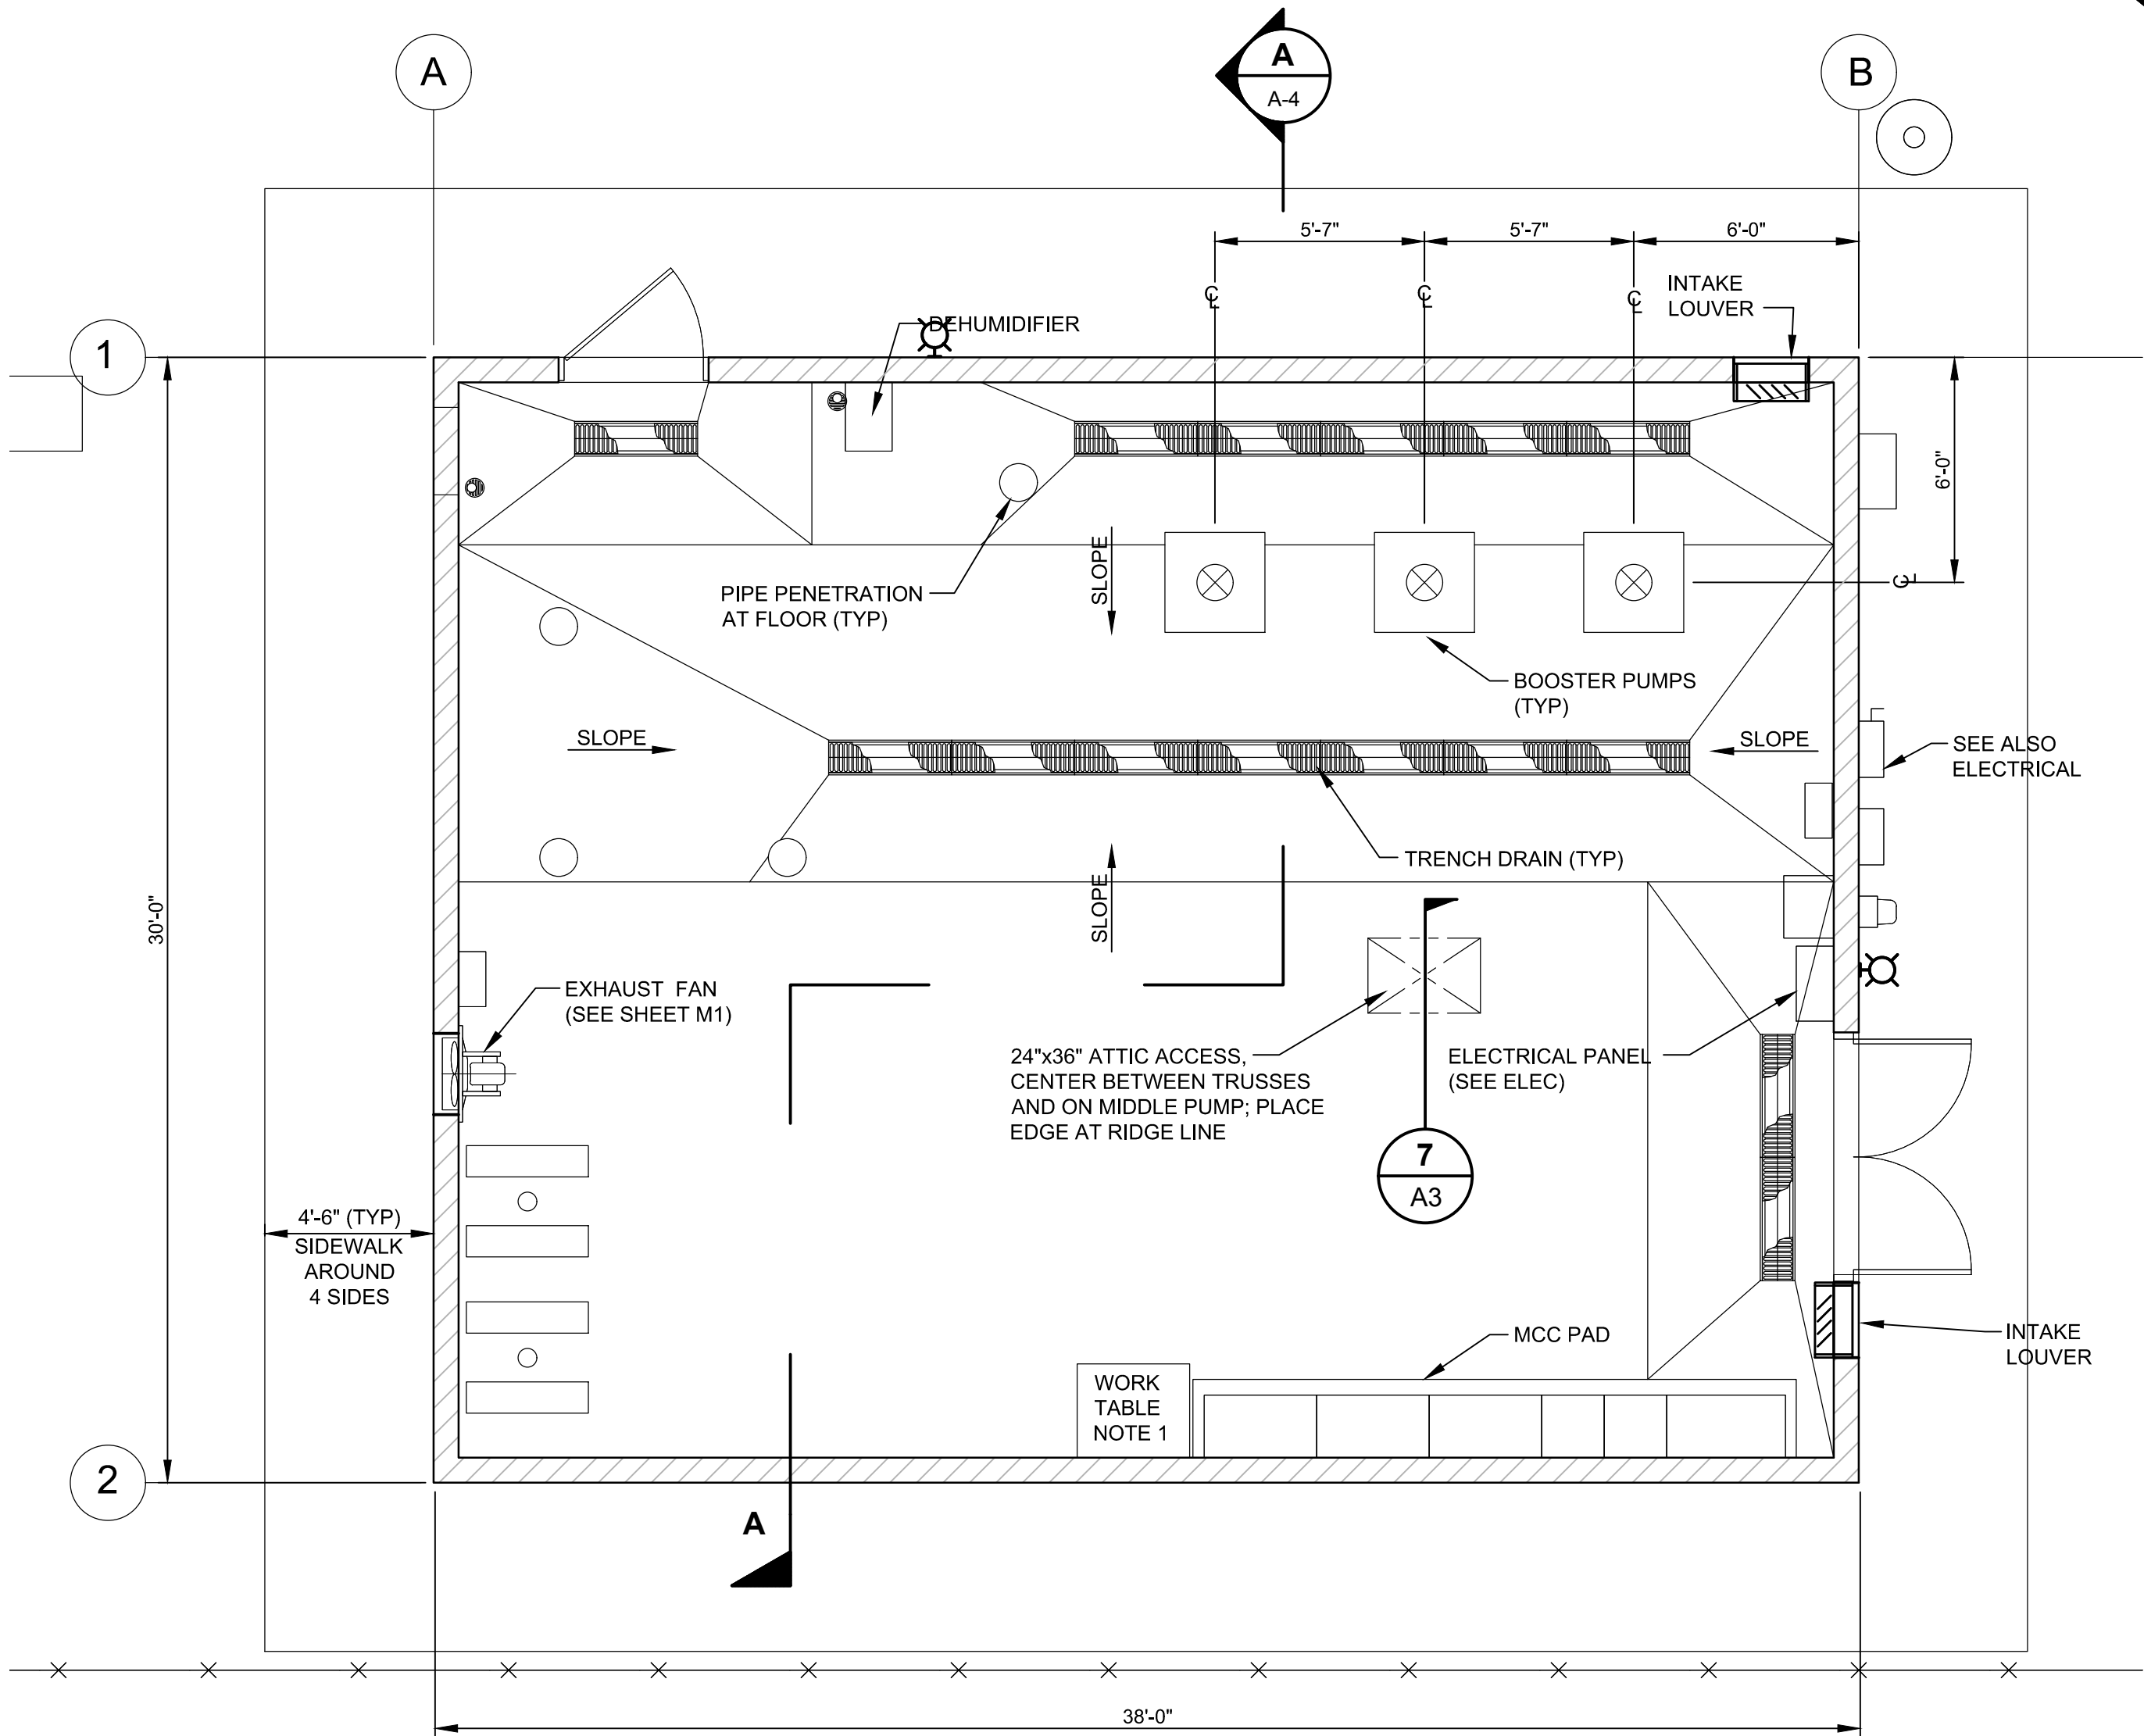

NOTES


1. WORK TABLE TO BE LOCKABLE SHOP DESK. GRAINGER MODEL NO. 4TX91 OR APPROVED EQUAL.

FLOOR PLAN


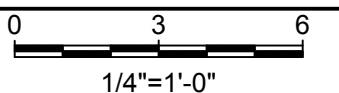


USE OF DOCUMENTS THIS DOCUMENT, INCLUDING THE INCORPORATED DESIGNS, IS AN INSTRUMENT OF SERVICE FOR THIS PROJECT AND SHALL NOT BE USED FOR ANY OTHER PROJECT WITHOUT THE WRITTEN AUTHORIZATION OF KENNEDY/JENKS CONSULTANTS.					<div>SCALES</div> <div>0 1" 0 25mm</div> <div>IF THIS BAR IS NOT DIMENSION SHOWN, ADJUST SCALES ACCORDINGLY.</div>	<div>4455 REGISTERED ARCHITECT</div> <div>MARK PRESTON</div> <div>STATE OF WASHINGTON</div>	DESIGNED	MP		CITY OF ISSAQUAH ISSAQUAH, WASHINGTON SOUTH SPAR BOOSTER PUMP STATION	Kennedy/Jenks Consultants FEDERAL WAY, WASHINGTON	PUMP STATION FLOOR PLAN AND CODE SUMMARY	FILE NAME	139700500-A001.DWG			
							DRAWN	MP					JOB NO.	1397005*00			
							CHECKED	JMF					DATE	NOVEMBER 2020			
	NO.	REVISION	DATE	BY			90% SUBMITTAL (REVISED 11/30/2020)						SHEET	OF			
													A1				



P:\CAD\131\1397005.00_City_of_Issaquah\139700500-A002.dwg 11/30/2020 10:21 AM MARKPRESTON

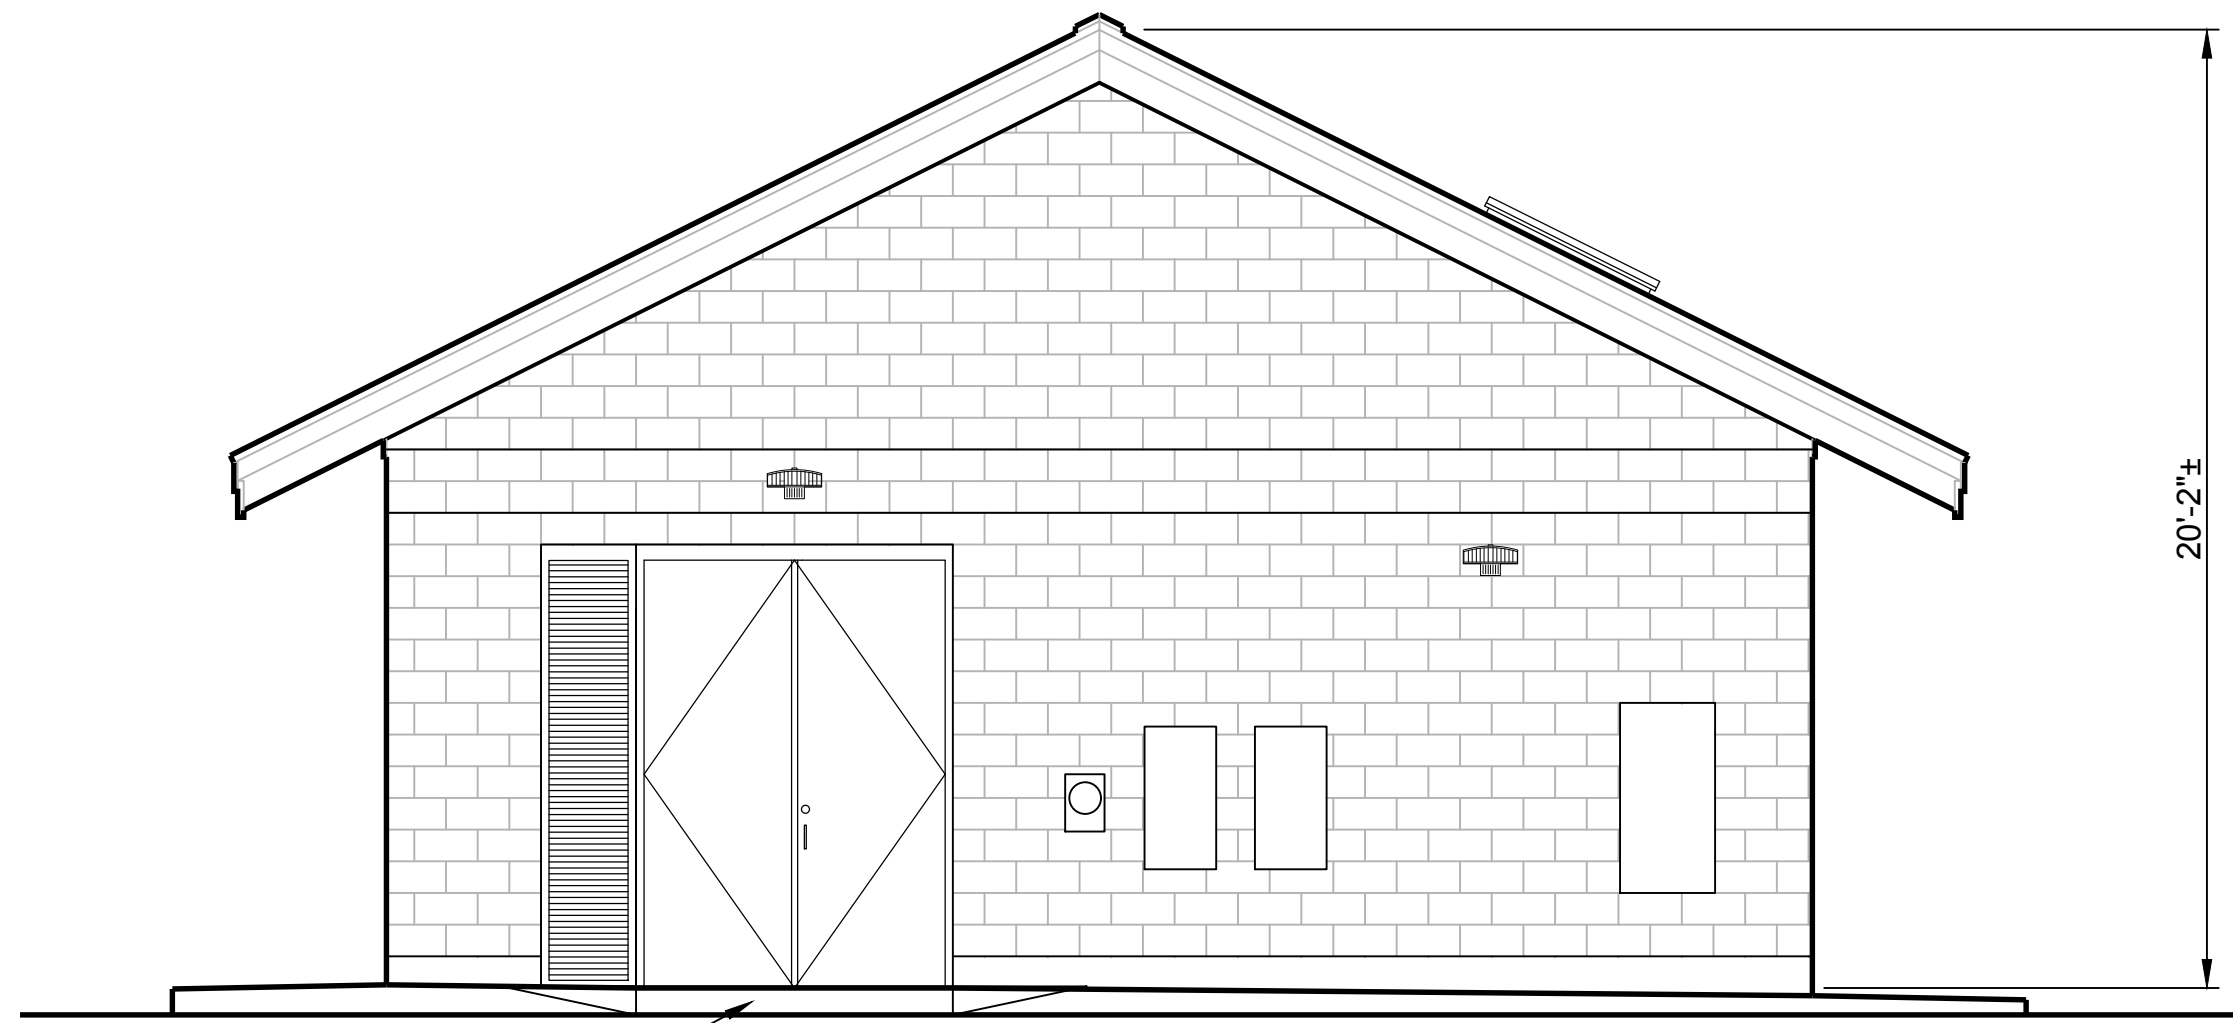



SOUTH ELEVATION

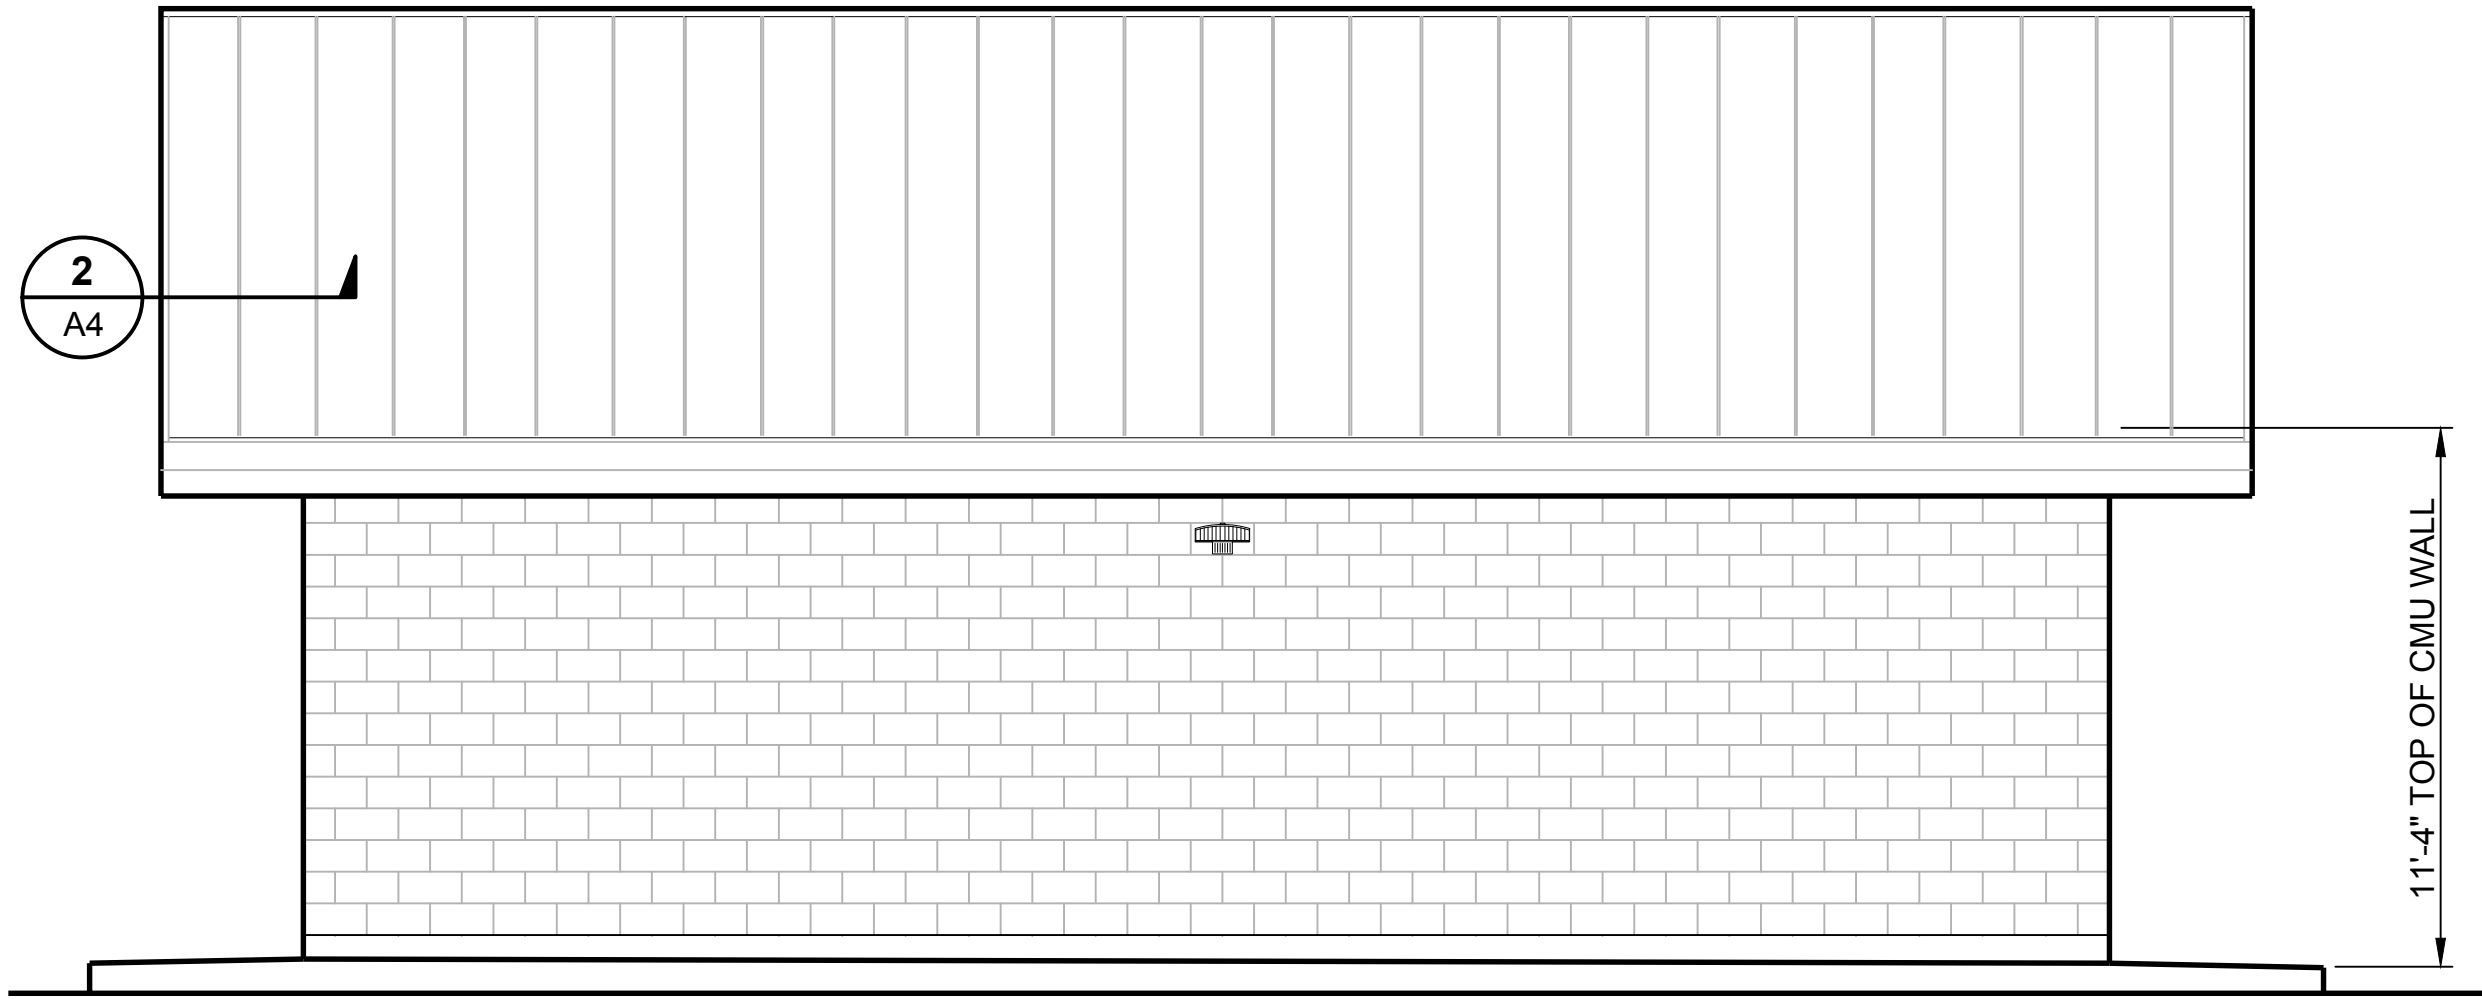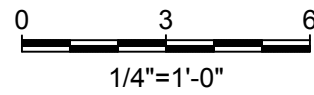


WEST ELEVATION

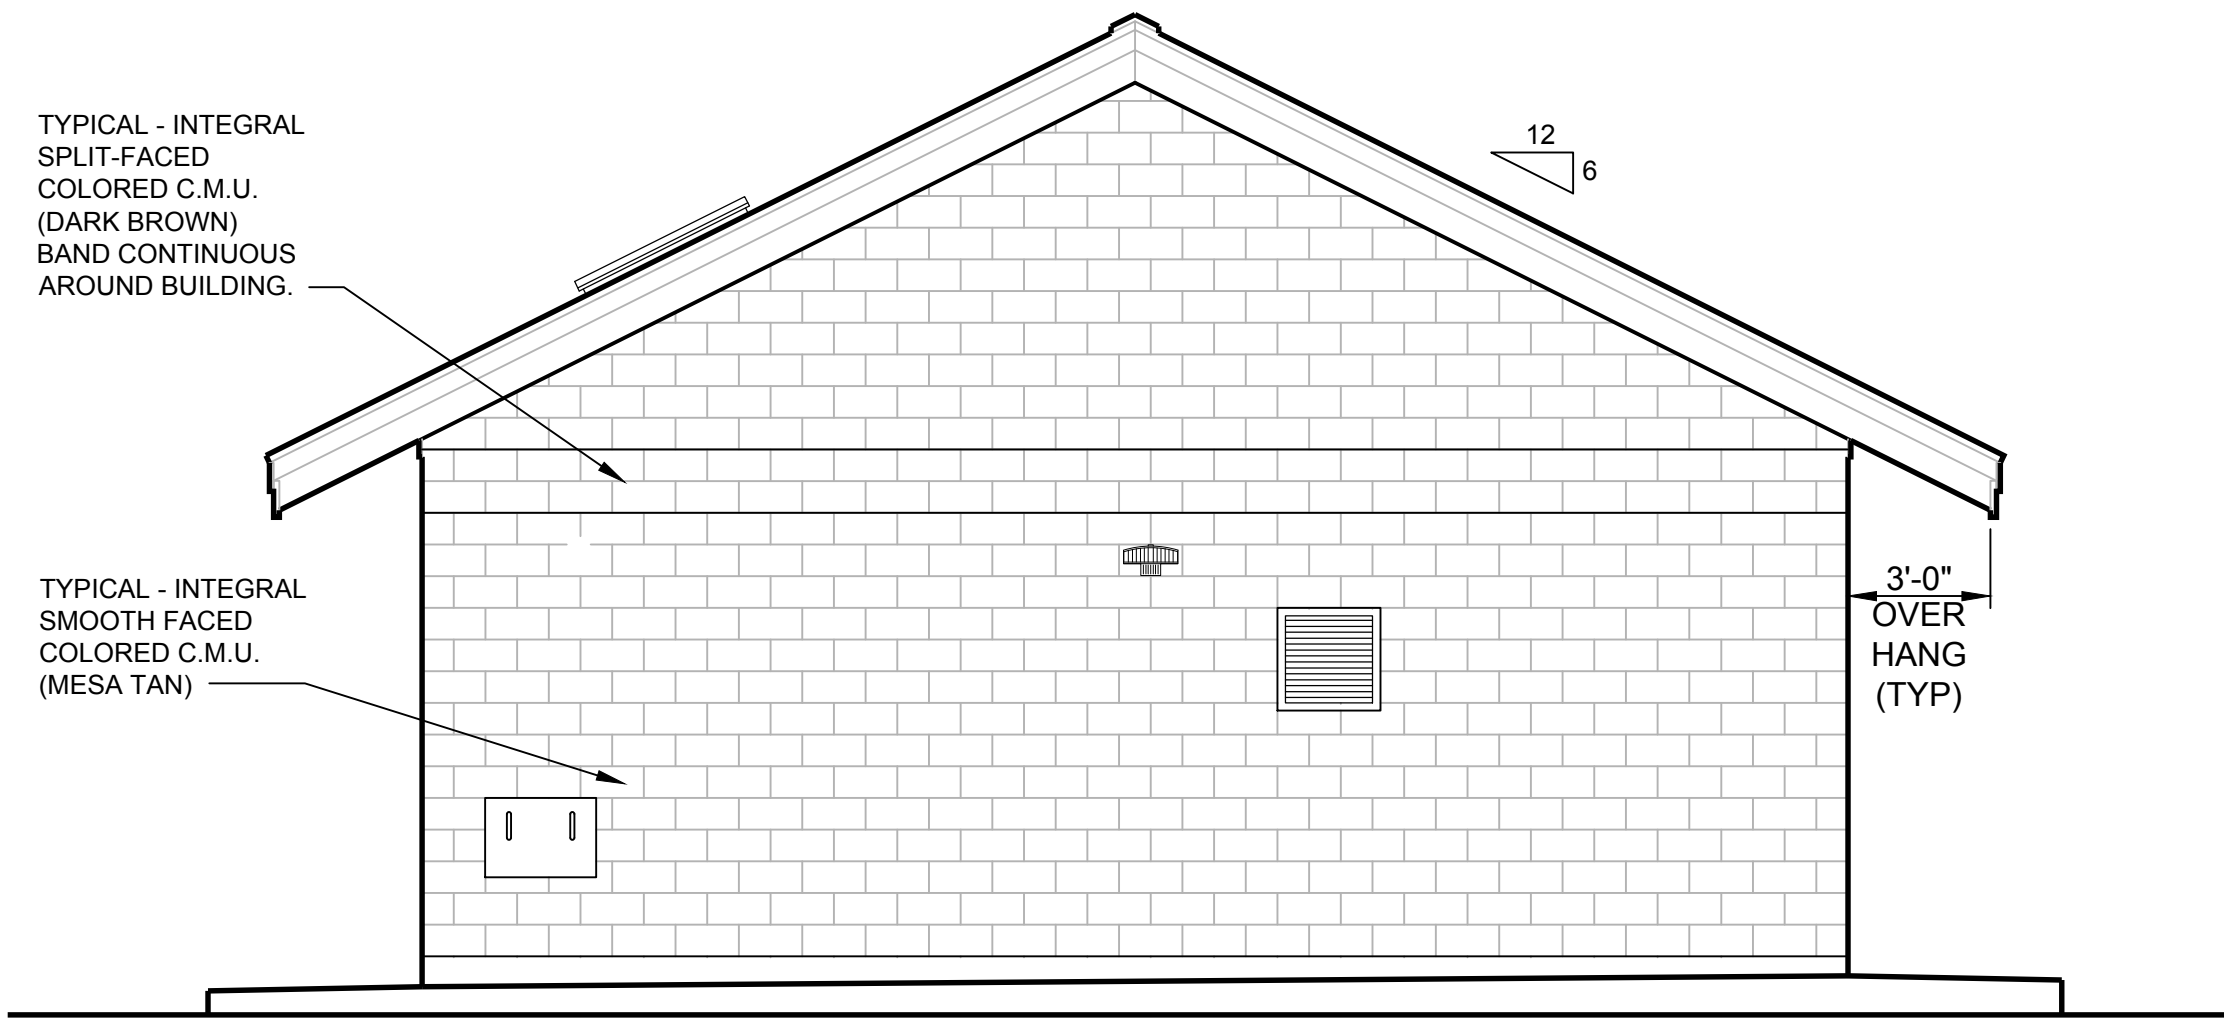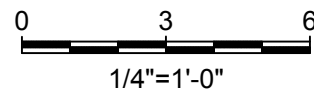

NORTH ELEVATION

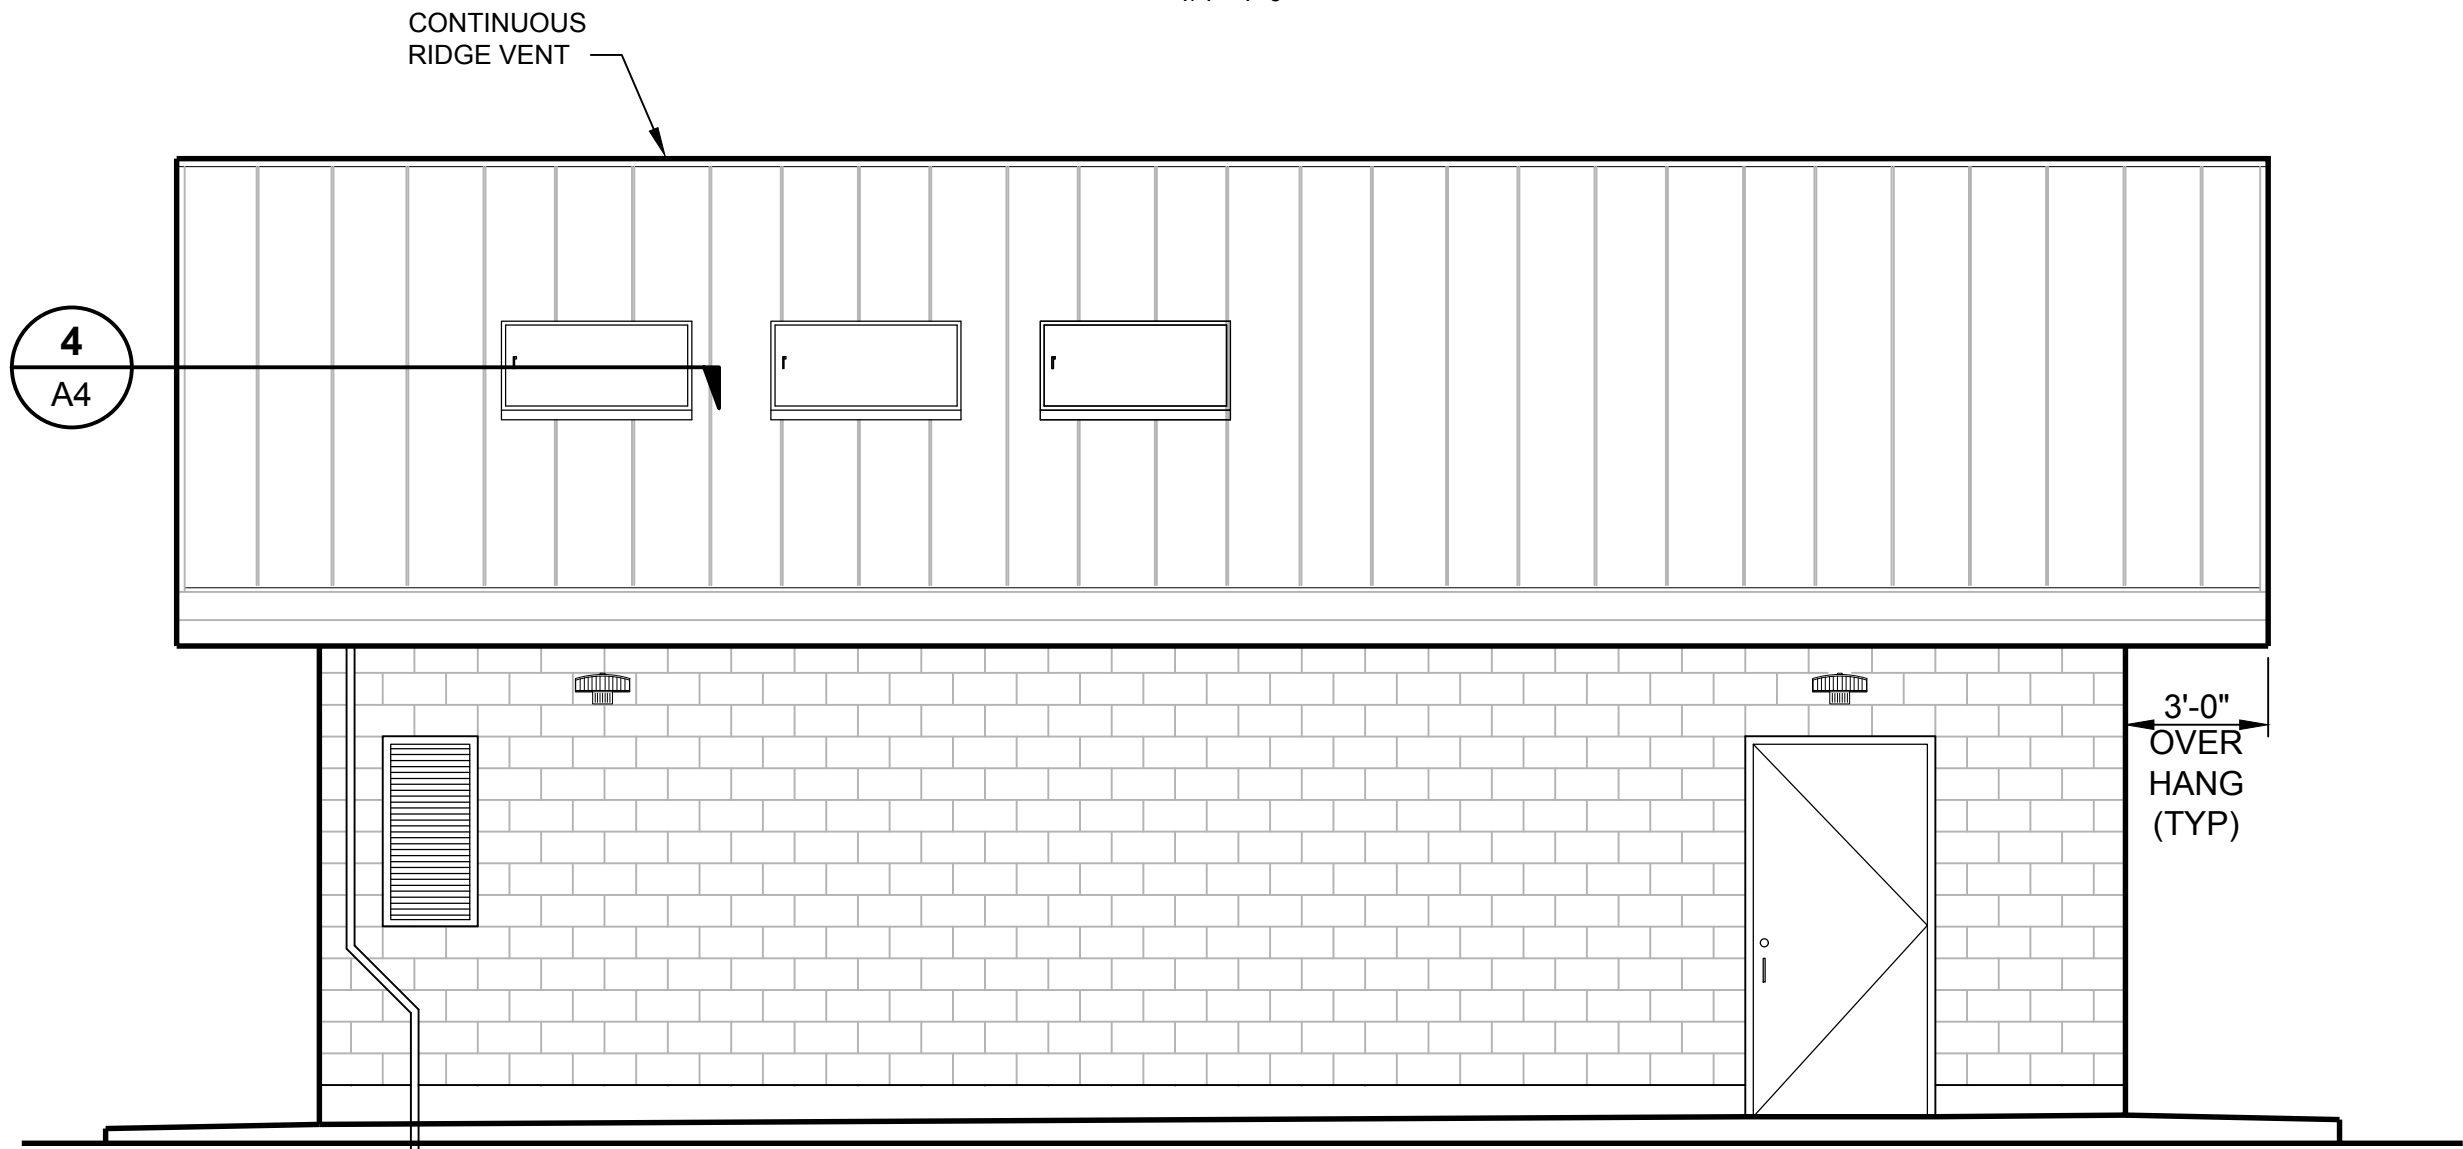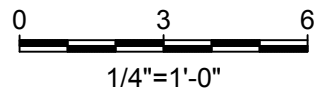

EAST ELEVATION

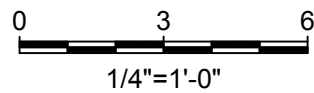

- NOTES:
1. CMU COLOR TO BE MESA TAN WITH TAN GROUT. ROOF TO BE JADE GREEN.
 2. DOORS, LOUVERS AND FRAMES TO BE SW 6748 "GREENS".

USE OF DOCUMENTS
THIS DOCUMENT, INCLUDING THE INCORPORATED DESIGNS, IS AN INSTRUMENT OF SERVICE FOR THIS PROJECT AND SHALL NOT BE USED FOR ANY OTHER PROJECT WITHOUT THE WRITTEN AUTHORIZATION OF KENNEDY/JENKS CONSULTANTS.

NO.	REVISION	DATE	BY

SCALES
0 1"
0 25mm
IF THIS BAR IS NOT DIMENSION SHOWN, ADJUST SCALES ACCORDINGLY.

4455 REGISTERED ARCHITECT
MARK PRESTON
STATE OF WASHINGTON

DESIGNED MP
DRAWN MP
CHECKED JMF



CITY OF ISSAQUAH
ISSAQUAH, WASHINGTON
SOUTH SPAR BOOSTER PUMP STATION

Kennedy/Jenks Consultants
FEDERAL WAY, WASHINGTON

**PUMP STATION
EXTERIOR ELEVATIONS**

90% SUBMITTAL (REVISED 11/30/2020)

FILE NAME
139700500-A002.DWG
JOB NO.
1397005*00
DATE
NOVEMBER 2020
SHEET OF
A2

P:\CAD\131\1397005_00_City_of_Issaquah\139700500-A003.dwg 11/30/2020 9:56 AM MARKPRESTON

FINISH SCHEDULE																
	ROOM	FLOOR		BASE		WALL								CEILING		
NO.	NAME	MATERIAL	FINISH	MATERIAL	FINISH	NORTH		WEST		SOUTH		EAST		MATERIAL	FINISH	HEIGHT
						MATERIAL	FINISH	MATERIAL	FINISH	MATERIAL	FINISH	MATERIAL	FINISH			
01	PUMP ROOM	CONC	FS	N/A	---	CMU	PTS	CMU	PTS	CMU	PTS	CMU	PTS	MGP	PTS	SLOPED

FINISH SCHEDULE NOTES

1. SEAL ALL EXPOSED EXTERIOR MASONRY WITH WATER RESISTANT SEALER/ANTI-GRAFFITI COATING.
2. PROVIDE BLOCK FILLER AND PAINT ALL EXPOSED INTERIOR CMU SURFACES.
3. COLOR OF DOORS AND FRAMES, SHALL BE SELECTED BY OWNER FROM MANUFACTURER'S FULL PALETTE.

FINISH SCHEDULE

ABBREVIATIONS

CMU = CONCRETE MASONRY UNIT
CONC = CONCRETE
FS = FLOOR SEALER - SEE ALSO SPECIFICATION SECTION 6-20.2(1)D
PTS = PAINT TO SPECIFICATIONS
MGP = MARINE-GRADE PLYWOOD


DOOR SCHEDULE													
ROOM		DOOR		DOOR		FRAME			ASSEMBLY		REMARKS		
NO.	NAME	NO.	WIDTH X HEIGHT	TYPE	MATERIAL	THERMAL VALUE	MATERIAL	HEAD	JAMB	SILL	HDWRE GROUP	FIRE RATING	
01	PUMP ROOM	01	6'-4" X 9'-0"	A	HM	-	HM	4/A3	5/A3	6/A3	1	-	INTEGRAL LOUVER SIDELITE
01	PUMP ROOM	02	3'-8" X 7'-10"	B	HM	-	HM	4/A3	5/A3	6/A3	2	-	

DOOR SCHEDULE NOTES



1. ALL EXIT DOORS SHALL BE OPERABLE FROM THE INSIDE WITHOUT THE USE OF A KEY OR SPECIAL KNOWLEDGE PER 2012 IBC 1008.1.8.
2. SEE SPECIFICATIONS FOR HARDWARE.

ABBREVIATIONS



HM = HOLLOW METAL

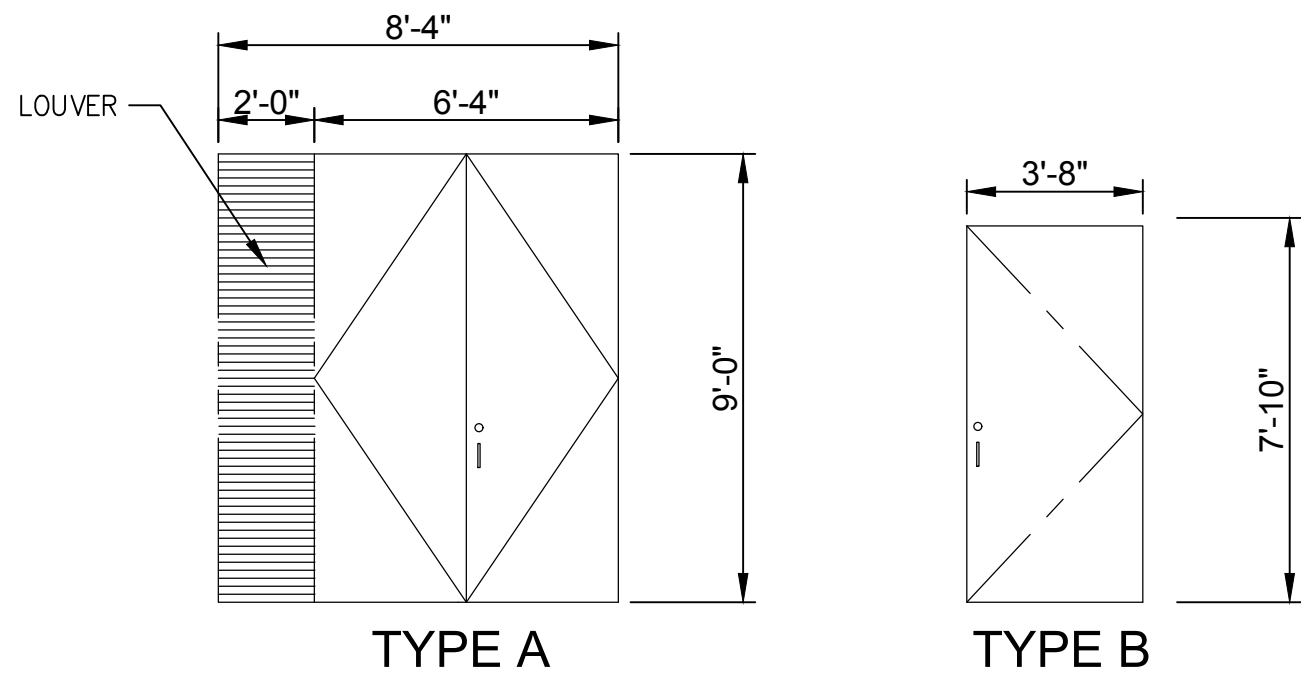



DOOR ELEVATIONS

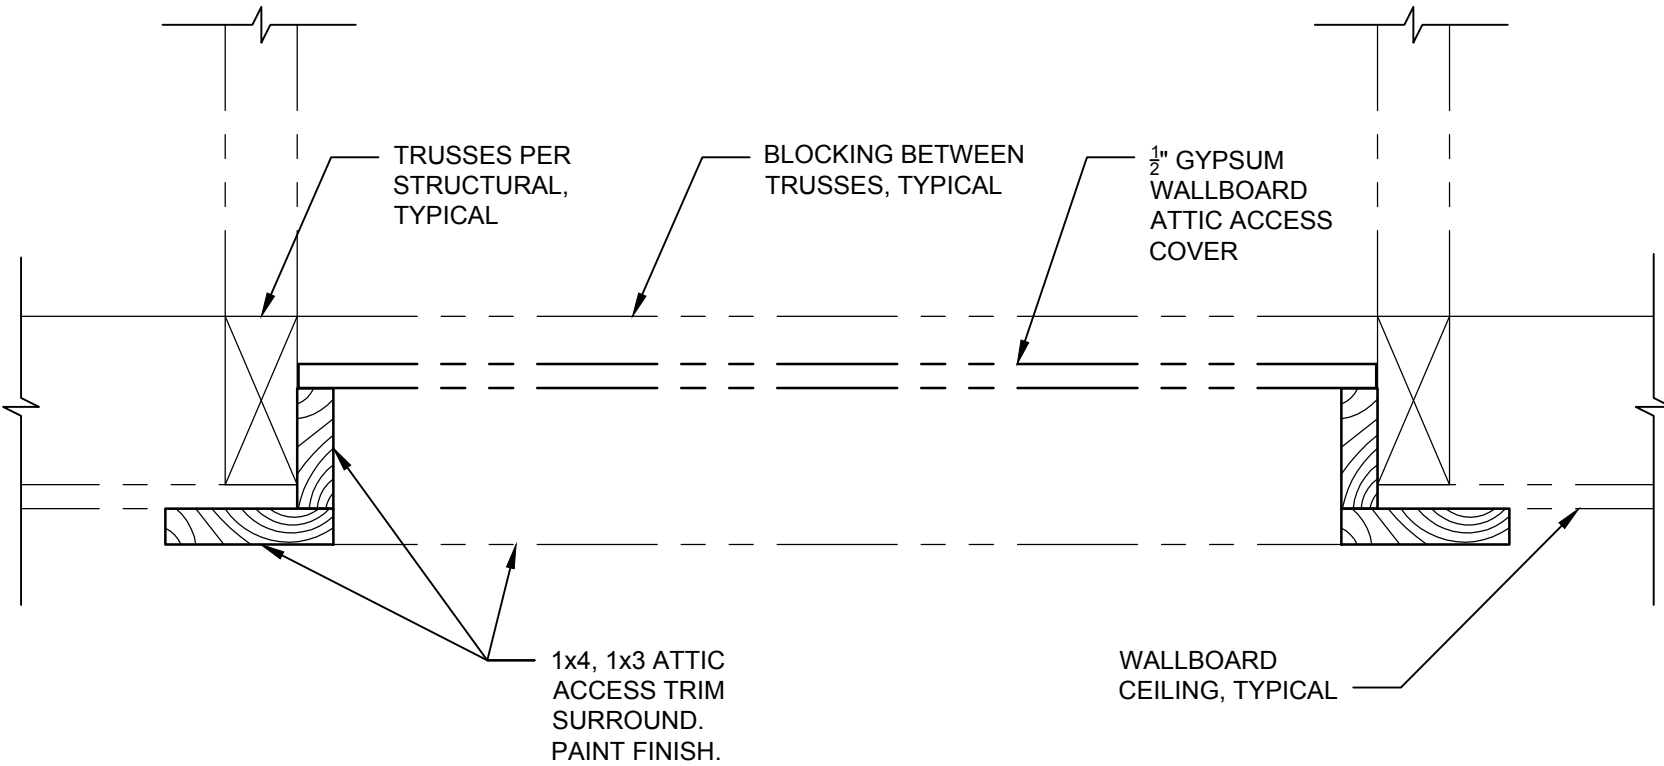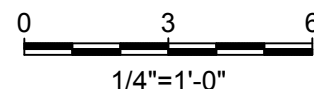



ATTIC ACCESS DETAIL

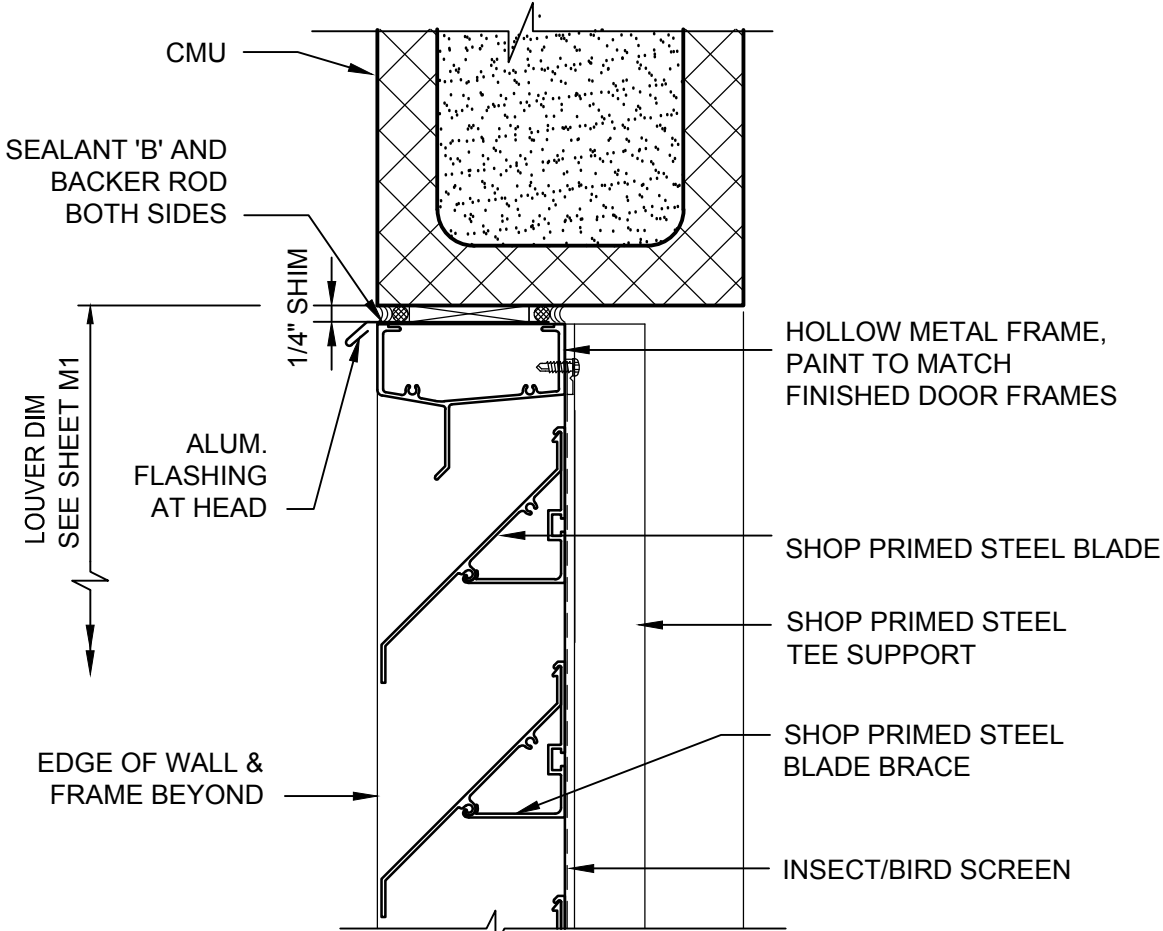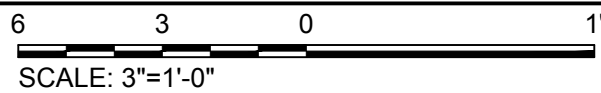



LOUVER HEAD DETAIL

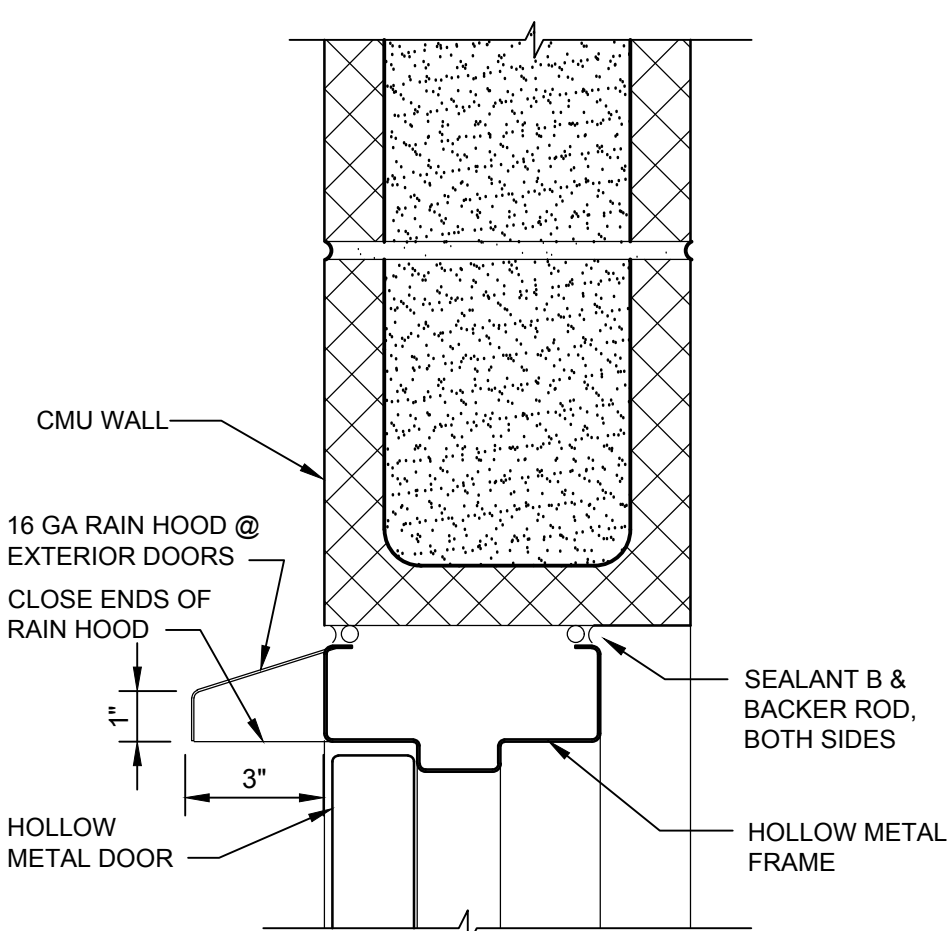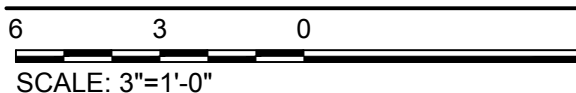



HM DOOR HEAD DETAIL

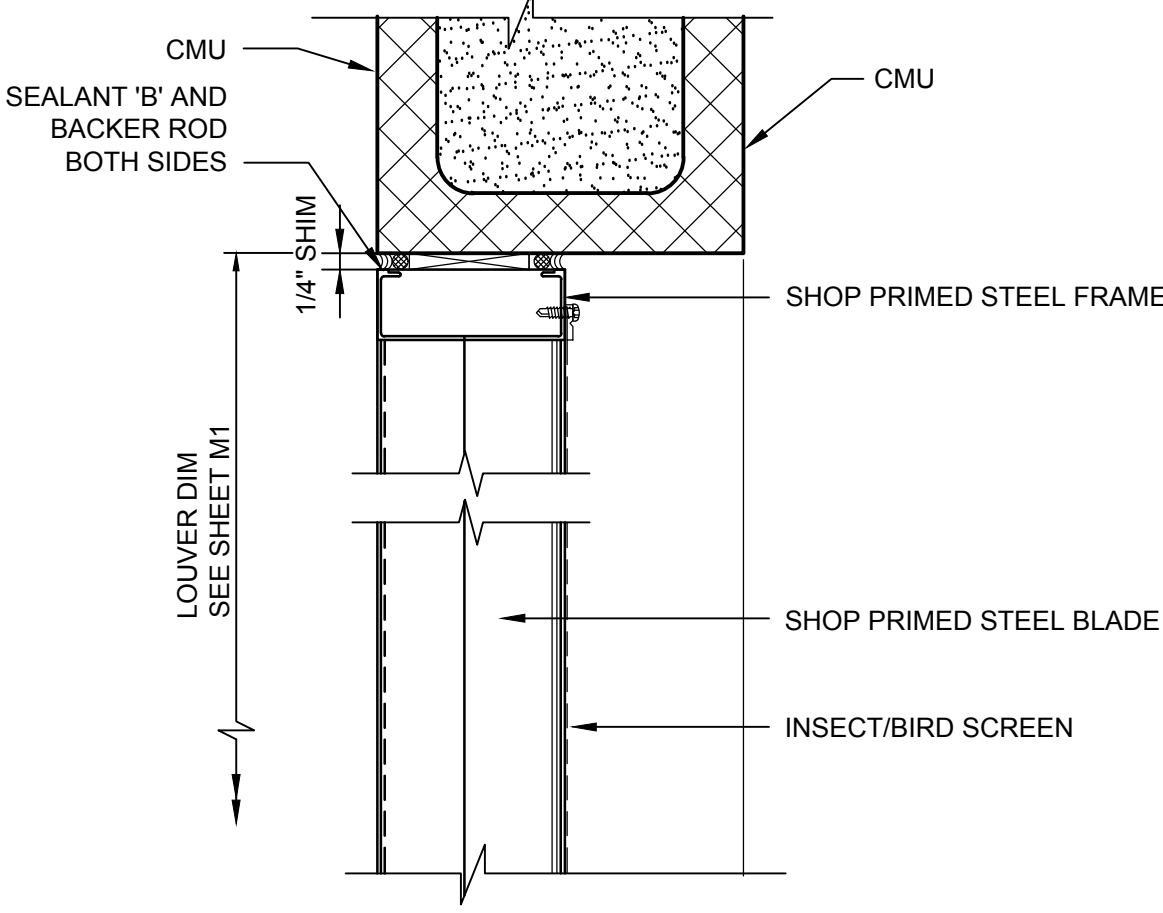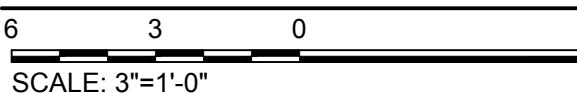



LOUVER JAMB DETAIL

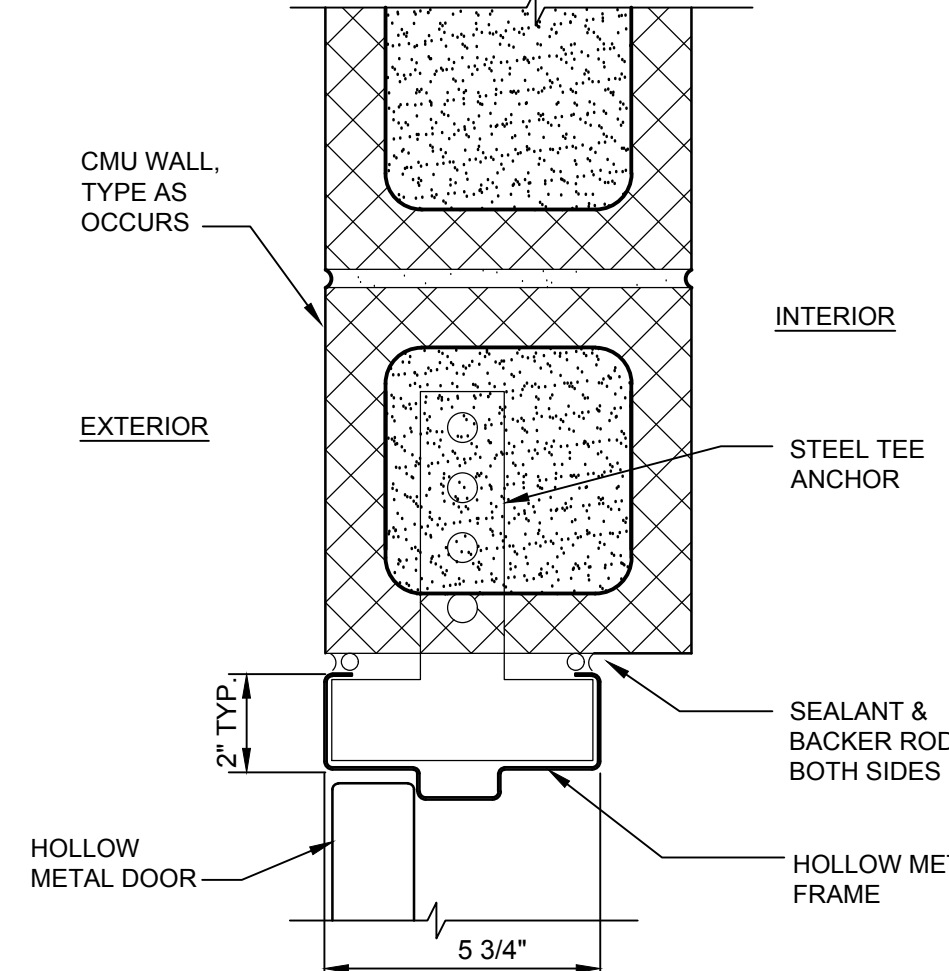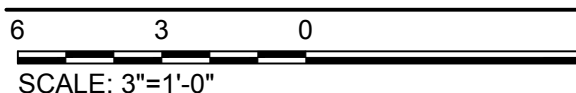


HM DOOR JAMB DETAIL

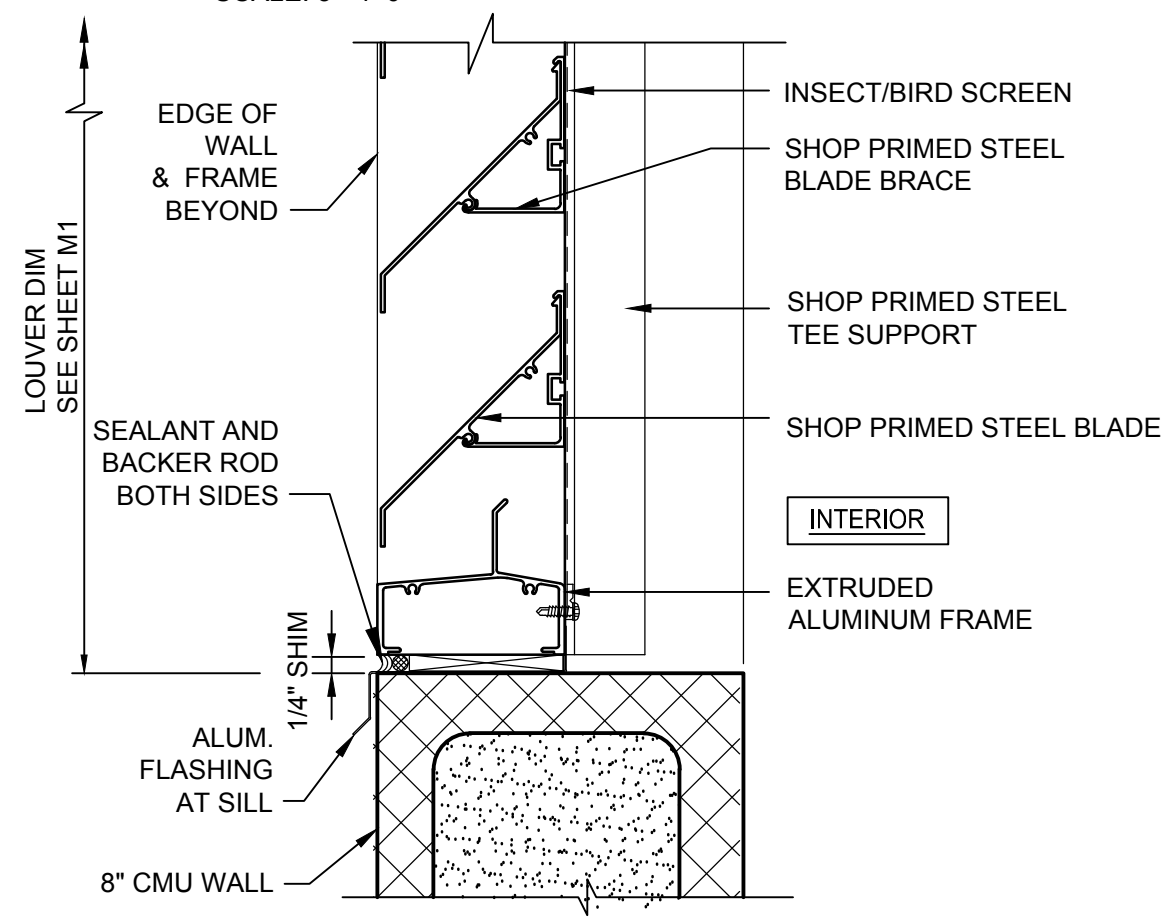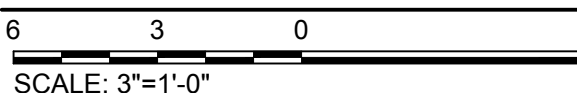

LOUVER SILL DETAIL

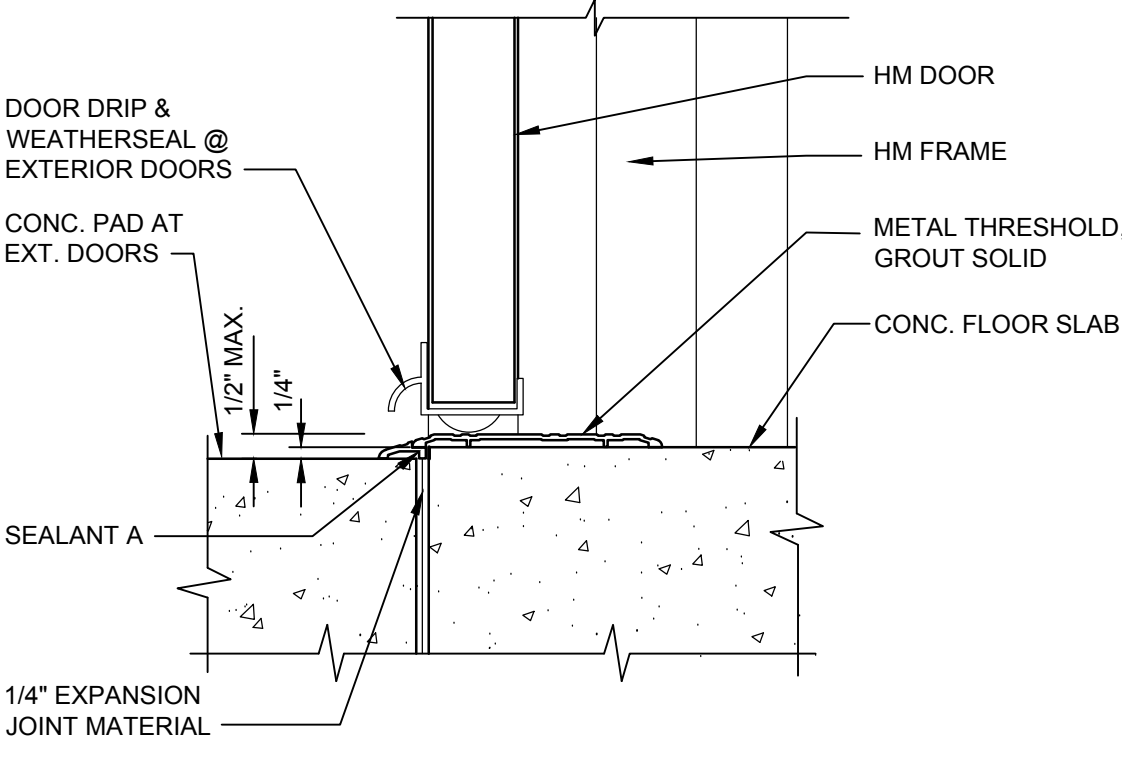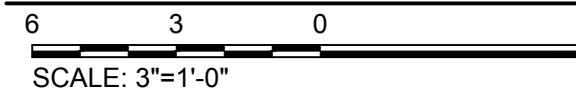



HM DOOR SILL DETAIL

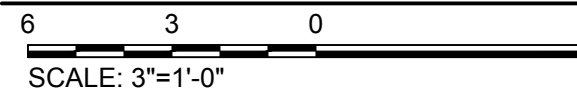

USE OF DOCUMENTS

THIS DOCUMENT, INCLUDING THE INCORPORATED DESIGNS, IS AN INSTRUMENT OF SERVICE FOR THIS PROJECT AND SHALL NOT BE USED FOR ANY OTHER PROJECT WITHOUT THE WRITTEN AUTHORIZATION OF KENNEDY/JENKS CONSULTANTS.

NO.	REVISION	DATE	BY
-----	----------	------	----

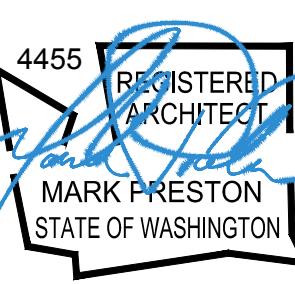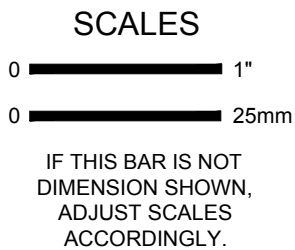

DESIGNED	MP
DRAWN	MP
CHECKED	JMF



CITY OF ISSAQUAH
ISSAQUAH, WASHINGTON
SOUTH SPAR BOOSTER PUMP STATION


Kennedy/Jenks Consultants
FEDERAL WAY, WASHINGTON

PUMP STATION DOOR AND
FINISH SCHEDULES AND DETAILS


90% SUBMITTAL (REVISED 11/30/2020)

FILE NAME	139700500-A003.DWG
JOB NO.	1397005'00
DATE	NOVEMBER 2020
SHEET	OF
A3	


P:\CAD\131\1397005_00_City_of_Issaquah\139700500-A004.dwg 11/29/2020 10:49 AM JEANL 4

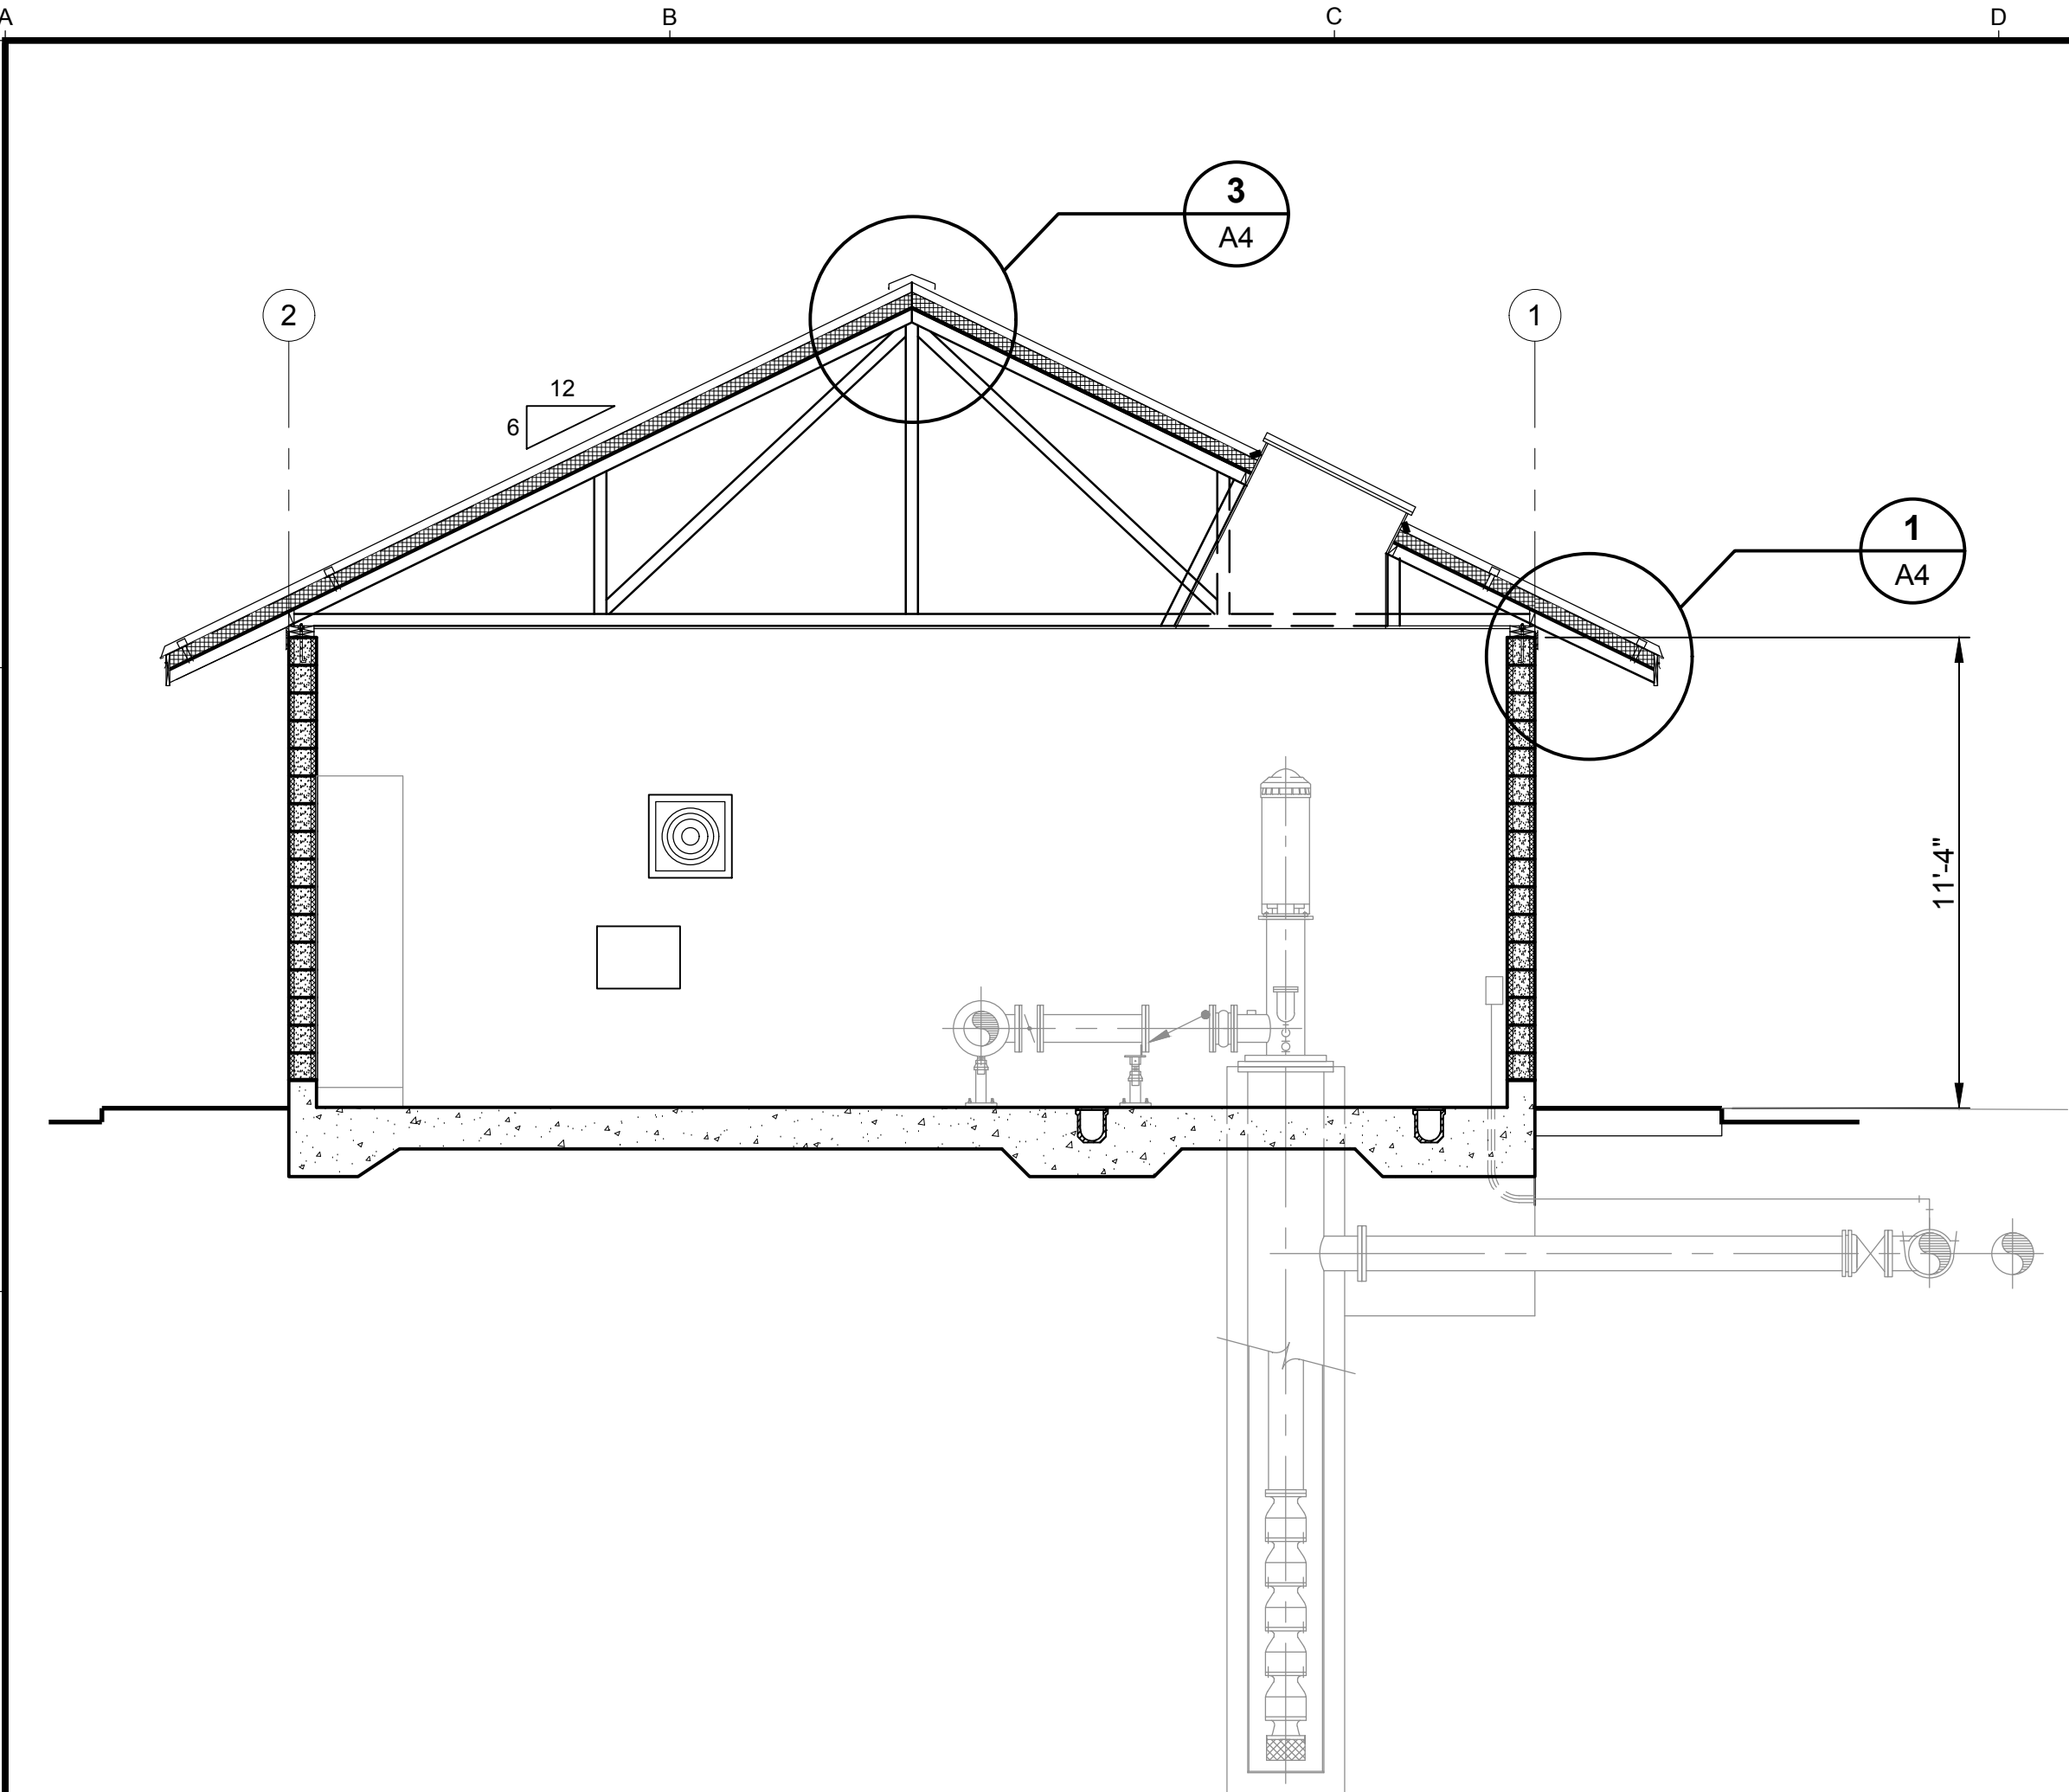


BUILDING SECTION
A
A1
0 3 6
1/4"=1'-0"

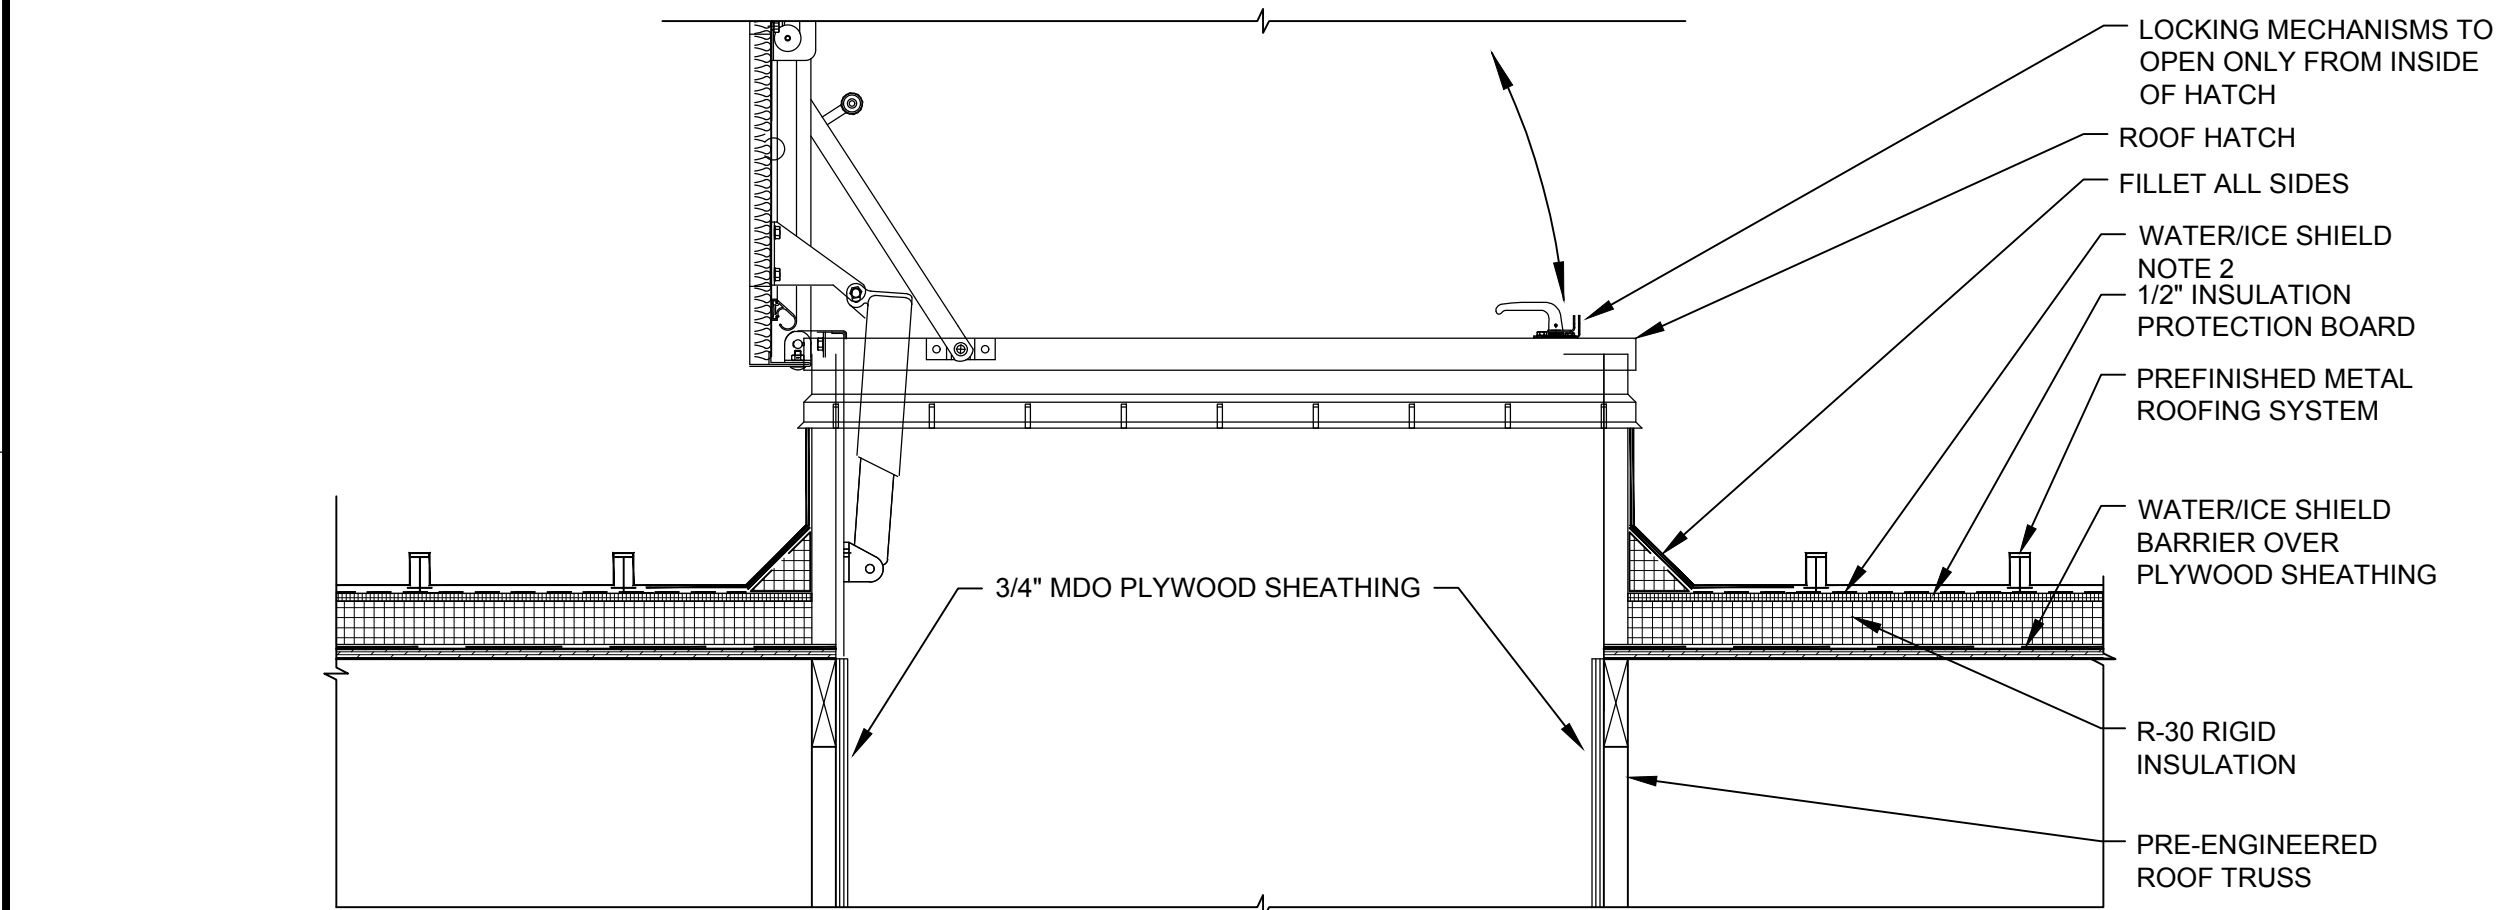


ROOF HATCH DETAIL
4
A2
0 1
1 1/2"=1'-0"

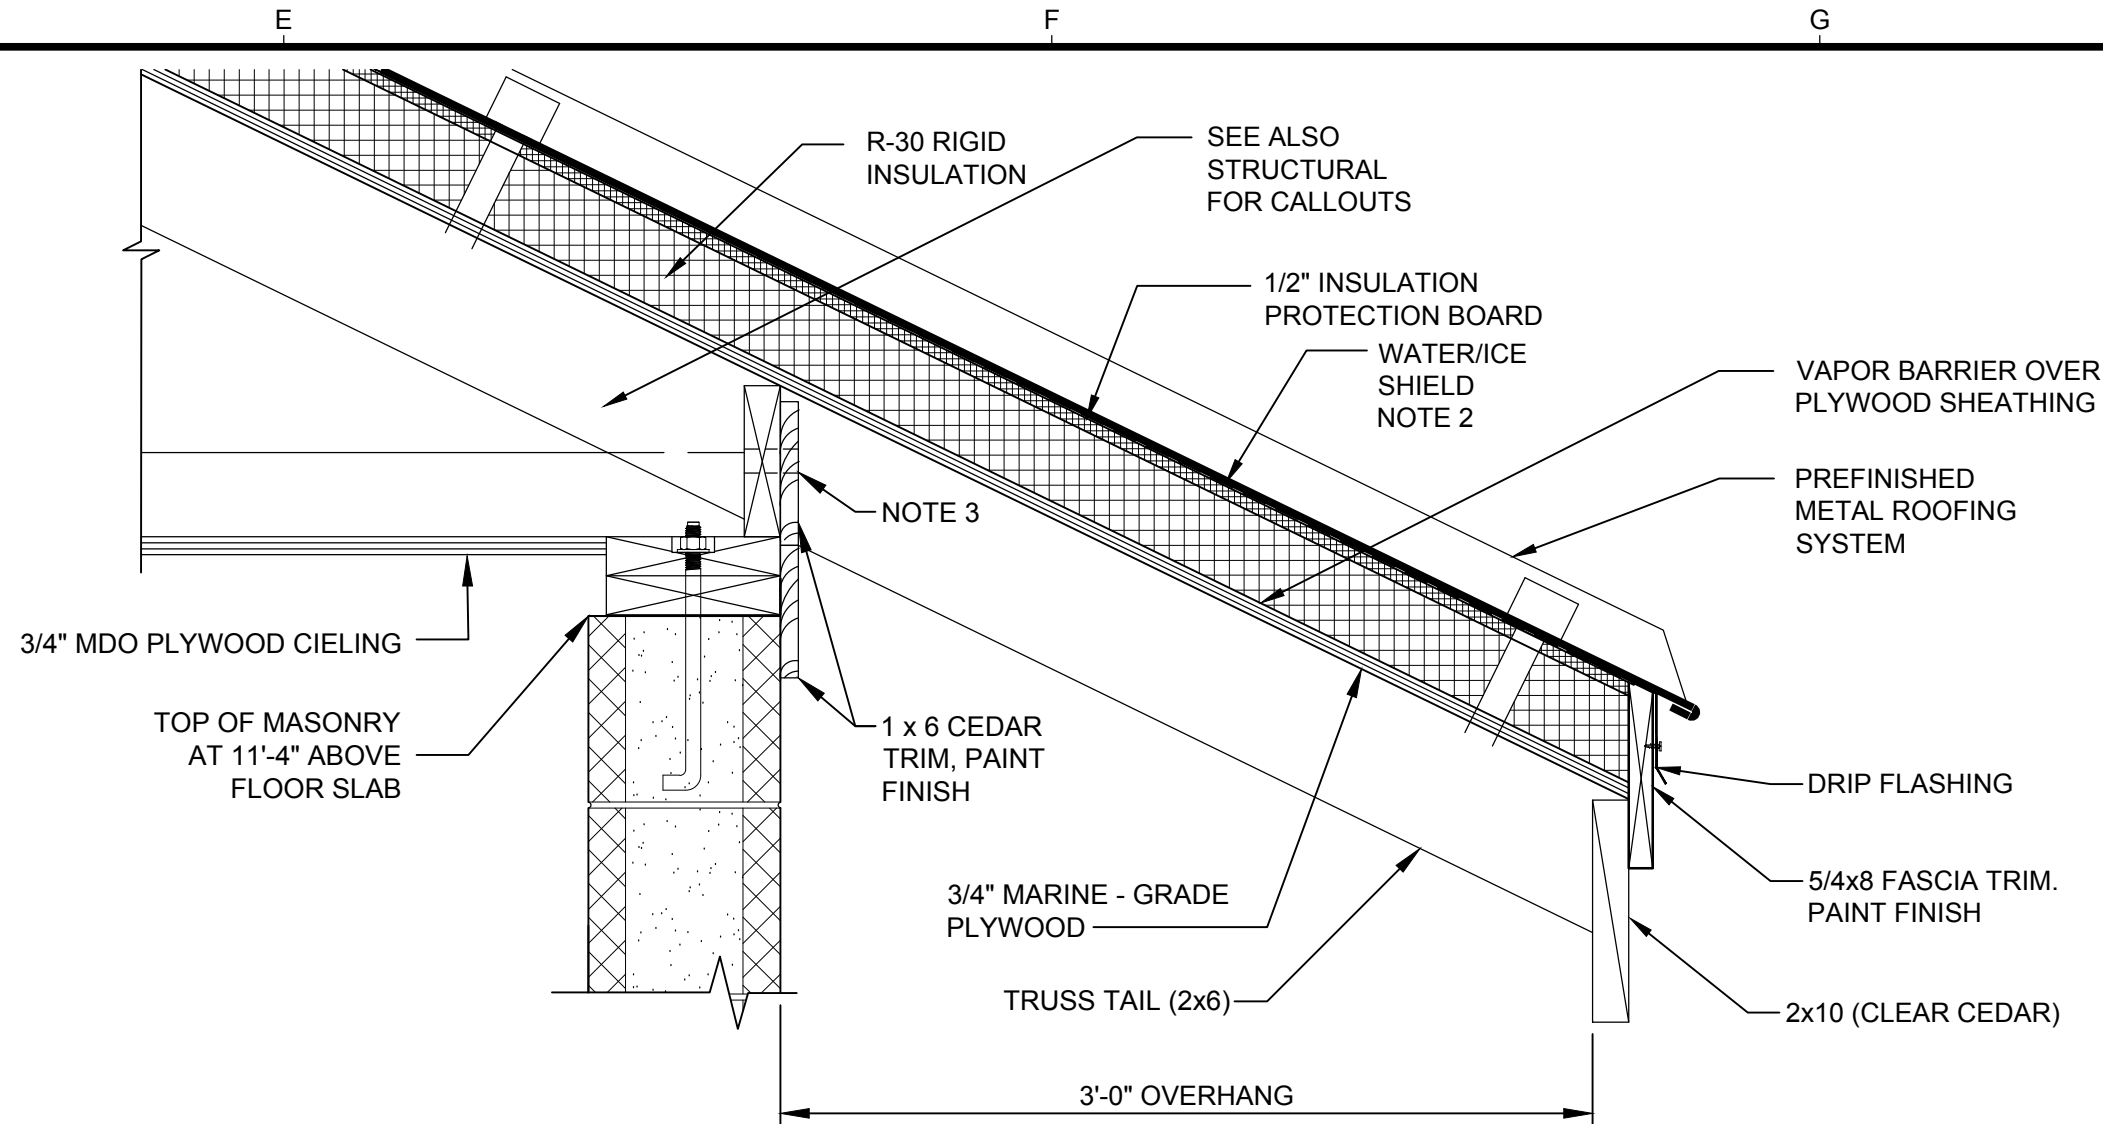

EAVE DETAIL
1
A4
0 1
1 1/2"=1'-0"

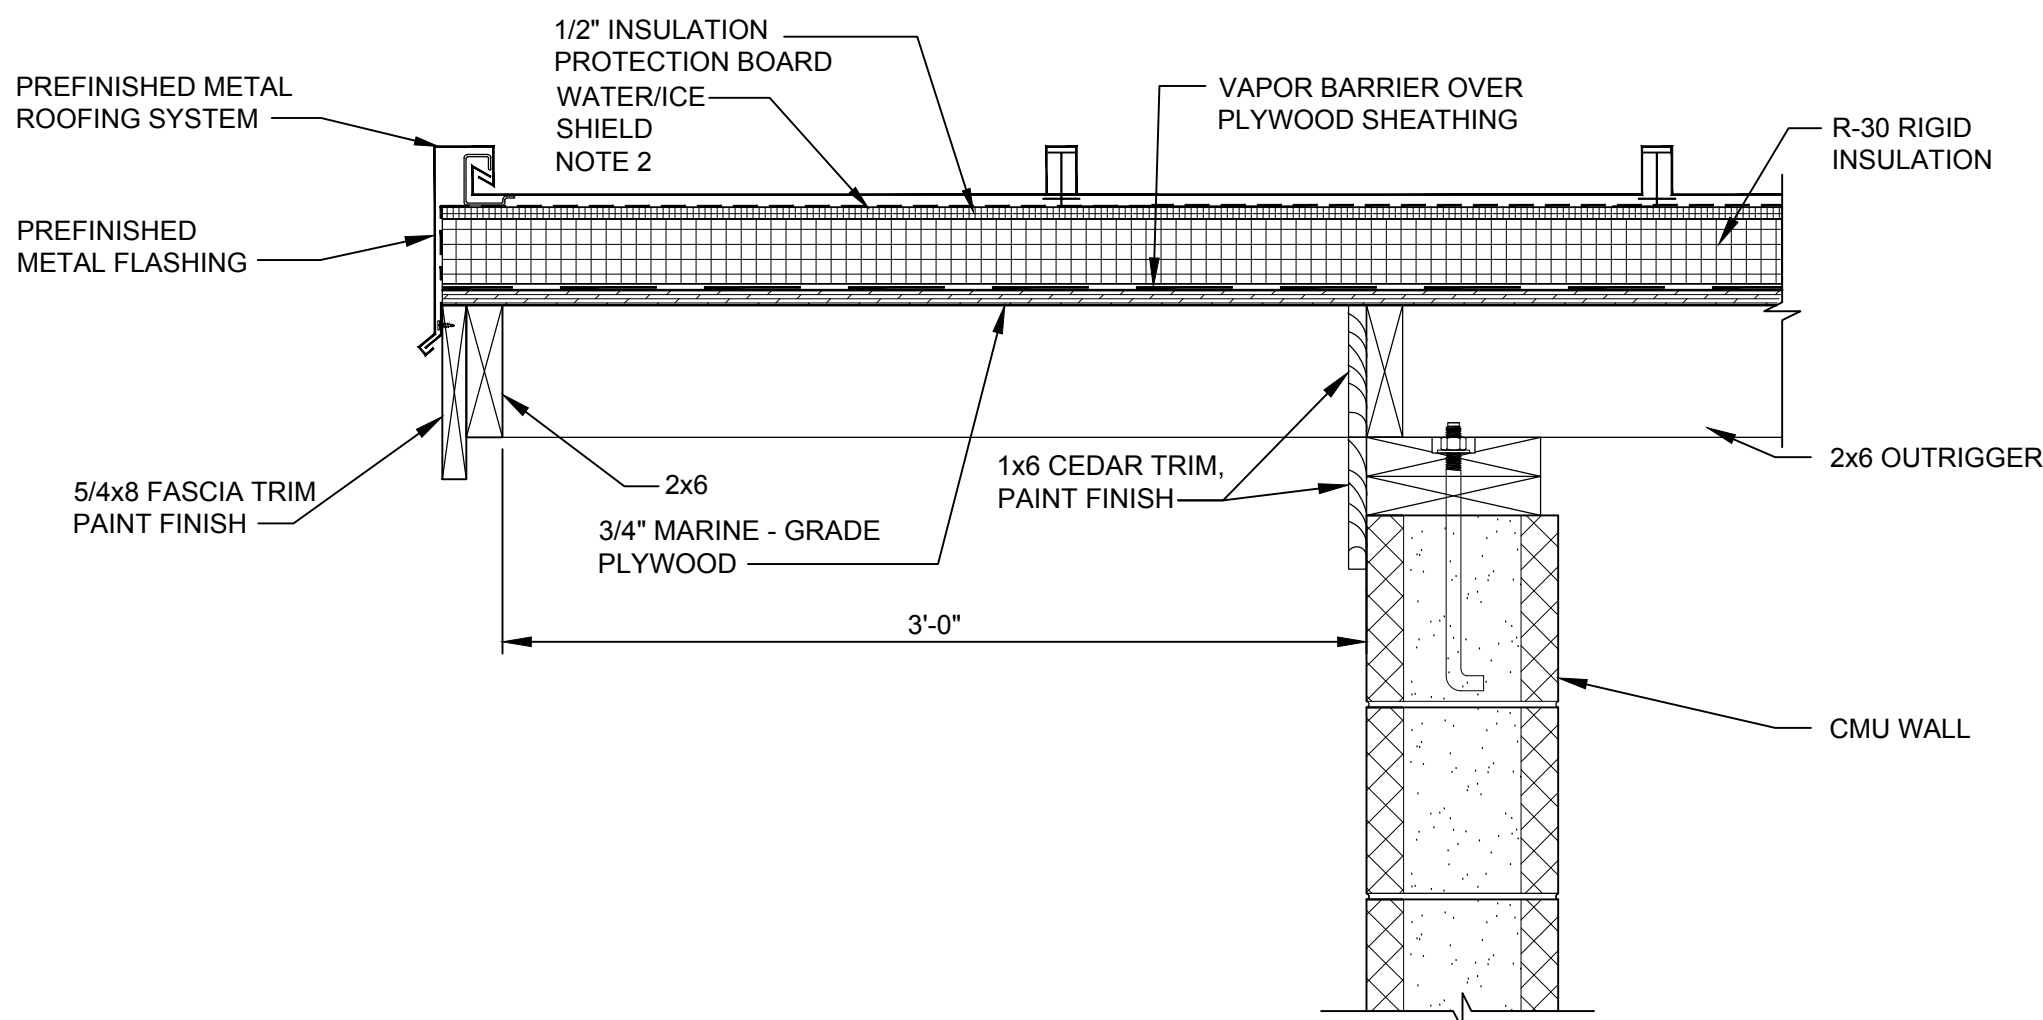


RAKE DETAIL
2
A2
0 1
1 1/2"=1'-0"

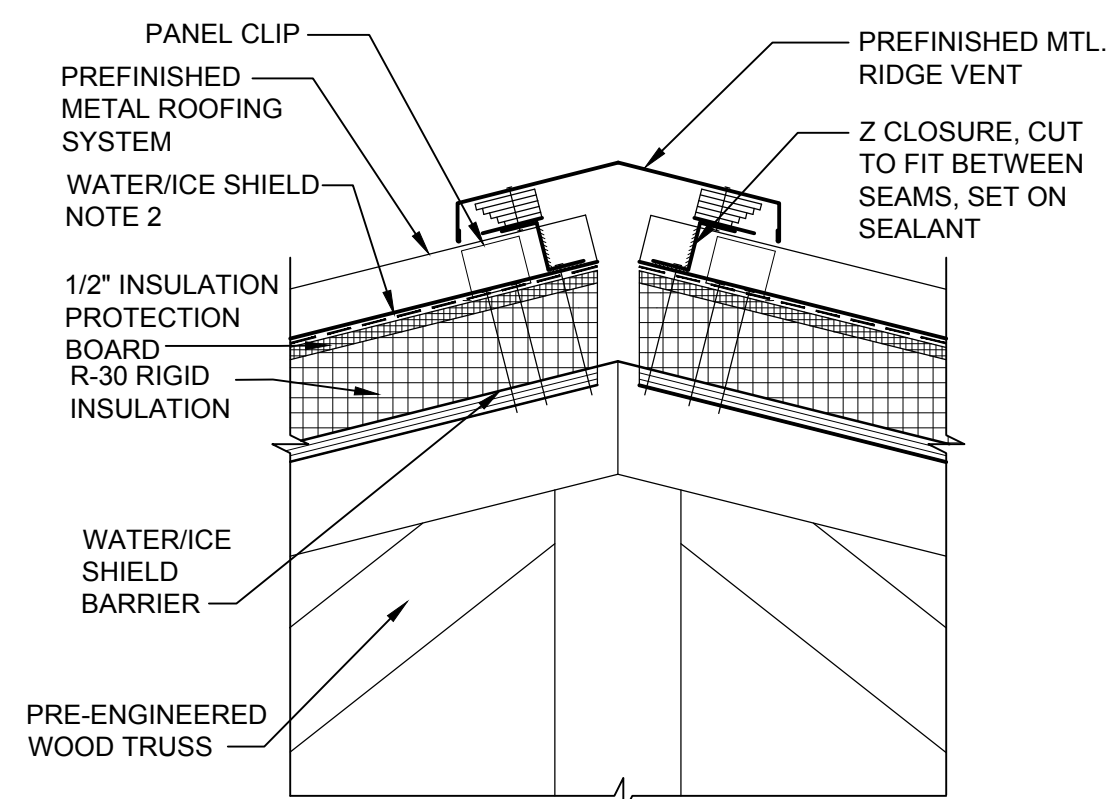

RIDGE DETAIL
3
A4
0 1
1 1/2"=1'-0"

- NOTES:**
1. ALL EXPOSED PLYWOOD AND WOOD TRIM TO BE PAINTED.
 2. WATER/ICE SHIELD TO BE CARLISLE WIP 300 HT.
 3. VENT BLOCKING WITH INSECT SCREEN, CONTINUOUS BETWEEN TRUSSES AT BOTH EAVES. PROVIDE MATCHING ALIGNED VENTILATION HOLES AT CEDAR TRIM."

<div>USE OF DOCUMENTS</div> <div>THIS DOCUMENT, INCLUDING THE INCORPORATED DESIGNS, IS AN INSTRUMENT OF SERVICE FOR THIS PROJECT AND SHALL NOT BE USED FOR ANY OTHER PROJECT WITHOUT THE WRITTEN AUTHORIZATION OF KENNEDY/JENKS CONSULTANTS.</div>					<div>SCALES</div> <div><div>01"25mm</div></div> <div>IF THIS BAR IS NOT DIMENSION SHOWN, ADJUST SCALES ACCORDINGLY.</div>	<div>4455 REGISTERED ARCHITECT</div> <div>Mark Preston</div> <div>MARK PRESTON</div> <div>STATE OF WASHINGTON</div>	DESIGNED	MP	<div></div> <div>CITY OF ISSAQUAH</div> <div>ISSAQUAH, WASHINGTON</div> <div>SOUTH SPAR BOOSTER PUMP STATION</div> <div>Kennedy/Jenks Consultants</div> <div>FEDERAL WAY, WASHINGTON</div>	<div>PUMP STATION BUILDING SECTION AND DETAILS</div> <div>90% SUBMITTAL (REVISED 11/30/2020)</div>		FILE NAME	139700500-A004.DWG
	DRAWN	MP	JOB NO.	1397005*00									
	CHECKED	JMF	DATE	NOVEMBER 2020									
			SHEET	OF									
			A4										
	NO.	REVISION	DATE	BY									

2/23/2021 3:22 PM

STEVEPRITCHETT

\\gic\ic-root\KJ-Cad\FederalWay\CAD\131\1397005.00_City_of_Issaquah\139700500-S001.dwg

GENERAL STRUCTURAL NOTES

GENERAL

- DESIGN AND CONSTRUCTION SHALL CONFORM TO THE 2015 INTERNATIONAL BUILDING CODE WITH AMENDMENTS ADOPTED INTO THE WASHINGTON STATE BUILDING CODE AND THE REFERENCED BUILDING CODE STANDARDS.
- THESE NOTES AS WELL AS THE TYPICAL DETAILS APPLY TO ALL PARTS OF THE PROJECT UNLESS NOTED OTHERWISE.
- SHOP DRAWINGS FOR THIS CONTRACT SHALL BE COORDINATED WITH FAVORABLY REVIEWED EQUIPMENT MANUFACTURER'S DRAWINGS.
- DIMENSIONS NOTED WITH AN ASTERISK, * * *, ARE TO BE COORDINATED WITH FAVORABLY REVIEWED SUBMITTAL BY THE EQUIPMENT MANUFACTURER.
- DETAILS CALLED OUT WITH [S-XXXX] SHALL REFER TO THE STANDARD DETAIL FOR WHICH THEY ARE SO NAMED.

PERMITS AND INSPECTIONS

- THE CONTRACTOR IS RESPONSIBLE FOR OBTAINING ALL PERMITS AND INSPECTIONS REQUIRED BY THE LOCAL BUILDING INSPECTOR.
- THE CONTRACTOR SHALL SELECT, INSTALL AND MAINTAIN SHORING, SHEETING, BRACING AND SLOPING AS NECESSARY TO MAINTAIN SAFE EXCAVATIONS. THE CONTRACTOR SHALL BE RESPONSIBLE FOR ENSURING FULL COMPLIANCE WITH 29 CFR PART 1926 OSHA SUBPART P EXCAVATIONS AND TRENCHES REQUIREMENTS. ALL EARTHWORK SHALL BE PERFORMED IN STRICT ACCORDANCE WITH APPLICABLE LAW, INCLUDING LOCAL ORDINANCES, WASHINGTON STATE DEPARTMENT OF LABOR AND INDUSTRIES TITLE 296, WASHINGTON ADMINISTRATIVE CODE REQUIREMENTS, AND APPLICABLE OSHA REQUIREMENTS.

SPECIAL INSPECTIONS AND STRUCTURAL OBSERVATIONS

- THE CONTRACTOR SHALL NOTIFY THE ENGINEER 48-HOURS BEFORE PLACEMENT OF REINFORCING STEEL AND CONCRETE SO THAT THE SUBGRADE OF EXCAVATIONS MAY BE INSPECTED BY THE GEOTECHNICAL ENGINEER.
- THE GEOTECHNICAL ENGINEER SHALL VERIFY BACKFILL MATERIAL AND BACKFILLING PROCEDURES AND PROVIDE SOIL COMPACTION TESTS.
- STRUCTURAL OBSERVATION SHALL BE PROVIDED BY THE DESIGN ENGINEER(S) OF RECORD OR THEIR AUTHORIZED REPRESENTATIVES IN ACCORDANCE WITH IBC 2018, SECTION 1710. STRUCTURAL OBSERVATION SHALL CONSIST OF SITE VISITS AT INTERVALS APPROPRIATE TO THE STAGE OF CONSTRUCTION TO OBSERVE CONSTRUCTION IN PROGRESS AND REVIEW OF TESTING AND INSPECTION REPORTS FOR GENERAL COMPLIANCE WITH THE CONSTRUCTION DOCUMENTS RELATING TO THE STRUCTURAL WORK AND THE NONSTRUCTURAL COMPONENTS AND EQUIPMENT ANCHORAGE.
- SPECIAL INSPECTION IN ACCORDANCE WITH IBC 2018, SECTION 1704, SHALL BE REQUIRED AS INDICATED IN THE SPECIAL INSPECTION AND TESTING SCHEDULE ON THIS SHEET.

SOIL AND FOUNDATIONS

- GEOTECHNICAL INVESTIGATIONS FOR DESIGN PURPOSES FOR THIS PROJECT WERE MADE FOR CITY OF ISSAQUAH BY ICILE CREEK ENGINEERS, INC IN A REPORT DATED 28 FEBRUARY 2017 AND REPORT ADDENDUMS DATED 11 OCTOBER 2019 AND 22 JANUARY 2021.
- IN ACCORDANCE WITH THE IBC CHAPTER 18 THE SOILS IN ISSAQUAH, WA ARE GENERALLY CLASSIFIED SILTY SAND AND GRAVEL.
- THE DESIGN BEARING CAPACITY OF THE SOILS IS 2,000 PSF FOR FOOTINGS. BEARING CAPACITY OF SOILS ARE FOR DEAD AND LIVE LOADS FOR FOUNDATIONS. BEARING VALUES MAY BE INCREASED BY ONE-THIRD WHEN TRANSIENT LOADS SUCH AS WIND OR SEISMIC LOADS ARE INCLUDED.
- SOILS SHALL BE EXCAVATED TO THE ELEVATIONS INDICATED ON THE DRAWINGS FOR FOUNDATIONS. THE SUBGRADE SHALL BE PREPARED AS INDICATED ON THE DRAWINGS AND SPECIFICATIONS AND APPROVED BY THE GEOTECHNICAL ENGINEER. EXCAVATED MATERIAL SHALL BE REPLACED WITH STRUCTURAL FILL AS SHOWN ON THE DRAWINGS. FOUNDATIONS SHALL BE CONSTRUCTED AGAINST UNDISTURBED NATIVE COMPETENT MATERIAL OR COMPACTED STRUCTURAL FILL.

LOADING CRITERIA

- MINIMUM LOADING REQUIREMENTS PER CHAPTER 16 OF THE 2015 INTERNATIONAL BUILDING CODE INCLUDING LATEST REVISION.
- DEAD LOAD: AS CALCULATED
- LIVE LOADS:
 - FLOOR - HEAVY MANUFACTURING/STORAGE 250 PSF UNIFORM, 3,000 LBS POINT
 - ROOF (REDUCTION FOR UNIFORM LOAD) 20 PSF UNIFORM, 2,000 LBS POINT
 - GRATING, CHECKERED PLATE, ACCESS HATCHES EQUAL TO FLOOR LIVE LOAD
 - SIDEWALKS & VEHICULAR DRIVEWAYS 250 PSF UNIFORM, 8,000 LBS POINT AASHTO
 - UNRESTRICTED VEHICULAR ACCESS HS20-44
 - CONCRETE VAULTS AND COVERS AASHTO HS20-44
- WIND LOAD:
 - BASIC WIND SPEED, Vult 115 MPH
 - EXPOSURE C
- SNOW LOAD:
 - IMPORTANCE FACTOR, I 1.2
 - BASIC GROUND SNOW LOAD, Pg 25 PSF
 - SNOW EXPOSURE COEFFICIENT, Ce 0.9
 - THERMAL FACTOR, Ct 1.0
- SEISMIC LOAD:
 - OCCUPANCY CATEGORY III
 - SEISMIC IMPORTANCE FACTOR, I 1.2
 - SEISMIC IMPORTANCE FACTOR, Ip 1.50
 - SITE CLASS C
 - SITE COEFFICIENT Ss 1.304 g
 - SITE COEFFICIENT Si 0.490 g
 - SEISMIC DESIGN RESPONSE PARAMATER S0s 0.869 g
 - SEISMIC DESIGN RESPONSE PARAMATER S01 0.428 g
 - SEISMIC DESIGN CATEGORY D
 - LONG PERIOD TRANSITION PERIOD, Tl 6

REINFORCING STEEL

- REINFORCING BARS SHALL BE ASTM A615-GRADE 60.
- WELDED WIRE FABRIC SHALL CONFORM TO ASTM A185.
- ARRANGEMENT AND DETAILING OF REINFORCING STEEL, INCLUDING BAR SUPPORTS AND SPACERS, SHALL BE IN ACCORDANCE WITH THE LATEST ACI 315 DETAILING MANUAL.
- REINFORCING SHALL LAP IN ACCORDANCE WITH THE CONCRETE REINFORCEMENT SPLICE TABLE, UNLESS OTHERWISE SHOWN. WHEN BARS OF DIFFERENT SIZE LAP TO EACH OTHER, SPLICE LENGTH FOR THE SMALLER BAR CAN BE USED. DOWELS SHALL HAVE THE SAME SIZE AND SPACING AS THAT OF THE REINFORCING STEEL. THEY ARE SPLICED AND SHALL HAVE A MINIMUM LAP AS NOTED ABOVE. BAR SPLICES SHALL BE STAGGERED.
- HOOK REINFORCING BARS INTERRUPTED BY OPENINGS.
- NO WELDING OF REINFORCING BARS SHALL BE PERMITTED, UNLESS APPROVAL IN WRITING IS OBTAINED FROM THE ENGINEER PRIOR TO CONSTRUCTION.
- DIMENSIONS TO REINFORCING ARE TO BAR CENTERLINES, UNLESS NOTED OTHERWISE. BAR COVER IS CLEAR DISTANCE BETWEEN THE BAR AND THE CONCRETE SURFACE. UNLESS NOTED OR SHOWN OTHERWISE BAR COVER FOR REINFORCING STEEL SHALL BE AS FOLLOWS:

FOOTINGS AND BASE SLABS:	
FORMED SURFACES AND BOTTOMS ON CONCRETE WORK MAT	2-INCH
TOP SURFACES EXPOSED TO EARTH, WATER, OR WEATHER	2-INCH
BOTTOMS AND SIDES IN CONTACT WITH EARTH	3-INCH
SUSPENDED SLABS:	
FORMED SURFACES EXPOSED TO EARTH, WATER, OR WEATHER	2-INCH
TOP AND BOTTOM BARS DRY CONDITION	1-INCH
BEAMS AND COLUMNS:	
DRY CONDITIONS:	
STIRRUPS, SPIRALS, AND TIES	1 1/2-INCH
PRINCIPAL REINFORCEMENT	2-INCH
EXPOSED TO EARTH, WATER, OR WEATHER:	
STIRRUPS, SPIRALS, AND TIES	2-INCH
PRINCIPAL REINFORCEMENT	2 1/2-INCH
WALLS:	
LESS THAN 12-INCHES THICK	1 1/2-INCH
12 INCHES OR OVER IN THICKNESS	2 1/2-INCH

CONCRETE:

- CEMENT SHALL BE ASTM C150 TYPE II FOR ALL STRUCTURES. CONCRETE SHALL HAVE A MINIMUM 28 DAY COMPRESSIVE STRENGTH OF 4,000 PSI.
- CONCRETE CONSTRUCTION SHALL CONFORM TO ACI 318-14 INCLUDING BAR BENDS AND HOOKS, UNLESS DETAILED OTHERWISE.
- SUBMIT CONCRETE AND MASONRY LIFT DRAWINGS SHOWING THE LOCATION OF CONSTRUCTION JOINTS, WATERSTOPS AND OTHER TYPES OF JOINTS OTHER THAN SPECIFIED OR SHOWN ON THE DRAWINGS FOR FAVORABLE REVIEW BY THE ENGINEER BEFORE START OF WORK ON FORMS, REINFORCING STEEL OR PLACING CONCRETE. ANY ADDITIONAL VERTICAL OR HORIZONTAL CONSTRUCTION JOINTS SHALL HAVE A STANDARD KEYWAY AND SHALL BE FAVORABLY REVIEWED BY THE ENGINEER. REFER TO SPECIFICATIONS AND TYPICAL DETAILS FOR ADDITIONAL INFORMATION. CONSTRUCTION JOINTS SHALL BE ROUGHENED TO 1/4-INCH AMPLITUDE.
- OPENINGS, PIPE SLEEVES, CONDUITS, INSERTS AND OTHER EMBEDDED ITEMS SHALL BE IN PLACE BEFORE CONCRETE IS PLACED. IT IS THE CONTRACTOR'S RESPONSIBILITY TO COORDINATE ARCHITECTURAL, CIVIL, MECHANICAL, ELECTRICAL, LANDSCAPING, HVAC, PLUMBING, INSTRUMENTATION AND OTHER PLANS FOR ITEMS REQUIRING SLEEVES AND EMBEDMENTS IN CONCRETE WHICH ARE NOT INDICATED OR SHOWN ON STRUCTURAL DRAWINGS. NO PIPES OR SLEEVES SHALL PASS THROUGH STRUCTURAL MEMBERS (UNLESS SHOWN ON STRUCTURAL DRAWINGS). COORDINATE WITH EQUIPMENT MANUFACTURERS DRAWINGS FOR ANCHORING DEVICES.
- UNLESS OTHERWISE NOTED, ALL EXPOSED EDGES AND CORNERS SHALL BE CHAMFERED 3/4-INCH. INTERIOR FLOOR SLABS AND EXTERIOR SIDEWALKS SHALL HAVE TOOLED 3/8-INCH RADIUS CONSTRUCTION JOINT.
- EACH FACE CONCRETE SHALL BE REINFORCED A MINIMUM OF NO. 5 BARS AT 12-INCHES EACH WAY.
- CONCRETE ENCASE ALL PIPES AND CONDUITS UNDER CONCRETE SLABS AND FOOTINGS

MASONRY:

- SEE SHEET S5.

WOOD FRAMING:

- FRAMING LUMBER SHALL BE DOUGLAS FIR-LARCH AND BE GRADE MARKED PER WCLIB SPECIFICATIONS:
 - STUDS:
 - 2" TO 4" THICK, 2" TO 4" WIDE, INTERIOR, NON-BEARING PARTITIONS, STUD GRADE.
 - 2" TO 4" THICK, 2" AND WIDER, EXTERIOR, BEARING WALLS, NO. 1 AND BETTER GRADE.
 - JOISTS AND RAFTERS:
 - 2" TO 4" THICK, 2" TO 4" WIDE, SELECT STRUCTURAL GRADE.
 - 2" TO 4" THICK, 5" AND WIDER, NO. 1 AND BETTER GRADE.
 - BEAMS AND HEADERS:
 - 2" TO 4" THICK, 5" AND WIDER, NO. 1 AND BETTER GRADE.
 - 5" THICK AND GREATER, ALL WIDTHS, NO. 1 AND BETTER GRADE.
 - TOP PLATES:
 - 2" THICK X 4" WIDE, INTERIOR, NON-BEARING PARTITIONS, STUD GRADE.
 - 2" THICK X 4" WIDE, EXTERIOR, BEARING WALLS, NO. 1 AND BETTER GRADE.
 - BLOCKING:
 - 2" TO 4" THICK, 2" AND WIDER, STUD GRADE.
 - SILL PLATES:
 - 2" THICK X 4" WIDE, INTERIOR, NON-BEARING PARTITIONS, PRESSURE TREATED STUD GRADE.
 - 2" TO 4" THICK, 4" AND WIDER, EXTERIOR, PRESSURE TREATED NO. 1 AND BETTER GRADE.
- STRUCTURAL PLYWOOD SHALL BE DOUGLAS FIR CONFORMING TO COMMERCIAL STANDARDS PS 1-09 AND GRADE STAMPED NFPA. ALL ROOFS AND WALLS SHALL BE SHEATHED AND ALL UNSUPPORTED EDGES SHALL BE BLOCKED ACCORDING TO THE TYPICAL NAILING SCHEDULE:
 - ROOF SHEATHING:
 - 4'x8'x3/4" SHEETS, MARINE GRADE.
- ALL LUMBER HARDWARE (HANGERS, FRAMING ANCHORS, STRAPS, ETC) AS SHOWN ARE STRONG-TIE CONNECTORS AS MANUFACTURED BY SIMPSON COMPANY OF SAN LEANDRO, CALIFORNIA. APPROVED EQUAL HARDWARE MAY BE SUBSTITUTED IF FAVORABLY REVIEWED BY THE ENGINEER.
- FASTENERS AND CONNECTORS EXPOSED TO WEATHER OR IN CONTACT WITH PRESERVATIVE-TREATED WOOD SHALL BE HOT-DIP GALVANIZED.
- NO STRUCTURAL MEMBER SHALL BE CUT, NOTCHED, OR DRILLED UNLESS SPECIFICALLY SHOWN OR APPROVED BY THE ENGINEER.
- MAXIMUM MOISTURE CONTENT OF LUMBER SHALL NOT EXCEED 19% FOR ALL FRAMING LUMBER.

STRUCTURAL ABBREVIATIONS

&	AND	JT	JOINT
@	AT		
#	NUMBER	KIP	1,000 POUNDS
Ø	DIAMETER	KSI	KIPS PER SQUARE INCH
AASHTO	AMERICAN ASSOCIATION OF STATE HIGHWAY TRANSPORTATION OFFICIAL	L/L	ANGLE
AB	AGGREGATE BASE, ANCHOR BOLT	LB(S)	POUNDS
ACI	AMERICAN CONCRETE INSTITUTE	LB/SF	POUND(S) PER SQUARE FOOT
ADDIT	ADDITIONAL	LL	LIVE LOAD
ADJ	ADJACENT	LLH	LONG LEG HORIZONTAL
AISC	AMERICAN INSTITUTE OF STEEL CONSTRUCTION	LLV	LONG LEG VERTICAL
AISI	AMERICAN IRON AND STEEL INSTITUTE	LLBB	LONG LEG BACK-TO-BACK
		LONGIT	LONGITUDINAL
		LT	LIGHT
		LW	LIGHT WEIGHT
AITC	AMERICAN INSTITUTE OF TIMBER CONSTRUCTION	MATL	MATERIAL
ALUM	ALUMINUM	MAX	MAXIMUM
ALT	ALTERNATE	MB	MACHINE BOLT
ANSI	AMERICAN NATIONAL STANDARDS	MC	MOISTURE CONTENT
INSTITUTE	AMERICAN PLYWOOD ASSOCIATION	MC	MISCELLANEOUS CHANNEL
APROX	APPROXIMATE	MECH	MECHANICAL
ARCH	ARCHITECTURAL		
ASTM	AMERICAN SOCIETY FOR TESTING AND MATERIALS	MIN	MINIMUM
		MISC	MISCELLANEOUS
ASME	AMERICAN SOCIETY OF MECHANICAL ENGINEERS	N/A	NOT APPLICABLE
		(N)	NEW
AWS	AMERICAN WELDING SOCIETY	NDT	NON-DESTRUCTIVE TEST(ING)
AWWA	AMERICAN WATER WORKS ASSOCIATION	NFFA	NATIONAL FIRE PROTECTION ASSOCIATION
		NIC	NOT IN CONTACT
B/	BOTTOM OF BEARING BAR(S)	NO.	NUMBER
BB(S)	BLOCKING	NOM	NOMINAL
BLKG	BUILDING	NS	NEAR SIDE
BLDG	BEAM	NSG	NON-SHRINK GROUT
BM	BEAM MEMBER 1	NTS	NOT TO SCALE
BM-1	BOUNDARY NAILING		
BN	BOTTOM	OC	ON CENTERS
BOT	BASE PLATE	OD	OUTSIDE DIAMETER
BP	BOTH SIDES	OH	OPPOSITE HAND, OVERHEAD
BS	BETWEEN	OPNG(S)	OPENING(S)
BTWN		OPP	OPPOSITE
		OSHA	OCCUPATIONAL SAFETY AND HEALTH ASSOCIATION
C	CHANNEL		
CALC'S	CALCULATIONS		
CC/C/C	CENTER-TO-CENTER	PAF	POWDER/POWER ACTUATED
CBC	CALIFORNIA BUILDING CODE		FASTENER
CJ	CONSTRUCTION JOINT	PER	PERIODIC
CJP	COMPLETE JOINT PENETRATION	PL	PLATE
CL	CENTERLINE	PLF	POUND PER LINEAL FOOT
CLR	CLEAR	PP	PARTIAL PENETRATION
CNJ	CONTROL JOINT	PSF	POUND PER SQUARE FOOT
COL	COLUMN	PSI	POUND PER SQUARE INCH
CONC	CONCRETE	PT(S)	POINT(S)
CONN	CONNECTION	PT	PRESSURE TREATED
CONST	CONSTRUCTION		
CONT	CONTINUOUS		
		R, RAD	RADIUS
DBL	DOUBLE	RECT	RECTANGLE, RECTANGULAR
DIA	DIAMETER	REINF	REINFORCING, -MENT
DIM	DIMENSION	REQ'D	REQUIRED
DL	DEAD LOAD		
DN	DOWN		
DWG(S)	DRAWINGS	SCH	SCHEDULE
		SF	SQUARE FOOT
(E)	EXISTING	SHT	SHEET
EA	EACH	SIM	SIMILAR
EF	EACH FACE	SLBB	SHORT LEGS BACK-TO-BACK
EL	ELEVATION	SLH	SHORT LEG HORIZONTAL
ELEC	ELECTRICAL	SLV	SHORT LEG VERTICAL
EMBED	EMBEDMENT	SMS	SHEET METAL SCREW
EN	EDGE NAILING	SPEC(S)	SPECIFICATION(S)
EQ	EQUAL	SQ	SQUARE
EQUIP	EQUIPMENT	SS	STAINLESS STEEL
ES	EACH SIDE	SSD	SATURATED SURFACE DRY
EW	EACH WAY	STAG	STAGGER
EXP	EXPANSION	STD	STANDARD
EXT	EXTERIOR	STIFF	STIFFENER
		STL	STEEL
(F)	FUTURE	STRUC	STRUCTURE
FD	FLOOR DRAIN	SUSP	SUSPENDED
FF	FINISH FLOOR	SYM	SYMMETRICAL
FIN	FINISH		
FLR	FLOOR		
FN	FIELD NAILING	T/	TOP OF
FNDN	FOUNDATION	T&B	TOP AND BOTTOM
FRP	FIBERGLASS REINFORCED PLASTIC	TS	STRUCTURAL TUBING
		TYP	TYPICAL
FS	FAR SIDE		
FT	FOOT/FEET	UON	UNLESS OTHERWISE NOTED
FTG	FOOTING	UT	ULTRASONIC TESTING
GA	GAGE/GAUGE		
GALV	GALVANIZED	VERT	VERTICAL
GLB	GLULAM BEAM	VIF	VERIFY IN FIELD
HDG	HOT DIP GALVANIZE(D)	W/	WITH
HORIZ	HORIZONTAL	W/O	WITHOUT
HSS	HOLLOW STRUCTURAL SECTION	W, WF	WIDE FLANGE
HT	HEIGHT	WCLIB	WEST COAST LUMBER
HWL	HIGH WATER LEVEL		INSPECTION BUREAU
		WP	WORK POINT
IBC	INTERNATIONAL BUILDING CODE	WT	WEIGHT, STRUCTURAL TEE
ICC	INTERNATIONAL CODE COUNCIL		WALL THICKNESS
IN	INCH	WWF	WELDED WIRE FABRIC
INT	INTERIOR		
		YD	YARD

USE OF DOCUMENTS

THIS DOCUMENT, INCLUDING THE INCORPORATED DESIGNS, IS AN INSTRUMENT OF SERVICE FOR THIS PROJECT AND SHALL NOT BE USED FOR ANY OTHER PROJECT WITHOUT THE WRITTEN AUTHORIZATION OF KENNEDY/JENKS CONSULTANTS.

####

NO.

REVISION

####

DATE

####

BY

SCALES
0 1"
0 25mm
IF THIS BAR IS NOT DIMENSION SHOWN, ADJUST SCALES ACCORDINGLY.



DESIGNED

STP

DRAWN

STP

CHECKED

JDS



CITY OF ISSAQUAH
ISSAQUAH, WASHINGTON
SOUTH SPAR BOOSTER PUMP STATION

Kennedy/Jenks Consultants
FEDERAL WAY, WASHINGTON

STRUCTURAL GENERAL NOTES AND ABBREVIATIONS

FILE NAME

139700500-S001.DWG

JOB NO.

1397005'00

DATE

FEBRUARY 2021

SHEET

OF


S1

GOVERNING CODES	
CONCRETE	ACI 318-14
GENERAL	IBC 2015
STEEL	ANSI/AISC 360-10
MASONRY	ACI 530-13
WELDING	AWS D1.1-10


11/30/2020 2:26 PM
STEVEPRITCHETT

\\jc-kc\K-Cad\FederalWay\CAD\131\1397005.00_City_of_Issaquah\139700500-S004.dwg


- NOTES:
- CONCRETE SIDEWALKS SHALL HAVE 1/2" EXPANSION JOINTS EVERY 30' AND SHALL HAVE WEAKENED PLANE JOINTS EVERY 5'.
 - ALL SIDEWALKS TO BE 12" THICKNESS WITH #5 REINFORCING BARS AT 12" OC BOTH WAYS UON ON PLAN.

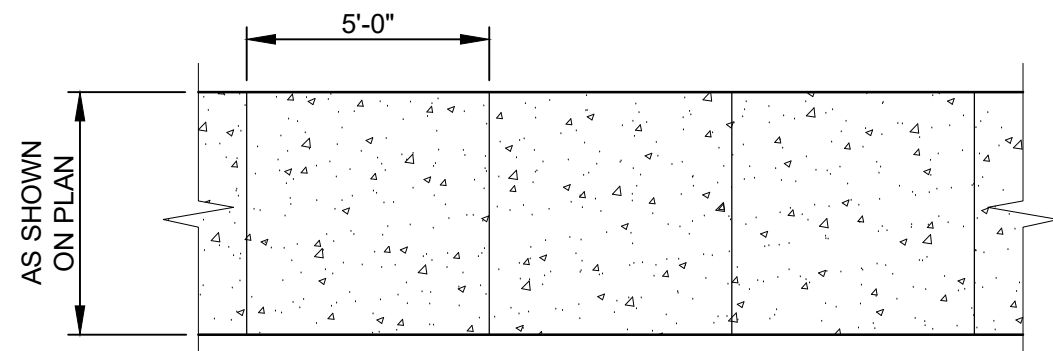


PLAN

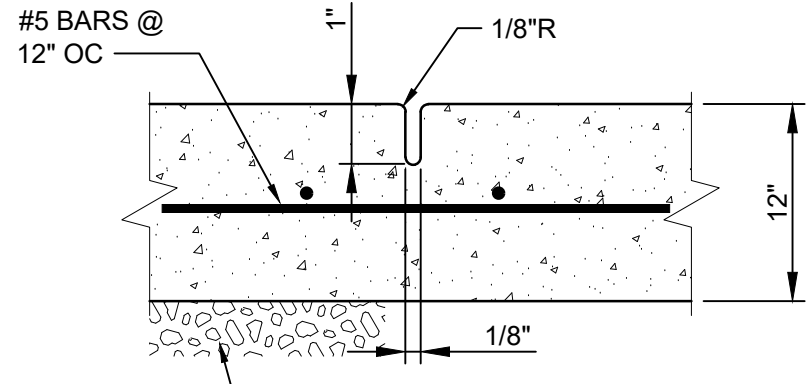

WEAKENED PLANE JOINT

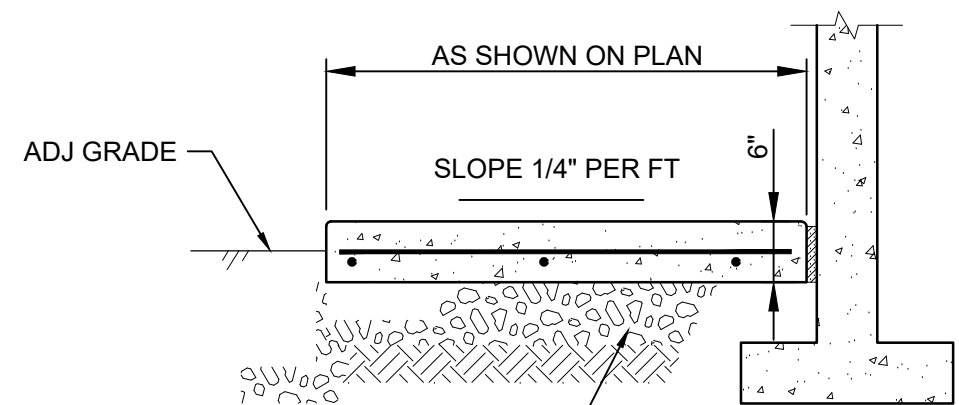

SECTION

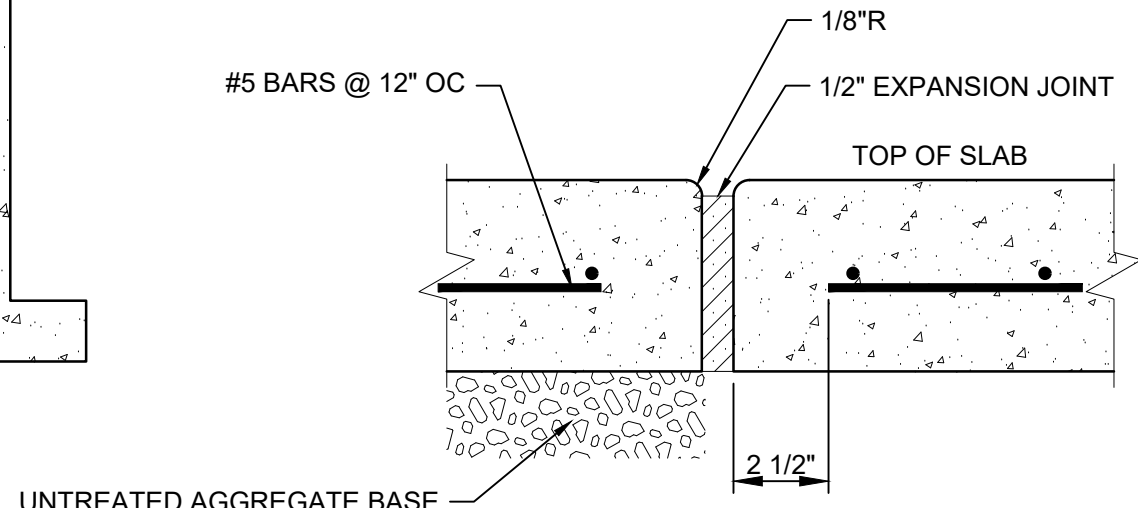

EXPANSION JOINT


EXTERIOR WALKWAY

THIN

S-3332

SCALE: NTS
REV 00

- NOTES:
- PLACE ALL EQUIPMENT ON CONCRETE PADS (UON).
 - SEPARATE ALL STEEL SURFACES BEARING ON CONC BY 1/4" (MIN) THICK GROUT LAYER.
 - INSTALL THE MAX OF STANDARD HOOK DEVELOPMENT LENGTH OR 3" LESS THAN THE SLAB THICKNESS

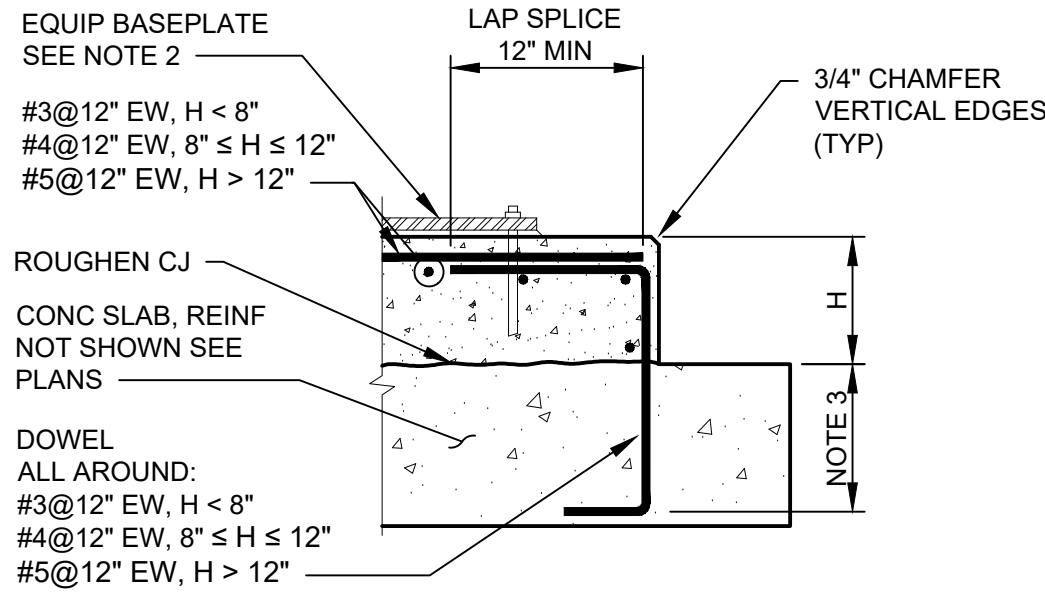

EQUIP PAD


ON NEW CONC

S-3831

SCALE: 1" = 1'-0"
REV 00

MASONRY REINFORCING DEVELOPMENT TABLE			
BAR SIZE	STRAIGHT (ℓ_d) REINF CENTERED IN WALL	STRAIGHT (ℓ_b) REINF NOT CENTERED	STD HOOK (ℓ_e)
#3	1'-0"	1'-2"	0'-5"
#4	1'-3"	2'-2"	0'-7"
#5	2'-0"	3'-3"	0'-9"
#6	3'-8"	4'-6"	0'-10"
#7	5'-0"	5'-3"	1'-0"
#8	6'-0"	6'-0"	1'-1"

- NOTES:
- MIN DEVELOPMENT LENGTH AND LAP SPLICE FOR 8" (NOMINAL) CMU WALLS, $f_m \geq 1500$ PSI, 60 KSI REINF, TYP REINF SPACED > 2 IN CC AND A MIN 2 IN CLEAR TO CMU OUTER FACE.
 - FOR EPOXY COATED BARS INCREASE THE DEVELOPMENT LENGTHS BY 50%.
 - d_b = BAR DIAMETER, f_m = CMU STRENGTH

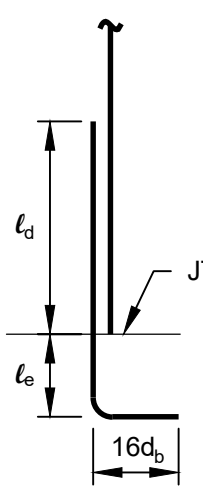


MASONRY REINFORCEMENT

DEVELOPMENT TABLE


S-4010

SCALE: NTS
REV 00

- NOTES:
- COORDINATE PUMP CAN DIMENSIONS WITH MECHANICAL DRAWINGS AND FAVORABLY REVIEWED PUMP ANCHORAGE AND EQUIPMENT SUBMITTALS.
 - COORDINATE ANCHOR TYPE, MATERIAL, FINISH, NUMBER, SIZE, SPACING, AND EDGE DISTANCE WITH REQUIREMENTS OF THE PUMP MANUFACTURER, AND REQUIREMENTS OF THE FAVORABLY REVIEWED PUMP ANCHORAGE DESIGN AND EQUIPMENT SUBMITTALS.
 - PUMP AND ANCHORS NOT SHOWN.

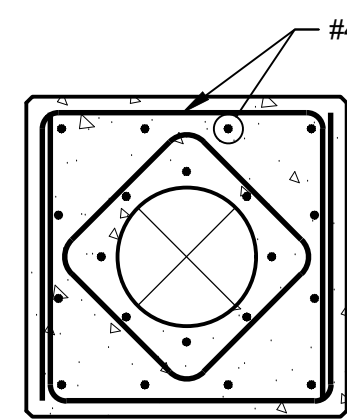


SECTION A-A

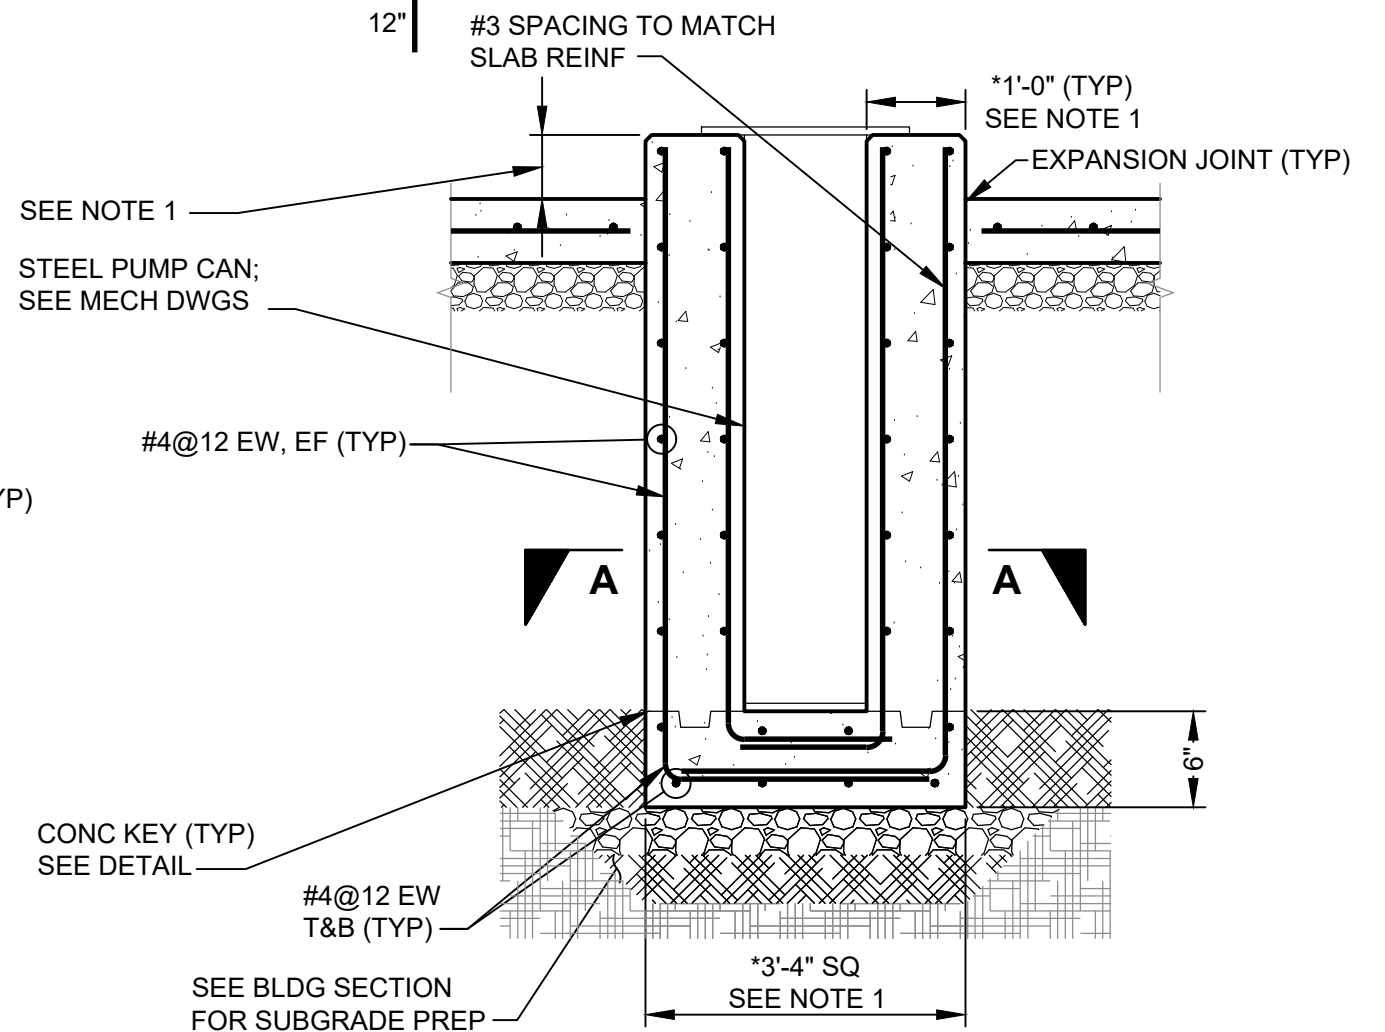

PUMP CAN


S-3999

SCALE: 1" = 1'-0"
REV 00

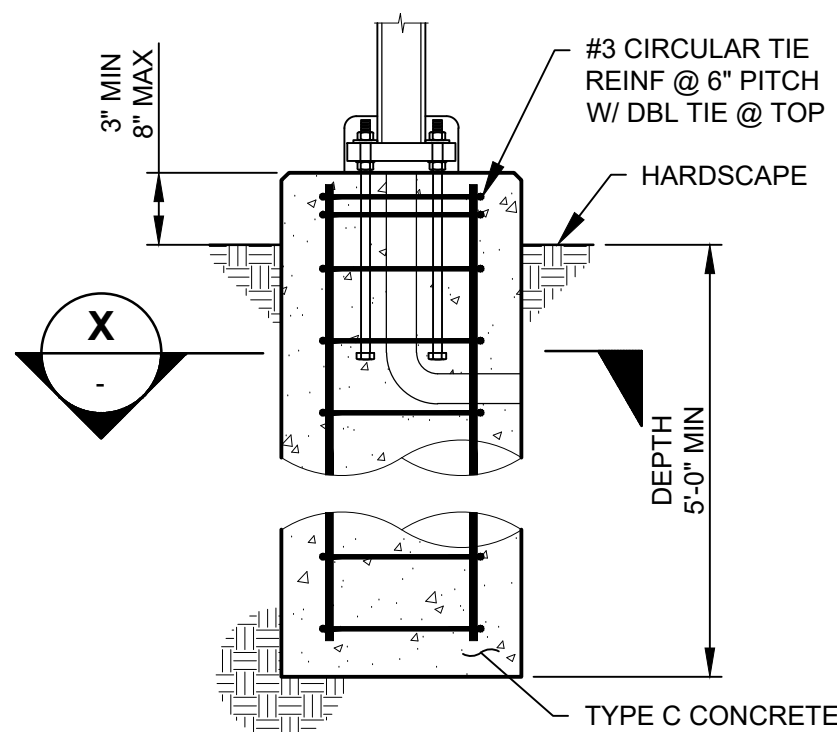

CONC PIER

- NOTE:
- SEE GENERAL STRUCTURAL NOTES AND SPECIFICATIONS FOR ADDITIONAL INFORMATION

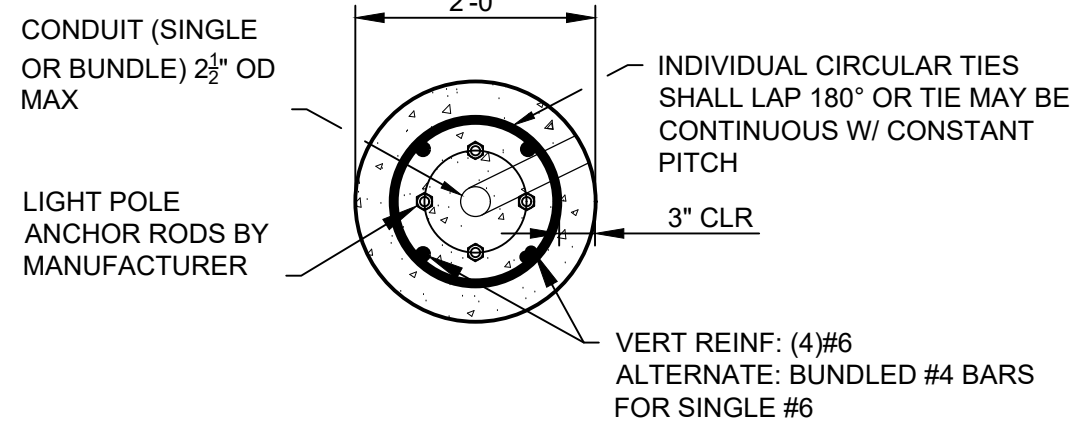


SECTION X

LIGHT POLE PIER

S-3771



SCALE: 3/4" = 1'-0"
REV 00

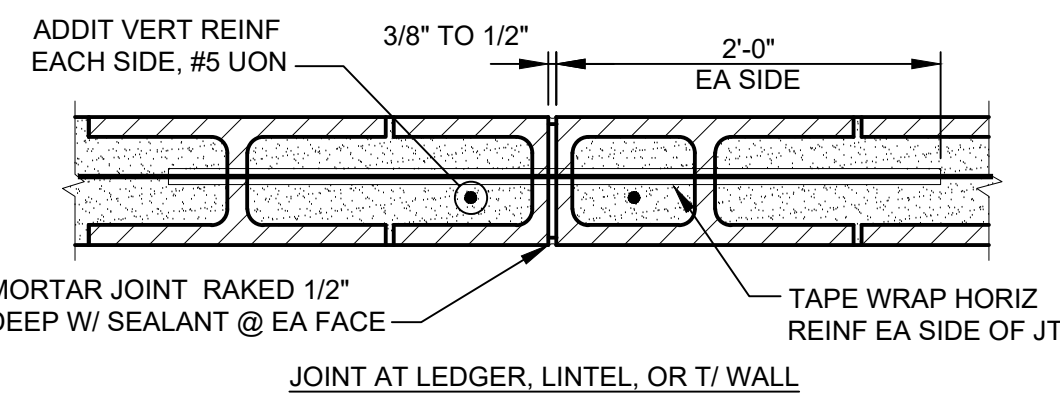

CMU CONTROL JOINT

S-4110

SCALE: 1" = 1'-0"
REV 00

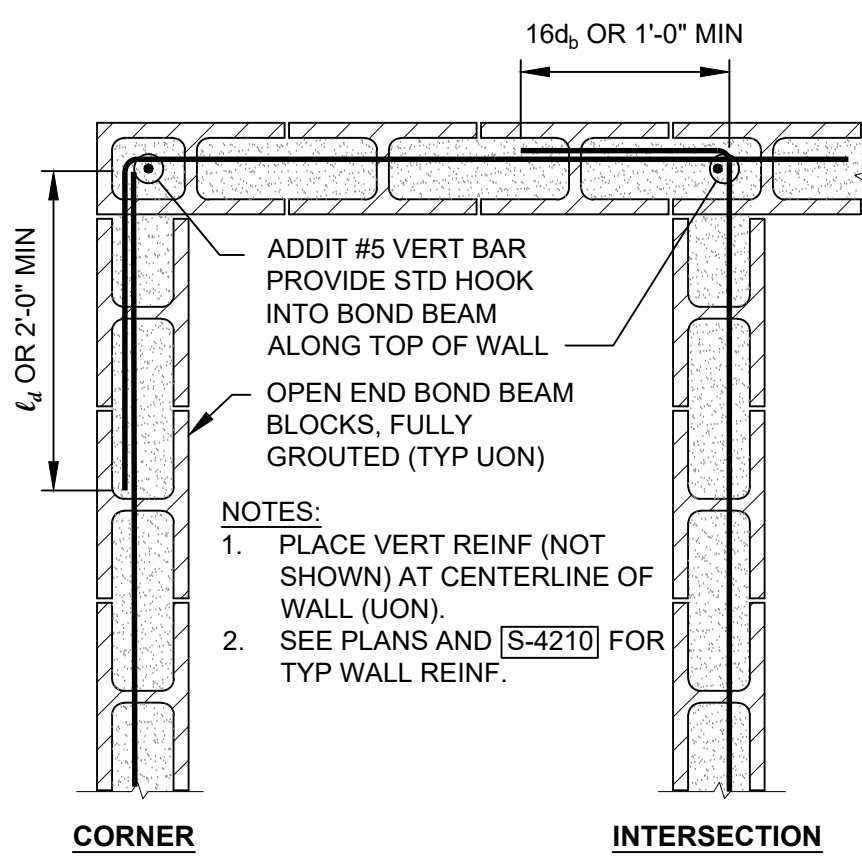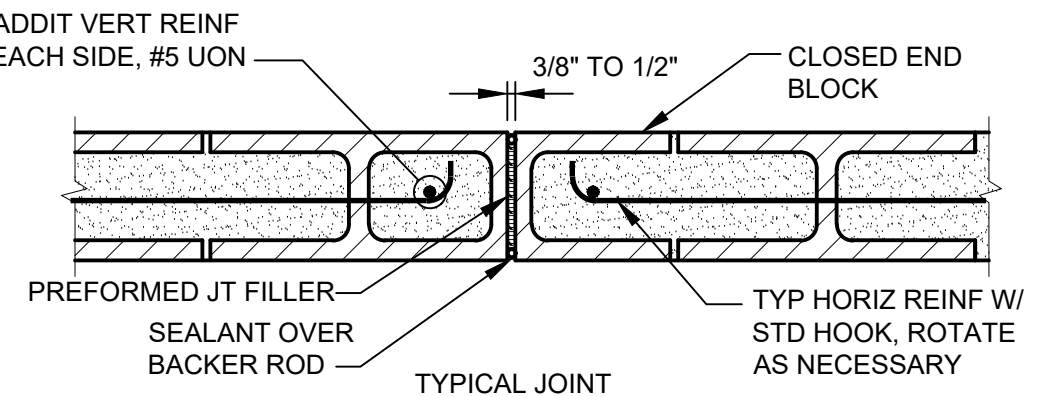


TYPICAL REINF AT CMU CORNERS

SINGLE MAT HORIZ REINF

S-4150

SCALE: 3/4" = 1'-0"
REV 00

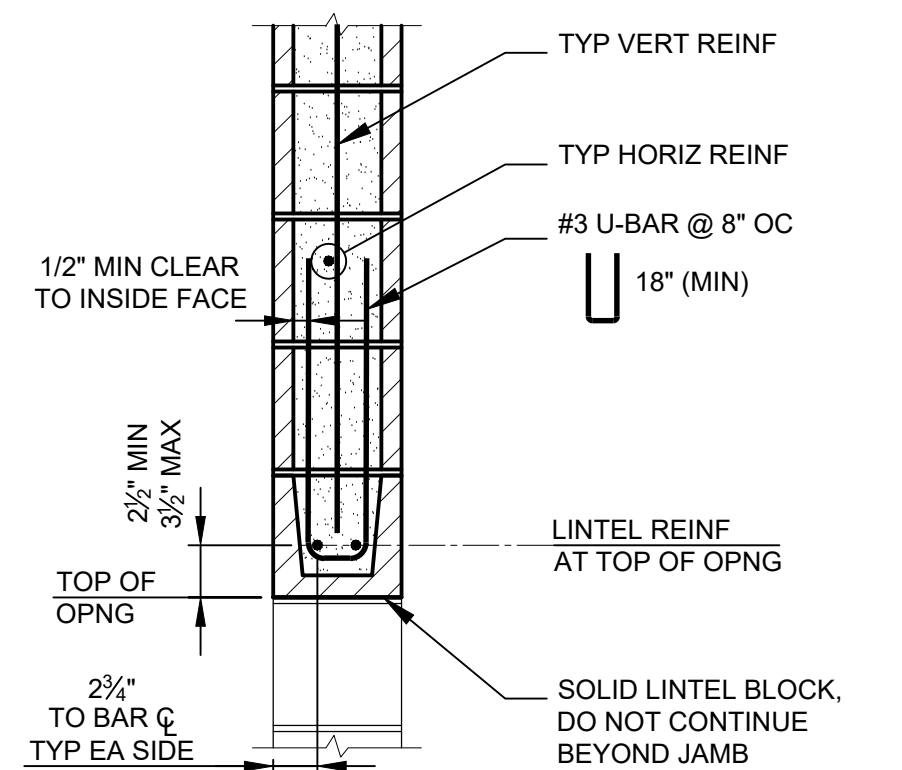

CMU LINTEL

CENTERED VERT REINF

S-4240


SCALE: 1" = 1'-0"
REV 00

USE OF DOCUMENTS

THIS DOCUMENT, INCLUDING THE INCORPORATED DESIGNS, IS AN INSTRUMENT OF SERVICE FOR THIS PROJECT AND SHALL NOT BE USED FOR ANY OTHER PROJECT WITHOUT THE WRITTEN AUTHORIZATION OF KENNEDY/JENKS CONSULTANTS.

NO.	REVISION	DATE	BY
-----	----------	------	----

SCALES
1" = 25mm
IF THIS BAR IS NOT DIMENSION SHOWN, ADJUST SCALES ACCORDINGLY.

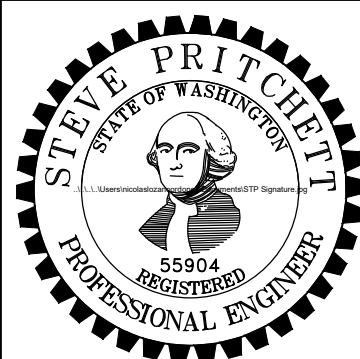

DESIGNED
STP

DRAWN
STP

CHECKED
JDS



CITY OF ISSAQUAH
ISSAQUAH, WASHINGTON
SOUTH SPAR BOOSTER PUMP STATION

Kennedy/Jenks Consultants
FEDERAL WAY, WASHINGTON

STRUCTURAL NOTES AND STANDARD DETAILS - 2


90% SUBMITTAL (REVISED 11/30/2020)

FILE NAME
139700500-S004.DWG
JOB NO.
1397005'00
DATE
NOVEMBER 2020
SHEET
OF
S4


P:\CAD\131\1397005_00_City_of_Issaquah\139700500-S005.dwg
6/24/2020 11:59 AM
MIKEMAPX
4

1. CONCRETE MASONRY UNITS: BLOCKS SHALL BE DOUBLE OPEN ENDED BOND BEAM (UON), HAVE A LIGHTWEIGHT CLASSIFICATION AND CONFORM TO ASTM C90. MINIMUM COMPRESSIVE STRENGTH OF UNITS OF 1,900 PSI WHEN AIR CURED FOR 28-DAYS. MINIMUM COMPRESSIVE STRENGTH OF 1,500 PSI OF MASONRY WALL ASSEMBLAGE AT 28-DAYS.
2. MORTAR: PROPORTION MORTAR TO CONFORM TO THE REQUIREMENTS OF ASTM C270 FOR TYPE S MORTAR. ANY MORTAR UNUSED WITHIN 2 HOURS OR GROUT THAT IS UNUSED WITHIN 1 1/2 HOURS AFTER INITIAL MIXING SHALL BE REMOVED FROM THE WORK.
3. GROUT: PROPORTION COARSE GROUT IN ACCORDANCE WITH ASTM C476. COMPRESSIVE STRENGTH SHALL BE TESTED IN ACCORDANCE WITH ASTM C1019. INCREASE CEMENT CONTENT OF THE GROUT, AS NECESSARY TO ACHIEVE THE SPECIFIED MASONRY ASSEMBLY STRENGTH (fm) AND ADEQUATE WORKABILITY. GROUT SHALL HAVE A SLUMP BETWEEN 8 AND 10-INCHES AT THE TIME OF PLACEMENT. ALL CELLS SHALL BE FILLED SOLIDLY WITH GROUT. ALL GROUT SHALL BE CONSOLIDATED BY MECHANICAL VIBRATION UNLESS SELF CONSOLIDATING GROUT HAS BEEN SPECIFICALLY APPROVED BY THE ENGINEER.
4. ADMIXTURES: ADMIXTURES ARE NOT PERMITTED IN MORTAR OR GROUT UNLESS FAVORABLY REVIEWED BY THE ENGINEER.
5. AGGREGATES: SAND FOR MORTAR SHALL CONFORM TO ASTM C144. AGGREGATE FOR GROUT SHALL CONFORM TO ASTM C404, EXCEPT WHEN OTHER GRADINGS ARE SPECIFICALLY APPROVED BY THE ENGINEER.
6. WATER USED FOR MORTAR AND GROUT SHALL BE CLEAN AND FREE FROM DELETERIOUS AMOUNTS OF ACIDS, SALTS, ALKALI, AND ORGANIC MATERIALS.
7. REINFORCEMENT: REINFORCING SHALL BE ASTM A615-GRADE 60 UNLESS OTHERWISE NOTED. REINFORCEMENT SHALL BE FULLY EMBEDDED IN GROUT. EMBEDDED ITEMS SHALL BE SECURED IN PLACE PRIOR TO GROUTING. PROVIDE A MINIMUM OF 1/2-INCH GROUT AROUND BOLTS IN MASONRY. VERTICAL REINFORCING SHALL BE HELD IN PLACE AT TOP AND BOTTOM AND AT INTERVALS NOT EXCEEDING 200 BAR DIAMETERS. UTILIZE REBAR POSITIONERS TO ACHIEVE VERTICAL REINFORCING PLACEMENT. LINTEL UNITS SHALL BE USED OVER OPENINGS. MINIMUM SPLICE LENGTH SHALL EQUAL THE STRAIGHT BAR DEVELOPMENT LENGTH SHOWN IN THE TABLE BELOW.
8. BEFORE PLACING BLOCK ON CONCRETE, CLEAN AND ROUGHEN CONCRETE SO THAT AGGREGATE IS EXPOSED TO 1/4-INCH AMPLITUDE.
9. LAY ALL MASONRY WITH RUNNING BOND UNLESS OTHERWISE NOTED. CONSTRUCT ALL MASONRY TO MAINTAIN AN UNOBSTRUCTED VERTICAL CONTINUITY OF THE CELLS TO BE FILLED. THE VERTICAL ALIGNMENT SHALL BE SUFFICIENT TO MAINTAIN A CLEAR, UNOBSTRUCTED VERTICAL FLUE IN ACCORDANCE WITH THE GROUT SPACE REQUIREMENTS IN TABLE 7 OF THE SPECIFICATION FOR MASONRY STRUCTURES (ACI 530.1).
10. CONSTRUCTION JOINTS: WHEN GROUTING IS STOPPED FOR A PERIOD OF 1 HOUR OR LONGER, FORM HORIZONTAL CONSTRUCTION JOINTS BY STOPPING THE GROUT POUR 1 1/2 INCHES MINIMUM BELOW THE UPPER-MOST UNIT, EXCEPT AT THE TOP OF WALLS.
11. CONTROL JOINTS: LOCATE CONTROL JOINTS AS SHOWN ON PLANS. PLACE LEDGER, LINTEL, OR TOP OF WALL BEAM REINFORCING CONTINUOUS THROUGH EXPANSION AND CONTROL JOINTS. WRAPPING BARS WITH 1/8-INCH THICK BOND BREAKING TAPE 2'-0" BOTH SIDES OF JOINT. DO NOT SPLICE BOND BEAM REINFORCING WITHIN 6'-0" OF AN EXPANSION OR CONTROL JOINT.
12. SPECIAL INSPECTION: WHERE THE BUILDING, STRUCTURE OR STRUCTURAL ELEMENT REQUIRES SPECIAL INSPECTION AS NOTED ON THE PLANS AND THE REINFORCING SCHEDULE BELOW, THE CONTRACTOR SHALL MAINTAIN ALL WORK ACCESSIBLE AND EXPOSED FOR INSPECTION IN ACCORDANCE WITH IBC CHAPTER 17.
13. REINFORCEMENT TOLERANCES: IN ACCORDANCE WITH THE SPECIFICATION FOR MASONRY STRUCTURES (ACI 530.1). UNLESS OTHERWISE NOTED VERTICAL WALL REINFORCEMENT SHALL BE PLACED AT CENTER CELL WITHIN A TOLERANCE OF ±1/2 INCH IN THE DIRECTION PERPENDICULAR TO THE WALL AND +/-1 INCH IN THE PLANE OF THE WALL.

MASONRY GENERAL NOTES
SCALE: NTS
REV 00

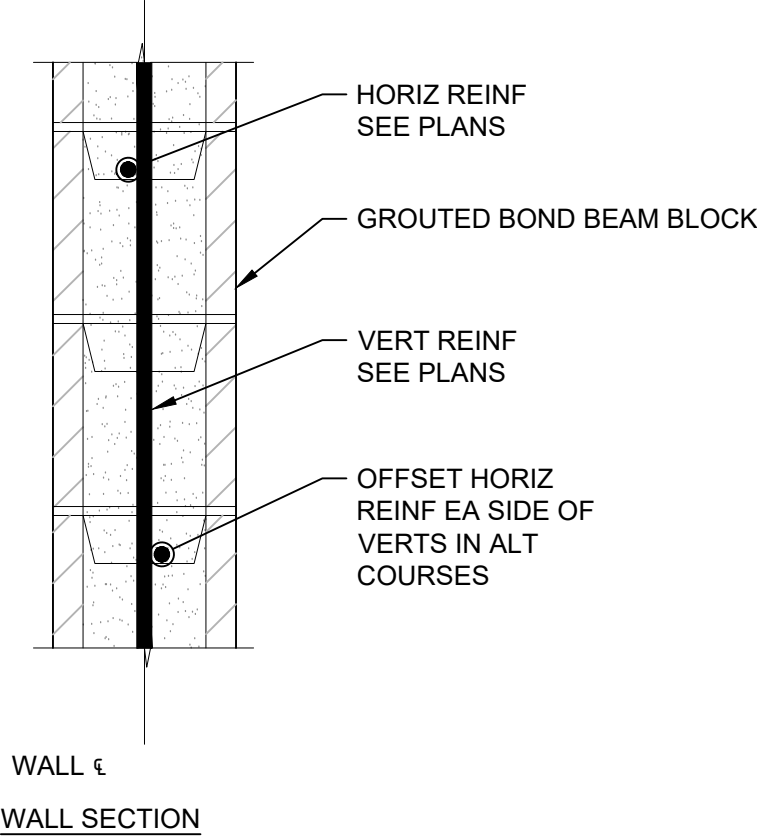


WALL SECTION

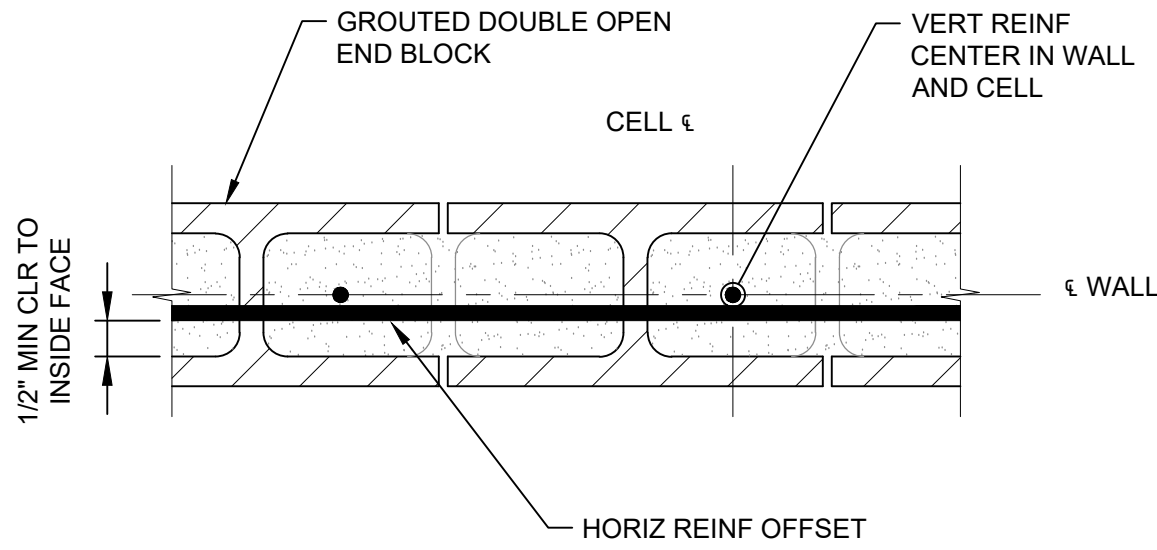


WALL PLAN


CMU WALL PLAN AND SECTION
8" NOMINAL THICKNESS - VERT REINF CENTERED
SCALE: 1-1/2" = 1'-0"
REV 00

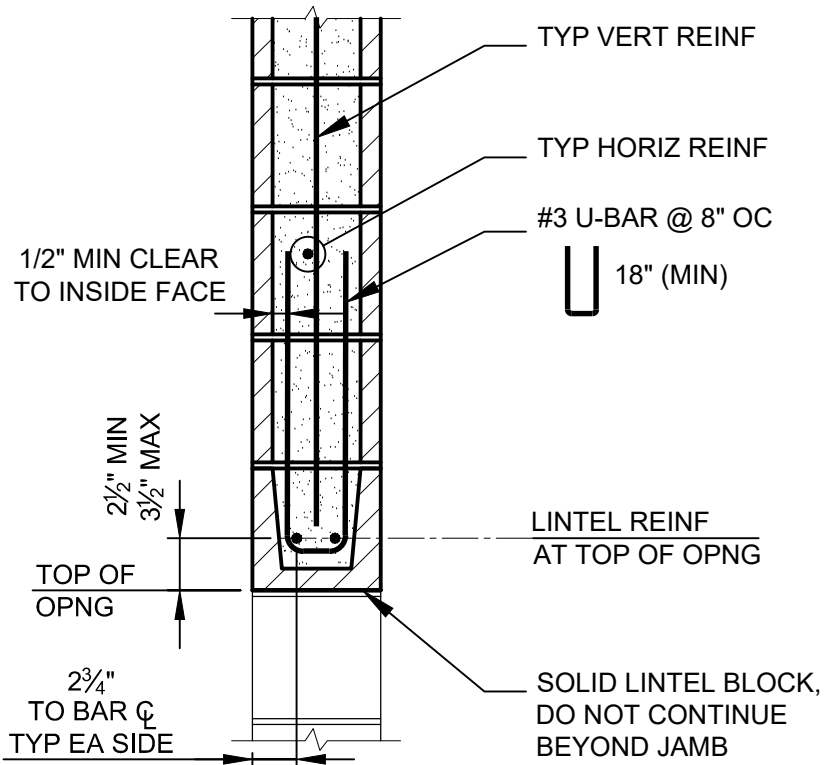

CMU LINTEL
CENTERED VERT REINF
SCALE: 1" = 1'-0"
REV 00

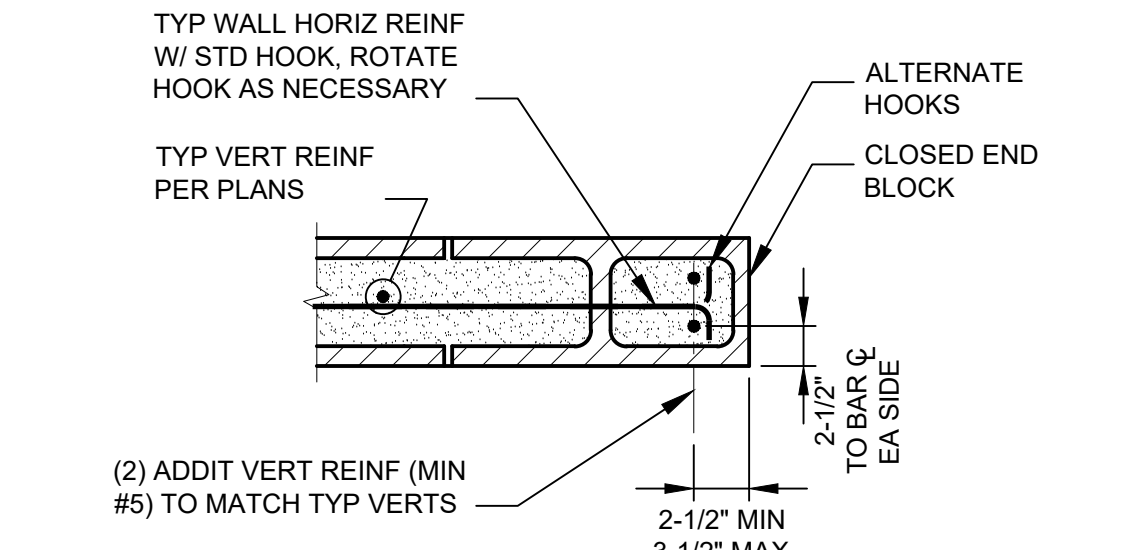


CMU JAMB OR END OF WALL
STD REINF
SCALE: 1" = 1'-0"
REV 00

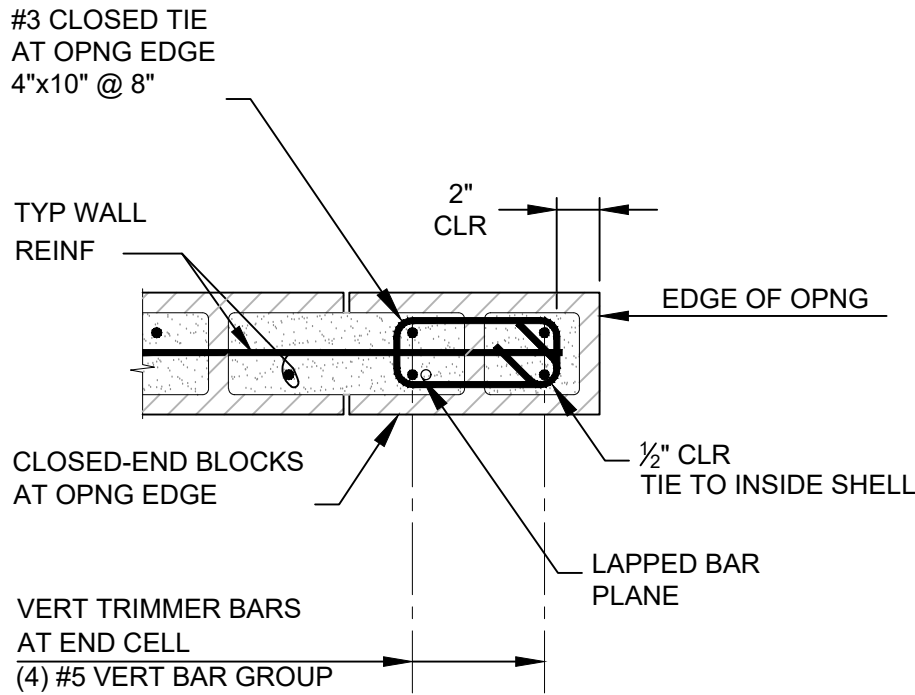


CMU JAMB OR END OF WALL
BOUNDARY ELEMENT
SCALE: 1" = 1'-0"
REV 00

- NOTES:
1. ALL TRIMMER BARS ARE #5 UON ON PLANS. TRIMMER BARS ARE IN ADDITION TO TYPICAL WALL REINF.
 2. TYPICAL WALL REINF NOT SHOWN.

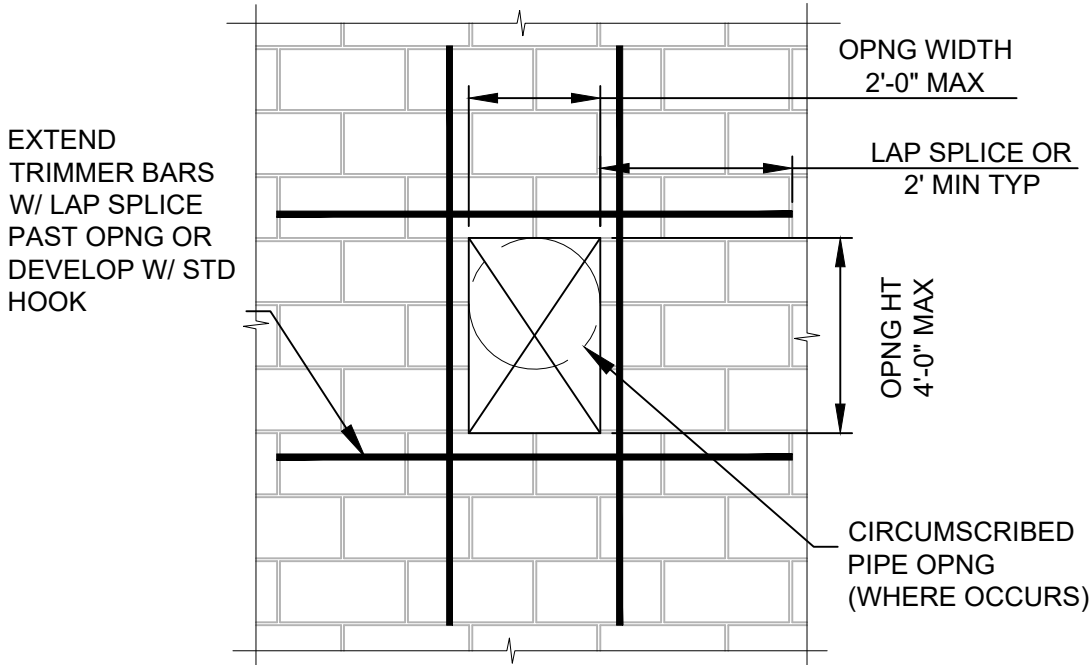


CMU WALL OPENING
MAX 24" WIDTH
SCALE: 1/2" = 1'-0"
REV 00

- NOTES:
- FOR WALL REINF. SEE PLANS AND [S-4210]
- EXTENDED JAMB BARS ℓ_d OR 2'-0" MIN EXCEPT WHERE OPENING EXCEEDS 4'-0" IN WIDTH EXTEND FROM THE FLOOR TO ROOF


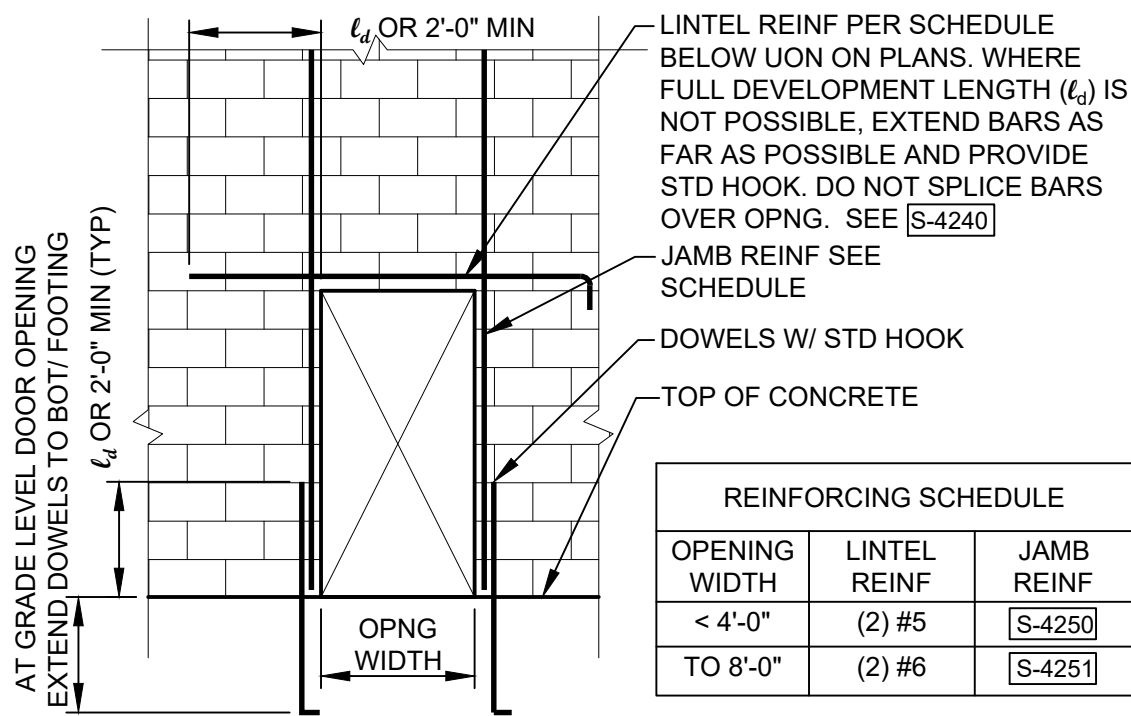


CMU ELEVATION
PERSONNEL DOOR
SCALE: 1/4" = 1'-0"
REV 00

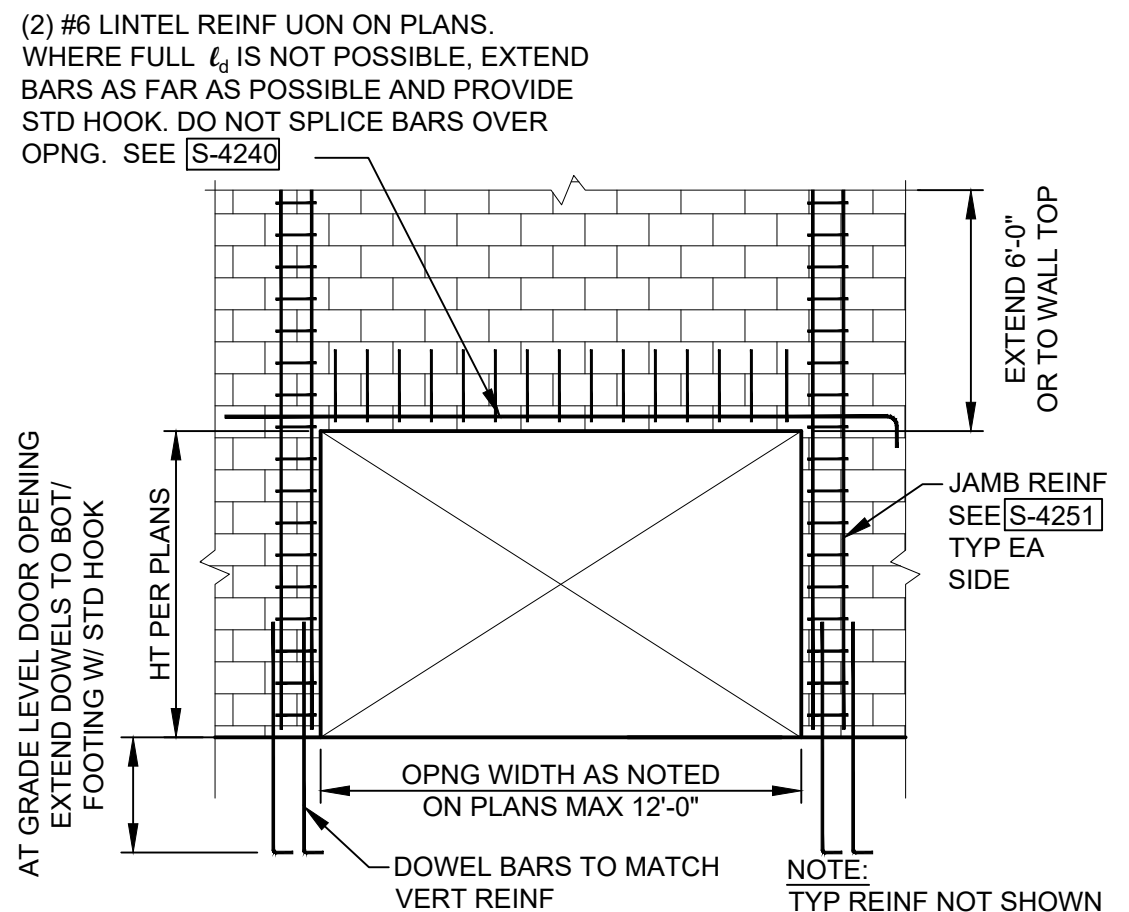


CMU ELEVATION
ROLL-UP DOOR
SCALE: 1/4" = 1'-0"
REV 00

- NOTES:
1. TYP REINF NOT SHOWN.
 2. FOR REINF AT WALL OPENINGS SEE [S-4330]
 3. FOR REINF AT PERSONNEL AND ROLL-UP DOORS SEE [S-4350] & [S-4360]

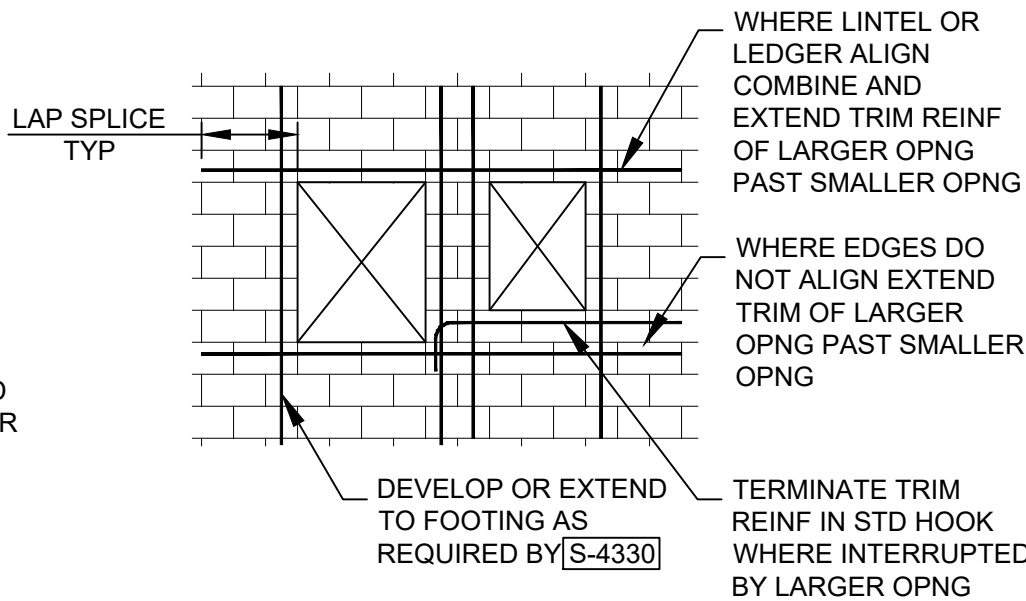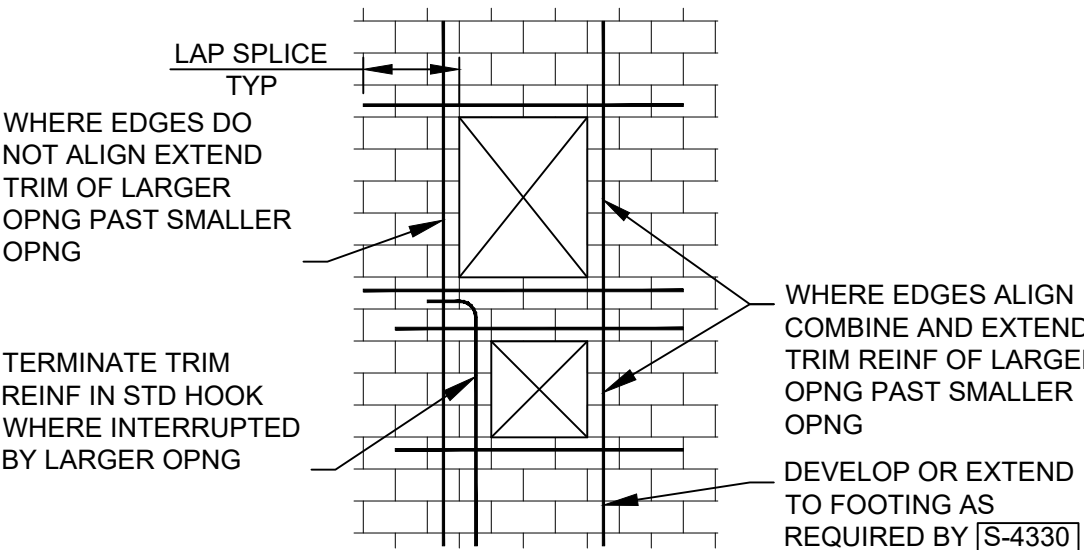

CMU WALL REINF
AT ADJACENT OPENINGS
SCALE: 1/4" = 1'-0"
REV 00

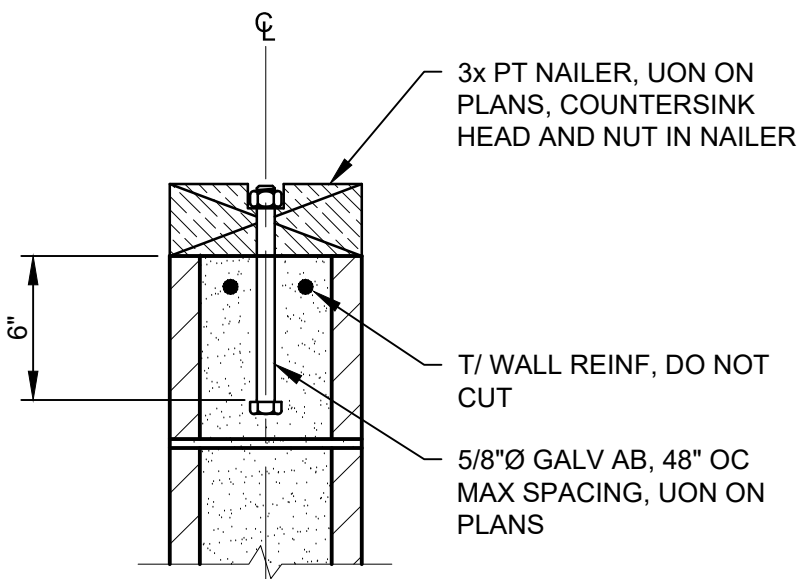

WOOD NAILER
OVER CMU WALL
SCALE: 1-1/2" = 1'-0"
REV 00

USE OF DOCUMENTS

THIS DOCUMENT, INCLUDING THE INCORPORATED DESIGNS, IS AN INSTRUMENT OF SERVICE FOR THIS PROJECT AND SHALL NOT BE USED FOR ANY OTHER PROJECT WITHOUT THE WRITTEN AUTHORIZATION OF KENNEDY/JENKS CONSULTANTS.

NO.	REVISION	DATE	BY
-----	----------	------	----

SCALES
0 1"
0 25mm
IF THIS BAR IS NOT DIMENSION SHOWN, ADJUST SCALES ACCORDINGLY.



DESIGNED
STP
DRAWN
STP
CHECKED
JDS




CITY OF ISSAQUAH
ISSAQUAH, WASHINGTON
SOUTH SPAR BOOSTER PUMP STATION

Kennedy/Jenks Consultants
FEDERAL WAY, WASHINGTON


STRUCTURAL
NOTES AND STANDARD DETAILS - 3

90% SUBMITTAL (REVISED 7/1/2020)


FILE NAME
139700500-S005.DWG
JOB NO.
1397005'00
DATE
JUNE 2020
SHEET
66 OF 83
S5

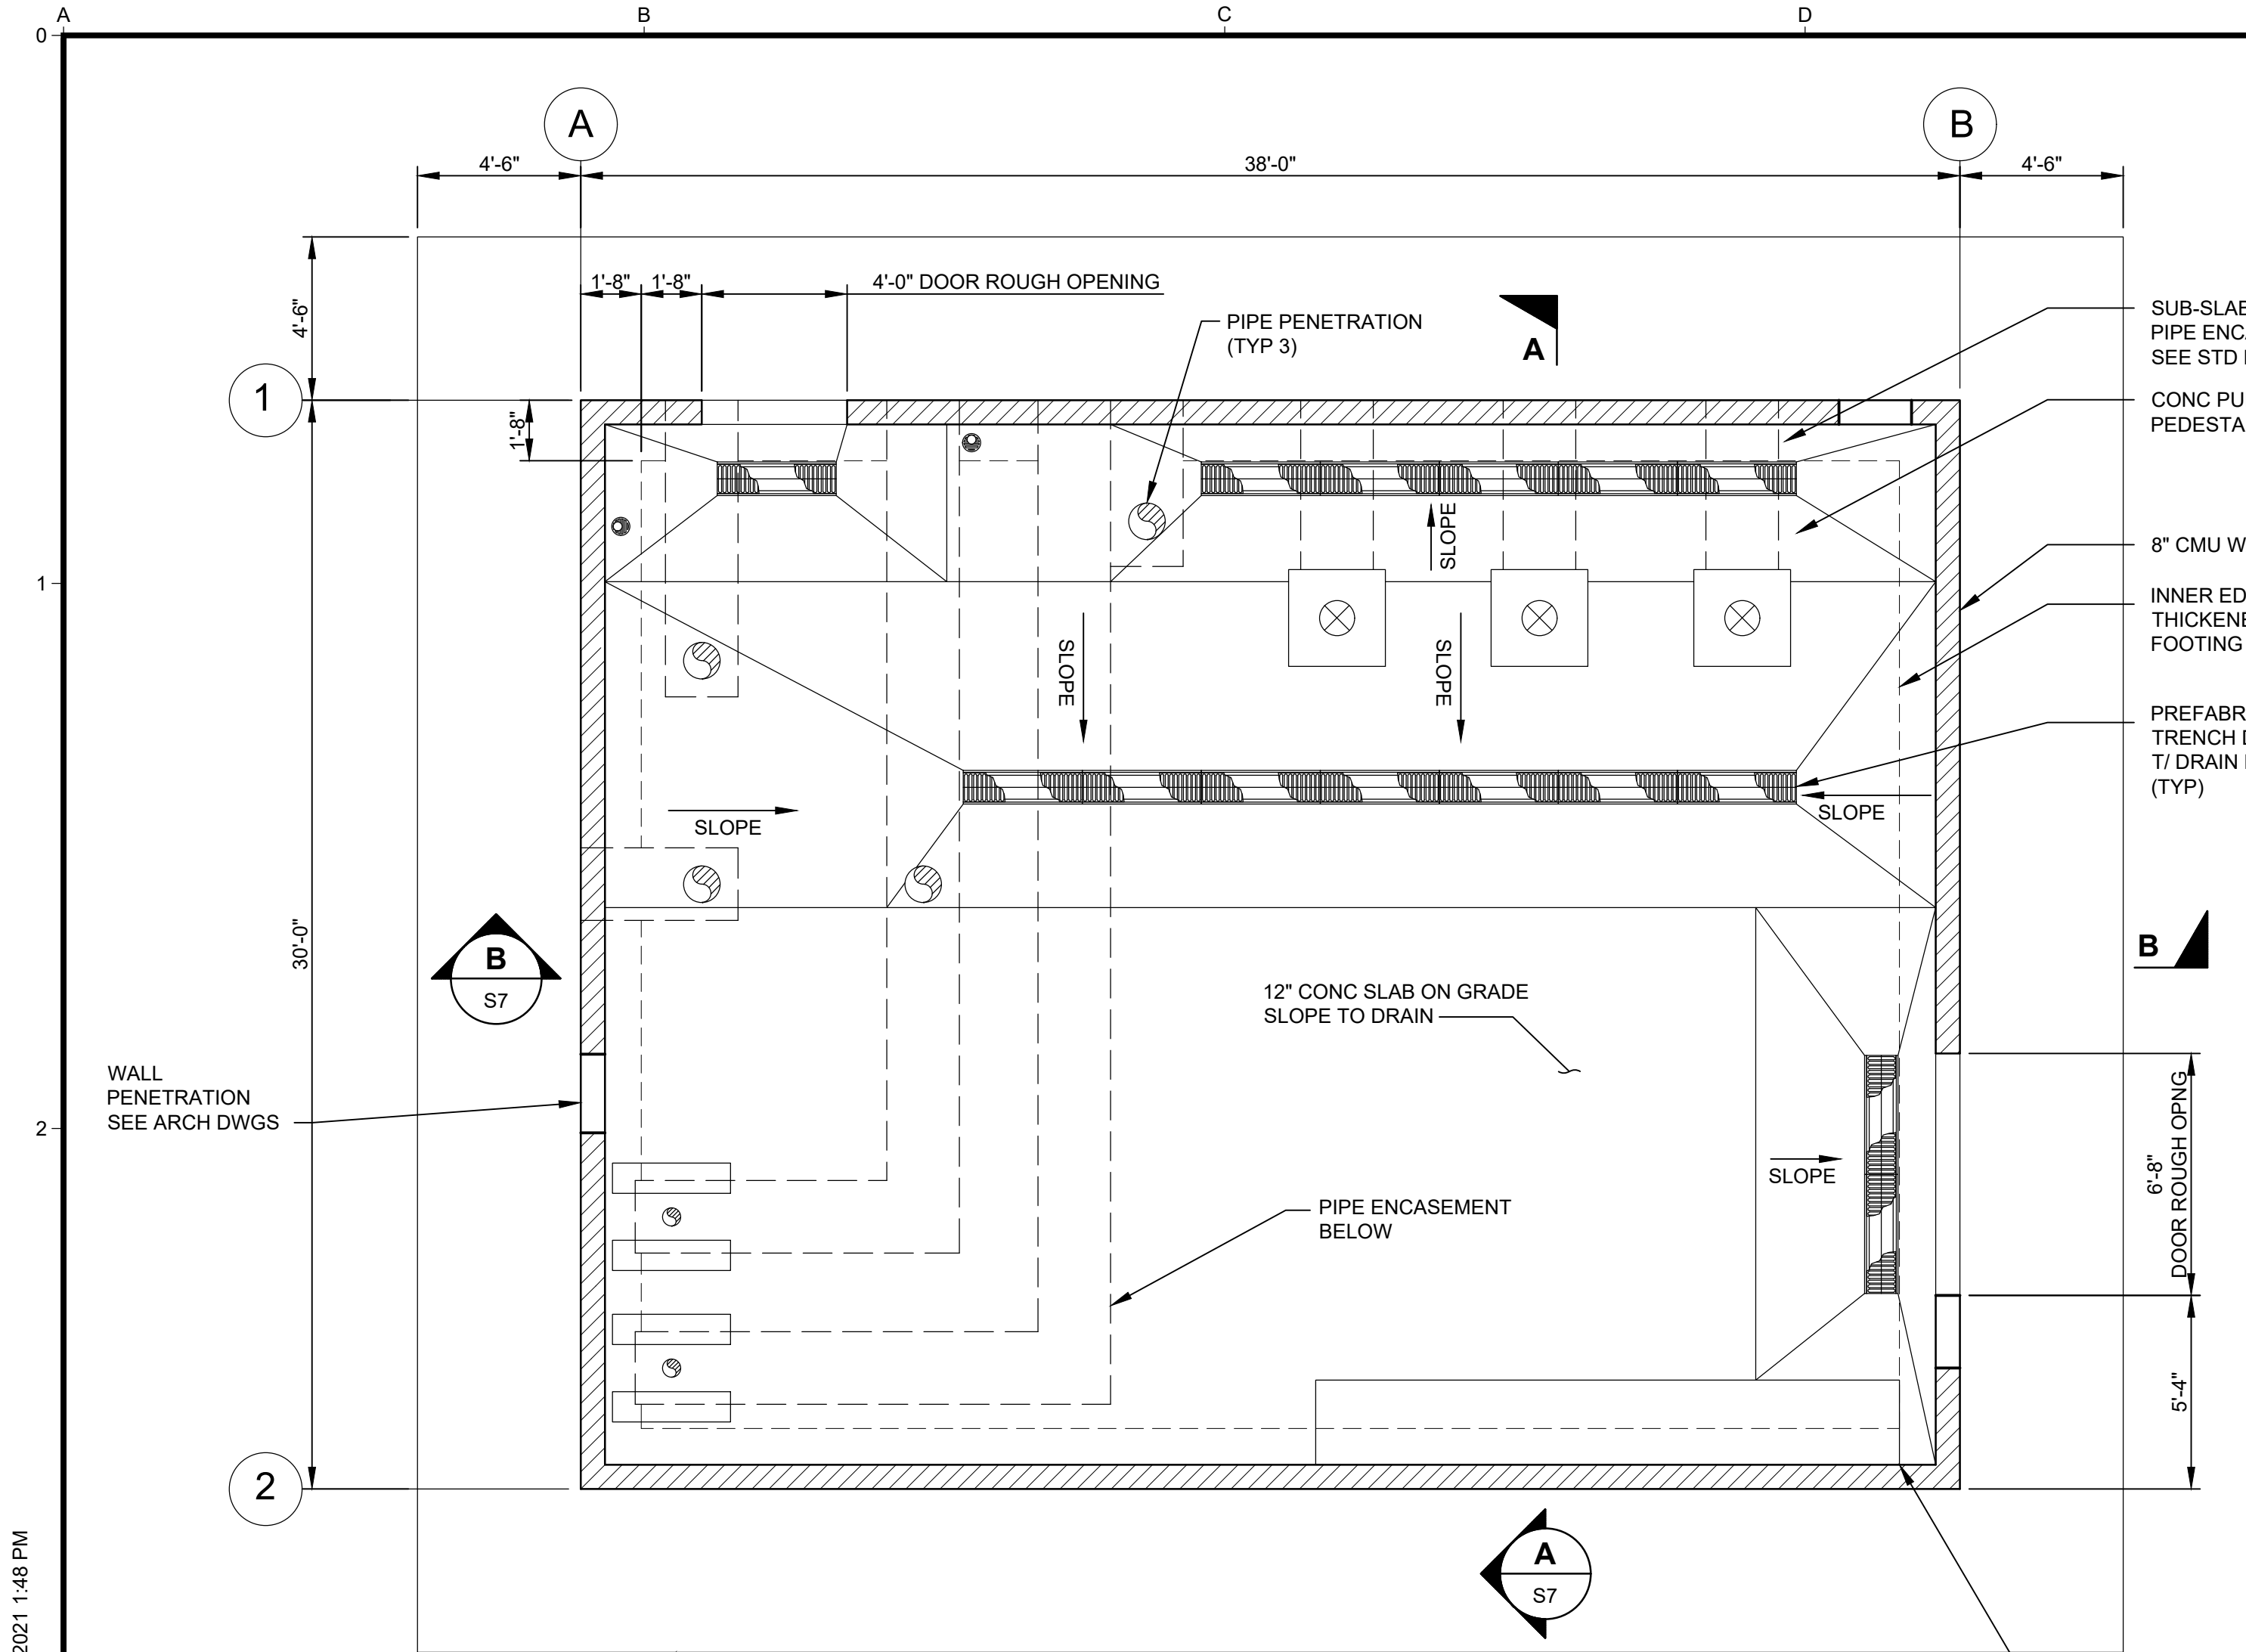

FOUNDATION PLAN

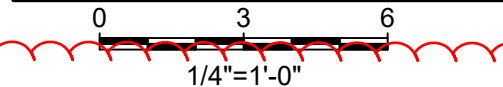


SIDEWALK (TYP)
SEE SHEET C2 AND DETAIL S-3332

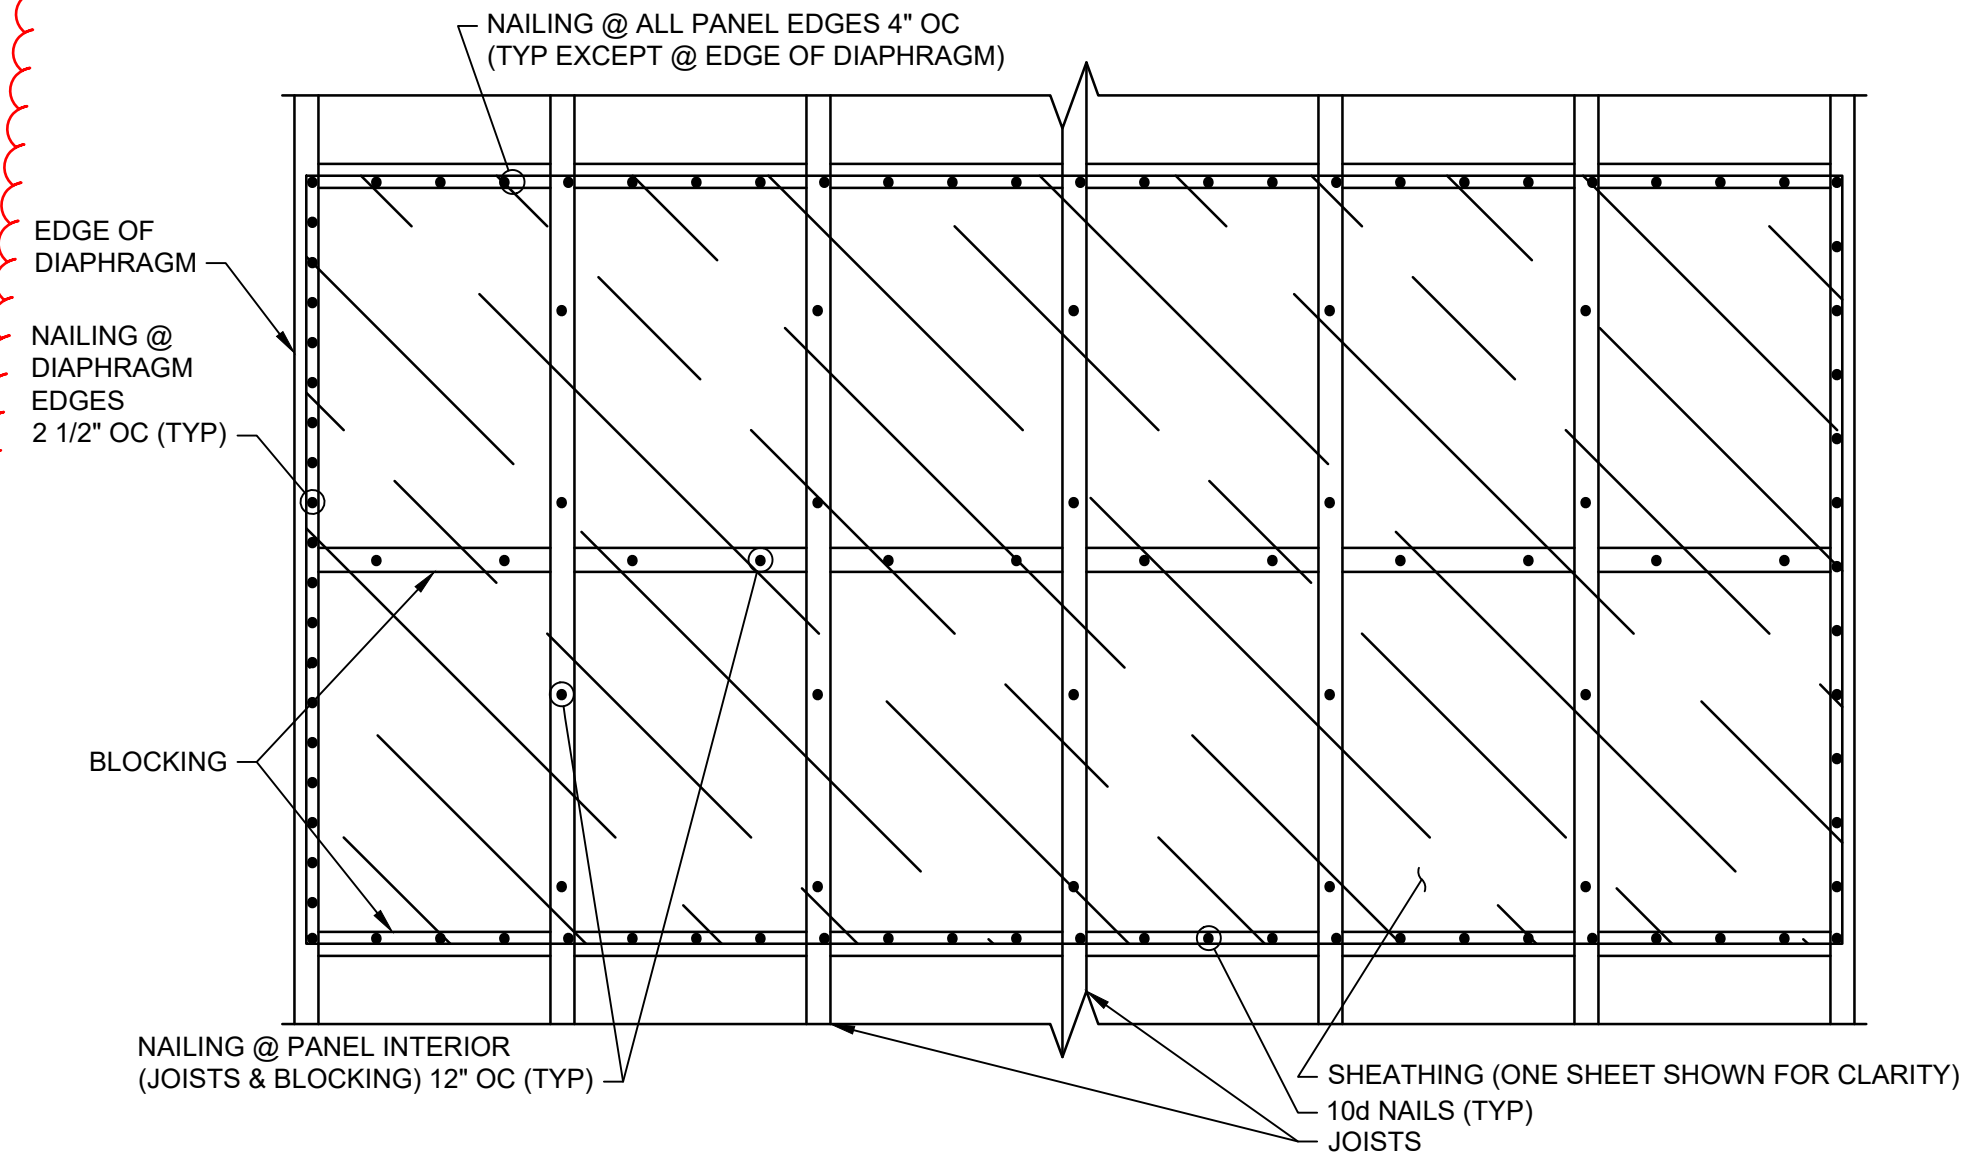

DIAPHRAGM NAILING DETAIL


1

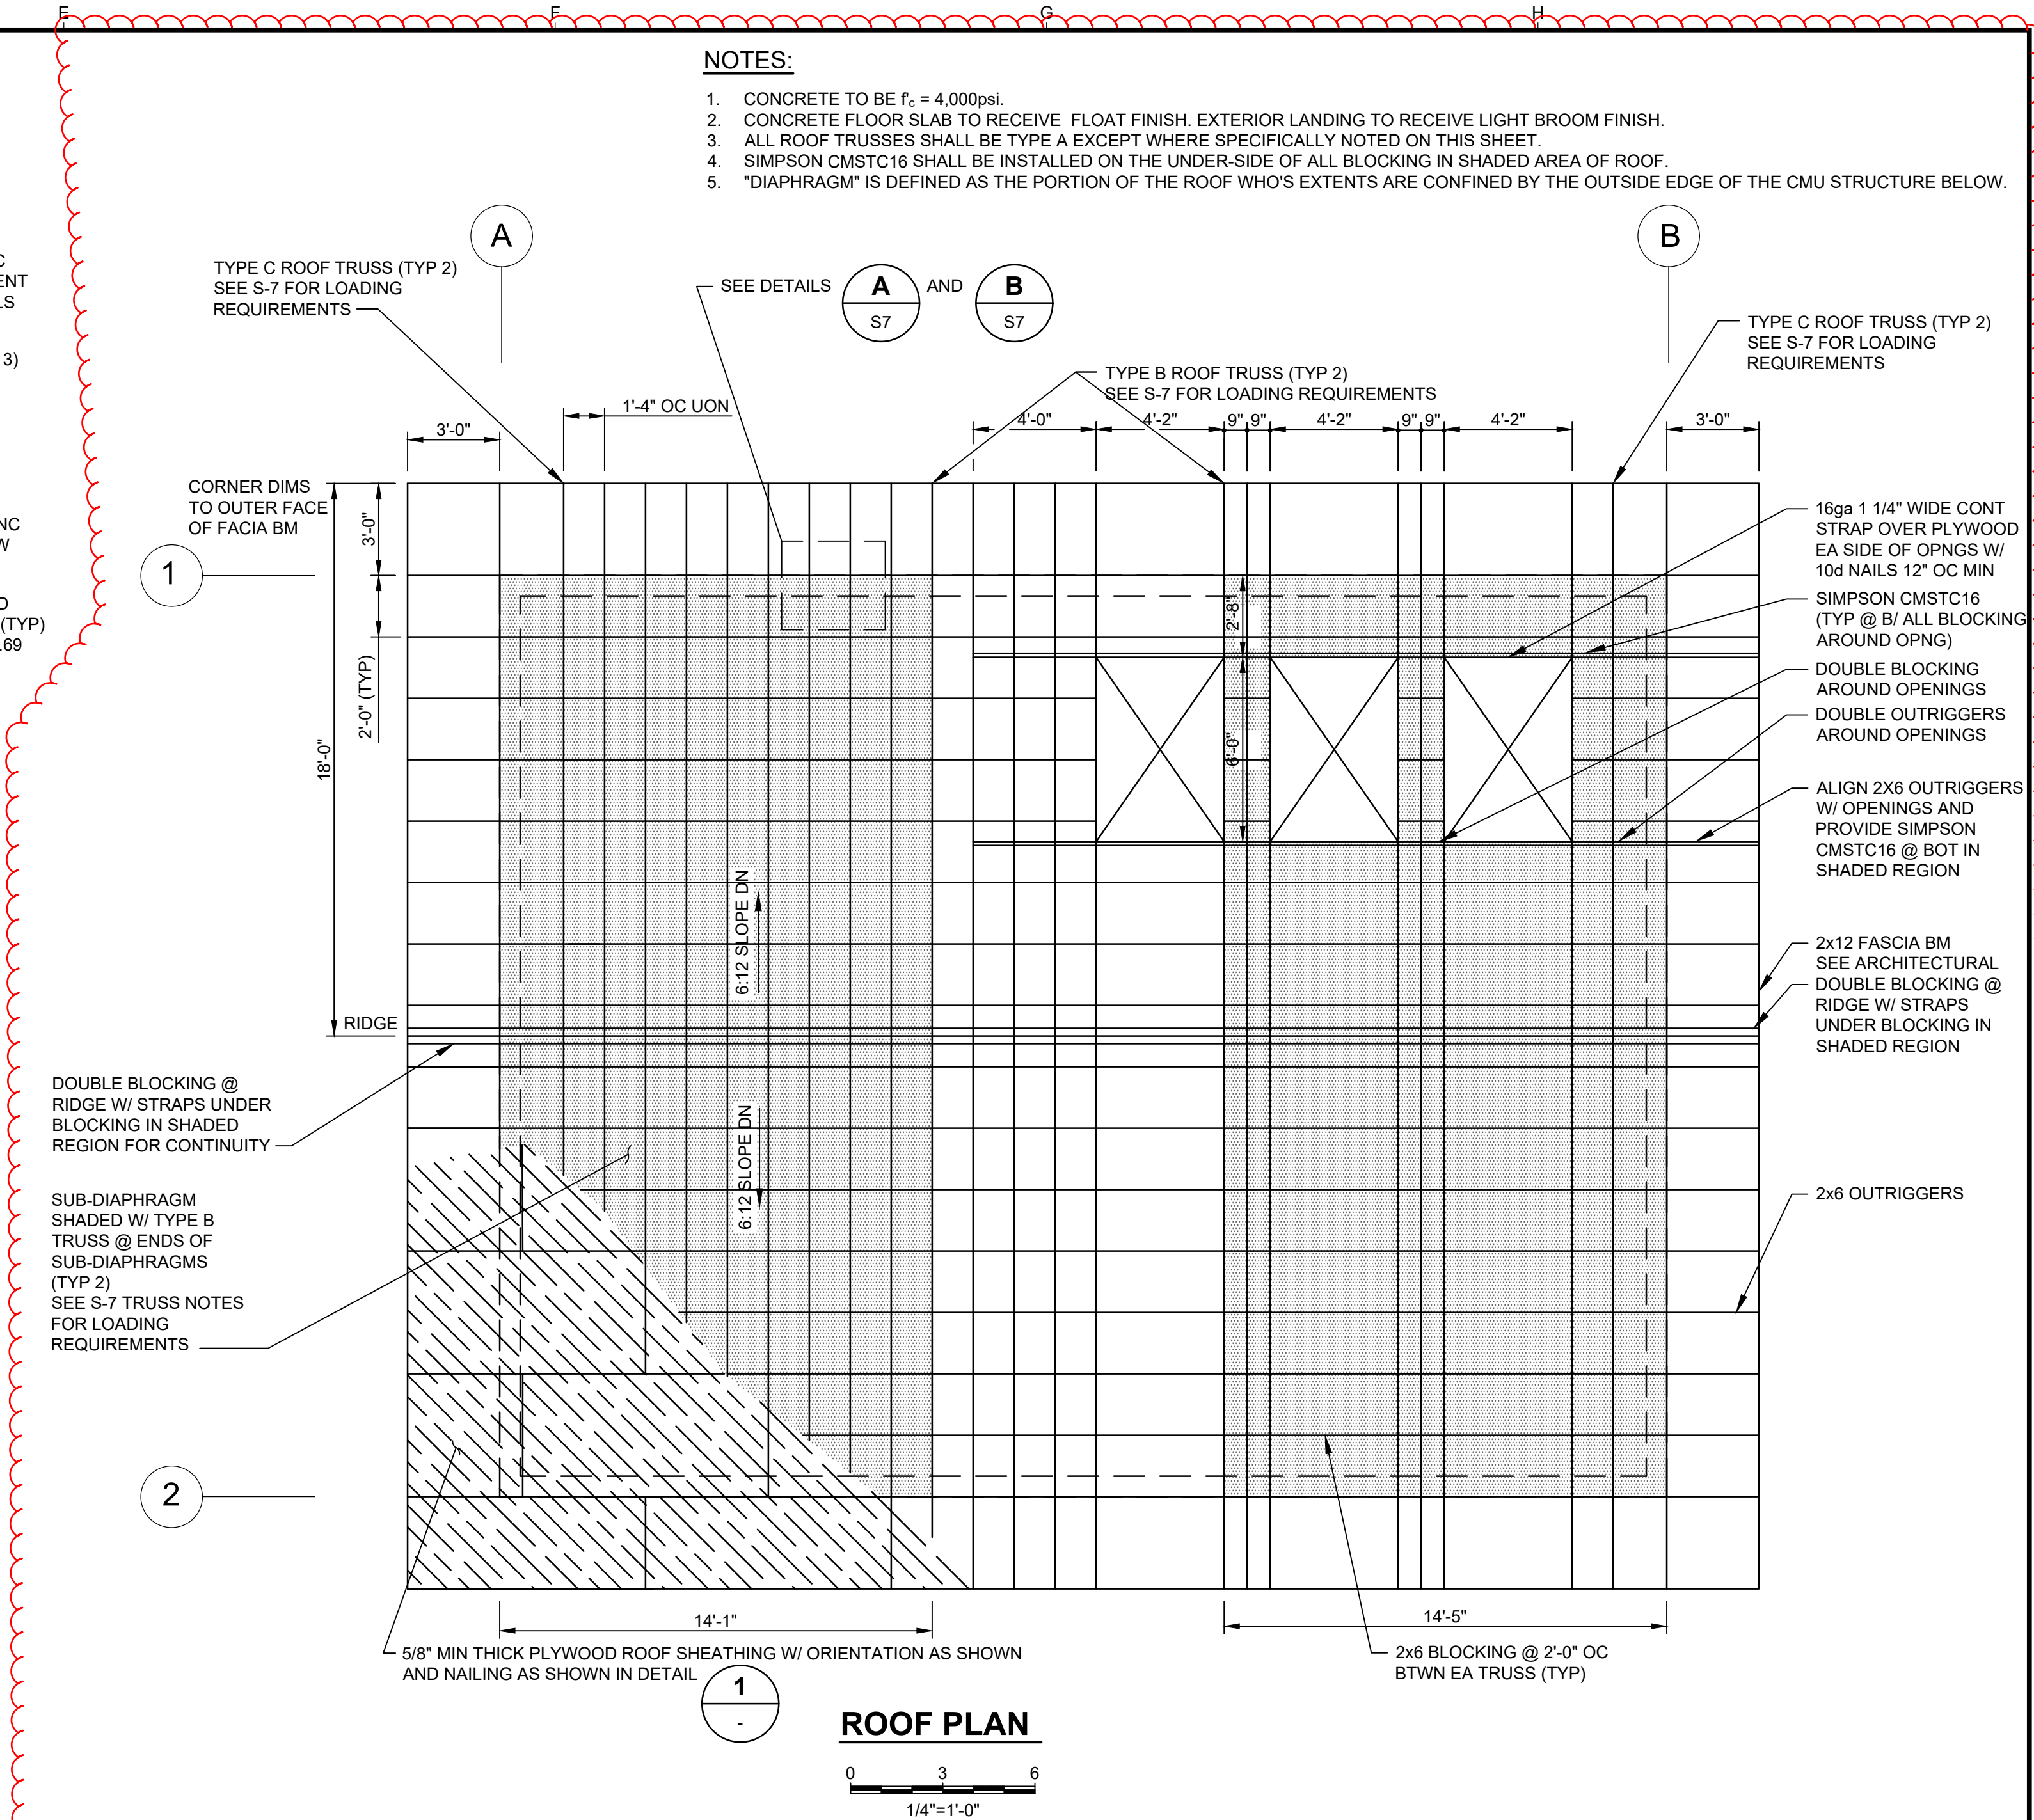

NOTES:

1. CONCRETE TO BE $f_c = 4,000$ psi.
2. CONCRETE FLOOR SLAB TO RECEIVE FLOAT FINISH. EXTERIOR LANDING TO RECEIVE LIGHT BROOM FINISH.
3. ALL ROOF TRUSSES SHALL BE TYPE A EXCEPT WHERE SPECIFICALLY NOTED ON THIS SHEET.
4. SIMPSON CMSTC16 SHALL BE INSTALLED ON THE UNDER-SIDE OF ALL BLOCKING IN SHADED AREA OF ROOF.
5. "DIAPHRAGM" IS DEFINED AS THE PORTION OF THE ROOF WHO'S EXTENTS ARE CONFINED BY THE OUTSIDE EDGE OF THE CMU STRUCTURE BELOW.

ROOF PLAN

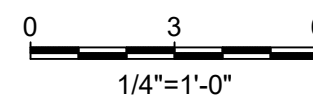

STEVEPRITCHETT 2/11/2021 1:48 PM


\\jc-kc-rook-KJ-Cad\FederalWay\CAD\131\1397005.00_City_of_Issaquah\139700500-S006.dwg

USE OF DOCUMENTS

THIS DOCUMENT, INCLUDING THE INCORPORATED DESIGNS, IS AN INSTRUMENT OF SERVICE FOR THIS PROJECT AND SHALL NOT BE USED FOR ANY OTHER PROJECT WITHOUT THE WRITTEN AUTHORIZATION OF KENNEDY/JENKS CONSULTANTS.

NO.	REVISION	DATE	BY
####	####	####	####

SCALES

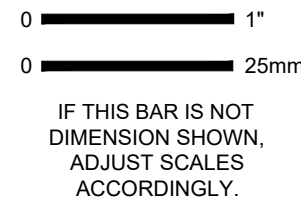

DESIGNED	STP
DRAWN	STP
CHECKED	JDS




CITY OF ISSAQUAH
ISSAQUAH, WASHINGTON
SOUTH SPAR BOOSTER PUMP STATION

Kennedy/Jenks Consultants
FEDERAL WAY, WASHINGTON

PUMP STATION FOUNDATION PLAN AND ROOF PLAN

FILE NAME	139700500-S006.DWG
JOB NO.	1397005'00
DATE	FEBRUARY 2021
SHEET	OF

S6

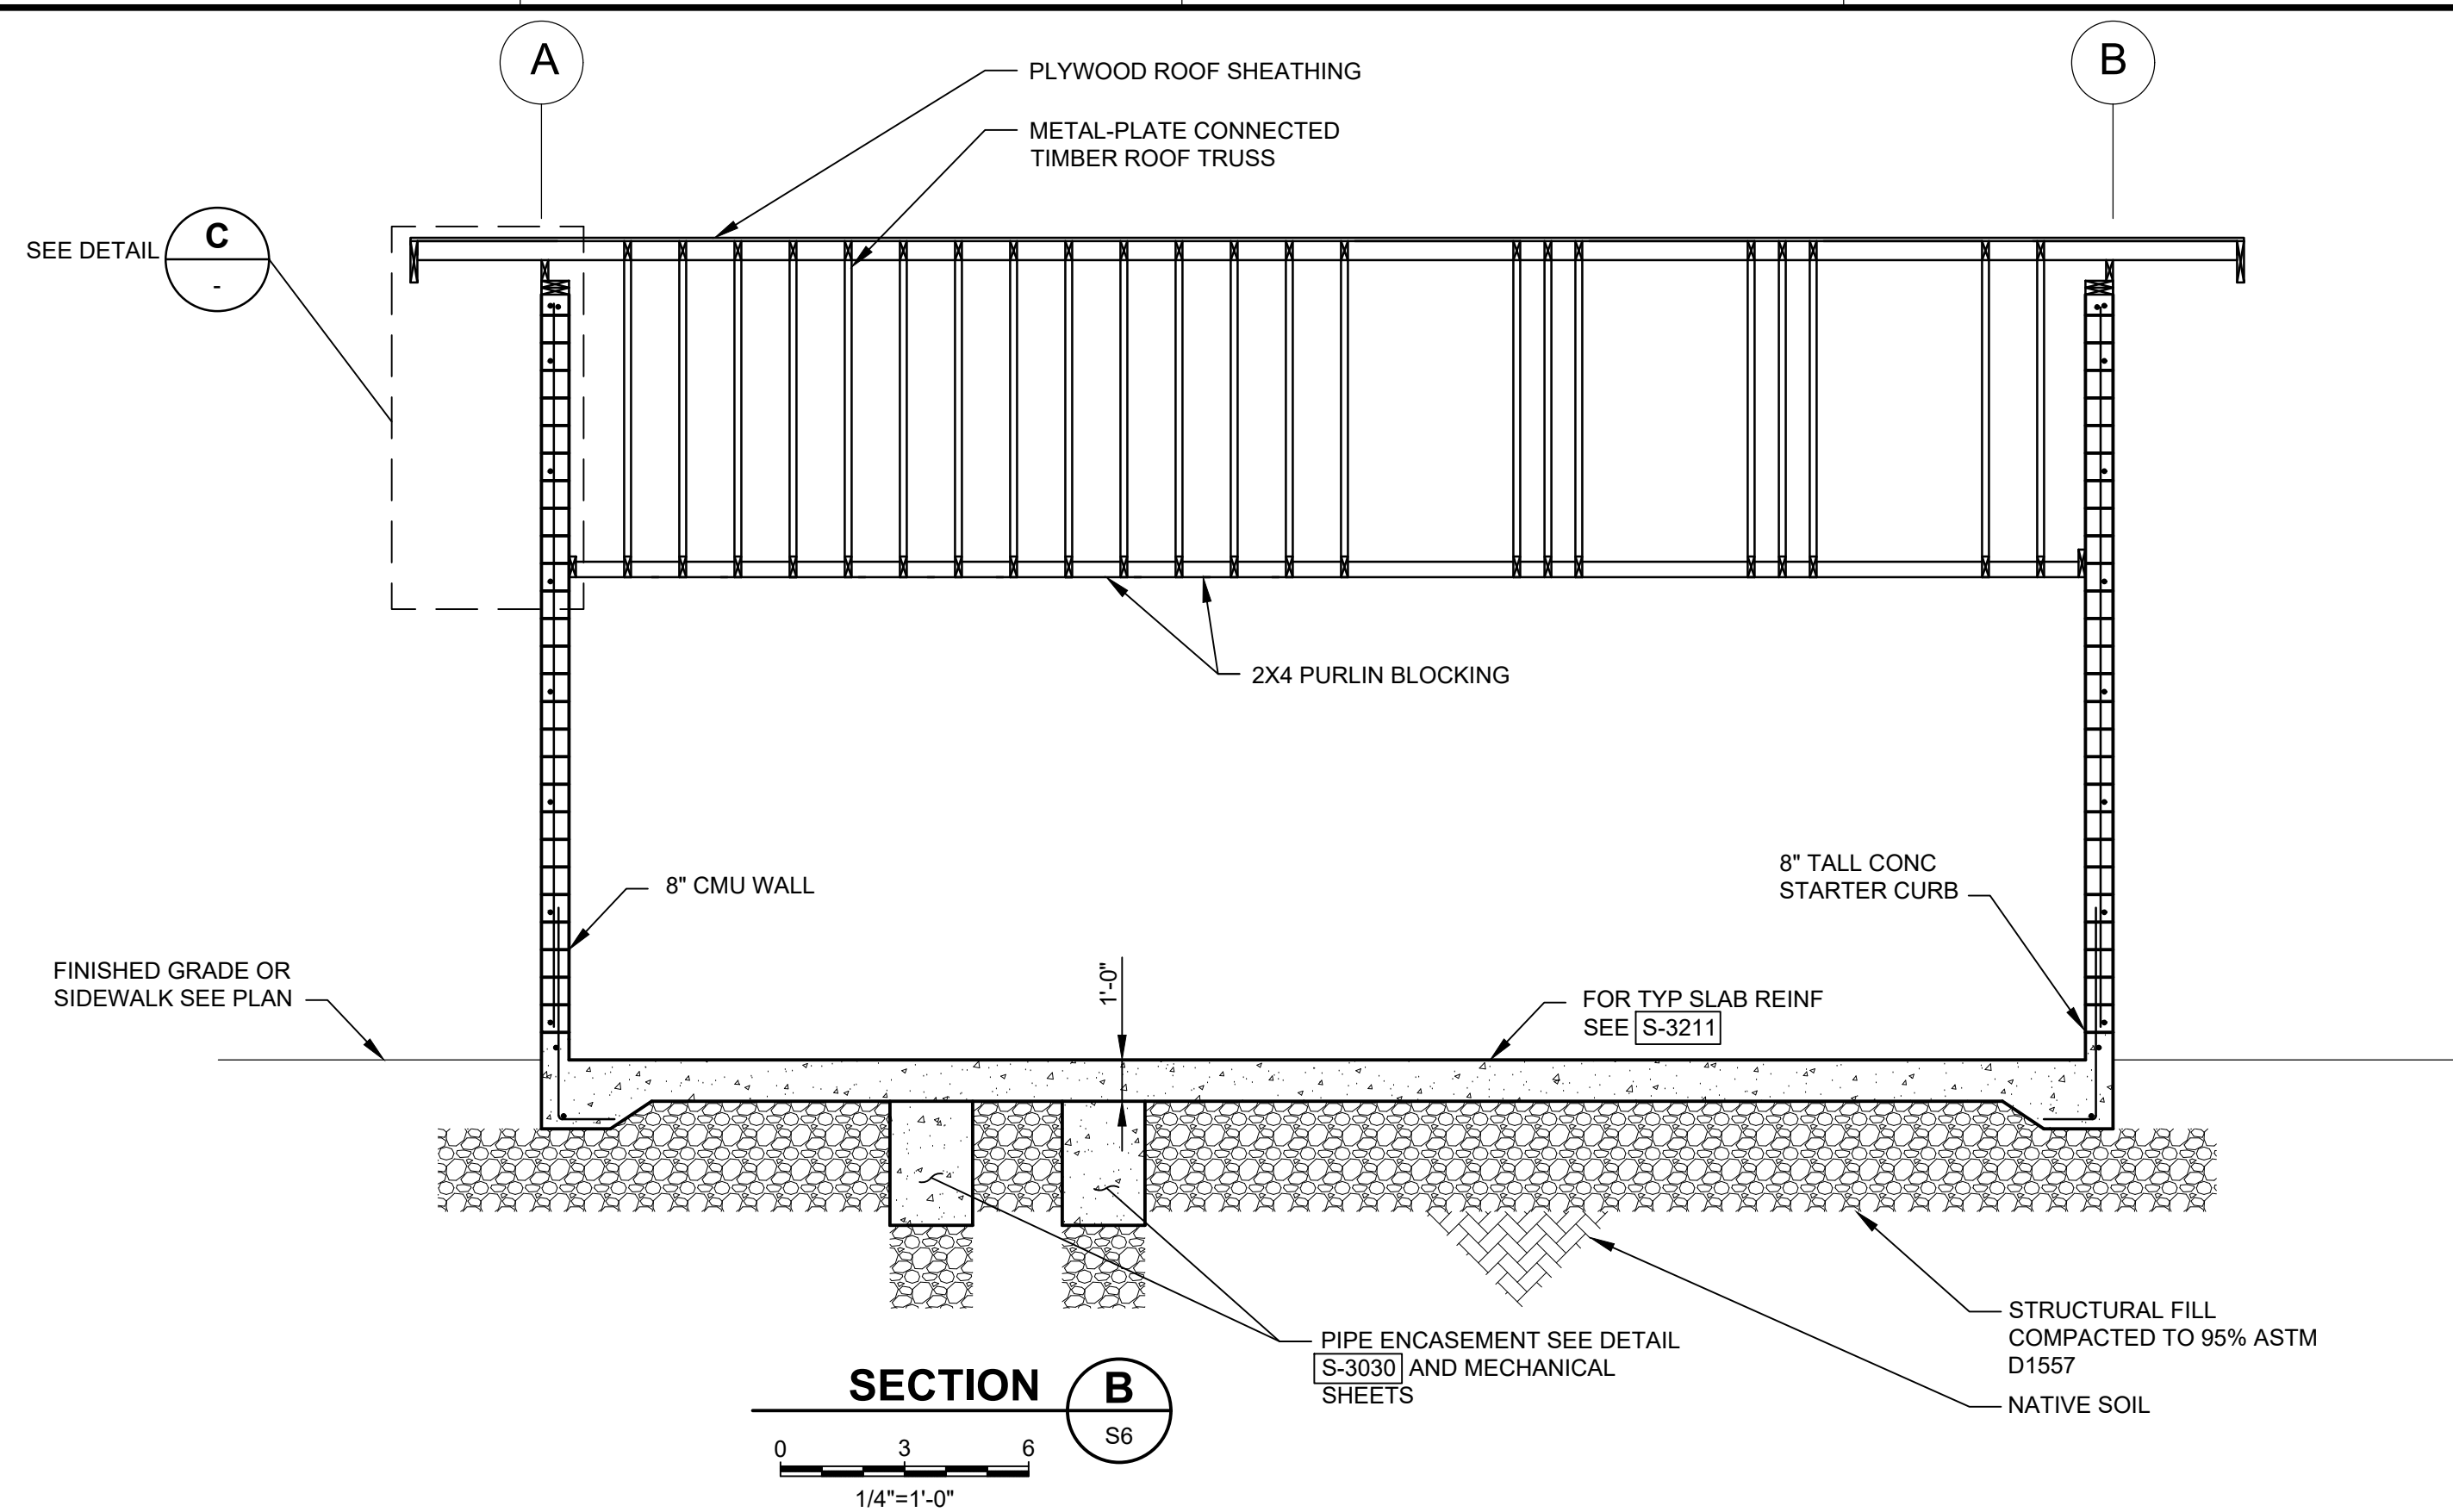


1.	DESIGN ROOF TRUSSES FOR THE FOLLOWING MINIMUM UNFACTORED LOADS.		
	DEAD LOAD (NOT INCLUDING JOIST SELF WEIGHT)		
	ON TOP CHORD	20 PSF	
	ON BOTTOM CHORD	5 PSF	
	HANGING POINT LOAD ANYWHERE		
	ALONG BOTTOM CHORD	200 LB	
	LIVE LOAD		
	HANGING POINT LOAD ANYWHERE		
	ALONG BOT CHORD	500 LB	
	ON TOP CHORD	20 PSF	
	WIND LOAD: AT BASIC WIND SPEED OF 115 MPH, EXPOSURE CAT C	-24 PSF/ 16 PSF	
	NET UPLIFT/DOWNPRESSURE	TYPE C: 312 PLF ADDITIONAL DOWNWARD LOADING FROM OUTRIGGERS	
	SEISMIC LOAD:	TYPE A: 1,300 LBS AXIAL TENSION AND COMPRESSION @ FULL LENGTH	
		TYPE B: 4,900 LBS AXIAL TENSION AND COMPRESSION @ FULL LENGTH	
	SNOW LOAD:	25 PSF UNIFORM	
		.30 PSF UNBALANCED	


Diagram illustrating the roof ridge assembly components and their connections:

- PLYWOOD SHEATHING
- 3x8 BLOCKING (TYP @ RIDGE)
- 2x6 DBL BLOCKING (TYP @ RIDGE)
- SIMPSON CMSTC16 STRAP (TYP)
- ROOF TRUSS
- 2x6 BLOCKING (TYP)


1

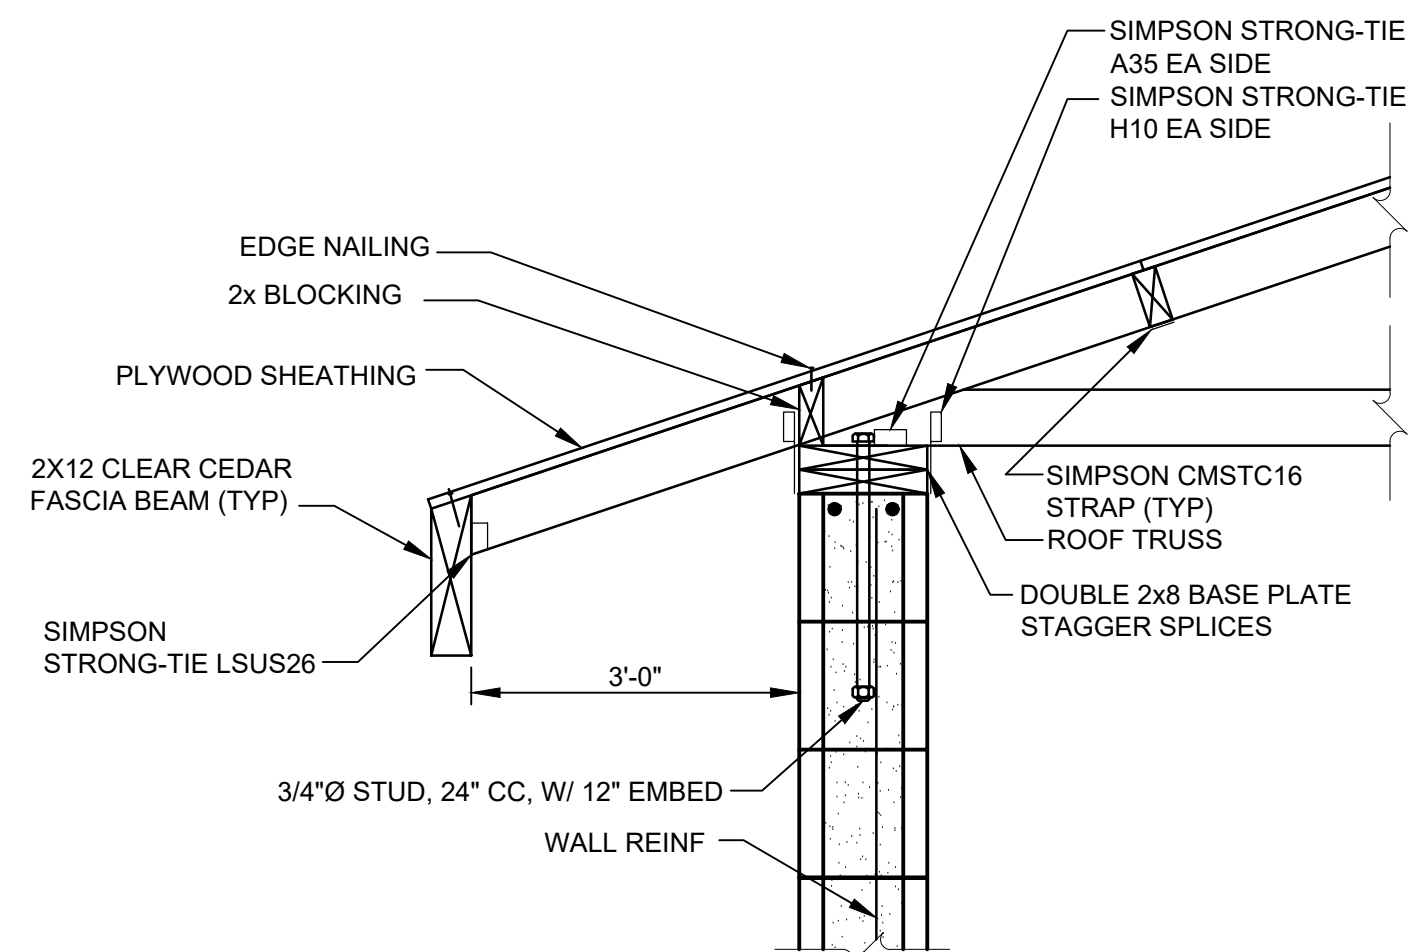

A

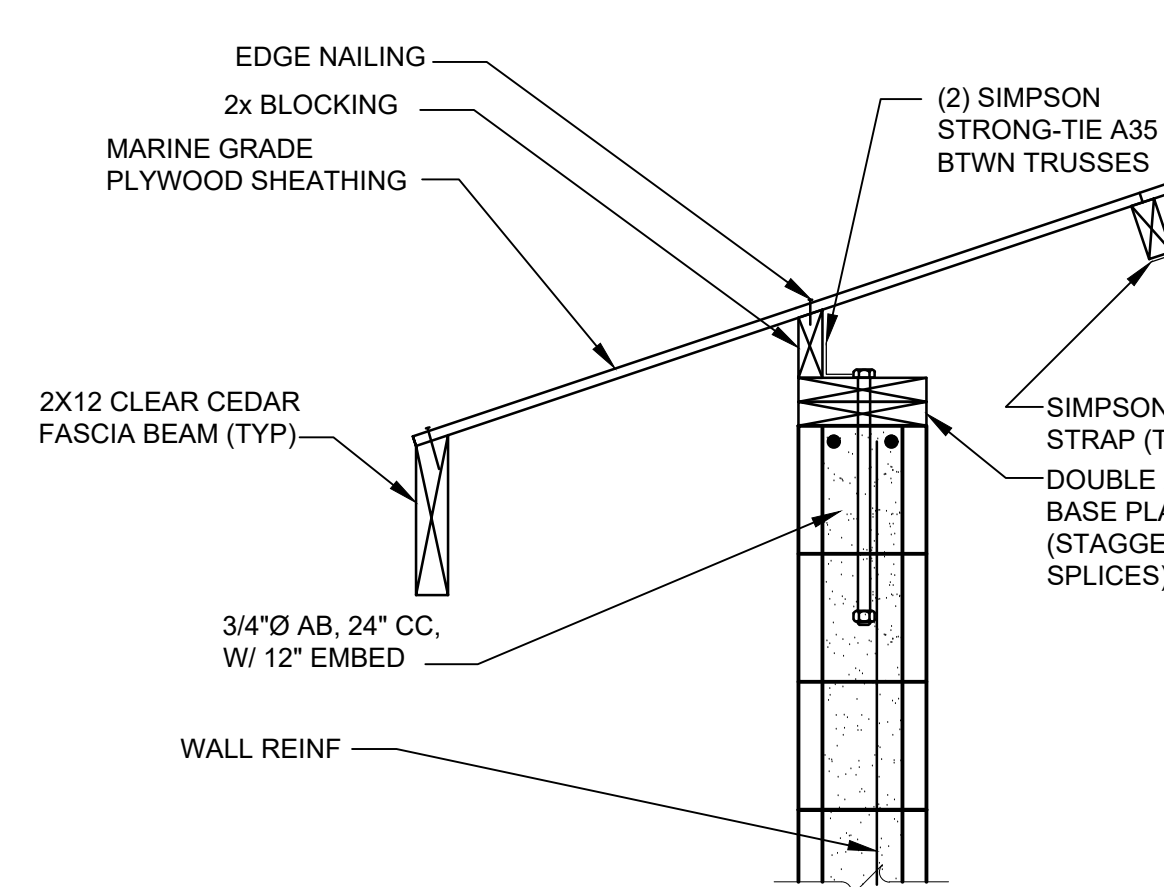


B

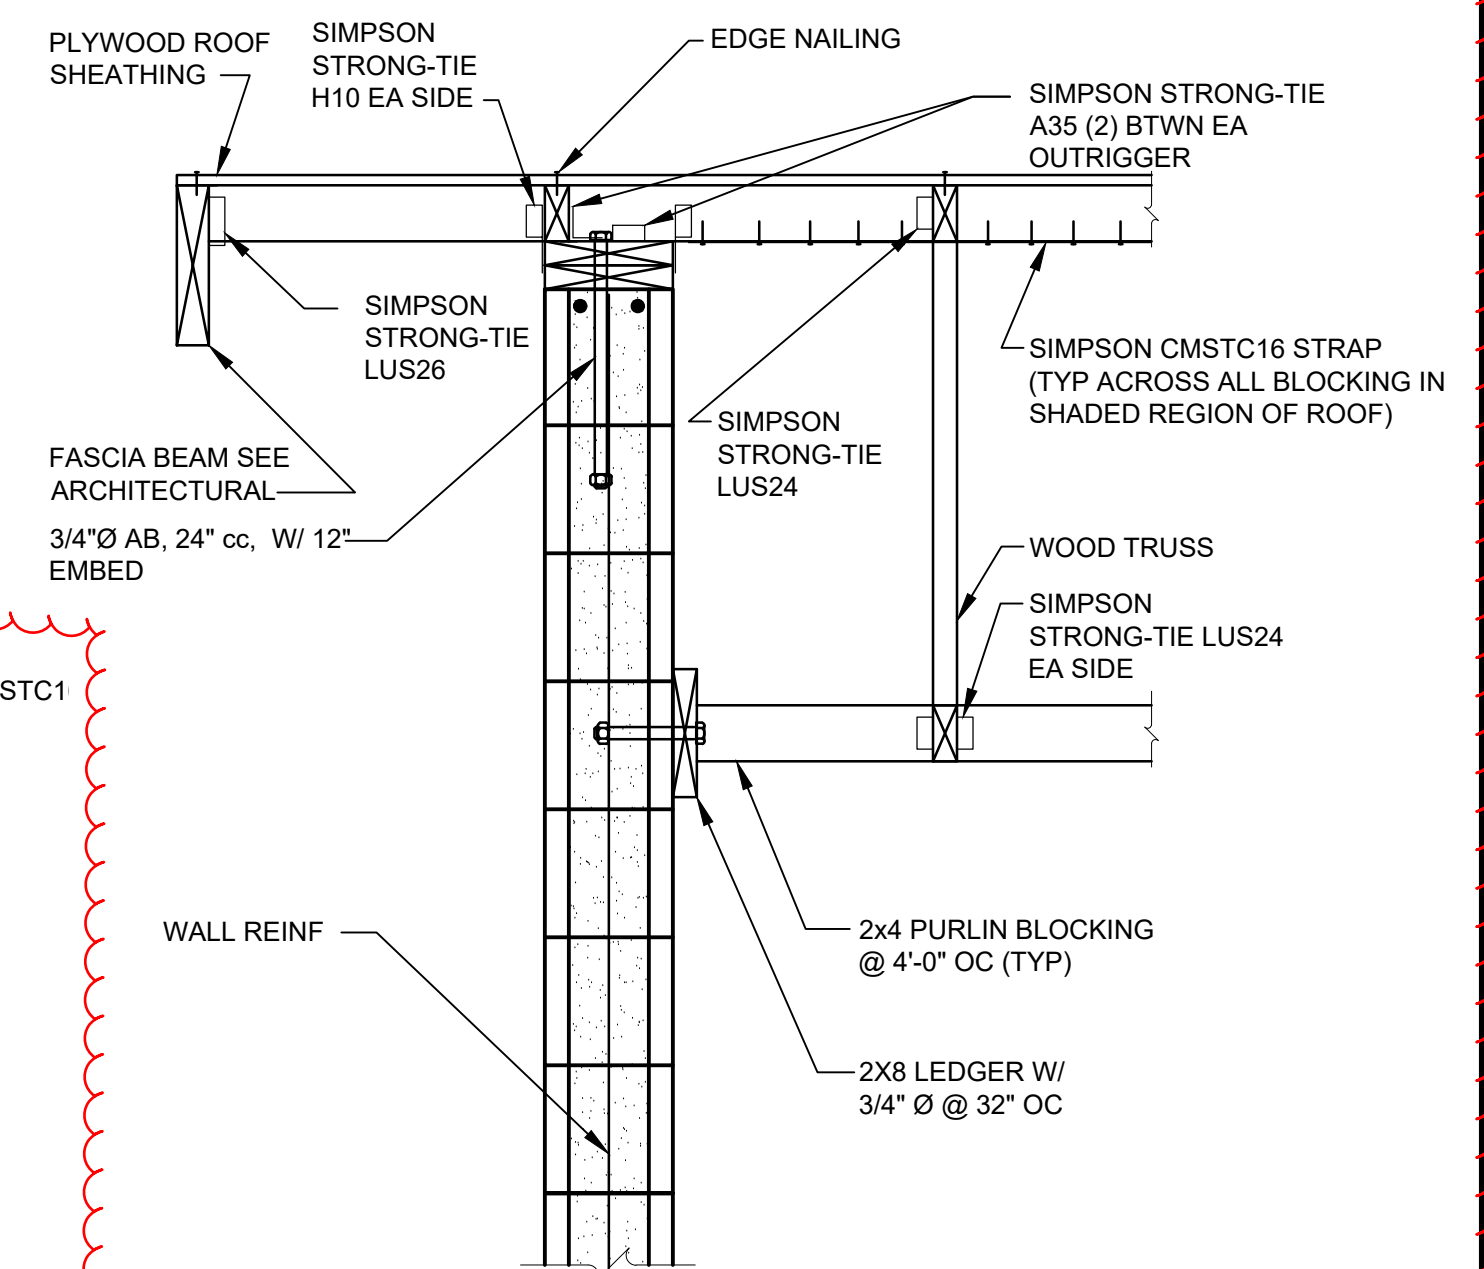


C


<p>USE OF DOCUMENTS</p> <p>THIS DOCUMENT, INCLUDING THE INCORPORATED DESIGNS, IS AN INSTRUMENT OF SERVICE FOR THIS PROJECT AND SHALL NOT BE USED FOR ANY OTHER PROJECT WITHOUT THE WRITTEN AUTHORIZATION OF KENNEDY/JENKS CONSULTANTS.</p>			
	NO.	REVISION	DATE BY

SCALES

0  1"

0  25mm

IF THIS BAR IS NOT
DIMENSION SHOWN,
ADJUST SCALES
ACCORDINGLY.

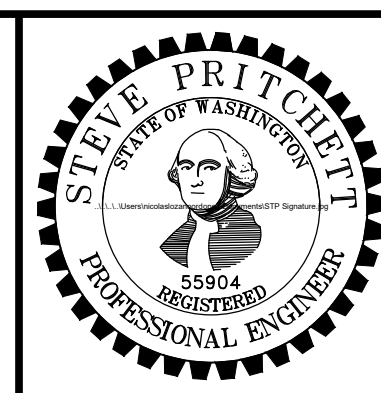


DESIGNED	STP
DRAWN	STP
CHECKED	JDS




Kennedy/Jenks Consultants
FEDERAL WAY, WASHINGTON

FILE NAME	139700500-S007.DWG
JOB NO.	1397005*00
DATE	FEBRUARY 2021
SHEET	OF
S7	

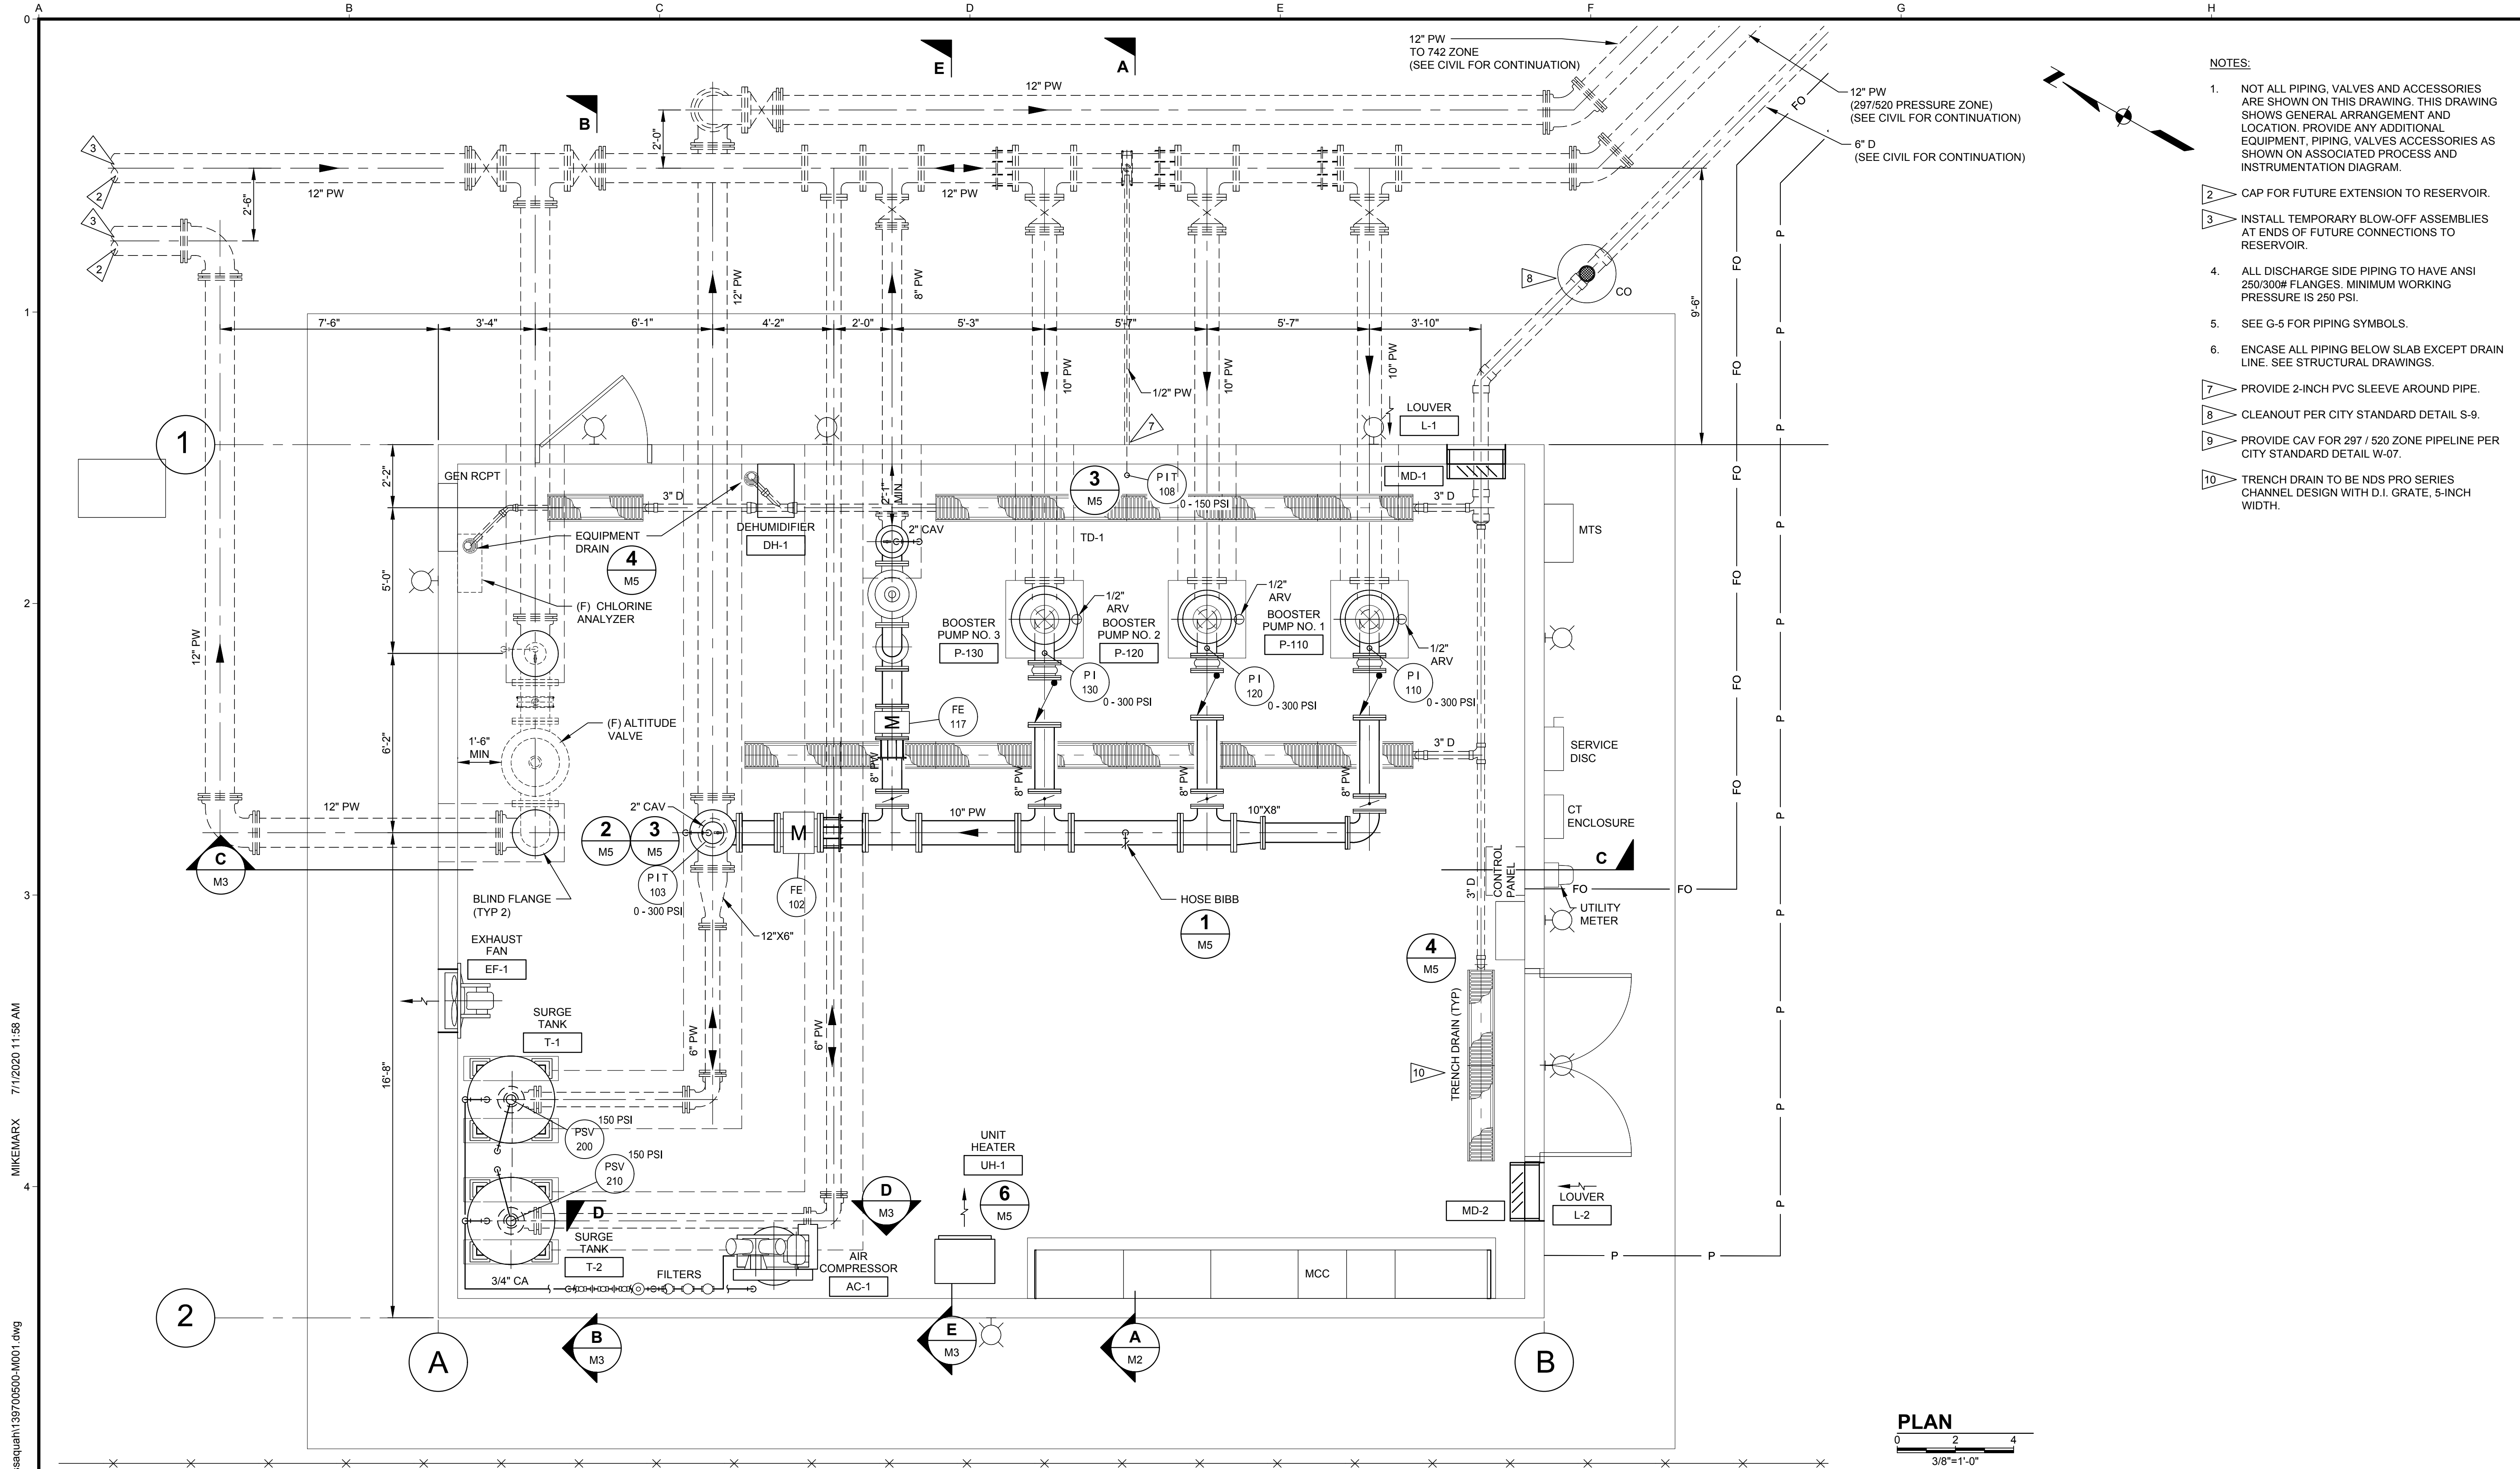



- NOTES:**
- NOT ALL PIPING, VALVES AND ACCESSORIES ARE SHOWN ON THIS DRAWING. THIS DRAWING SHOWS GENERAL ARRANGEMENT AND LOCATION. PROVIDE ANY ADDITIONAL EQUIPMENT, PIPING, VALVES ACCESSORIES AS SHOWN ON ASSOCIATED PROCESS AND INSTRUMENTATION DIAGRAM.
 - CAP FOR FUTURE EXTENSION TO RESERVOIR.
 - INSTALL TEMPORARY BLOW-OFF ASSEMBLIES AT ENDS OF FUTURE CONNECTIONS TO RESERVOIR.
 - ALL DISCHARGE SIDE PIPING TO HAVE ANSI 250/300# FLANGES. MINIMUM WORKING PRESSURE IS 250 PSI.
 - SEE G-5 FOR PIPING SYMBOLS.
 - ENCASE ALL PIPING BELOW SLAB EXCEPT DRAIN LINE. SEE STRUCTURAL DRAWINGS.
 - PROVIDE 2-INCH PVC SLEEVE AROUND PIPE.
 - CLEANOUT PER CITY STANDARD DETAIL S-9.
 - PROVIDE CAV FOR 297 / 520 ZONE PIPELINE PER CITY STANDARD DETAIL W-07.
 - TRENCH DRAIN TO BE NDS PRO SERIES CHANNEL DESIGN WITH D.I. GRATE, 5-INCH WIDTH.

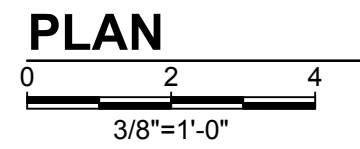

P:\CAD\131\1397005_00_City_of_Issaquah\139700500-M001.dwg
MIKENARYX 7/1/2020 11:58 AM

USE OF DOCUMENTS THIS DOCUMENT, INCLUDING THE INCORPORATED DESIGNS, IS AN INSTRUMENT OF SERVICE FOR THIS PROJECT AND SHALL NOT BE USED FOR ANY OTHER PROJECT WITHOUT THE WRITTEN AUTHORIZATION OF KENNEDY/JENKS CONSULTANTS.					SCALES 1" = 25mm IF THIS BAR IS NOT DIMENSION SHOWN, ADJUST SCALES ACCORDINGLY.		DESIGNED SGH		CITY OF ISSAQUAH ISSAQUAH, WASHINGTON SOUTH SPAR BOOSTER PUMP STATION	PUMP STATION PLAN		FILE NAME 139700500-M001.DWG
							DRAWN LMM			Kennedy/Jenks Consultants FEDERAL WAY, WASHINGTON	90% SUBMITTAL (REVISED 7/1/2020)	JOB NO. 1397005*00
				NO.	REVISION	DATE	BY			DATE JUNE 2020	SHEET 69 OF 83	M1

P:\CAD\131397005_00_City_of_Issaquah\139700500-M002.dwg 6/24/2020 12:02 PM MIKE MARY

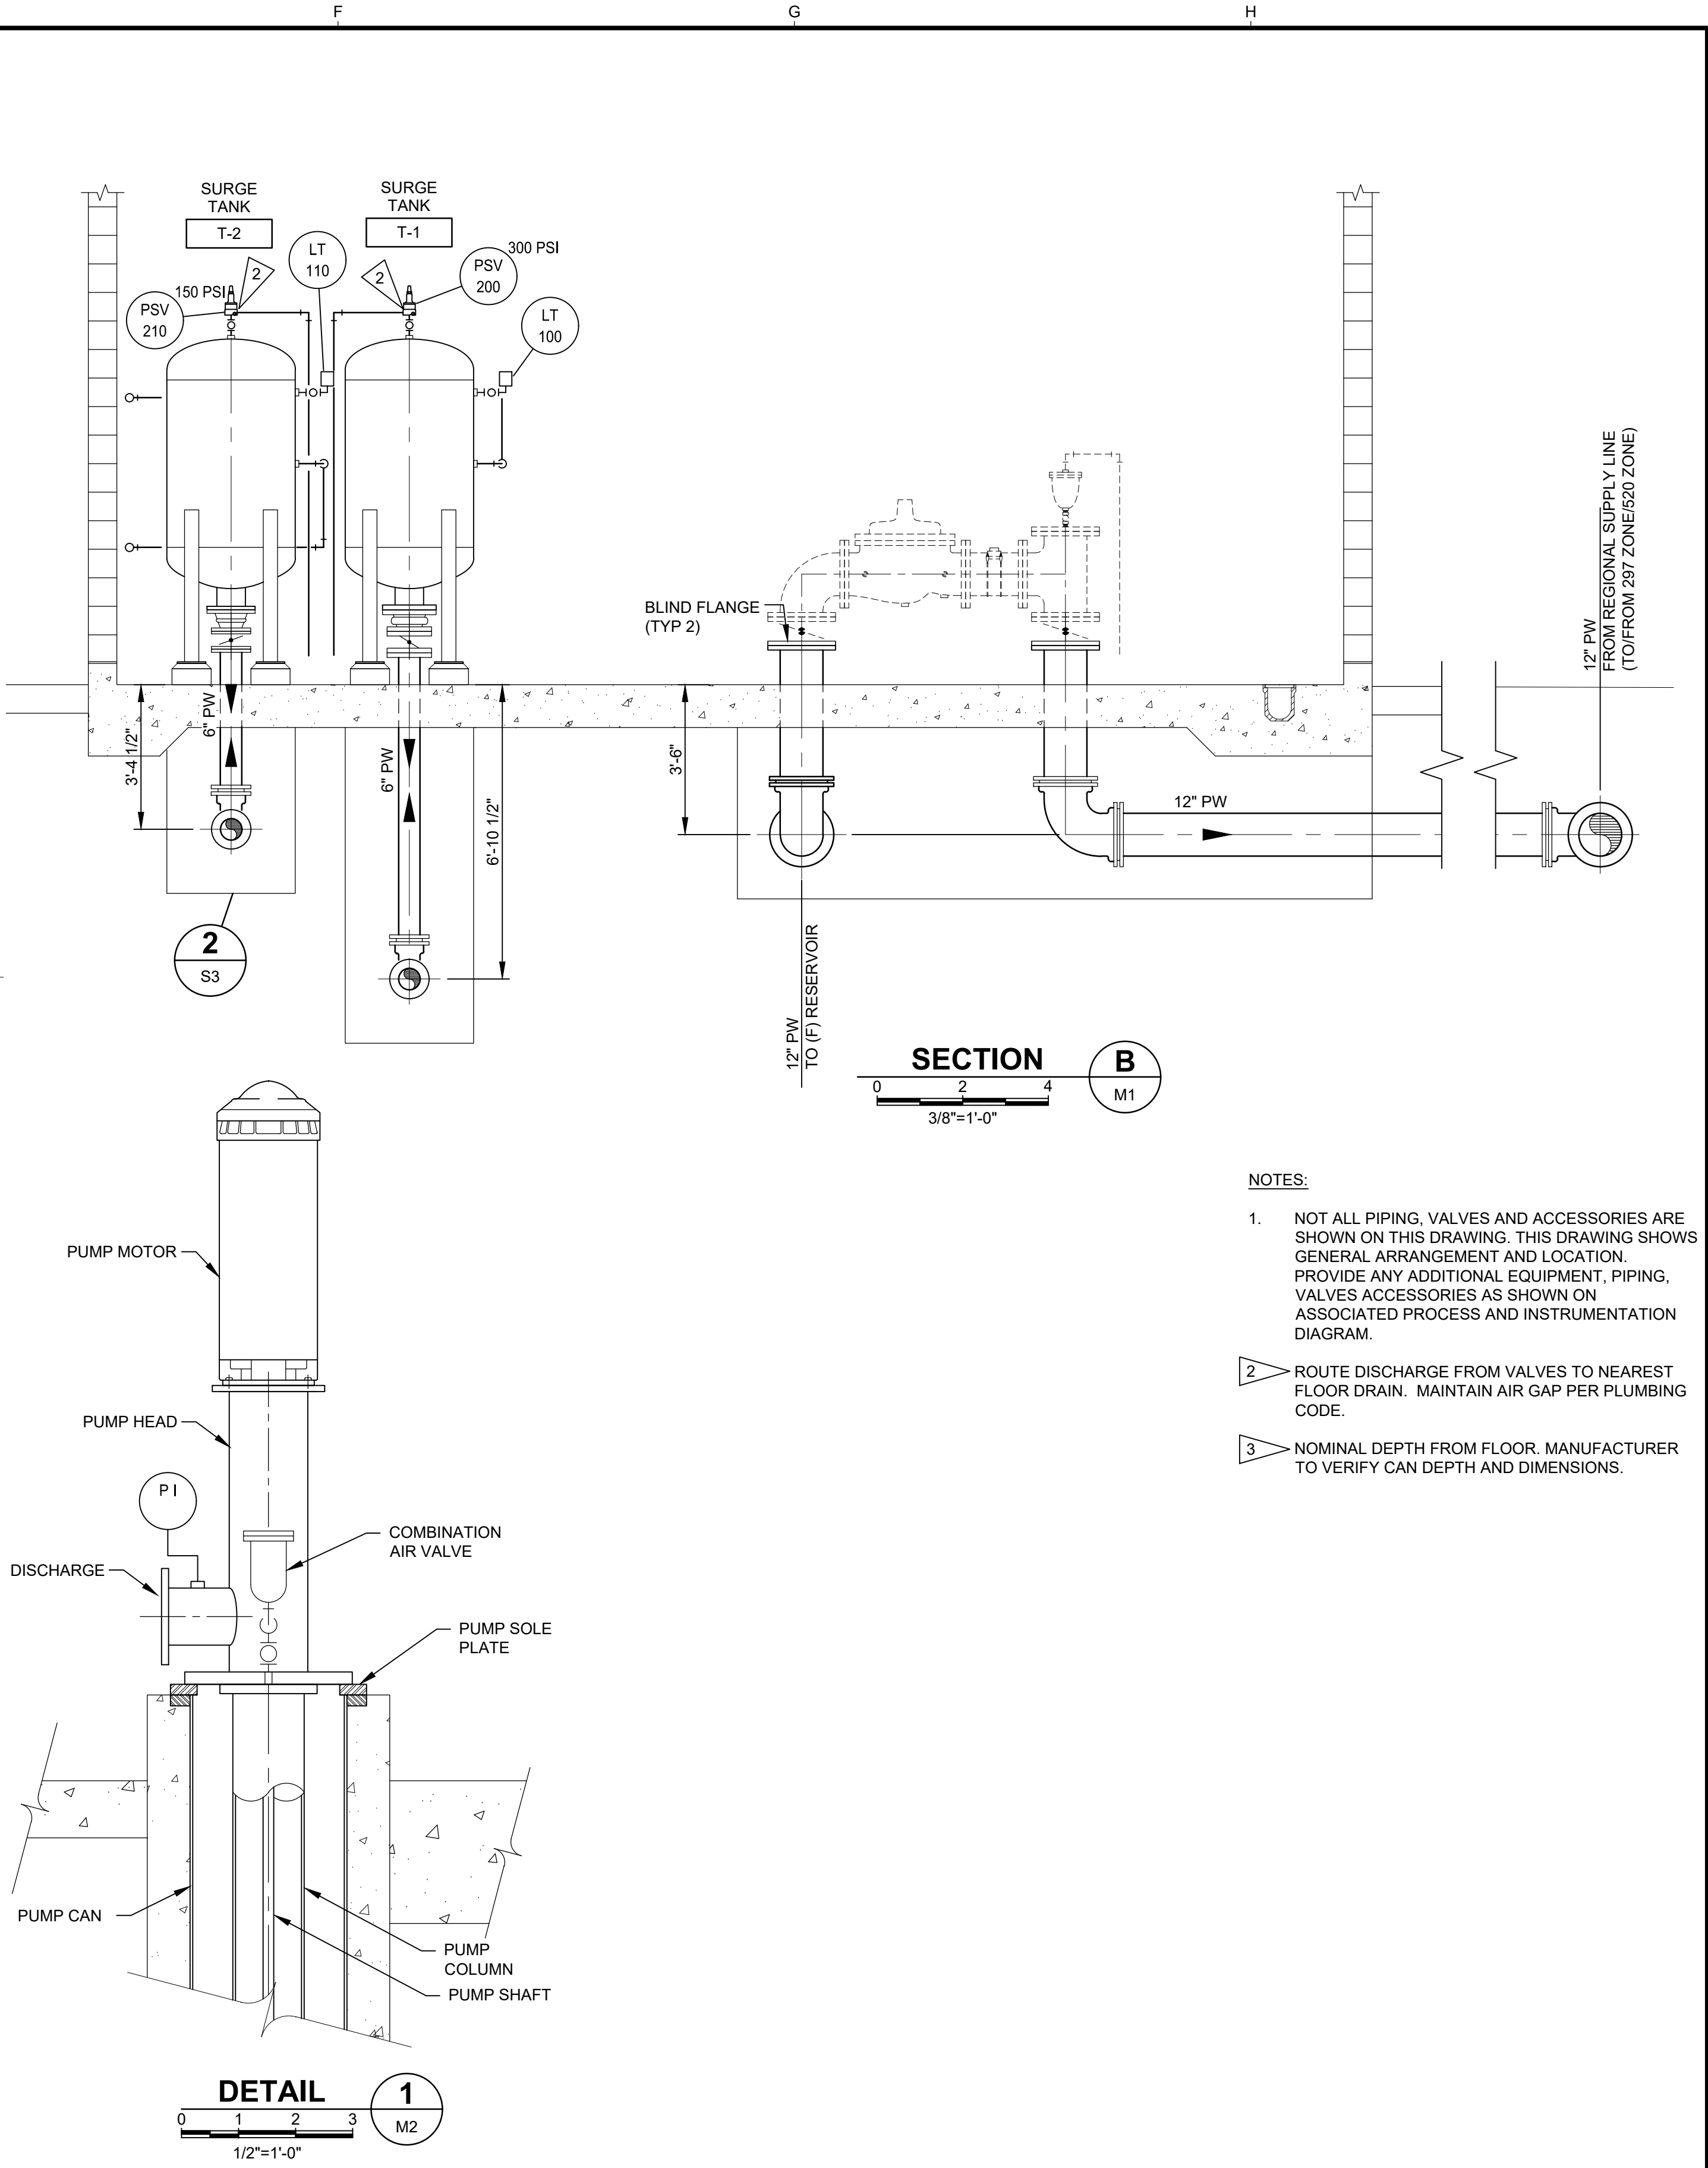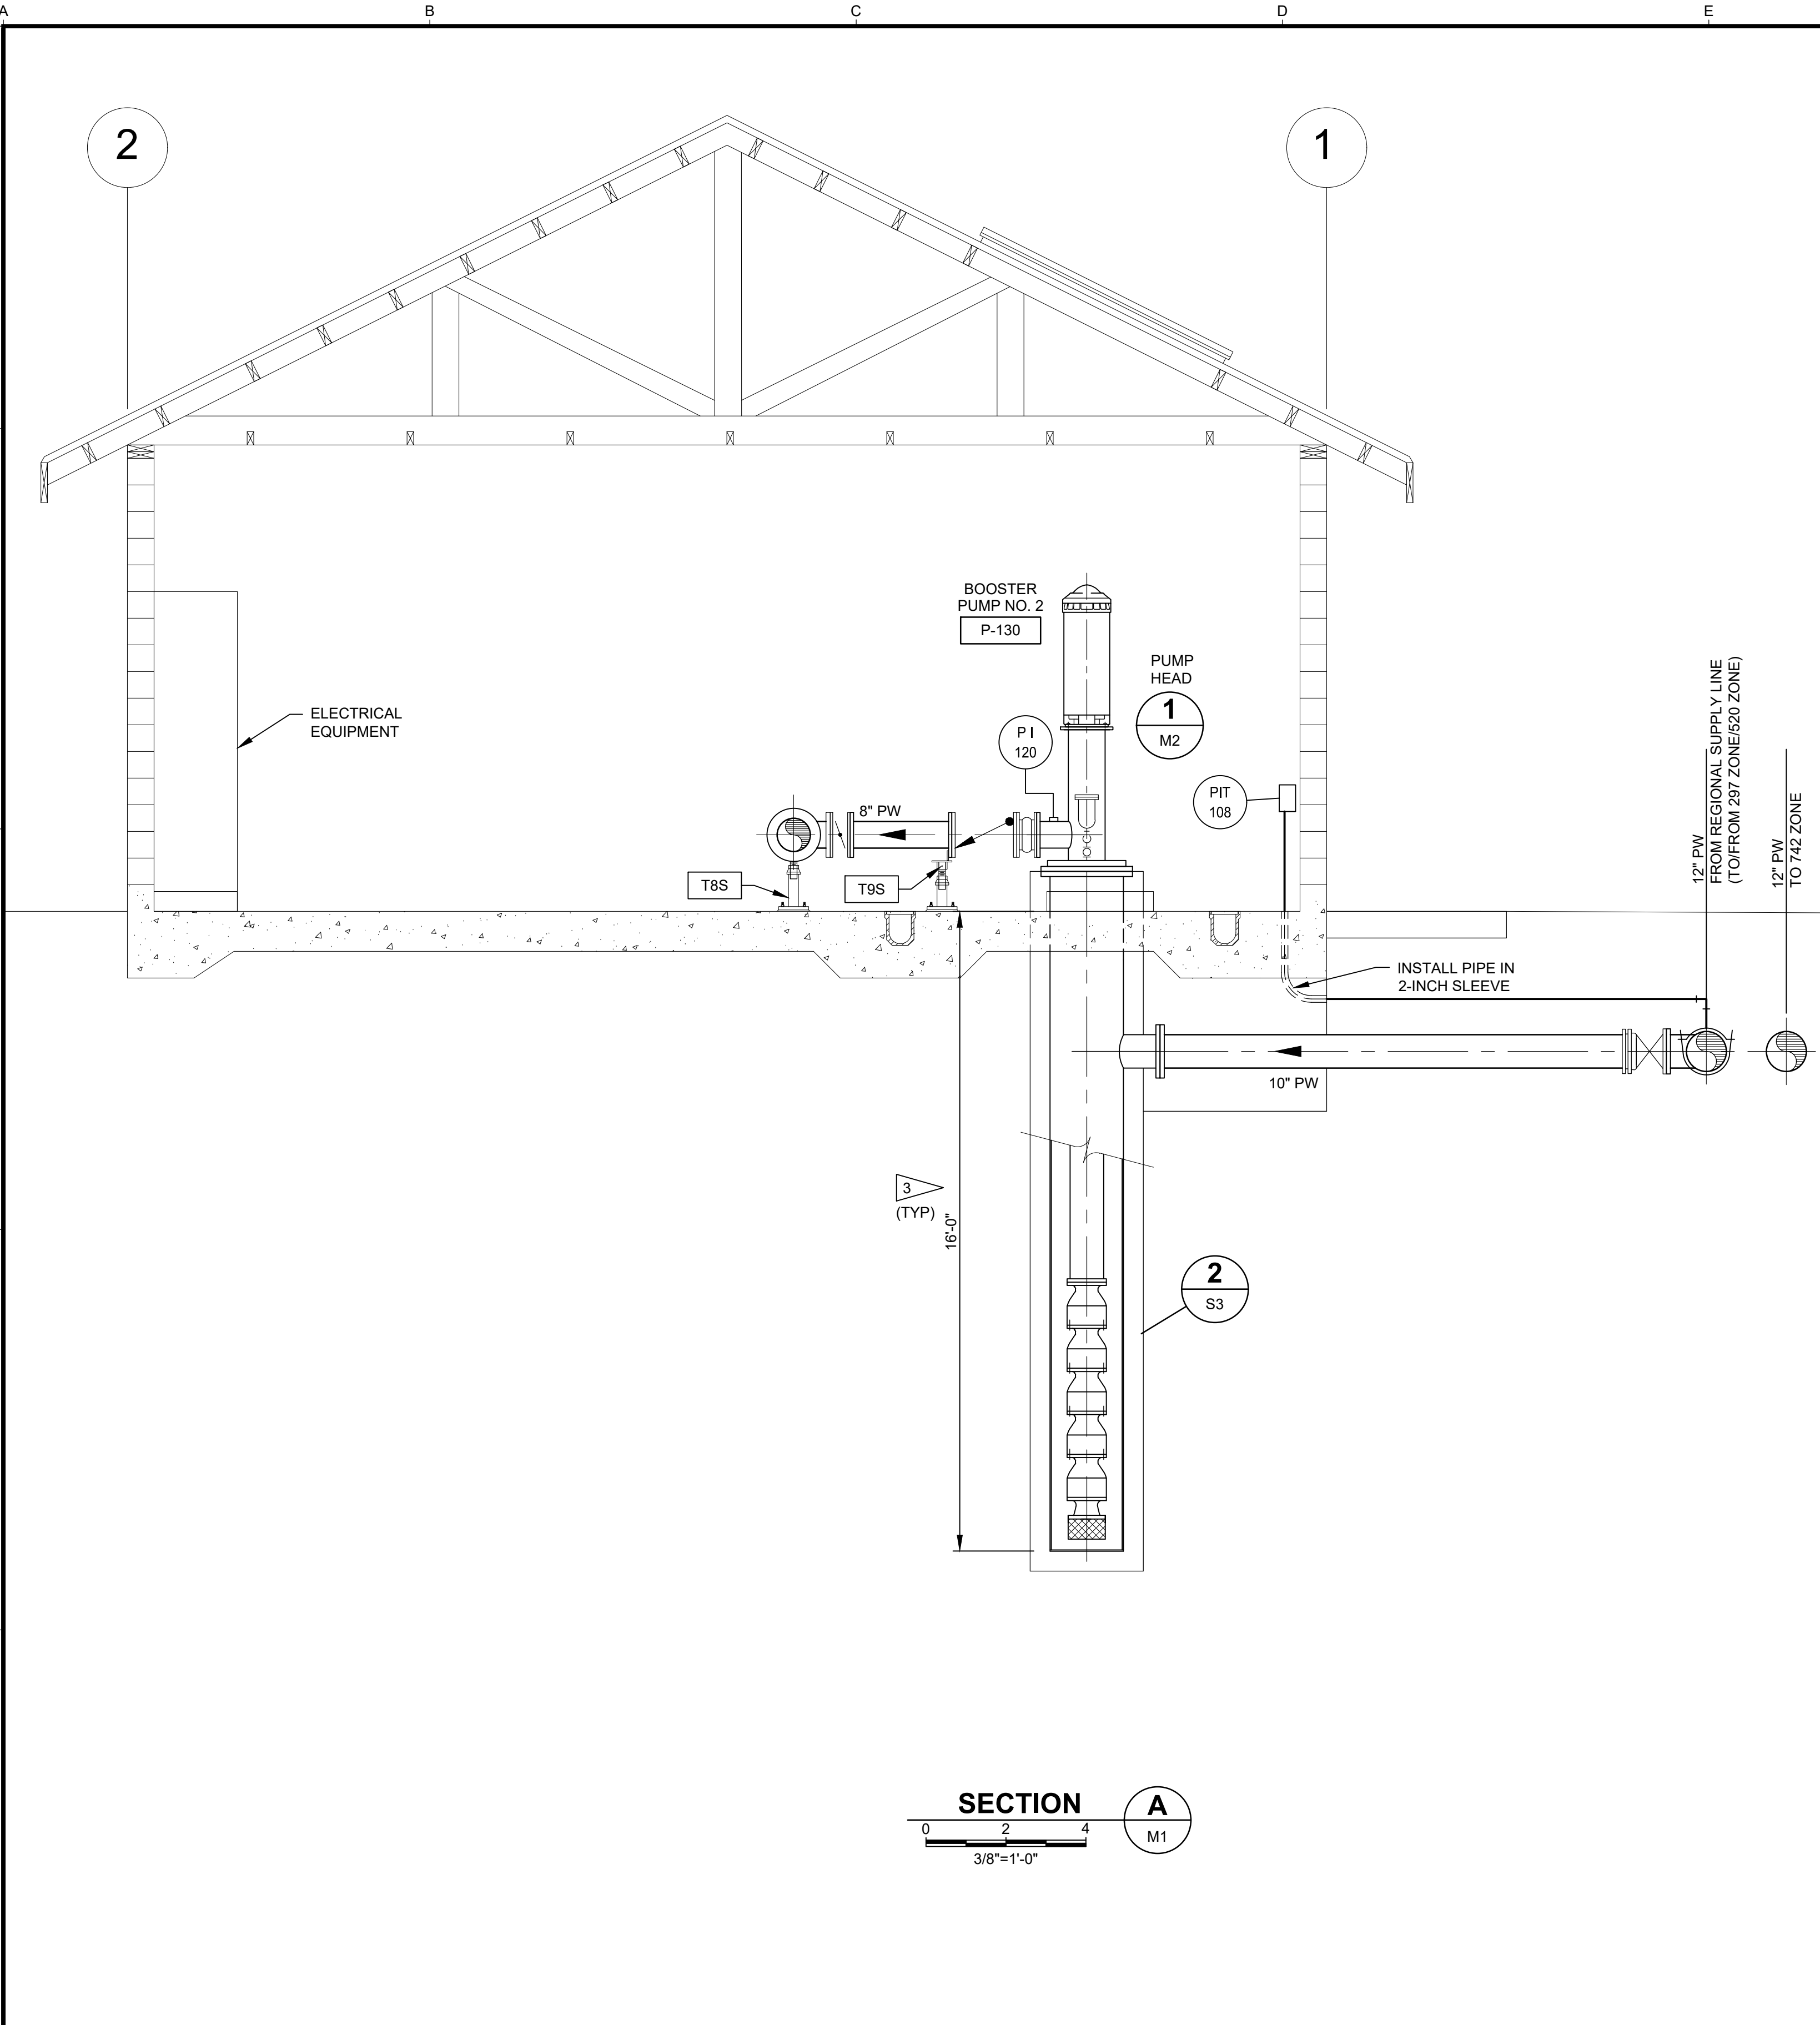

<div>USE OF DOCUMENTS</div> <div>THIS DOCUMENT, INCLUDING THE INCORPORATED DESIGNS, IS AN INSTRUMENT OF SERVICE FOR THIS PROJECT AND SHALL NOT BE USED FOR ANY OTHER PROJECT WITHOUT THE WRITTEN AUTHORIZATION OF KENNEDY/JENKS CONSULTANTS.</div>																																																																																																																																																																																																																																																																																																																																																																																																																																																																																																																																																																																																																																																																																																																																																																																																																																																																																																																																																																																																																																																																																																																																																																																																																																																																																																																																																																																																</
--	--	----

P:\CAD\131\1397005_00_City_of_Issaquah\139700500-M003.dwg
7/1/2020 11:29 AM
MIKENARY



29 AM

FAN SCHEDULE												
TAG NO.	LOCATION	AREA SERVED	TYPE	DRIVE	FAN & MOTOR CHARACTERISTICS						WEIGHT (LBS)	NOTES
					CFM	ESP (IN WC)	RPM	HP	VOLTS/ PHASE	ENCLOSURE		
EF-1	BOOSTER PUMP STATION	BOOSTER PUMP STATION	CENTRIFUGAL SIDEWALL	DIRECT	3,000	0.25	1,200	1	120/1	ODP	88	1,2,3,4,5,6


- NOTES:
- 1) PROVIDE BACK DRAFT DAMPER AND WALL GRILLE.
 - 2) MOTOR TO BE FURNISHED WITH A FACTORY-MOUNTED DISCONNECT SWITCH.
 - 3) MOTOR TO BE VARIABLE SPEED.
 - 4) FAN AND DAMPER SHALL BE PROVIDED WITH CORROSION RESISTANT COATING.
 - 5) INTERLOCK FAN WITH CONTROL DAMPERS ON INTAKE LOUVERS.
 - 6) FAN IS THERMOSTAT CONTROLLED.
 - 7) FAN IS GREENHECK MODEL SE2-24 WITH ACCESSORIES, OR EQUAL.

DEHUMIDIFIER SCHEDULE							
TAG-NO	LOCATION	AREA SERVED	PROCESS AIRFLOW (CFM)	REACTIVATION AIRFLOW (CFM)	REACTIVATION POWER (KW)	MOISTURE REMOVAL (LB/HR)	VOLTS/ PHASE
DH-1	BOOSTER PUMP STATION	BOOSTER PUMP STATION	300	100	6	7.9	480/3


- NOTES:
- 1) INTEGRAL HUMIDISTAT CONTROLLED

LOUVER SCHEDULE							
TAG NO	LOCATION	AREA SERVED	TYPE	DIMENSIONS		AIRFLOW (CFM)	PRESSURE DROP (IN WC)
				H (IN)	W (IN)		
L-1	BOOSTER PUMP STATION	BOOSTER PUMP STATION	SUPPLY	48	24	1500	0.09
L-2	BOOSTER PUMP STATION	BOOSTER PUMP STATION	SUPPLY	88	24	1500	0.09

USE OF DOCUMENTS				
THIS DOCUMENT, INCLUDING THE INCORPORATED DESIGNS, IS AN INSTRUMENT OF SERVICE FOR THIS PROJECT AND SHALL NOT BE USED FOR ANY OTHER PROJECT WITHOUT THE WRITTEN AUTHORIZATION OF KENNEDY/JENKS CONSULTANTS.				
NO.	REVISION			DATE
				BY

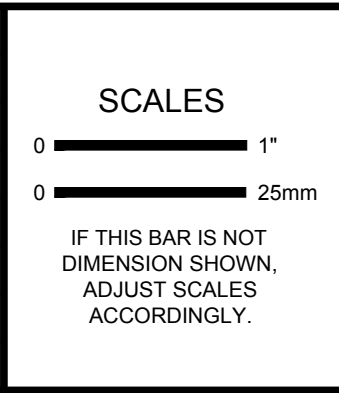

DESIGNED	SGH
DRAWN	LMM
CHECKED	JMF

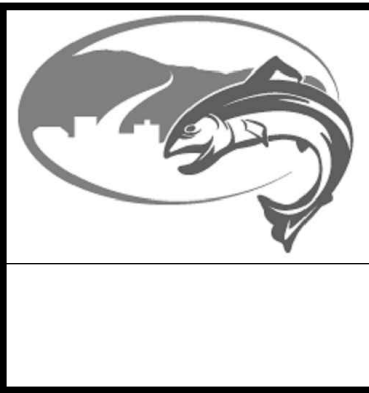


CITY OF ISSAQUAH
ISSAQUAH, WASHINGTON
SOUTH SPAR BOOSTER PUMP STATION

Kennedy/Jenks Consultants
FEDERAL WAY, WASHINGTON


PUMP STATION SECTIONS - 2

90% SUBMITTAL (REVISED 7/1/2020)


FILE NAME
139700500-M003.DWG
JOB NO.
1397005*00
DATE
JUNE 2020
SHEET
71 OF 83
M3

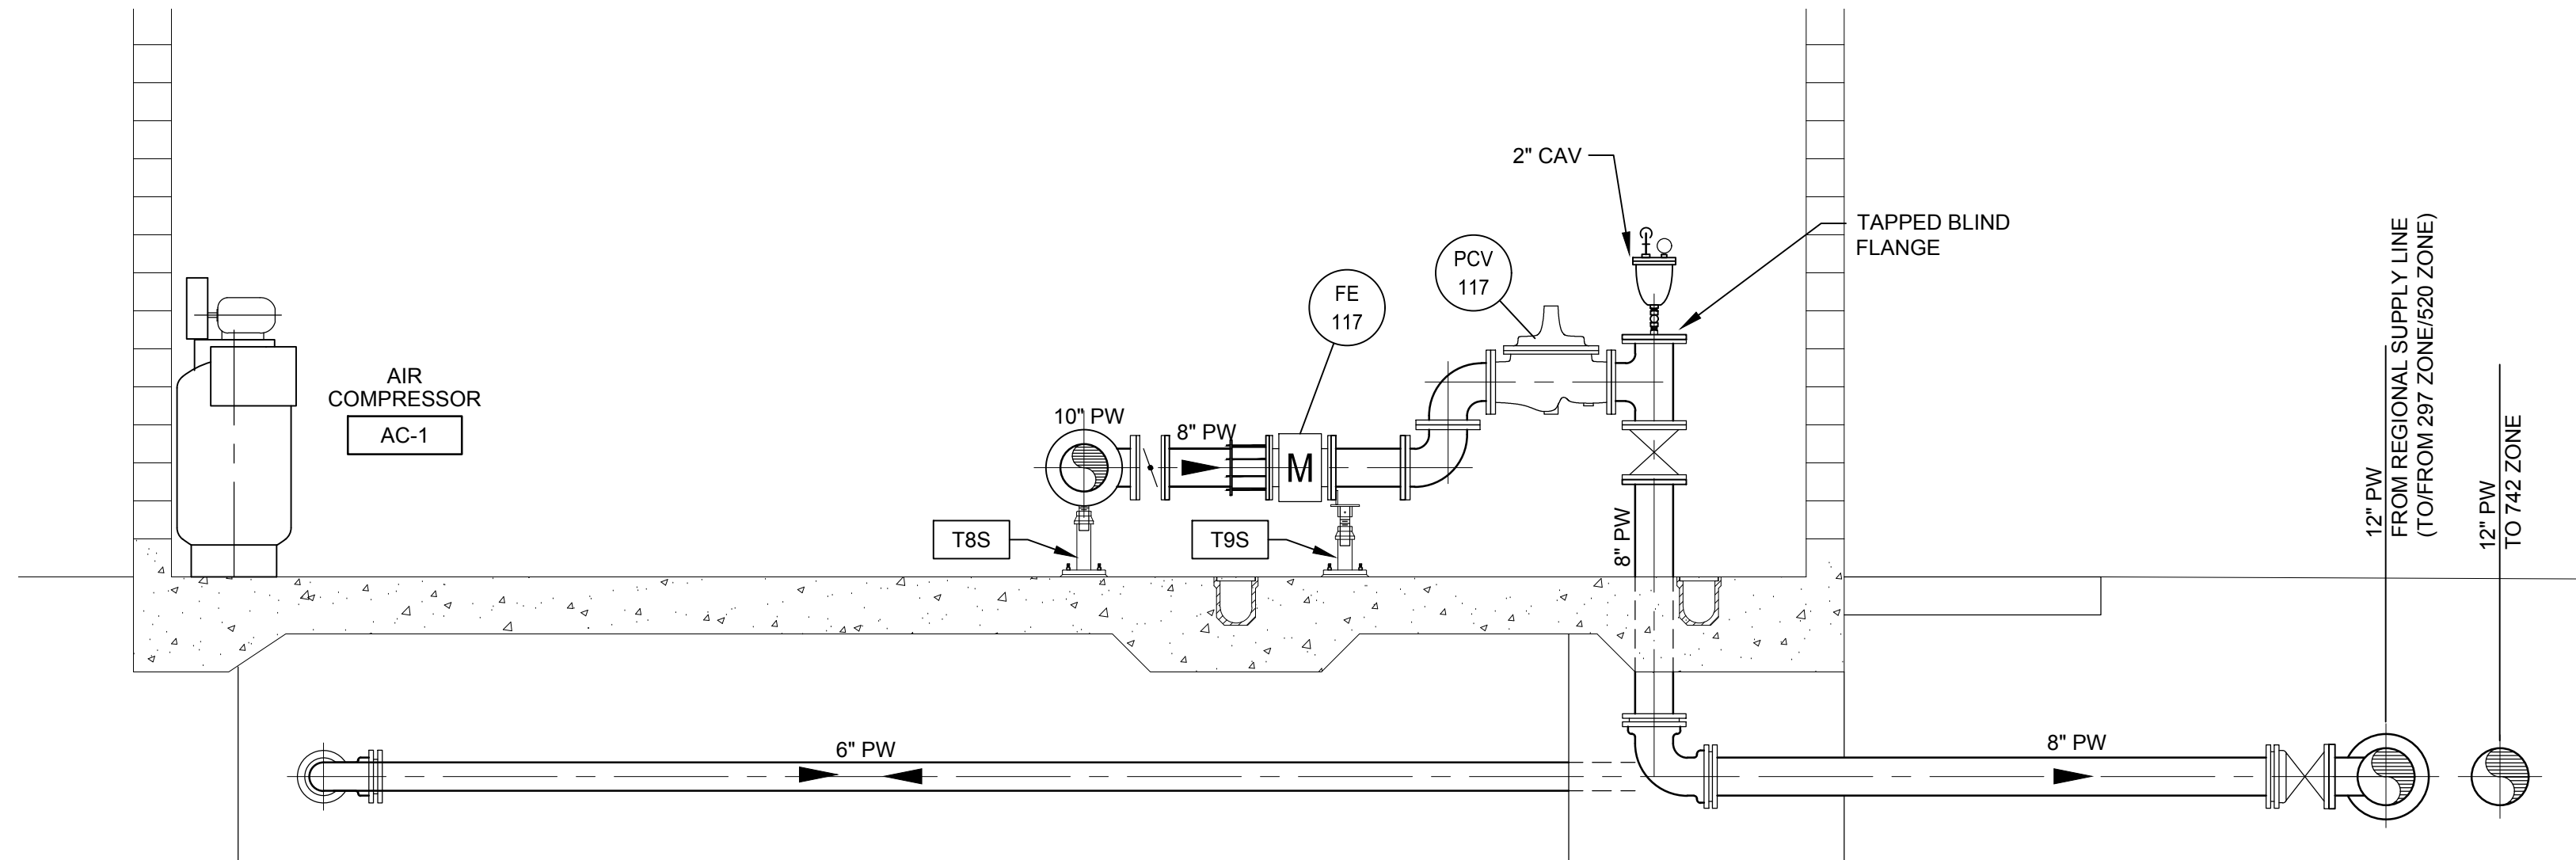

SECTION E
0 2 4
3/8"=1'-0"

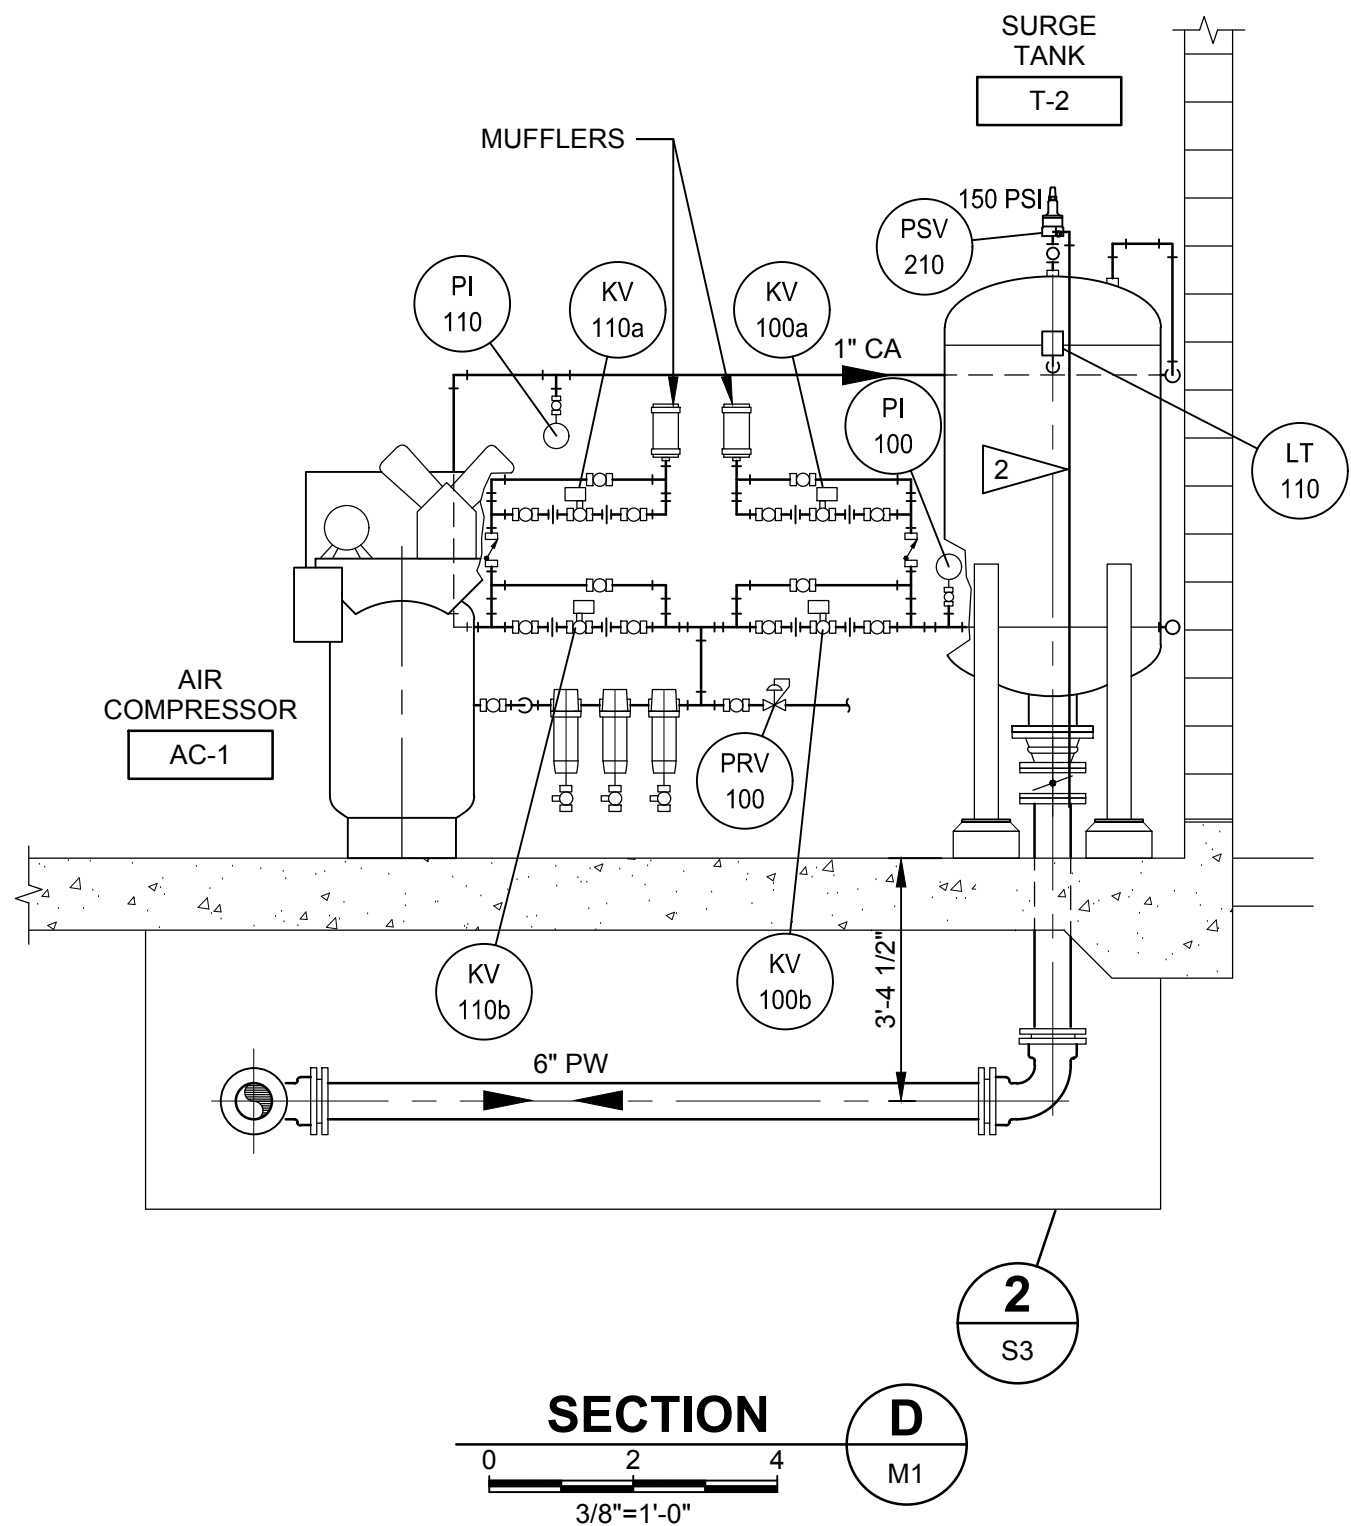


- NOTES:
1. NOT ALL PIPING, VALVES AND ACCESSORIES ARE SHOWN ON THIS DRAWING. THIS DRAWING SHOWS GENERAL ARRANGEMENT AND LOCATION. PROVIDE ANY ADDITIONAL EQUIPMENT, PIPING, VALVES ACCESSORIES AS SHOWN ON ASSOCIATED PROCESS AND INSTRUMENTATION DIAGRAM.
 2. ROUTE DISCHARGE FROM VALVES TO NEAREST FLOOR DRAIN. MAINTAIN AIR GAP PER PLUMBING CODE.
 3. NOMINAL DEPTH FROM FLOOR. MANUFACTURER TO VERIFY CAN DEPTH AND DIMENSIONS.

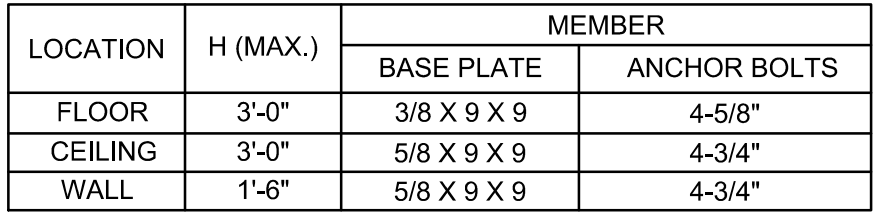

1. AS AN ALTERNATE, IF ADJUSTMENT IS NOT NECESSARY, DELETE PIPE AND REDUCER AND WELD 3" STEEL PIPE DIRECTLY TO BOTTOM PIPE STRAP.
2. DO NOT CUT OR WELD AFTER GALVANIZING.
3. PIPE SUPPORT MAY BE ORIENTATED IN ANY DIRECTION.

SCALE: NONE (SEISMIC RESTRAINT)

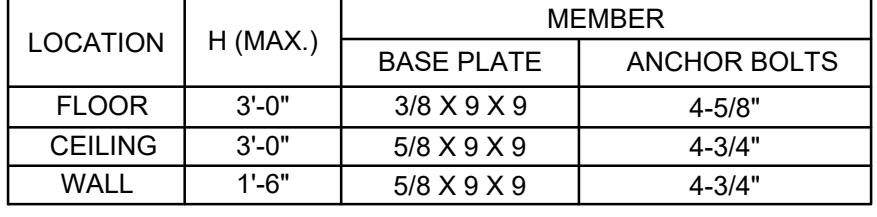

1. AS AN ALTERNATE, IF ADJUSTMENT IS NOT NECESSARY, DELETE 2 1/2" PIPE AND REDUCER AND WELD 3" STEEL PIPE DIRECTLY TO 3/8" PLATE ATTACHED TO PIPE FLANGE.
2. DO NOT CUT OR WELD AFTER GALVANIZING.
3. PIPE SUPPORT MAY BE ORIENTATED IN ANY DIRECTION.

SCALE: NONE (SEISMIC RESTRAINT)

THIS DOCUMENT, INCLUDING THE INCORPORATED
DESIGNS, IS AN INSTRUMENT OF SERVICE FOR THIS
PROJECT AND SHALL NOT BE USED FOR ANY OTHER
PROJECT WITHOUT THE WRITTEN AUTHORIZATION
OF KENNEDY/JENKS CONSULTANTS.

NO.	REVISION	DATE	BY
-----	----------	------	----

IF THIS BAR IS NOT
DIMENSION SHOWN,
ADJUST SCALES
ACCORDINGLY.



JMF



Kennedy/Jenks Consultants
FEDERAL WAY, WASHINGTON

90% SUBMITTAL (REVISED 7/1/2020)


FILE NAME	139700500-M004.DWG
JOB NO.	1397005*00
DATE	JUNE 2020
SHEET	72 OF 8
M4	




THIS DOCUMENT, INCLUDING THE INCORPORATED
DESIGNS, IS AN INSTRUMENT OF SERVICE FOR THIS
PROJECT AND SHALL NOT BE USED FOR ANY OTHER
PROJECT WITHOUT THE WRITTEN AUTHORIZATION
OF KENNEDY/JENKS CONSULTANTS.


NO.	REVISION	DATE	BY

SCALES

0  1"

0  25mm

IF THIS BAR IS NOT
DIMENSION SHOWN,
ADJUST SCALES
ACCORDINGLY.

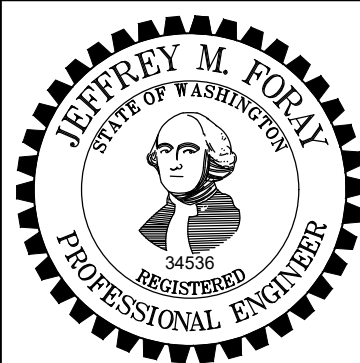

DESIGNED

DRAWN

CHECKED
JMF



CITY OF ISSAQUAH
ISSAQUAH, WASHINGTON
SOUTH SPAR BOOSTER PUMP STATION

Kennedy/Jenks Consultants
FEDERAL WAY, WASHINGTON


STANDARD MECHANICAL DETAILS - 2

90% SUBMITTAL (REVISED 7/1/2020)

FILE NAME	139700500-M005.DWG
JOB NO.	1397005*00
DATE	JUNE 2020
SHEET	73 OF 83


M5

[illegible]

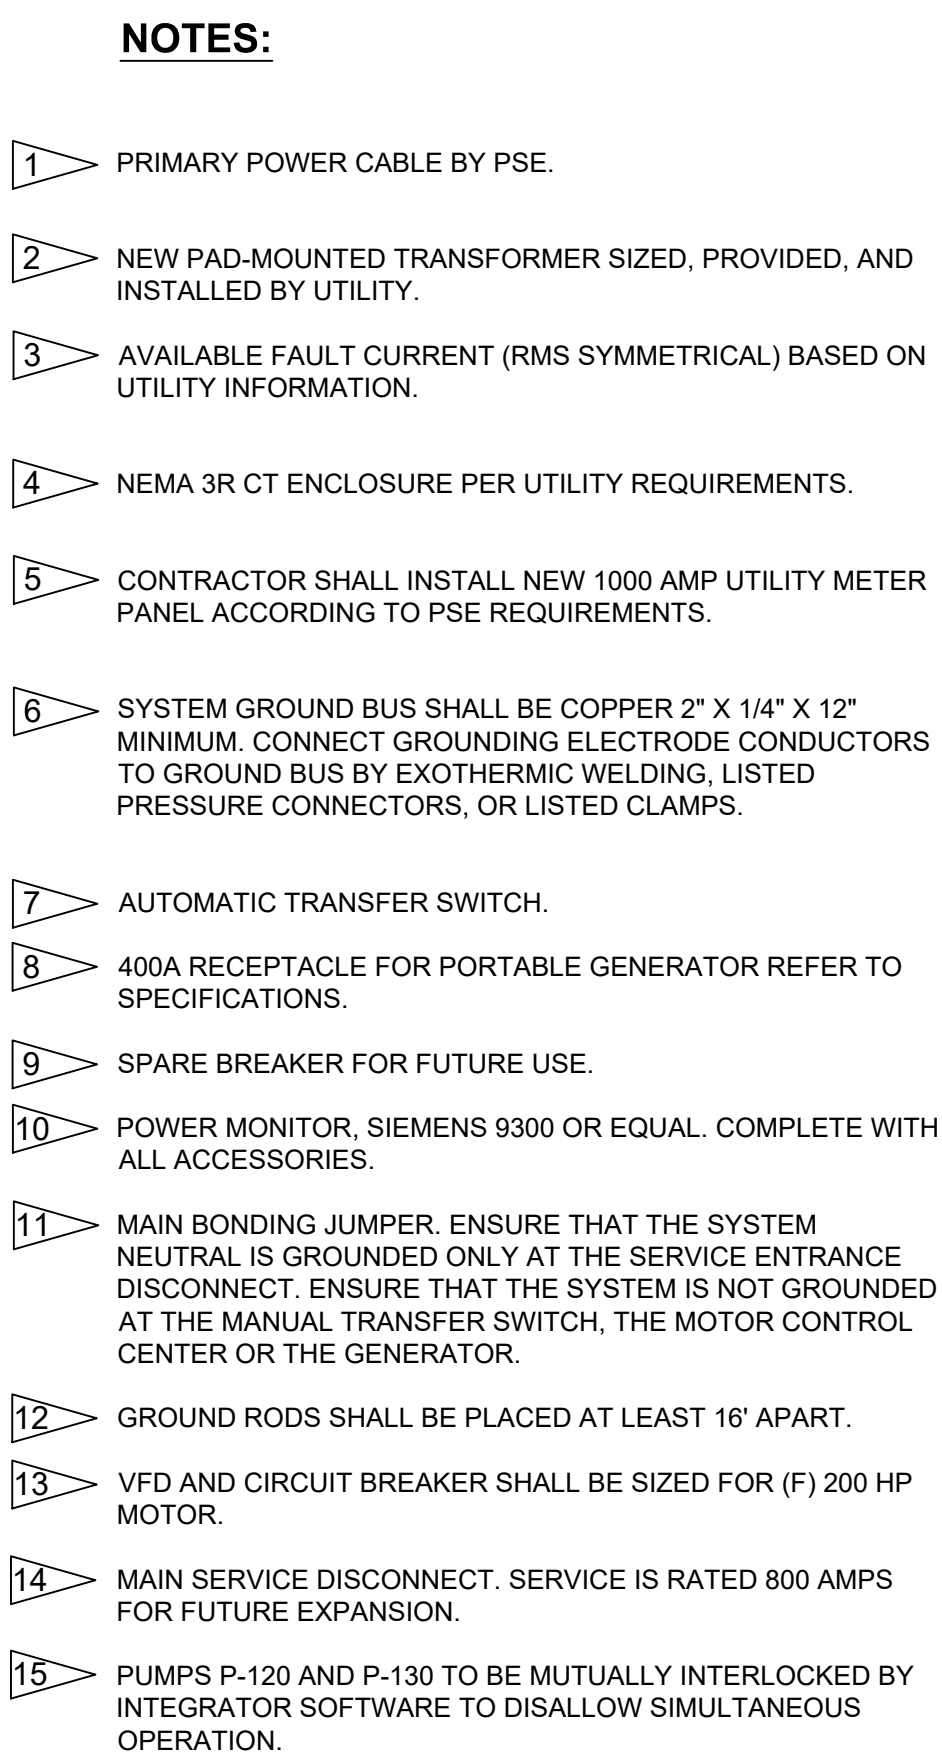


15
15

P:\CAD\13\1397005_00_City_of_Issaquah\139700500-E003.dwg
MIKEMARX
6/29/2020 8:07 AM

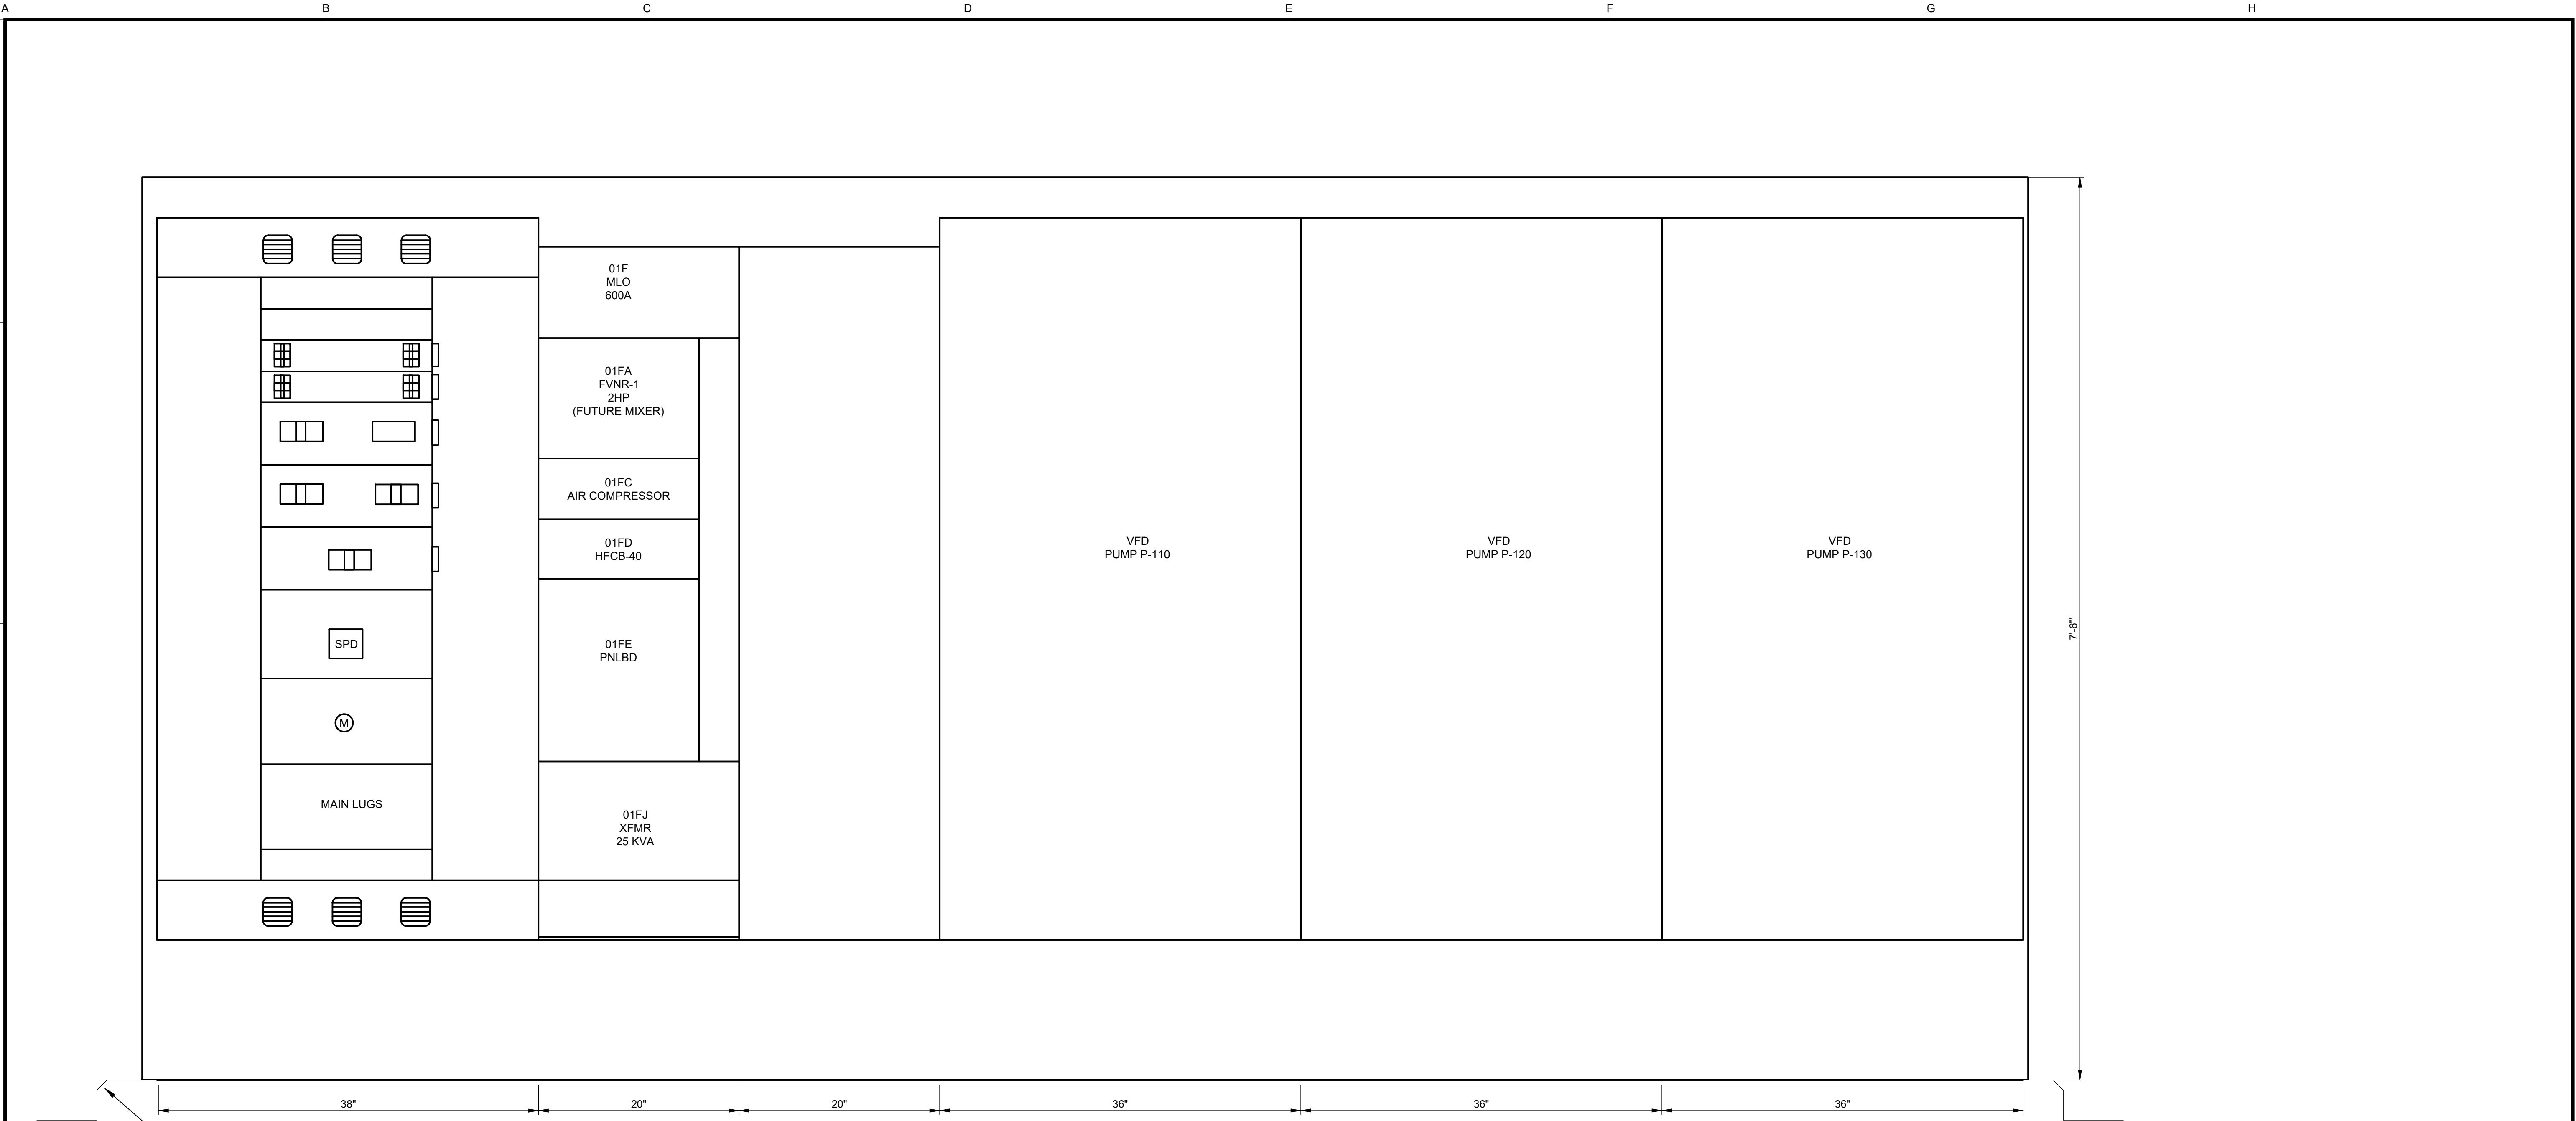


MCC-1 ELEVATION

SCALE: 1½" = 1'-0"

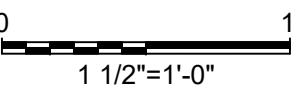

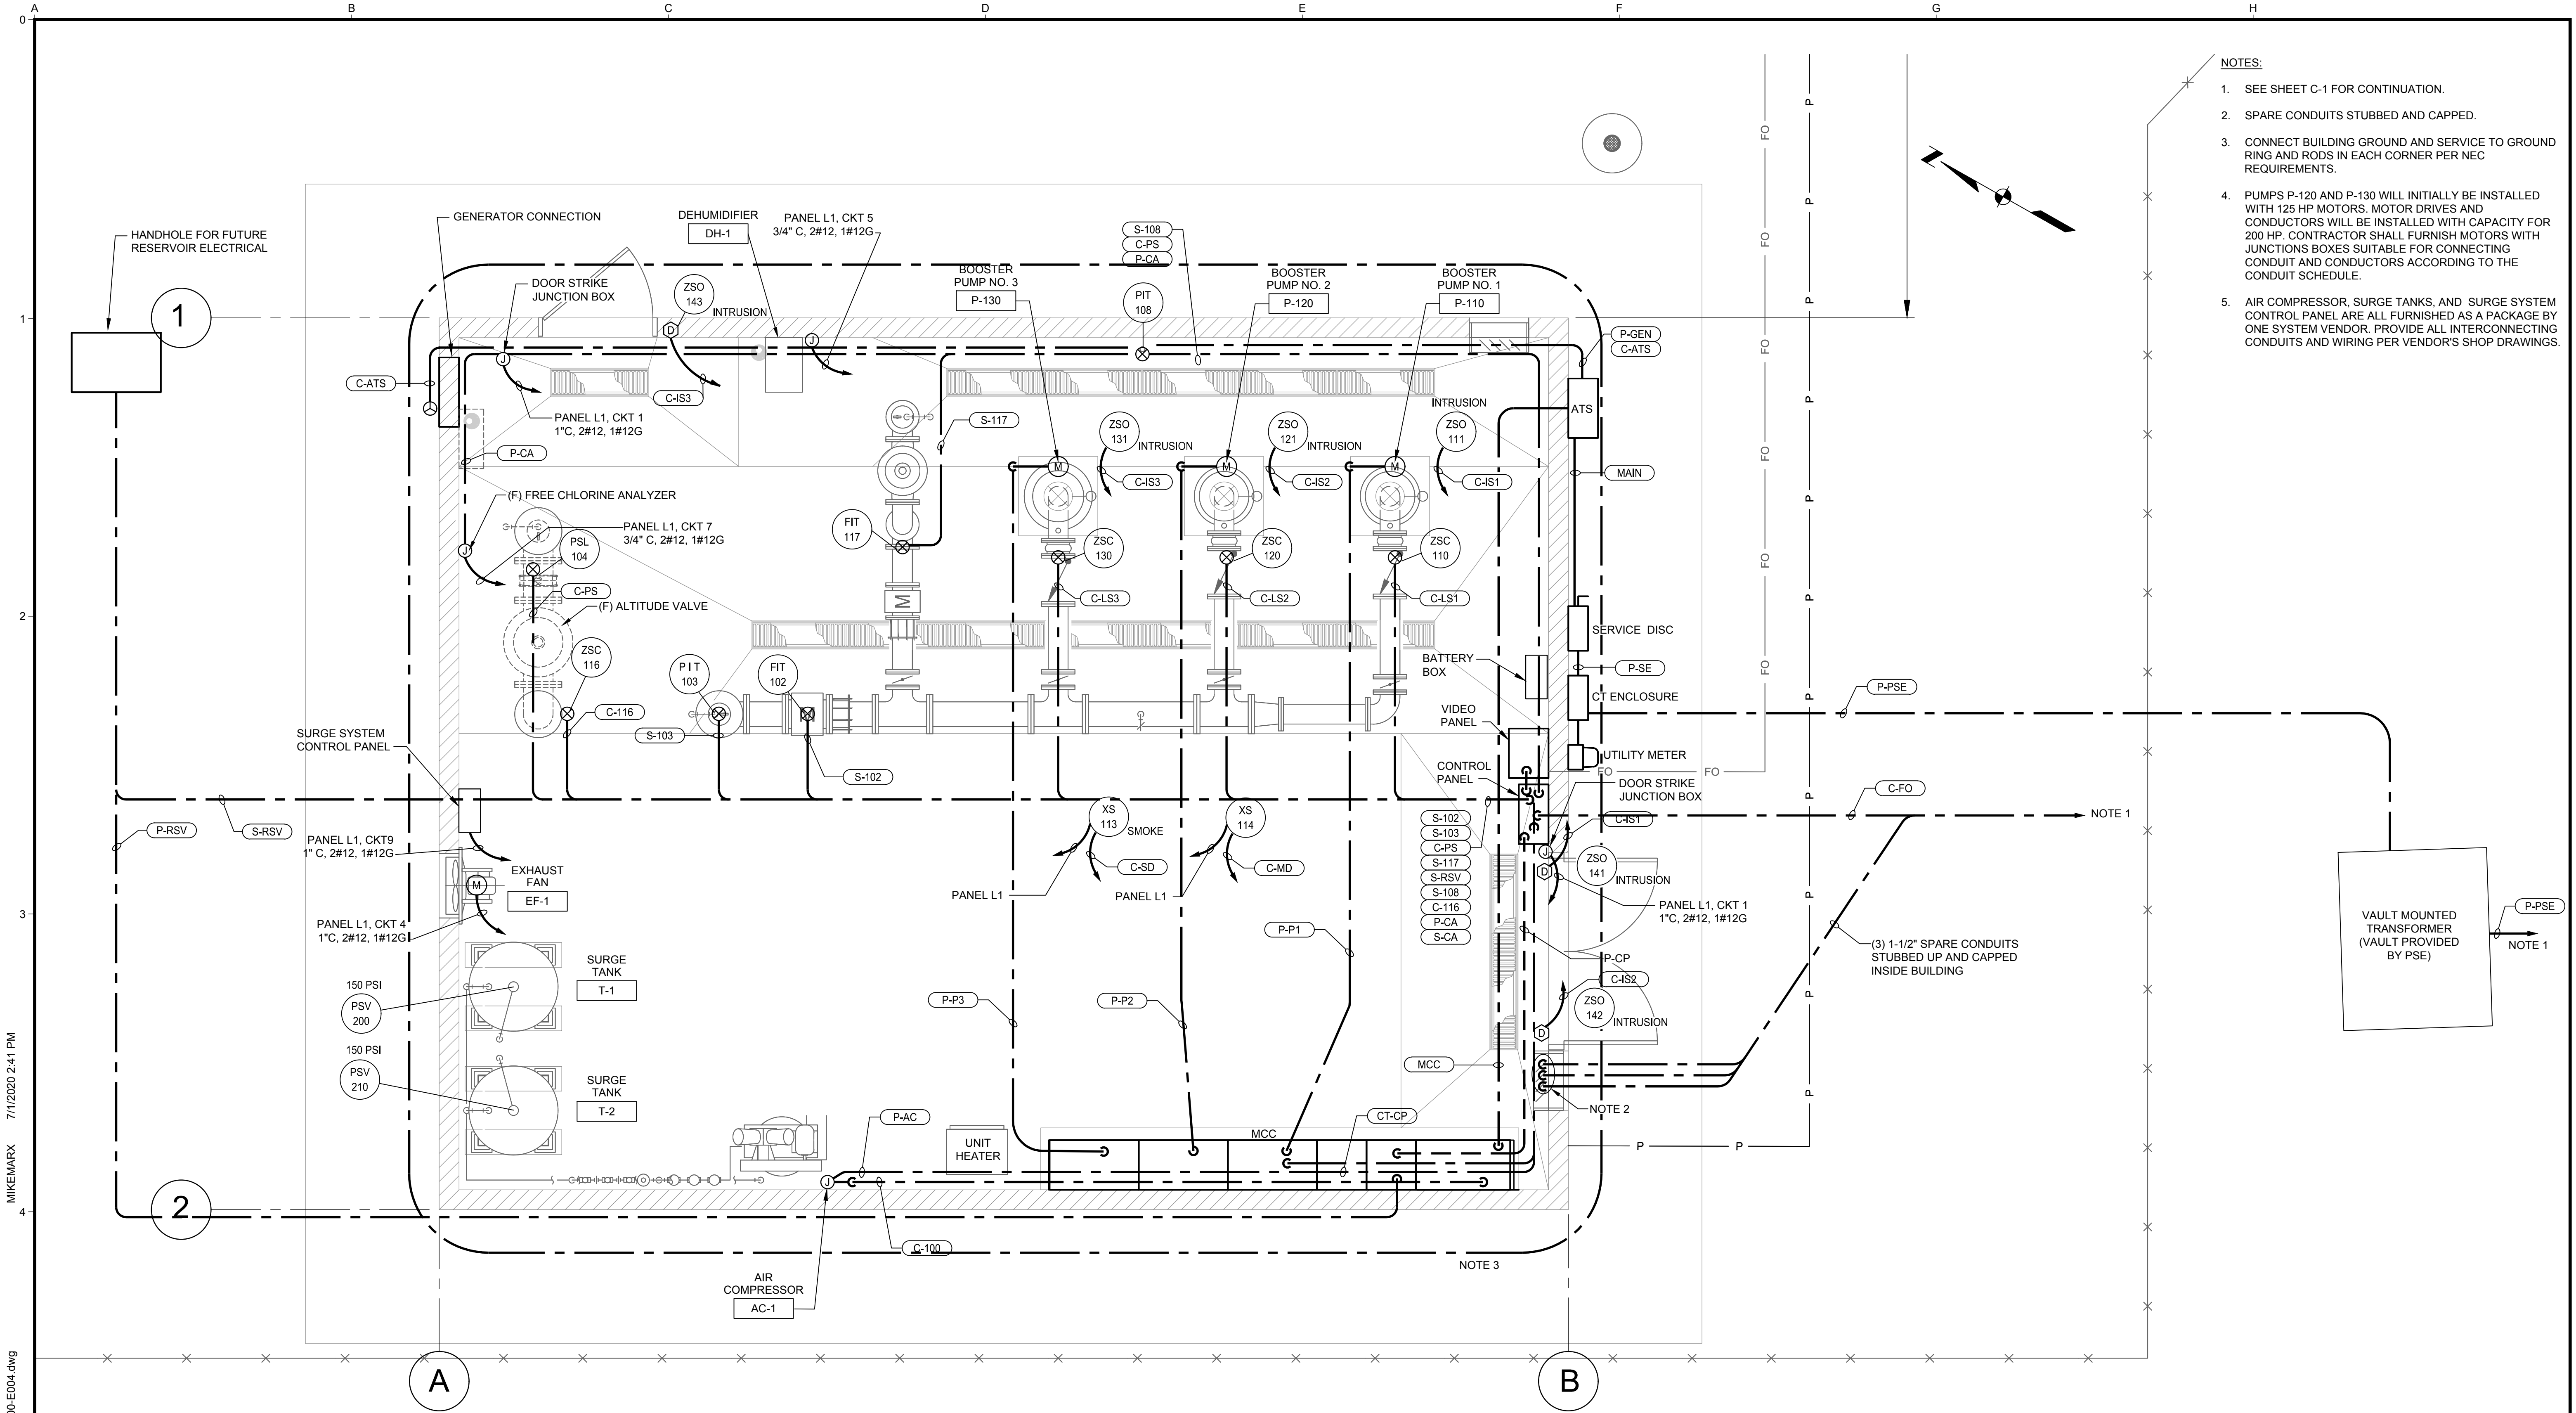


USE OF DOCUMENTS <small>THIS DOCUMENT, INCLUDING THE INCORPORATED DESIGNS, IS AN INSTRUMENT OF SERVICE FOR THIS PROJECT AND SHALL NOT BE USED FOR ANY OTHER PROJECT WITHOUT THE WRITTEN AUTHORIZATION OF KENNEDY/JENKS CONSULTANTS.</small>					SCALES 0 1" 0 25mm <small>IF THIS BAR IS NOT DIMENSION SHOWN, ADJUST SCALES ACCORDINGLY.</small>		DESIGNED		CITY OF ISSAQUAH ISSAQUAH, WASHINGTON SOUTH SPAR BOOSTER PUMP STATION Kennedy/Jenks Consultants FEDERAL WAY, WASHINGTON	MCC-1 ELEVATION 90% SUBMITTAL (REVISED 7/1/2020)	FILE NAME
							139700500-E003.DWG				
							JOB NO.				
							1397005*00				
							DATE				
										JUNE 2020	SHEET
										76 OF 83	E3
NO.	REVISION	DATE	BY								



- NOTES:
1. SEE SHEET C-1 FOR CONTINUATION.
 2. SPARE CONDUITS STUBBED AND CAPPED.
 3. CONNECT BUILDING GROUND AND SERVICE TO GROUND RING AND RODS IN EACH CORNER PER NEC REQUIREMENTS.
 4. PUMPS P-120 AND P-130 WILL INITIALLY BE INSTALLED WITH 125 HP MOTORS. MOTOR DRIVES AND CONDUCTORS WILL BE INSTALLED WITH CAPACITY FOR 200 HP. CONTRACTOR SHALL FURNISH MOTORS WITH JUNCTIONS BOXES SUITABLE FOR CONNECTING CONDUIT AND CONDUCTORS ACCORDING TO THE CONDUIT SCHEDULE.
 5. AIR COMPRESSOR, SURGE TANKS, AND SURGE SYSTEM CONTROL PANEL ARE ALL FURNISHED AS A PACKAGE BY ONE SYSTEM VENDOR. PROVIDE ALL INTERCONNECTING CONDUITS AND WIRING PER VENDOR'S SHOP DRAWINGS.

PLAN
0 2 4
3/8"=1'-0"

<p>USE OF DOCUMENTS</p> <p>THIS DOCUMENT, INCLUDING THE INCORPORATED DESIGNS, IS AN INSTRUMENT OF SERVICE FOR THIS PROJECT AND SHALL NOT BE USED FOR ANY OTHER PROJECT WITHOUT THE WRITTEN AUTHORIZATION OF KENNEDY/JENKS CONSULTANTS.</p>					<p>SCALES</p> <p>0 1" 0 25mm</p> <p>IF THIS BAR IS NOT DIMENSION SHOWN, ADJUST SCALES ACCORDINGLY.</p>		DESIGNED		<p>CITY OF ISSAQUAH</p> <p>ISSAQUAH, WASHINGTON</p> <p>SOUTH SPAR BOOSTER PUMP STATION</p>	<p>Kennedy/Jenks Consultants</p> <p>FEDERAL WAY, WASHINGTON</p>	<p>PUMP STATION POWER AND SIGNAL PLAN</p>	FILE NAME	139700500-E004.DWG
	DRAWN	RFB/JL	JOB NO.	1397005*00									
	CHECKED	LGR	DATE	JUNE 2020									
	<p>90% SUBMITTAL (REVISED 7/1/2020)</p>		SHEET	77 OF 83									
			<p>E4</p>										

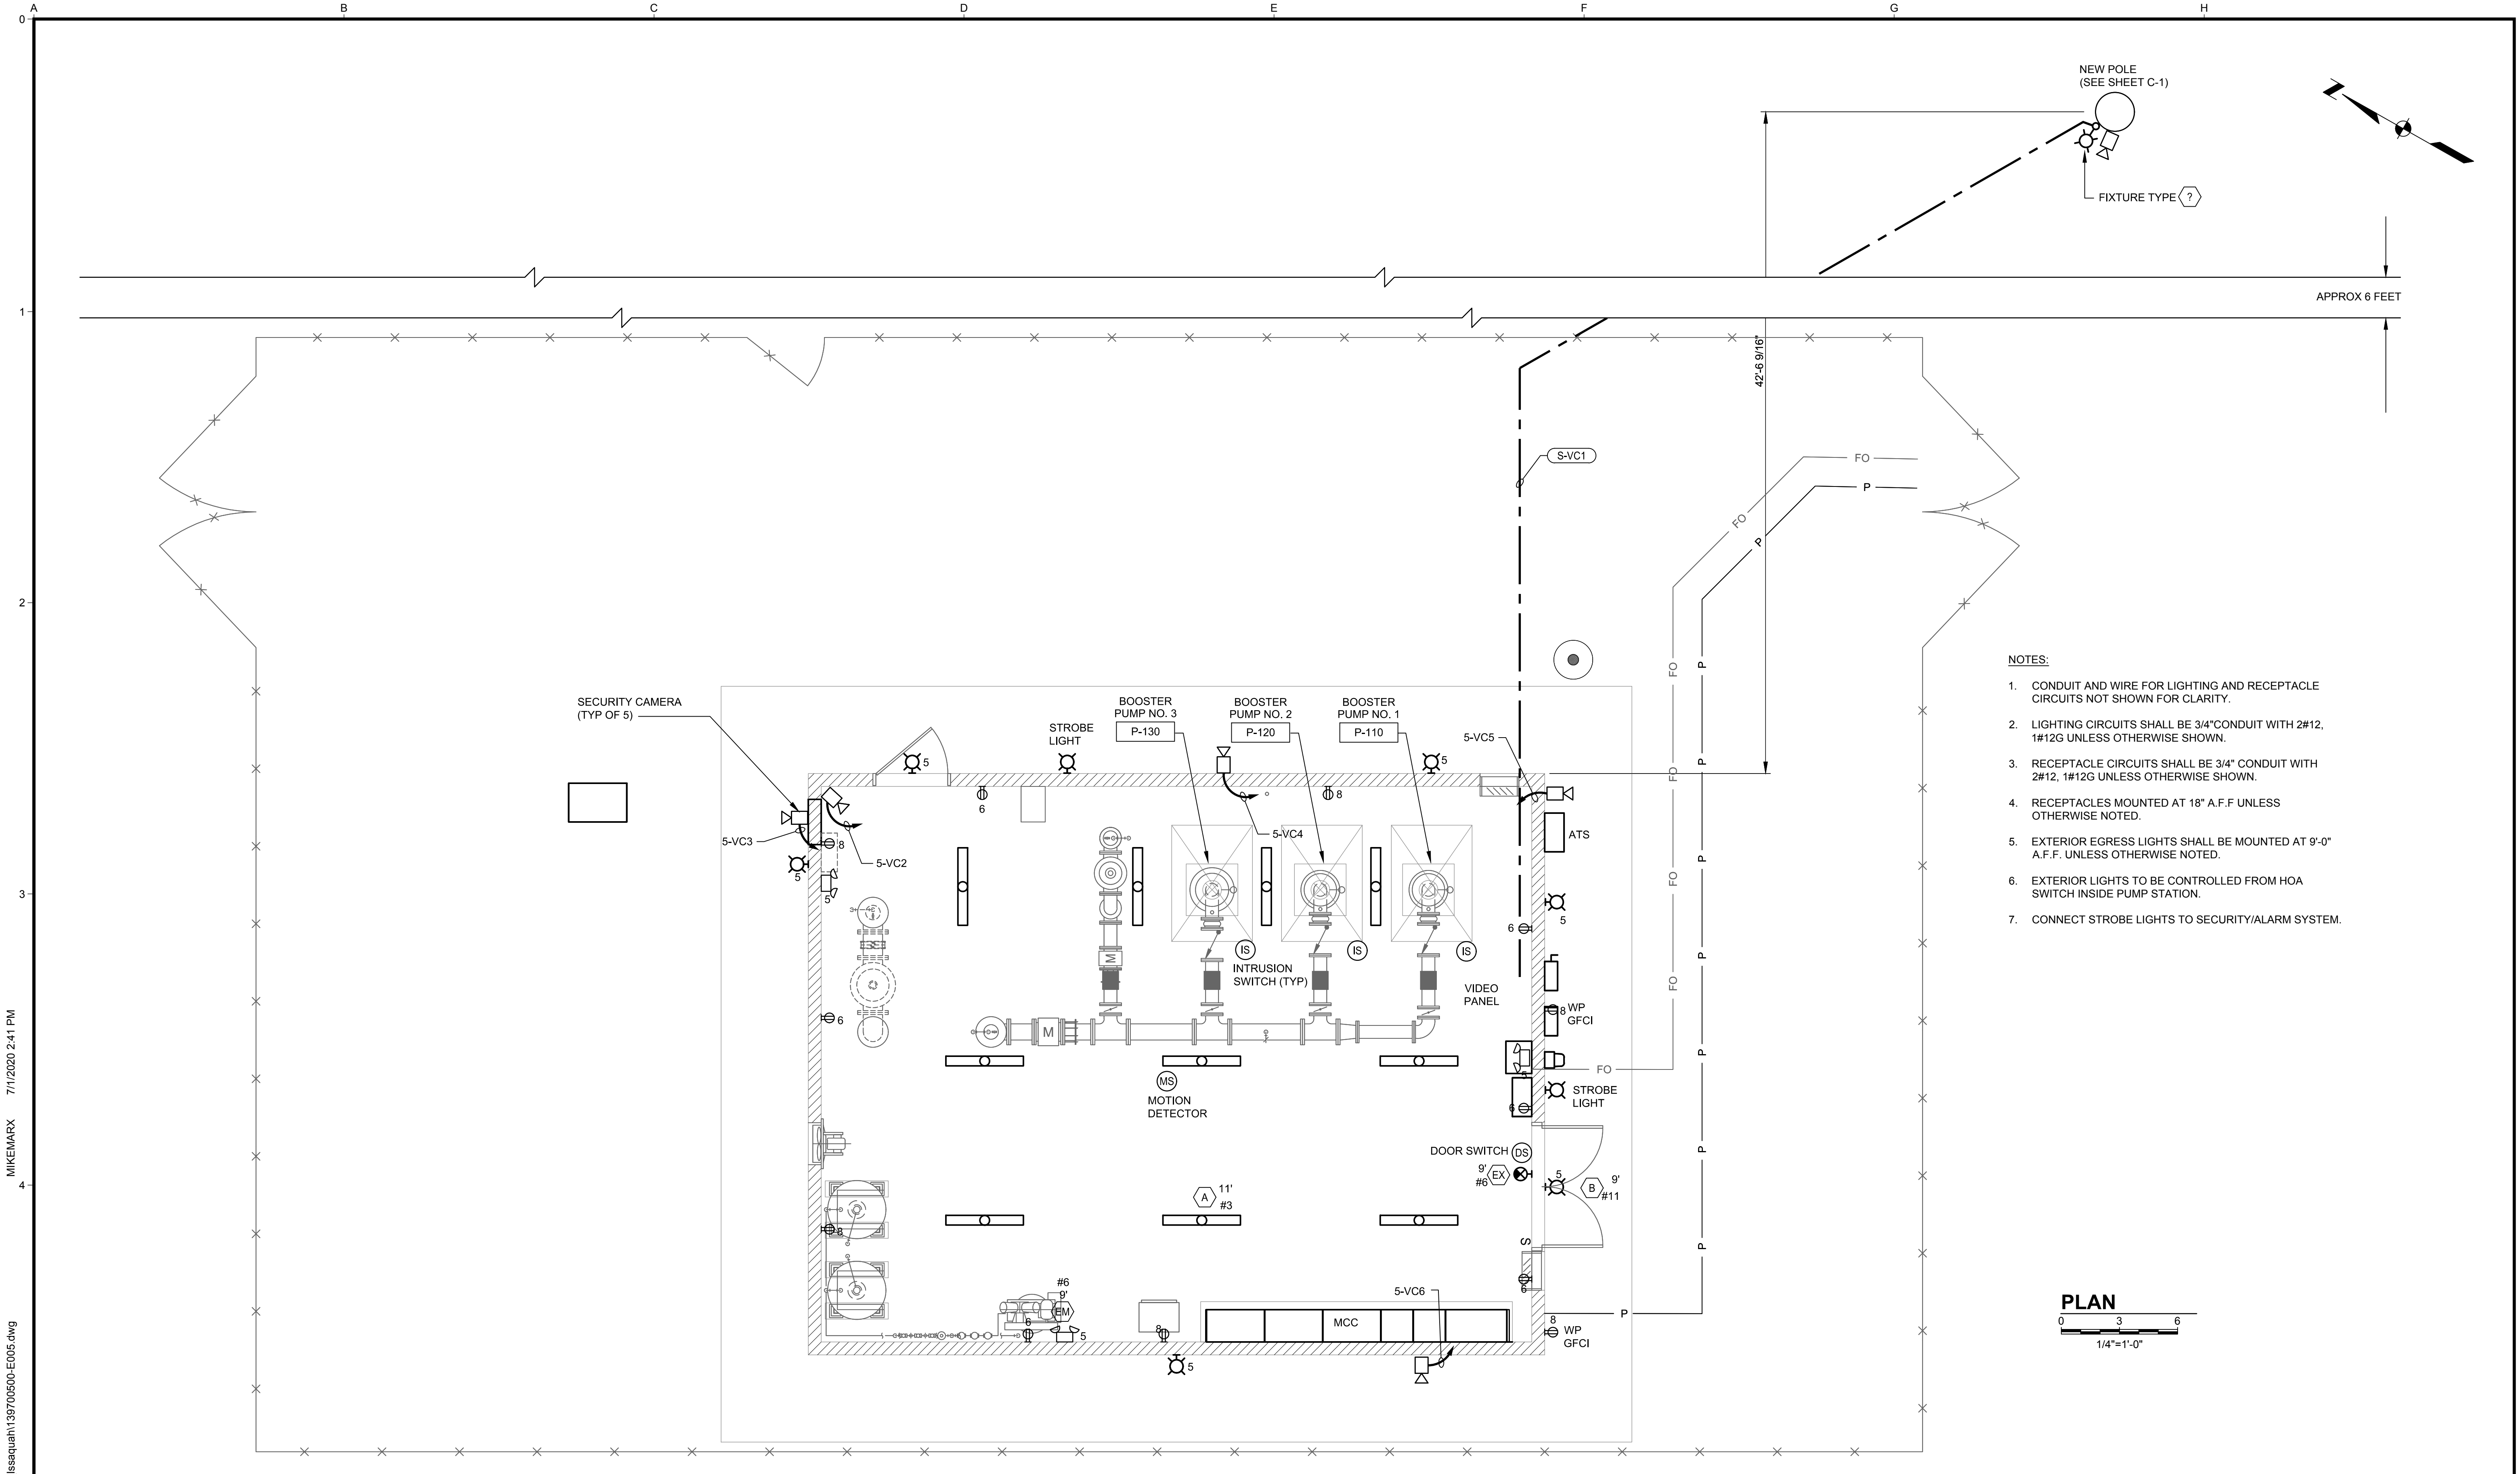

- NOTES:
1. CONDUIT AND WIRE FOR LIGHTING AND RECEPTACLE CIRCUITS NOT SHOWN FOR CLARITY.
 2. LIGHTING CIRCUITS SHALL BE 3/4" CONDUIT WITH 2#12, 1#12G UNLESS OTHERWISE SHOWN.
 3. RECEPTACLE CIRCUITS SHALL BE 3/4" CONDUIT WITH 2#12, 1#12G UNLESS OTHERWISE SHOWN.
 4. RECEPTACLES MOUNTED AT 18" A.F.F UNLESS OTHERWISE NOTED.
 5. EXTERIOR EGRESS LIGHTS SHALL BE MOUNTED AT 9'-0" A.F.F. UNLESS OTHERWISE NOTED.
 6. EXTERIOR LIGHTS TO BE CONTROLLED FROM HOA SWITCH INSIDE PUMP STATION.
 7. CONNECT STROBE LIGHTS TO SECURITY/ALARM SYSTEM.

PLAN

0 3 6


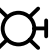


1/4"=1'-0"

USE OF DOCUMENTS THIS DOCUMENT, INCLUDING THE INCORPORATED DESIGNS, IS AN INSTRUMENT OF SERVICE FOR THIS PROJECT AND SHALL NOT BE USED FOR ANY OTHER PROJECT WITHOUT THE WRITTEN AUTHORIZATION OF KENNEDY/JENKS CONSULTANTS.					SCALES 0 1" 25mm IF THIS BAR IS NOT DIMENSION SHOWN, ADJUST SCALES ACCORDINGLY.		DESIGNED LGR		CITY OF ISSAQUAH ISSAQUAH, WASHINGTON SOUTH SPAR BOOSTER PUMP STATION	Kennedy/Jenks Consultants FEDERAL WAY, WASHINGTON	PUMP STATION LIGHTING AND VIDEO PLAN	FILE NAME 139700500-E005.DWG JOB NO. 1397005'00 DATE JUNE 2020 SHEET 78 OF 83 E5
	NO.	REVISION	DATE	BY			CHECKED LGR					

P:\CAD\131\1397005_00_City_of_Issaquah\139700500-E006.dwg 7/1/2020 1:07 PM MIKEMARX

CONDUIT AND WIRE SCHEDULE							
NUMBER	FROM	TO	SIZE (")	POWER	CONTROL	SIGNAL	COMMENTS
	AREA/GROUP						
P-PSE	PRIMARY CABLES	TRANSFORMER	BY PSE	BY PSE			FURNISHED BY PSE
P-SL	TRANSFORMER	POWER METERING ENCLOSURE	3X3"	3X 3-400 KCM, 1- #2N, 1-#2/0G			
P-SE	POWER METERING ENCLOSURE	MAIN (SUSE) CIRCUIT BREAKER	3X3"	3X 3-400 KCM, 1- #2N, 1-#2/0G			
P-MAIN	MAIN (SUSE) CIRCUIT BREAKER	AUTOMATIC TRANSFER SWITCH	3X3"	3X 3-400 KCM, 1- #2N, 1-#2/0G			
P-GEN	GENERATOR TERMINATION BOX	AUTOMATIC TRANSFER SWITCH	3X3"	3X 3-400 KCM, 1- #2N, 1-#2/0G			
G-GEC	GROUND NETWORK	MAIN (SUSE) CIRCUIT BREAKER	BARE	1-#2/0			
P-SB	AUTOMATIC TRANSFER SWITCH	SWITCHBOARD	3X2-1/2"	3X 3-400 KCM, 1- #2N, 1-#2/0G			
P-V1	SWITCHBOARD	VFD P-110	3"	3-350 KCM, 1- #2N, 1-#3G			
P-V2	SWITCHBOARD	VFD P-120	3"	3-350 KCM, 1- #2N, 1-#3G			
P-V3	SWITCHBOARD	VFD P-130	3"	3-350 KCM, 1- #2N, 1-#3G			
P-V4	SWITCHBOARD	UNIT HEATER	¾"	2-#12, 1-#12G			
P-MCC	SWITCHBOARD	MOTOR CONTROL CENTER	2X3"	2X 3-#350 KCM, 1-#1G			
P-P1	VFD P-110	PUMP P-110	3"	3-350 KCM, 1- #2N, 1-#3G	2-#14		
P-P2	VFD P-120	PUMP P-120	3"	3-350 KCM, 1- #2N, 1-#3G	2-#14		
P-P3	VFD P-130	PUMP P-130	3"	3-350 KCM, 1- #2N, 1-#3G	2-#14		
P-AC	MOTOR CONTROL CENTER	AIR COMPRESSOR	1"	3-#12, 1-#12N, 1-#12G			
P-CP	MOTOR CONTROL CENTER (PANEL)	CONTROL PANEL	¾"	2-#12, 1-#12G			
P-VCP	MOTOR CONTROL CENTER (PANEL)	VIDEO CONTROL PANEL	¾"	2-#12, 1-#12G			
P-MD	MOTOR CONTROL CENTER (PANEL)	MOTION DETECTOR, XS-114	¾"	2-#12, 1-#12G			
P-SD	MOTOR CONTROL CENTER (PANEL)	SMOKE DETECTOR, XS-113	¾"	2-#12, 1-#12G			
P-ST	MOTOR CONTROL CENTER (PANEL)	SURGE TANK CP	¾"	2-#12, 1-#12G			
P-CA	CONTROL PANEL	CHLORINE ANALYZER (FUTURE)	¾"	2-#12, 1-#12G			FUTURE
P-RSV	MOTOR CONTROL CENTER	HANDHOLE FOR (F) RESERVIOR	2-2"	TBD			FUTURE
CT-CP	MCC	CONTROL PANEL	2"			PER S&B	FROM VFDS TO PLC, PROVIDED BY INTGRATOR
C-IS1	CONTROL PANEL	ROOF INTRUSION SWITCH 1, ZSO-111	¾"		2-#14		
C-IS2	CONTROL PANEL	ROOF INTRUSION SWITCH 2, ZSO-121	¾"		2-#14		
C-IS3	CONTROL PANEL	ROOF INTRUSION SWITCH 3, ZSO-131	¾"		2-#14		
C-IS1	CONTROL PANEL	DOOR INTRUSION SWITCH 1, ZSO-141	¾"		2-#14		
C-IS2	CONTROL PANEL	DOOR INTRUSION SWITCH 2, ZSO-142	¾"		2-#14		
C-IS3	CONTROL PANEL	DOOR INTRUSION SWITCH 1, ZSO-143					
C-MD	CONTROL PANEL	MOTION DETECTOR, XS-114	¾"		2-#14		
C-SD	CONTROL PANEL	SMOKE DETECTOR, XS-113	¾"		2-#14		
C-104	CONTROL PANEL	PRESSURE SWITCH, PSL-104	¾"				FUTURE
C-LS1	CONTROL PANEL	CHECK VALVE LS PUMP 1, ZSC-110	¾"		2-#14		
C-LS2	CONTROL PANEL	CHECK VALVE LS PUMP 2, ZSC-120	¾"		2-#14		
C-LS3	CONTROL PANEL	CHECK VALVE LS PUMP 3, ZSC-130	¾"		2-#14		
C-PS	CONTROL PANEL	PS-104	¾"		2-#14		
C-116	CONTROL PANEL	ZSC-116	¾"				FUTURE
C-GEN	CONTROL PANEL	AUTOMATIC TRANSFER SWITCH	1"		8-#14		
C-ATS	GENERATOR RECEPTACLE	AUTOMATIC TRANSFER SWITCH	1"		8-#14		
S-102	CONTROL PANEL	MAGNETIC FLOWMETER, FIT-102	1"		2-#14	#16 TSP	24 VDC POWER
S-103	CONTROL PANEL	PRESSURE TRANSMITTER, PIT-103	¾"			#16 TSP	
S-108	CONTROL PANEL	PRESSURE TRANSMITTER, PIT-108	¾"			#16 TSP	
S-116	CONTROL PANEL	SPILLBACK VALVE POSITION ZT-116	¾"			#16 TSP	
S-117	CONTROL PANEL	MAGNETIC FLOWMETER, FIT-117	1"		2-#14	#16 TSP	24 VDC POWER
S-CA	CONTROL PANEL	CHLORINE ANALYZER (FUTURE)	¾"			3-#16 TSP	FUTURE
S-RSV	CONTROL PANEL	HANDHOLE FOR (F) RESERVIOR	2-2"	TBD			FUTURE
S-FO	CONTROL PANEL	PLANT SHOPS VIA HANDHOLES	2"			12-STRAND FIBER	COORDINATE WITH S&B; SEE CIVIL DRAWINGS
S-VFO	CONTROL PANEL	VIDEO PANEL	1"			FIBER	COORDINATE WITH S&B
S-VC1	CAMERA 1	VIDEO PANEL	¾"			CAT5	POE
S-VC2	CAMERA 2	VIDEO PANEL	¾"			CAT5	POE
S-VC3	CAMERA 3	VIDEO PANEL	¾"			CAT5	POE
S-VC4	CAMERA 4	VIDEO PANEL	¾"			CAT5	POE
S-VC5	CAMERA 5	VIDEO PANEL	¾"			CAT5	POE

PANEL L1									
240	/120 VOLTS, SINGLE PHASE, 3 WIRE	BUS: 100A		AIC: 10KA	MAIN: 100A/2P		MOUNTING: MCC		
CKT. NO.	DESCRIPTION	CONNECTED KVA		TRIP AMPS/ POLES	CKT. NO.	DESCRIPTION	CONNECTED KVA		TRIP AMPS/ POLES
		A	B				A	B	
1	VIDEO PANEL	0.4		20/1	2	CONTROL PANEL	1.0		20/1
3	DEHUMIDIFIER DH-1		0.5	20/1	4	EXHAUST FAN EF-1		0.5	20/1
5	LIGHTS	0.3		20/1	6	RECEPTACLES	1.1		20/1
7	CHLORINE ANALYZER (FUTURE)		0.0	20/1	8	RECEPTACLES		1.1	20/1
9	SURGE SYSTEM CONTROL PANEL	0.3		20/1	10	SPARE	0.0		20/1
11	SPARE		0.0	20/1	12	SPARE		0.0	20/1
13	SPACE	0.0		-	14	SPACE	0.0		-
15	SPACE		0.0	-	16	SPACE		0.0	-
17	SPACE	0.0		-	18	SPACE	0.0		-
19	SPACE		0.0	-	20	SPACE		0.0	-
21	SPACE	0.0		-	22	SPACE	0.0		-
23	SPACE		0.0	-	24	SPACE		0.0	-
PHASE SUBTOTALS (KVA):		1.0	0.5				2.1		1.6
PHASE TOTALS (KVA):							3.1		2.1
TOTAL KVA:									5.2 KVA
TOTAL AMPERES:									9 A

LIGHTING FIXTURE SCHEDULE						
TYPE	DESCRIPTION	LAMPS	WATTS/FIXTURE	MANUFACTURER	MOUNTING	SYMBOL
AFF A CKT	WET AREA SURFACE CEILING/SUSPENDED LED FIXTURE AND 12' CONNECTION CORD SET AND AIRCRAFT SUSPENSION CABLE SET.	LED	61	LITHONIA #FEM4 LED 4L 35 IAMCD CS89L 12 MHKK 120 OR EQUAL	SUSPENDED	
AFF B CKT	WALL PACK, LED WITH INTEGRAL PHOTOELECTRIC CELL AND TAMPER PROOF SCREWS.	LED	45	LITHONIA #TWP LED 20C 700 40K T3M 120 PE TP DBXD OR EQUAL	SURFACE WALL	
AFF EM CKT	EMERGENCY LIGHT, NICKLE-CADMIUM BATTERY OPERATED TWO 12V, 1.8W LED LAMPS, FUSED 120V INPUT W/ TEST SWITCH	(2) 1.8W LED	3.6	LITHONIA #EU2 LED M12 OR EQUAL	SURFACE WALL	
AFF EX CKT	LED EXIT LIGHT, SINGLE FACE, GREEN LETTERING WITH 90 MIN EMERGENCY NI-CAD BATTERY	LED	3	LITHONIA #ECBG LED M6 OR EQUAL	SURFACE WALL	

USE OF DOCUMENTS

THIS DOCUMENT, INCLUDING THE INCORPORATED DESIGNS, IS AN INSTRUMENT OF SERVICE FOR THIS PROJECT AND SHALL NOT BE USED FOR ANY OTHER PROJECT WITHOUT THE WRITTEN AUTHORIZATION OF KENNEDY/JENKS CONSULTANTS.

NO.	REVISION	DATE	BY

SCALES

1"

25mm

IF THIS BAR IS NOT DIMENSION SHOWN, ADJUST SCALES ACCORDINGLY.

LAWRENCE G. REISINGER

STATE OF WASHINGTON

22589

REGISTERED

PROFESSIONAL ENGINEER

DESIGNED


LGR

DRAWN

RFB

CHECKED

LGR



CITY OF ISSAQUAH

ISSAQUAH, WASHINGTON

SOUTH SPAR BOOSTER PUMP STATION

Kennedy/Jenks Consultants

FEDERAL WAY, WASHINGTON

CONDUIT AND WIRE SCHEDULE AND PANEL SCHEDULE

90% SUBMITTAL (REVISED 7/1/2020)

FILE NAME

139700500-E006.DWG

JOB NO.

1397005*00


DATE

JUNE 2020

SHEET

79 OF 83


E6

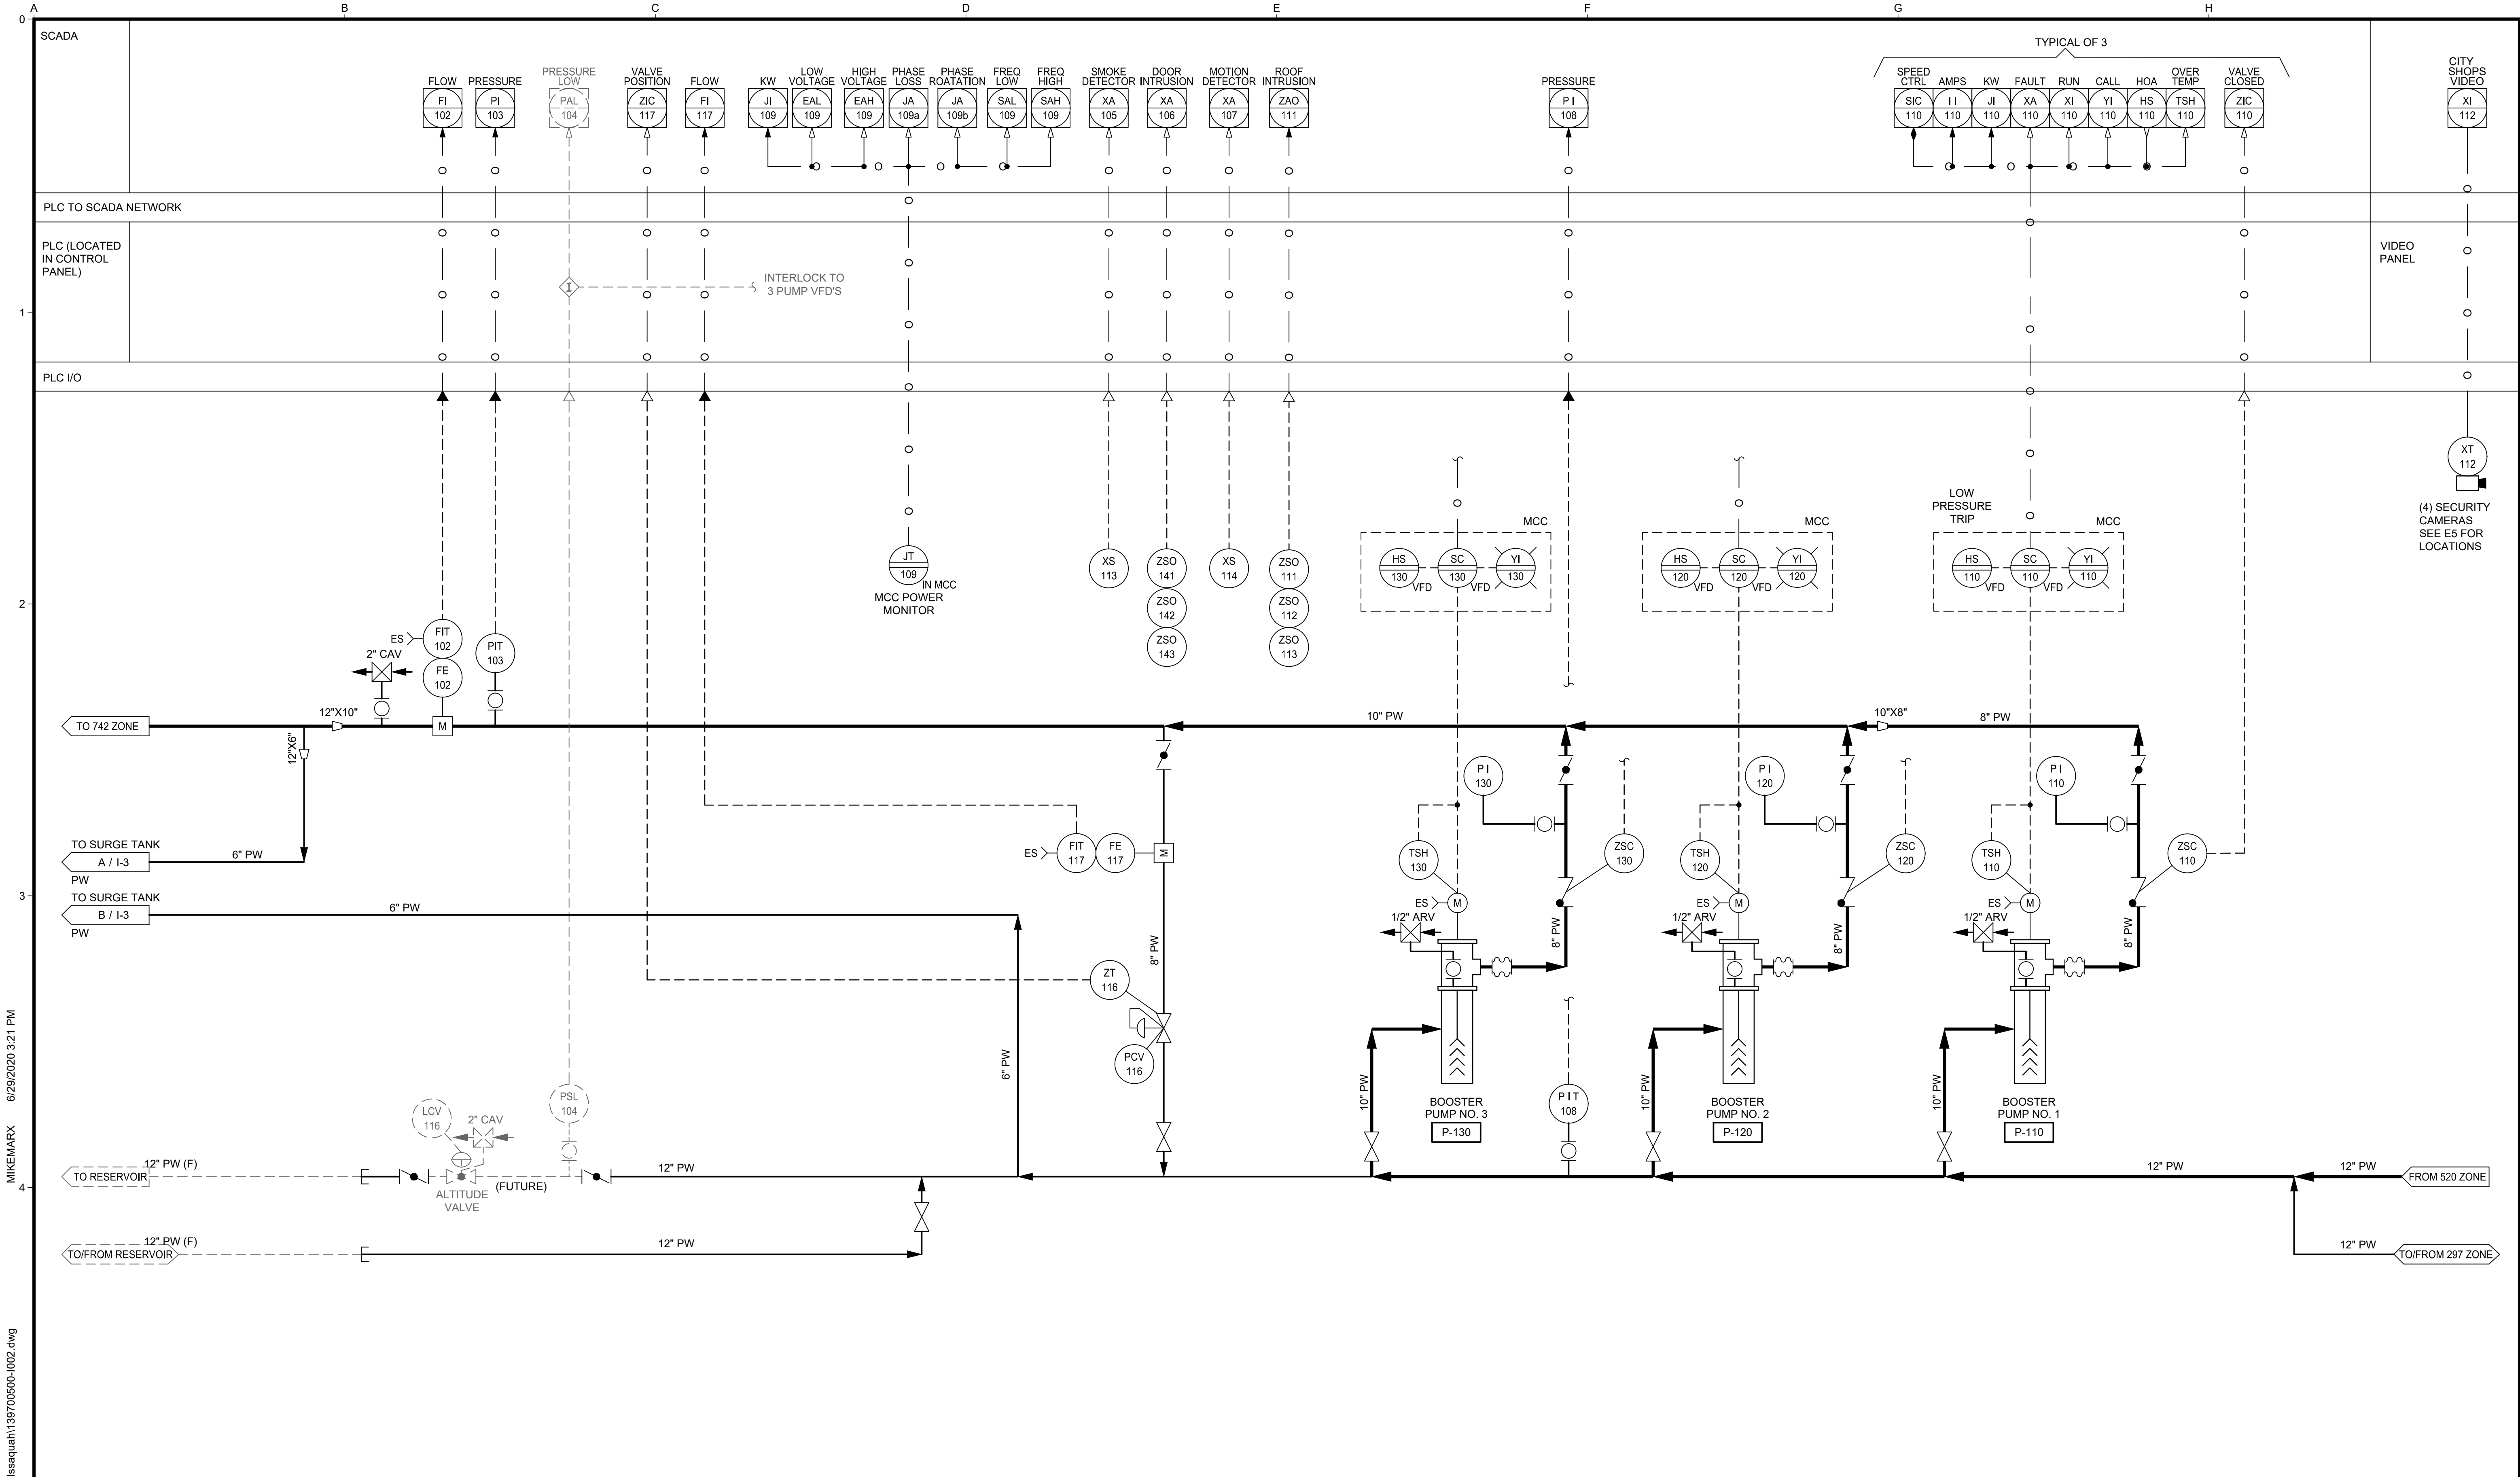

MIKEMARX 6/29/2020 3:21 PM

P:\CAD\131\1397005.00_City_of_Issaquah\139700500-1002.dwg

USE OF DOCUMENTS THIS DOCUMENT, INCLUDING THE INCORPORATED DESIGNS, IS AN INSTRUMENT OF SERVICE FOR THIS PROJECT AND SHALL NOT BE USED FOR ANY OTHER PROJECT WITHOUT THE WRITTEN AUTHORIZATION OF KENNEDY/JENKS CONSULTANTS.					SCALES 1" = 25mm IF THIS BAR IS NOT DIMENSION SHOWN, ADJUST SCALES ACCORDINGLY.		DESIGNED SGH		CITY OF ISSAQUAH ISSAQUAH, WASHINGTON SOUTH SPAR BOOSTER PUMP STATION	Kennedy/Jenks Consultants FEDERAL WAY, WASHINGTON	PROCESS AND INSTRUMENTATION DIAGRAM BOOSTER PUMP STATION	FILE NAME 139700500-1002.DWG
							DRAWN LMM					JOB NO. 1397005'00
							CHECKED JMF				DATE JUNE 2020	SHEET 82 OF 83
											90% SUBMITTAL (REVISED 7/1/2020)	12
NO.	REVISION	DATE	BY									

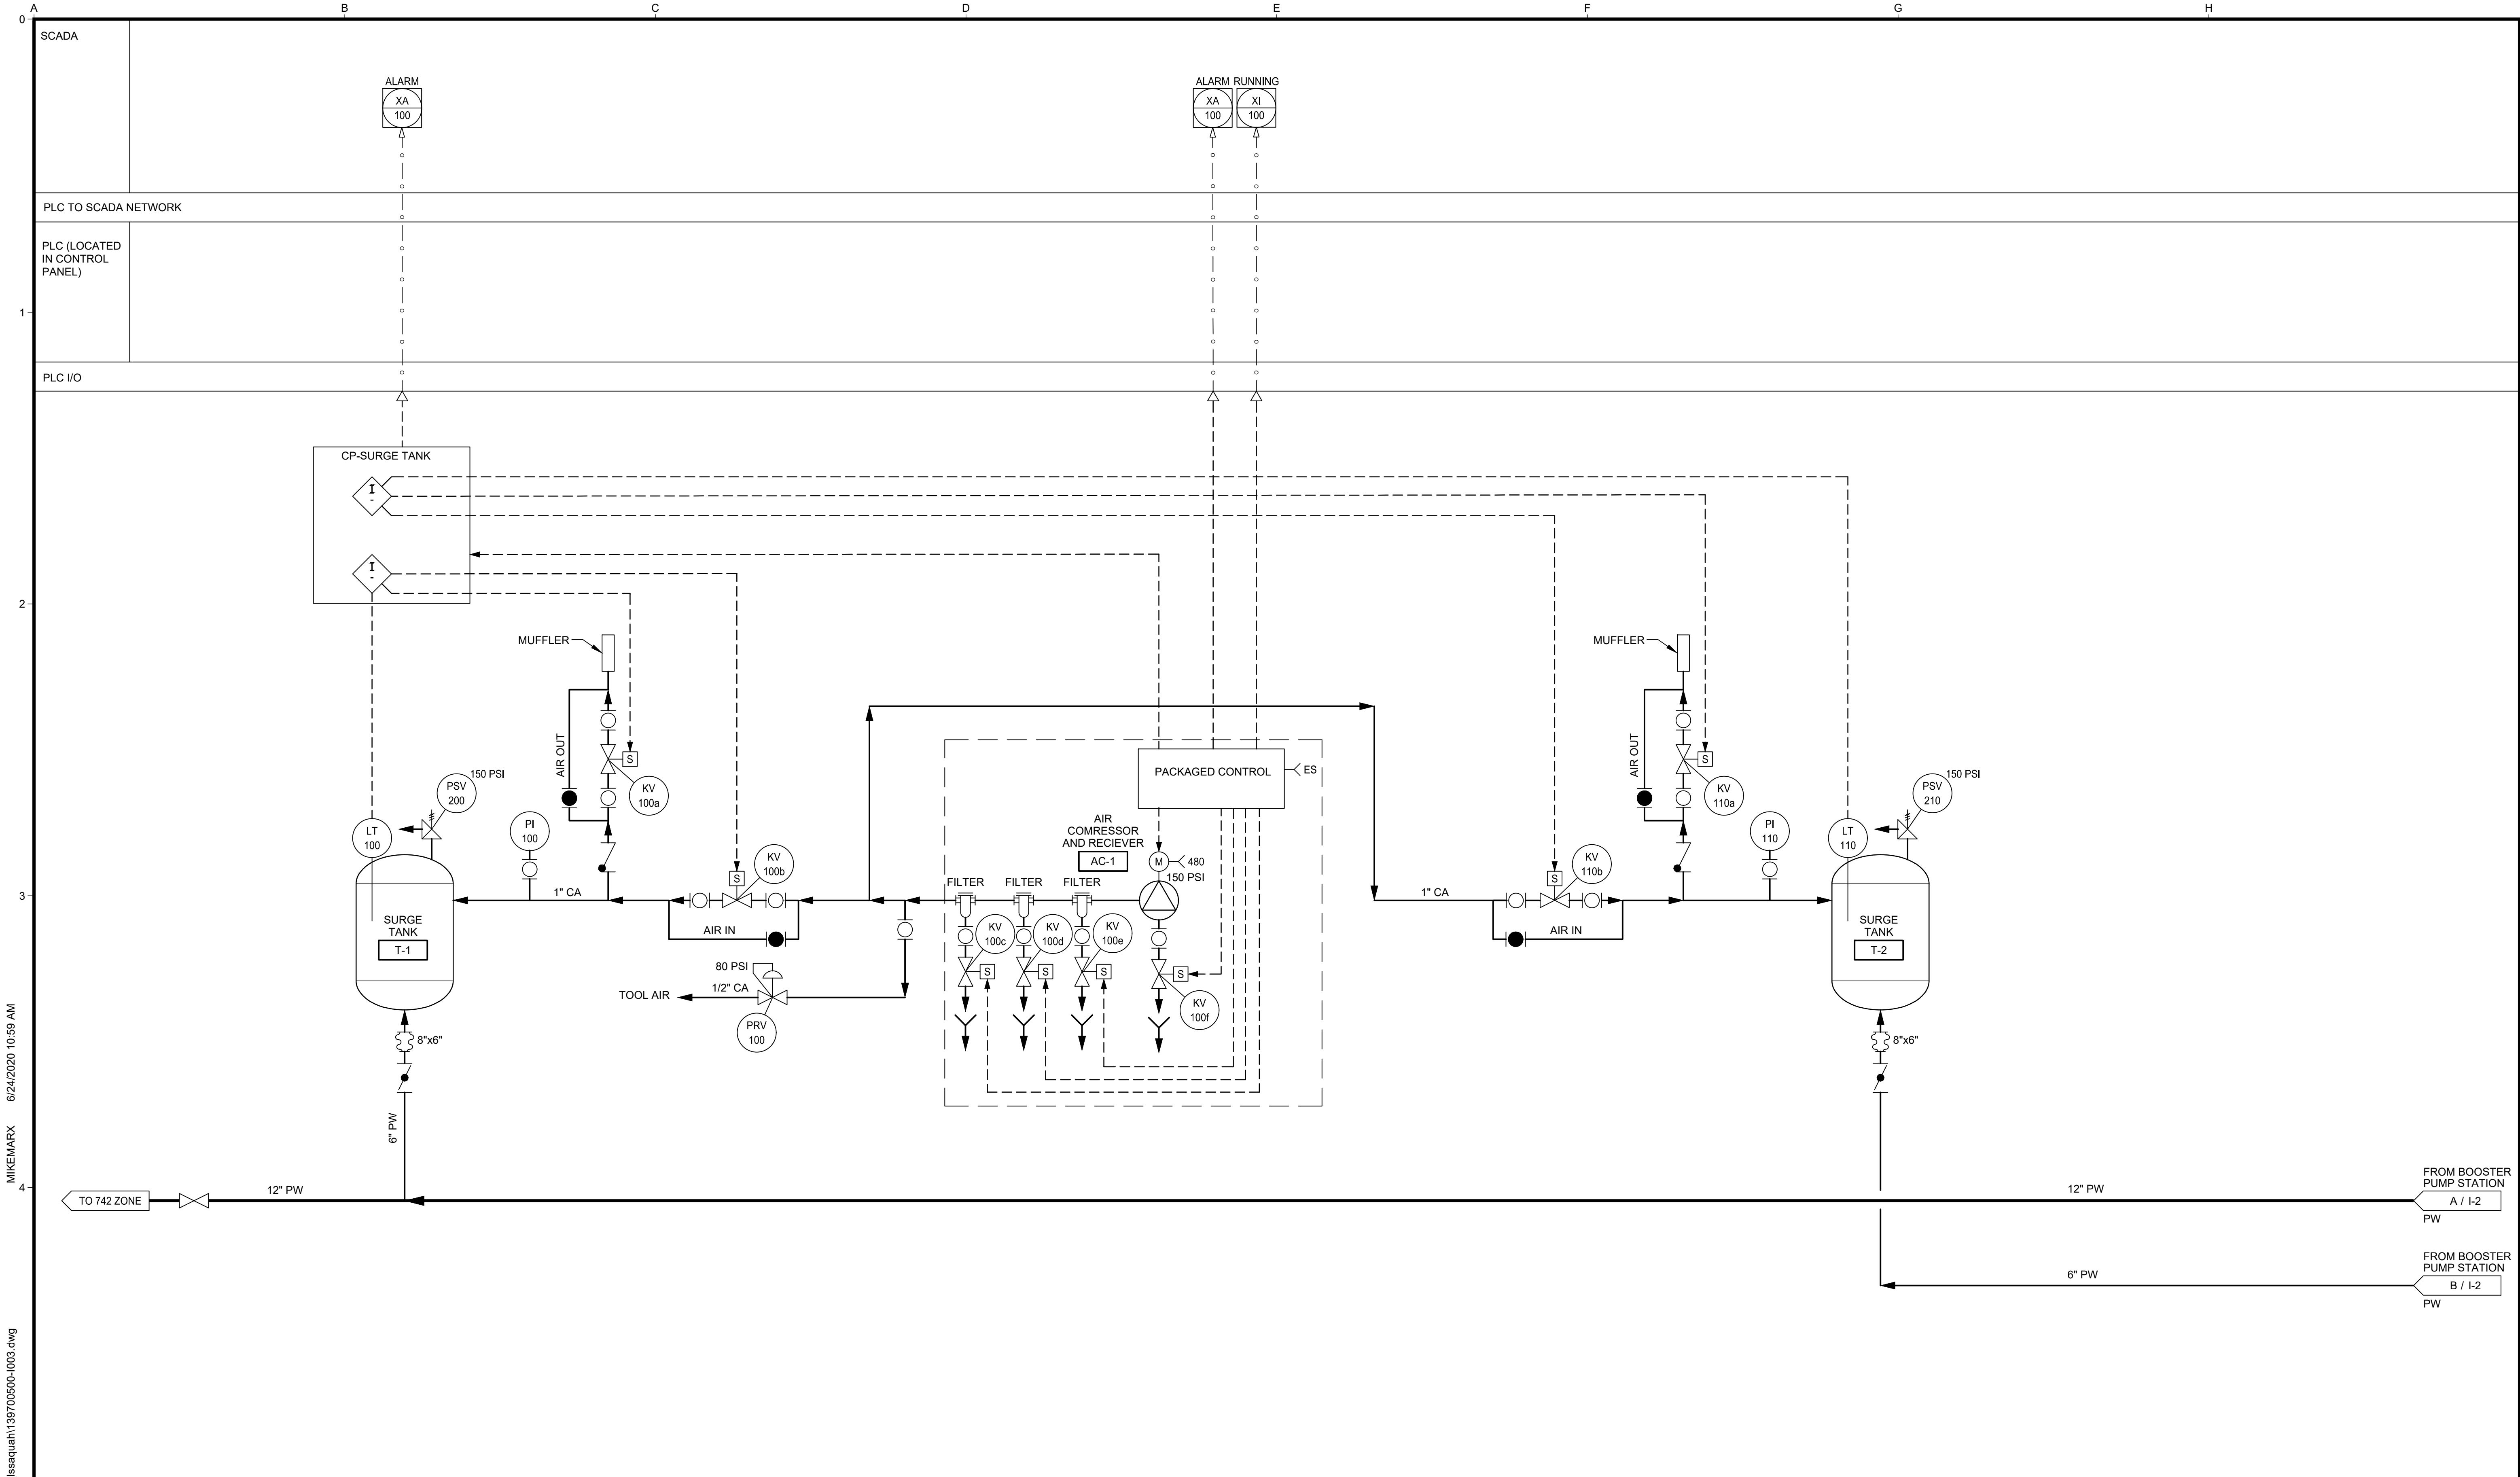

MIKEMARX 6/24/2020 10:59 AM

P:\CAD\131\1397005_00_City_of_Issaquah\139700500-1003.dwg

USE OF DOCUMENTS <small>THIS DOCUMENT, INCLUDING THE INCORPORATED DESIGNS, IS AN INSTRUMENT OF SERVICE FOR THIS PROJECT AND SHALL NOT BE USED FOR ANY OTHER PROJECT WITHOUT THE WRITTEN AUTHORIZATION OF KENNEDY/JENKS CONSULTANTS.</small>					SCALES 0 1" 0 25mm <small>IF THIS BAR IS NOT DIMENSION SHOWN, ADJUST SCALES ACCORDINGLY.</small>		DESIGNED SGH	 <div>CITY OF ISSAQUAH ISSAQUAH, WASHINGTON SOUTH SPAR BOOSTER PUMP STATION Kennedy/Jenks Consultants FEDERAL WAY, WASHINGTON</div>	PROCESS AND INSTRUMENTATION DIAGRAM AIR COMPRESSOR AND SURGE TANK 90% SUBMITTAL (REVISED 7/1/2020)	FILE NAME 139700500-1003.DWG
							DRAWN RFB			JOB NO. 1397005*00
							CHECKED JMF			DATE JUNE 2020
	NO.	REVISION	DATE	BY						SHEET 83 OF 83 13

Appendix D

Western Washington Hydrology Model Output

WWHM2012
PROJECT REPORT

General Model Information

Project Name: Issaquah SPAR_Nov30
Site Name:
Site Address:
City:
Report Date: 11/30/2020
Gage: Seatac
Data Start: 1948/10/01
Data End: 2009/09/30
Timestep: 15 Minute
Precip Scale: 1.333
Version Date: 2019/09/13
Version: 4.2.17

POC Thresholds

Low Flow Threshold for POC1:	50 Percent of the 2 Year
High Flow Threshold for POC1:	50 Year

Landuse Basin Data

Predeveloped Land Use

Existing

Bypass: No

GroundWater: No

Pervious Land Use acre
A B, Forest, Steep 0.085

Pervious Total 0.085

Impervious Land Use acre
ROADS MOD 0.118

Impervious Total 0.118

Basin Total 0.203

Element Flows To:
Surface Interflow Groundwater

Mitigated Land Use

Basin 1

Bypass: No

GroundWater: No

Pervious Land Use acre

Pervious Total 0

Impervious Land Use acre
ROADS MOD 0.2

Impervious Total 0.2

Basin Total 0.2

Element Flows To:		
Surface	Interflow	Groundwater


Routing Elements

Predeveloped Routing


Mitigated Routing

Analysis Results

POC 1

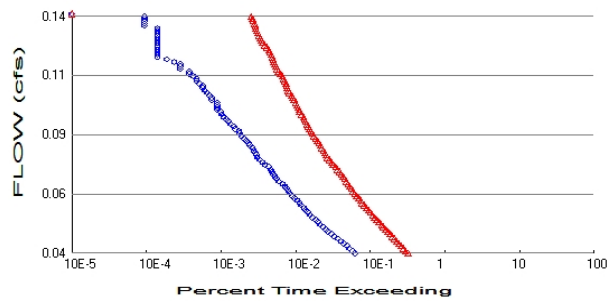

+ Predeveloped x Mitigated

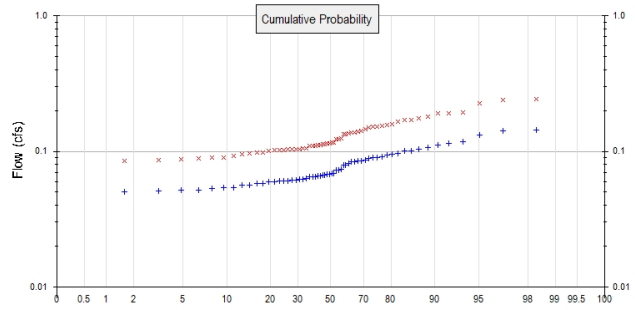

Predeveloped Landuse Totals for POC #1

Total Pervious Area: 0.085
Total Impervious Area: 0.118

Mitigated Landuse Totals for POC #1

Total Pervious Area: 0
Total Impervious Area: 0.2

Flow Frequency Method: Log Pearson Type III 17B

Flow Frequency Return Periods for Predeveloped. POC #1

Return Period	Flow(cfs)
2 year	0.072604
5 year	0.092335
10 year	0.105812
25 year	0.123366
50 year	0.13685
100 year	0.150701

Flow Frequency Return Periods for Mitigated. POC #1

Return Period	Flow(cfs)
2 year	0.122529
5 year	0.155565
10 year	0.178099
25 year	0.207421
50 year	0.229923
100 year	0.253022

Annual Peaks

Annual Peaks for Predeveloped and Mitigated. POC #1

Year	Predeveloped	Mitigated
1949	0.090	0.153
1950	0.093	0.158
1951	0.054	0.090
1952	0.048	0.082
1953	0.057	0.096
1954	0.060	0.102
1955	0.068	0.116
1956	0.067	0.114
1957	0.066	0.112
1958	0.058	0.098

1959	0.065	0.110
1960	0.062	0.105
1961	0.060	0.102
1962	0.051	0.086
1963	0.062	0.104
1964	0.062	0.105
1965	0.073	0.123
1966	0.052	0.087
1967	0.086	0.138
1968	0.112	0.190
1969	0.067	0.113
1970	0.065	0.110
1971	0.079	0.134
1972	0.083	0.135
1973	0.052	0.088
1974	0.073	0.124
1975	0.079	0.134
1976	0.060	0.102
1977	0.061	0.103
1978	0.090	0.152
1979	0.106	0.180
1980	0.114	0.194
1981	0.067	0.114
1982	0.097	0.165
1983	0.081	0.137
1984	0.053	0.090
1985	0.069	0.116
1986	0.058	0.098
1987	0.091	0.154
1988	0.066	0.112
1989	0.101	0.171
1990	0.119	0.191
1991	0.101	0.171
1992	0.054	0.092
1993	0.073	0.124
1994	0.059	0.101
1995	0.061	0.104
1996	0.085	0.140
1997	0.063	0.104
1998	0.068	0.115
1999	0.143	0.242
2000	0.065	0.110
2001	0.084	0.142
2002	0.086	0.145
2003	0.088	0.149
2004	0.141	0.239
2005	0.057	0.096
2006	0.051	0.084
2007	0.133	0.225
2008	0.096	0.157
2009	0.104	0.176

Ranked Annual Peaks

Ranked Annual Peaks for Predeveloped and Mitigated. POC #1

Rank	Predeveloped	Mitigated
1	0.1430	0.2423
2	0.1409	0.2388
3	0.1325	0.2246

4	0.1186	0.1935
5	0.1142	0.1906
6	0.1120	0.1898
7	0.1059	0.1796
8	0.1039	0.1760
9	0.1010	0.1709
10	0.1009	0.1706
11	0.0972	0.1647
12	0.0955	0.1584
13	0.0934	0.1573
14	0.0907	0.1537
15	0.0903	0.1526
16	0.0898	0.1523
17	0.0881	0.1493
18	0.0858	0.1454
19	0.0855	0.1417
20	0.0851	0.1397
21	0.0836	0.1384
22	0.0832	0.1374
23	0.0811	0.1352
24	0.0792	0.1343
25	0.0789	0.1338
26	0.0732	0.1241
27	0.0730	0.1238
28	0.0725	0.1228
29	0.0687	0.1164
30	0.0683	0.1158
31	0.0677	0.1147
32	0.0674	0.1143
33	0.0671	0.1136
34	0.0667	0.1131
35	0.0660	0.1118
36	0.0659	0.1117
37	0.0651	0.1103
38	0.0648	0.1099
39	0.0648	0.1098
40	0.0627	0.1053
41	0.0622	0.1050
42	0.0620	0.1044
43	0.0615	0.1041
44	0.0612	0.1038
45	0.0608	0.1031
46	0.0603	0.1022
47	0.0601	0.1019
48	0.0599	0.1015
49	0.0594	0.1007
50	0.0580	0.0982
51	0.0579	0.0981
52	0.0567	0.0959
53	0.0565	0.0958
54	0.0543	0.0921
55	0.0543	0.0902
56	0.0531	0.0900
57	0.0520	0.0881
58	0.0515	0.0873
59	0.0508	0.0860
60	0.0506	0.0845
61	0.0485	0.0821

Duration Flows

Flow(cfs)	Predev	Mit	Percentage	Pass/Fail
0.0363	1339	6840	510	Fail
0.0373	1233	6338	514	Fail
0.0383	1119	5908	527	Fail
0.0393	1036	5505	531	Fail
0.0404	947	5135	542	Fail
0.0414	865	4772	551	Fail
0.0424	782	4479	572	Fail
0.0434	702	4190	596	Fail
0.0444	639	3940	616	Fail
0.0454	575	3687	641	Fail
0.0465	539	3429	636	Fail
0.0475	498	3191	640	Fail
0.0485	456	3018	661	Fail
0.0495	425	2800	658	Fail
0.0505	393	2609	663	Fail
0.0515	355	2438	686	Fail
0.0526	332	2284	687	Fail
0.0536	312	2139	685	Fail
0.0546	293	2011	686	Fail
0.0556	276	1881	681	Fail
0.0566	253	1756	694	Fail
0.0576	240	1669	695	Fail
0.0586	224	1579	704	Fail
0.0597	204	1492	731	Fail
0.0607	192	1400	729	Fail
0.0617	178	1326	744	Fail
0.0627	170	1251	735	Fail
0.0637	160	1193	745	Fail
0.0647	154	1128	732	Fail
0.0658	143	1072	749	Fail
0.0668	127	1022	804	Fail
0.0678	118	965	817	Fail
0.0688	112	923	824	Fail
0.0698	107	868	811	Fail
0.0708	104	825	793	Fail
0.0718	99	772	779	Fail
0.0729	93	730	784	Fail
0.0739	82	679	828	Fail
0.0749	77	644	836	Fail
0.0759	71	604	850	Fail
0.0769	66	571	865	Fail
0.0779	64	545	851	Fail
0.0790	61	526	862	Fail
0.0800	58	501	863	Fail
0.0810	56	480	857	Fail
0.0820	52	457	878	Fail
0.0830	50	438	876	Fail
0.0840	46	416	904	Fail
0.0851	43	395	918	Fail
0.0861	40	376	939	Fail
0.0871	38	355	934	Fail
0.0881	37	344	929	Fail
0.0891	33	329	996	Fail
0.0901	32	313	978	Fail

0.0911	29	300	1034	Fail
0.0922	27	290	1074	Fail
0.0932	25	280	1120	Fail
0.0942	23	271	1178	Fail
0.0952	22	255	1159	Fail
0.0962	21	241	1147	Fail
0.0972	19	237	1247	Fail
0.0983	19	229	1205	Fail
0.0993	19	221	1163	Fail
0.1003	19	214	1126	Fail
0.1013	16	202	1262	Fail
0.1023	16	192	1200	Fail
0.1033	15	188	1253	Fail
0.1043	14	175	1250	Fail
0.1054	13	170	1307	Fail
0.1064	12	164	1366	Fail
0.1074	12	161	1341	Fail
0.1084	11	158	1436	Fail
0.1094	10	153	1530	Fail
0.1104	10	145	1450	Fail
0.1115	9	141	1566	Fail
0.1125	8	134	1675	Fail
0.1135	8	125	1562	Fail
0.1145	6	120	2000	Fail
0.1155	6	116	1933	Fail
0.1165	6	112	1866	Fail
0.1176	5	109	2180	Fail
0.1186	4	107	2675	Fail
0.1196	3	104	3466	Fail
0.1206	3	100	3333	Fail
0.1216	3	95	3166	Fail
0.1226	3	93	3100	Fail
0.1236	3	88	2933	Fail
0.1247	3	82	2733	Fail
0.1257	3	76	2533	Fail
0.1267	3	74	2466	Fail
0.1277	3	71	2366	Fail
0.1287	3	69	2300	Fail
0.1297	3	66	2200	Fail
0.1308	3	64	2133	Fail
0.1318	3	62	2066	Fail
0.1328	2	62	3100	Fail
0.1338	2	60	3000	Fail
0.1348	2	57	2850	Fail
0.1358	2	56	2800	Fail
0.1369	2	54	2700	Fail

The development has an increase in flow durations from 1/2 Predeveloped 2 year flow to the 2 year flow or more than a 10% increase from the 2 year to the 50 year flow.

The development has an increase in flow durations for more than 50% of the flows for the range of the duration analysis.

Water Quality

Water Quality BMP Flow and Volume for POC #1

On-line facility volume: 0 acre-feet

On-line facility target flow: 0 cfs.

Adjusted for 15 min: 0 cfs.

Off-line facility target flow: 0 cfs.

Adjusted for 15 min: 0 cfs.

LID Report

LID Technique	Used for Treatment ?	Total Volume Needs Treatment (ac-ft)	Volume Through Facility (ac-ft)	Infiltration Volume (ac-ft)	Cumulative Volume Infiltration Credit	Percent Volume Infiltrated	Water Quality	Percent Water Quality Treated	Comment
Total Volume Infiltrated		0.00	0.00	0.00		0.00	0.00	0%	No Treat. Credit
Compliance with LID Standard 8% of 2-yr to 50% of 2-yr									Duration Analysis Result = Failed

Model Default Modifications

Total of 0 changes have been made.

PERLND Changes

No PERLND changes have been made.

IMPLND Changes

No IMPLND changes have been made.


Appendix

Predeveloped Schematic



Existing
0.20ac

Mitigated Schematic

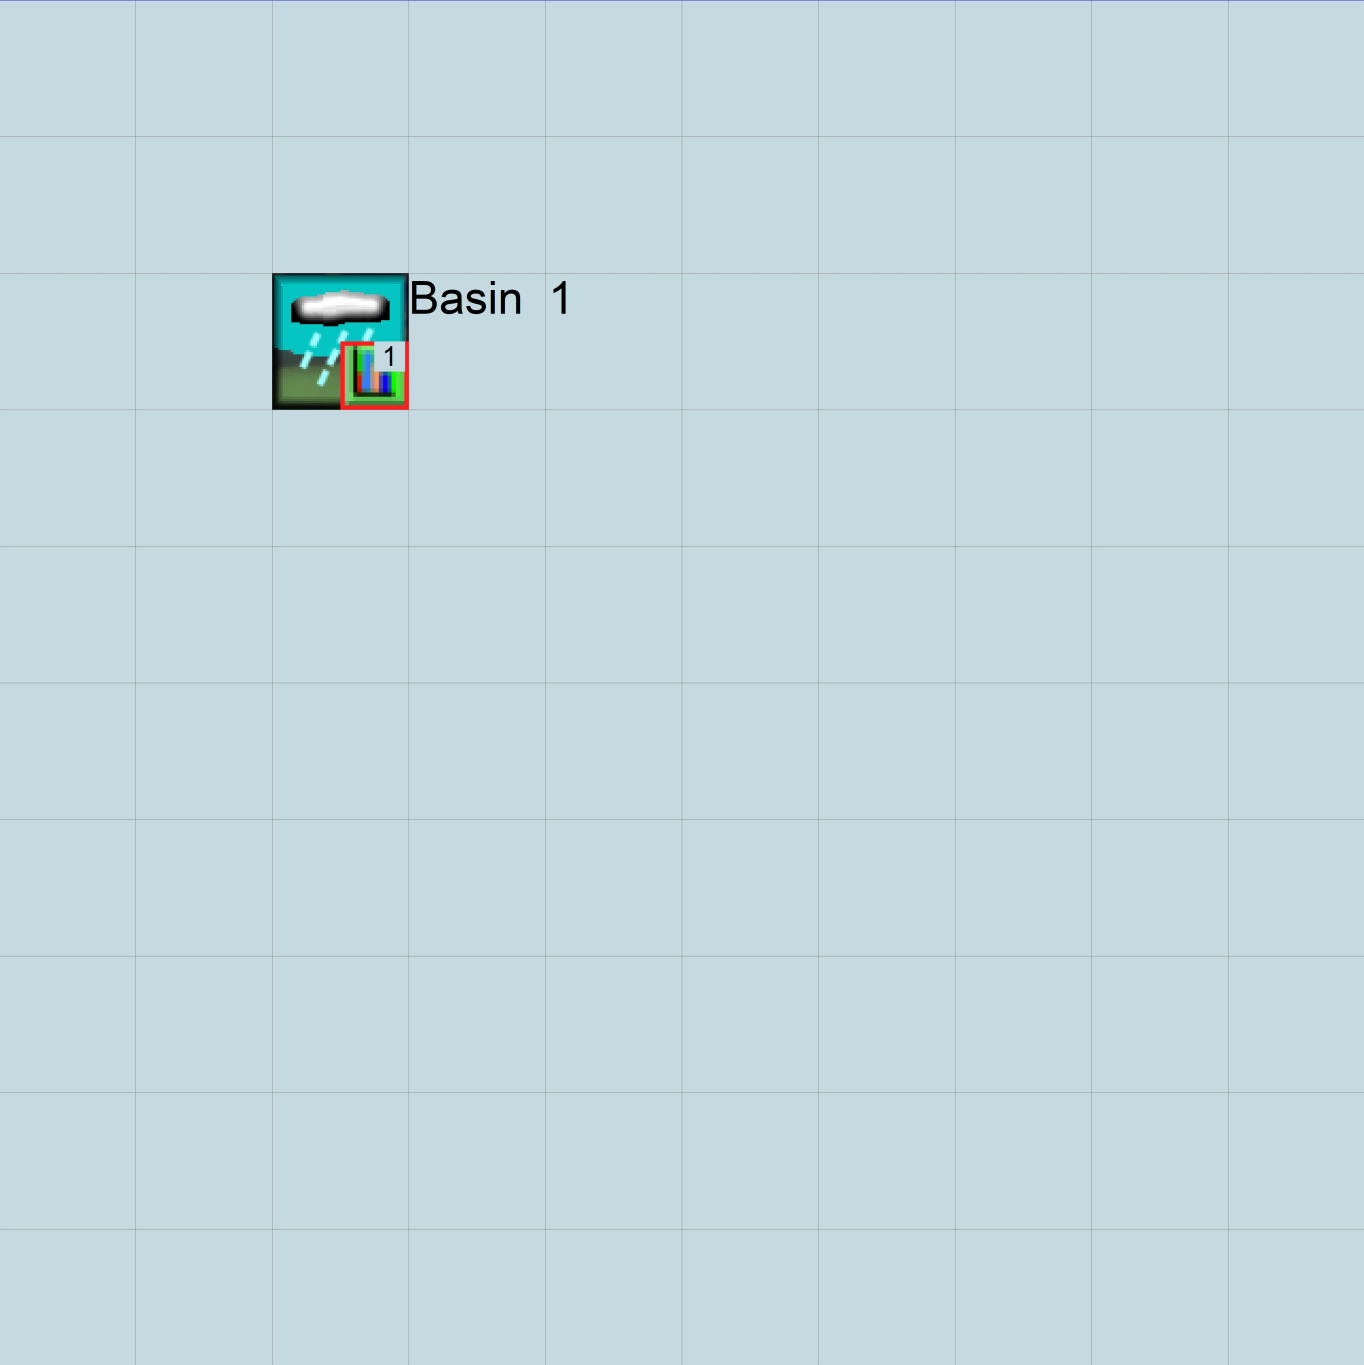

Predeveloped UCI File

RUN

GLOBAL

```
WWMH4 model simulation
START      1948 10 01      END      2009 09 30
RUN INTERP OUTPUT LEVEL    3      0
RESUME     0 RUN          1
UNIT SYSTEM 1
```

END GLOBAL

FILES

```
<File>  <Un#>  <-----File Name----->***
<-ID->                                     ***
WDM      26     Issaquah SPAR_Nov30.wdm
MESSU    25     PreIssaquah SPAR_Nov30.MES
          27     PreIssaquah SPAR_Nov30.L61
          28     PreIssaquah SPAR_Nov30.L62
          30     POCIssaquah SPAR_Nov301.dat
```

END FILES

OPN SEQUENCE

```
INGRP          INDELT 00:15
  PERLND        3
  IMPLND        2
  COPY          501
  DISPLY        1
```

END INGRP

END OPN SEQUENCE

DISPLY

DISPLY-INFO1

```
# - #<-----Title----->***TRAN PIVL DIG1 FIL1  PYR DIG2 FIL2 YRND
1      Existing to WSDOT          MAX          1    2    30    9
```

END DISPLY-INFO1

END DISPLY

COPY

TIMESERIES

```
# - #  NPT  NMN  ***
1      1    1
501    1    1
```

END TIMESERIES

END COPY

GENER

OPCODE

```
#      # OPCD ***
```

END OPCODE

PARM

```
#      #          K ***
```

END PARM

END GENER

PERLND

GEN-INFO

```
<PLS ><-----Name----->NBLKS    Unit-systems    Printer ***
# - #                      User    t-series    Engl Metr ***
                      in    out                      ***
```

```
3      A/B, Forest, Steep    1    1    1    1    27    0
```

END GEN-INFO

*** Section PWATER***

ACTIVITY

```
<PLS > ***** Active Sections *****
# - # ATMP SNOW PWAT  SED  PST  PWG  PQAL MSTL PEST NITR PHOS TRAC ***
3      0      0      1      0      0      0      0      0      0      0      0
```

END ACTIVITY

PRINT-INFO

```
<PLS > ***** Print-flags ***** PIVL  PYR
# - # ATMP SNOW PWAT  SED  PST  PWG  PQAL MSTL PEST NITR PHOS TRAC *****
3      0      0      4      0      0      0      0      0      0      0      0      1      9
```

END PRINT-INFO


```

PWAT-PARM1
<PLS > PWATER variable monthly parameter value flags ***
# - # CSNO RTOP UZFG VCS VUZ VNN VIFW VIRC VLE INFC HWT ***
3 0 0 0 0 0 0 0 0 0 0 0
END PWAT-PARM1

PWAT-PARM2
<PLS > PWATER input info: Part 2 ***
# - # ***FOREST LZSN INFILT LSUR SLSUR KVARV AGWRC
3 0 5 2 400 0.15 0.3 0.996
END PWAT-PARM2

PWAT-PARM3
<PLS > PWATER input info: Part 3 ***
# - # ***PETMAX PETMIN INFEXP INFILD DEEPFR BASETP AGWETP
3 0 0 2 2 0 0 0
END PWAT-PARM3

PWAT-PARM4
<PLS > PWATER input info: Part 4 ***
# - # CEPSC UZSN NSUR INTFW IRC LZETP ***
3 0.2 0.5 0.35 0 0.7 0.7
END PWAT-PARM4

PWAT-STATE1
<PLS > *** Initial conditions at start of simulation
ran from 1990 to end of 1992 (pat 1-11-95) RUN 21 ***
# - # *** CEPS SURS UZS IFWS LZS AGWS GWVS
3 0 0 0 0 3 1 0
END PWAT-STATE1

END PERLND

IMPLND
GEN-INFO
<PLS ><-----Name-----> Unit-systems Printer ***
# - # User t-series Engl Metr ***
in out ***
2 ROADS/MOD 1 1 1 27 0
END GEN-INFO
*** Section IWATER***

ACTIVITY
<PLS > ***** Active Sections *****
# - # ATMP SNOW IWAT SLD IWG IQAL ***
2 0 0 1 0 0 0
END ACTIVITY

PRINT-INFO
<ILS > ***** Print-flags ***** PIVL PYR
# - # ATMP SNOW IWAT SLD IWG IQAL *****
2 0 0 4 0 0 0 1 9
END PRINT-INFO

IWAT-PARM1
<PLS > IWATER variable monthly parameter value flags ***
# - # CSNO RTOP VRS VNN RTLI ***
2 0 0 0 0 0
END IWAT-PARM1

IWAT-PARM2
<PLS > IWATER input info: Part 2 ***
# - # *** LSUR SLSUR NSUR RETSC
2 400 0.05 0.1 0.08
END IWAT-PARM2

IWAT-PARM3
<PLS > IWATER input info: Part 3 ***
# - # ***PETMAX PETMIN
2 0 0

```

```

END IWAT-PARM3

IWAT-STATE1
  <PLS > *** Initial conditions at start of simulation
  # - # *** RETS      SURS
  2      0      0
END IWAT-STATE1

END IMPLND

SCHEMATIC
<-Source->          <--Area-->      <-Target->      MBLK      ***
<Name> #          <-factor->      <Name> #      Tbl#      ***
Existing to WSDOT***
PERLND  3          0.085      COPY  501      12
PERLND  3          0.085      COPY  501      13
IMPLND  2          0.118      COPY  501      15

*****Routing*****
END SCHEMATIC

NETWORK
<-Volume-> <-Grp> <-Member-><--Mult-->Tran <-Target vols> <-Grp> <-Member-> ***
<Name> #      <Name> # #<-factor->strg <Name> # #      <Name> # #      ***
COPY  501 OUTPUT MEAN  1 1  48.4      DISPLY  1      INPUT TIMSER 1

<-Volume-> <-Grp> <-Member-><--Mult-->Tran <-Target vols> <-Grp> <-Member-> ***
<Name> #      <Name> # #<-factor->strg <Name> # #      <Name> # #      ***
END NETWORK

RCHRES
GEN-INFO
  RCHRES      Name      Nexits      Unit Systems      Printer      ***
  # - #<-----><----> User T-series Engl Metr LKFG      ***
                                in out      ***
END GEN-INFO
*** Section RCHRES***

ACTIVITY
  <PLS > ***** Active Sections *****
  # - # HYFG ADFG CNFG HTFG SDFG GQFG OXFG NUFG PKFG PHFG ***
END ACTIVITY

PRINT-INFO
  <PLS > ***** Print-flags ***** PIVL  PYR
  # - # HYDR ADCA CONS HEAT SED  GQL OXRX NUTR PLNK PHCB PIVL  PYR *****
END PRINT-INFO

HYDR-PARM1
  RCHRES      Flags for each HYDR Section      ***
  # - # VC A1 A2 A3 ODFVFG for each *** ODGTFG for each FUNCT for each
          FG FG FG FG possible exit *** possible exit possible exit
          * * * * * * * * * * * * * * * * * * * * * * * * * * * * * * * * * *
END HYDR-PARM1

HYDR-PARM2
  # - # FTABNO      LEN      DELTH      STCOR      KS      DB50      ***
<-----><-----><-----><-----><-----><----->      ***
END HYDR-PARM2

HYDR-INIT
  RCHRES      Initial conditions for each HYDR section      ***
  # - # *** VOL      Initial value of COLIND      Initial value of OUTDGT
          *** ac-ft      for each possible exit      for each possible exit
<-----><----->      <----><----><----><----><----> *** <----><----><----><----><---->
END HYDR-INIT
END RCHRES

SPEC-ACTIONS

```


END SPEC-ACTIONS
 FTABLES
 END FTABLES

EXT SOURCES

<-Volume->	<Member>	SsysSgap<--Mult-->	Tran	<-Target	vols>	<-Grp>	<-Member->	***
<Name>	#	<Name>	#	tem strg<-factor->	strg	<Name>	#	#
WDM	2	PREC	ENGL	1.333		PERLND	1	999
WDM	2	PREC	ENGL	1.333		IMPLND	1	999
WDM	1	EVAP	ENGL	0.76		PERLND	1	999
WDM	1	EVAP	ENGL	0.76		IMPLND	1	999

END EXT SOURCES

EXT TARGETS

<-Volume->	<-Grp>	<-Member->	<--Mult-->	Tran	<-Volume->	<Member>	Tsys	Tgap	Amd	***
<Name>	#	<Name>	#	#<-factor->	strg	<Name>	#	<Name>	tem	strg
COPY	501	OUTPUT	MEAN	1	1	48.4	WDM	501	FLOW	ENGL

END EXT TARGETS

MASS-LINK

<Volume>	<-Grp>	<-Member->	<--Mult-->	<Target>	<-Grp>	<-Member->	***
<Name>		<Name>	#	#<-factor->	<Name>		<Name>
MASS-LINK		12					
PERLND	PWATER	SURO		0.083333	COPY	INPUT	MEAN
END MASS-LINK		12					
MASS-LINK		13					
PERLND	PWATER	IFWO		0.083333	COPY	INPUT	MEAN
END MASS-LINK		13					
MASS-LINK		15					
IMPLND	IWATER	SURO		0.083333	COPY	INPUT	MEAN
END MASS-LINK		15					

END MASS-LINK

END RUN

Mitigated UCI File

RUN

GLOBAL

```
WWMH4 model simulation
START      1948 10 01      END      2009 09 30
RUN INTERP OUTPUT LEVEL    3      0
RESUME     0 RUN      1      UNIT SYSTEM      1
END GLOBAL
```

FILES

```
<File>  <Un#>  <-----File Name----->***
<-ID->                                     ***
WDM      26      Issaquah SPAR_Nov30.wdm
MESSU    25      MitIssaquah SPAR_Nov30.MES
          27      MitIssaquah SPAR_Nov30.L61
          28      MitIssaquah SPAR_Nov30.L62
          30      POCIssaquah SPAR_Nov301.dat
```

END FILES

OPN SEQUENCE

INGRP INDELT 00:15

```
IMPLND      2
RCHRES      1
COPY        1
COPY      501
DISPLY      1
```

END INGRP

END OPN SEQUENCE

DISPLY

DISPLY-INFO1

```
# - #<-----Title----->***TRAN PIVL DIG1 FIL1 PYR DIG2 FIL2 YRND
1      Trapezoidal Pond 1      MAX      1      2      30      9
```

END DISPLY-INFO1

END DISPLY

COPY

TIMESERIES

```
# - # NPT NMN ***
1      1      1
501      1      1
```

END TIMESERIES

END COPY

GENER

OPCODE

```
#      # OPCODE ***
```

END OPCODE

PARM

```
#      #      K ***
```

END PARM

END GENER

PERLND

GEN-INFO

```
<PLS ><-----Name----->NBLKS      Unit-systems      Printer ***
# - #      User      t-series      Engl Metr      ***
      in out      ***
```

END GEN-INFO

*** Section PWATER***

ACTIVITY

```
<PLS > ***** Active Sections *****
# - # ATMP SNOW PWAT SED PST PWG PQAL MSTL PEST NITR PHOS TRAC ***
```

END ACTIVITY

PRINT-INFO

```
<PLS > ***** Print-flags ***** PIVL PYR
# - # ATMP SNOW PWAT SED PST PWG PQAL MSTL PEST NITR PHOS TRAC *****
```

END PRINT-INFO

PWAT-PARM1


```

    <PLS > PWATER variable monthly parameter value flags ***
    # - # CSNO RTOP UZFG VCS VUZ VNN VIFW VIRG VLE INFC HWT ***
END PWAT-PARM1

PWAT-PARM2
    <PLS > PWATER input info: Part 2 ***
    # - # ***FOREST LZSN INFILT LSUR SLSUR KVARY AGWRC
END PWAT-PARM2

PWAT-PARM3
    <PLS > PWATER input info: Part 3 ***
    # - # ***PETMAX PETMIN INFEXP INFILD DEEPFR BASETP AGWETP
END PWAT-PARM3
PWAT-PARM4
    <PLS > PWATER input info: Part 4 ***
    # - # CEPSC UZSN NSUR INTFW IRC LZETP ***
END PWAT-PARM4

PWAT-STATE1
    <PLS > *** Initial conditions at start of simulation
    ran from 1990 to end of 1992 (pat 1-11-95) RUN 21 ***
    # - # *** CEPS SURS UZS IFWS LZS AGWS GWVS
END PWAT-STATE1

END PERLND

IMPLND
GEN-INFO
    <PLS ><-----Name-----> Unit-systems Printer ***
    # - # User t-series Engl Metr ***
    in out ***
    2 ROADS/MOD 1 1 1 27 0
END GEN-INFO
*** Section IWATER***

ACTIVITY
    <PLS > ***** Active Sections *****
    # - # ATMP SNOW IWAT SLD IWG IQAL ***
    2 0 0 1 0 0 0
END ACTIVITY

PRINT-INFO
    <ILS > ***** Print-flags ***** PIVL PYR
    # - # ATMP SNOW IWAT SLD IWG IQAL *****
    2 0 0 4 0 0 0 1 9
END PRINT-INFO

IWAT-PARM1
    <PLS > IWATER variable monthly parameter value flags ***
    # - # CSNO RTOP VRS VNN RTLI ***
    2 0 0 0 0 0
END IWAT-PARM1

IWAT-PARM2
    <PLS > IWATER input info: Part 2 ***
    # - # *** LSUR SLSUR NSUR RETSC
    2 400 0.05 0.1 0.08
END IWAT-PARM2

IWAT-PARM3
    <PLS > IWATER input info: Part 3 ***
    # - # ***PETMAX PETMIN
    2 0 0
END IWAT-PARM3

IWAT-STATE1
    <PLS > *** Initial conditions at start of simulation
    # - # *** RETS SURS
    2 0 0
END IWAT-STATE1

```

END IMPLND

SCHEMATIC

<-Source->	<--Area-->	<-Target->	MBLK	***
<Name> #	<-factor->	<Name> #	Tbl#	***
Basin 1***				
IMPLND 2	0.191	RCHRES 1	5	

*****Routing*****

IMPLND 2	0.191	COPY 1	15
RCHRES 1	1	COPY 501	16

END SCHEMATIC

NETWORK

<-Volume->	<-Grp>	<-Member->	<--Mult-->	Tran	<-Target vols>	<-Grp>	<-Member->	***
<Name> #		<Name> #	#	<-factor->strg	<Name> #		<Name> #	***
COPY 501	OUTPUT	MEAN 1	1	48.4	DISPLY 1	INPUT	TIMSER 1	

<-Volume->	<-Grp>	<-Member->	<--Mult-->	Tran	<-Target vols>	<-Grp>	<-Member->	***
<Name> #		<Name> #	#	<-factor->strg	<Name> #		<Name> #	***

END NETWORK

RCHRES

GEN-INFO

RCHRES	Name	Nexits	Unit	Systems	Printer	***
# - #	<----->	<---->	User	T-series	Engl Metr LKFG	***
				in out		***
1	Trapezoidal Pond-005	1	1	1 1	28 0 1	

END GEN-INFO

*** Section RCHRES***

ACTIVITY

<PLS >	*****	Active Sections	*****								
# - #	HYFG	ADFG	CNFG	HTFG	SDFG	GQFG	OXFG	NUFG	PKFG	PHFG	***
1	1	0	0	0	0	0	0	0	0	0	

END ACTIVITY

PRINT-INFO

<PLS >	*****	Print-flags	*****	PIVL	PYR	*****							
# - #	HYDR	ADCA	CONS	HEAT	SED	GQL	OXRX	NUTR	PLNK	PHCB	PIVL	PYR	*****
1	4	0	0	0	0	0	0	0	0	0	1	9	

END PRINT-INFO

HYDR-PARM1

RCHRES	Flags for each HYDR Section	***	ODGTFG for each	FUNCT for each	***
# - #	VC A1 A2 A3 ODFVFG for each	***	possible exit	possible exit	possible exit
	FG FG FG FG				
	* * * *		* * * *	* * * *	* * * *
1	0 1 0 0		4 0 0 0 0	0 0 0 0 0	2 2 2 2 2

END HYDR-PARM1

HYDR-PARM2

# - #	FTABNO	LEN	DELTH	STCOR	KS	DB50	***
<----->	<----->	<----->	<----->	<----->	<----->	<----->	***
1	1	0.01	0.0	0.0	0.5	0.0	

END HYDR-PARM2

HYDR-INIT

RCHRES	Initial conditions for each HYDR section	***
# - #	*** VOL Initial value of COLIND Initial value of OUTDGT	
	*** ac-ft for each possible exit for each possible exit	
<----->	<----->	*** <----->
1	0 4.0 0.0 0.0 0.0 0.0	0.0 0.0 0.0 0.0 0.0

END HYDR-INIT

END RCHRES

SPEC-ACTIONS

END SPEC-ACTIONS

FTABLES

FTABLE

1

91

4

Depth (ft)	Area (acres)	Volume (acre-ft)	Outflow1 (cfs)	Velocity (ft/sec)	Travel Time*** (Minutes)***
0.000000	0.101427	0.000000	0.000000		
0.033333	0.102038	0.003391	0.004885		
0.066667	0.102652	0.006803	0.006909		
0.100000	0.103267	0.010235	0.008462		
0.133333	0.103883	0.013687	0.009771		
0.166667	0.104502	0.017160	0.010924		
0.200000	0.105122	0.020654	0.011967		
0.233333	0.105745	0.024168	0.012925		
0.266667	0.106369	0.027704	0.013818		
0.300000	0.106995	0.031260	0.014656		
0.333333	0.107623	0.034837	0.015449		
0.366667	0.108252	0.038435	0.016203		
0.400000	0.108884	0.042053	0.016923		
0.433333	0.109517	0.045693	0.017614		
0.466667	0.110152	0.049355	0.018279		
0.500000	0.110789	0.053037	0.018921		
0.533333	0.111428	0.056741	0.019541		
0.566667	0.112069	0.060466	0.020143		
0.600000	0.112711	0.064212	0.020727		
0.633333	0.113356	0.067980	0.021295		
0.666667	0.114002	0.071769	0.021848		
0.700000	0.114650	0.075580	0.022388		
0.733333	0.115300	0.079412	0.022914		
0.766667	0.115951	0.083267	0.023429		
0.800000	0.116605	0.087142	0.023933		
0.833333	0.117260	0.091040	0.024427		
0.866667	0.117918	0.094960	0.024911		
0.900000	0.118577	0.098901	0.025385		
0.933333	0.119237	0.102865	0.025851		
0.966667	0.119900	0.106851	0.026308		
1.000000	0.120565	0.110858	0.026758		
1.033333	0.121231	0.114888	0.027201		
1.066667	0.121899	0.118940	0.027636		
1.100000	0.122569	0.123015	0.028064		
1.133333	0.123241	0.127112	0.030077		
1.166667	0.123915	0.131231	0.033370		
1.200000	0.124591	0.135373	0.037465		
1.233333	0.125268	0.139537	0.042183		
1.266667	0.125947	0.143724	0.047418		
1.300000	0.126628	0.147934	0.053098		
1.333333	0.127311	0.152166	0.059165		
1.366667	0.127996	0.156421	0.065576		
1.400000	0.128683	0.160699	0.072294		
1.433333	0.129371	0.165000	0.079288		
1.466667	0.130061	0.169324	0.086531		
1.500000	0.130753	0.173671	0.094000		
1.533333	0.131447	0.178041	0.352804		
1.566667	0.132143	0.182434	0.825403		
1.600000	0.132841	0.186850	1.436952		
1.633333	0.133540	0.191290	2.160705		
1.666667	0.134241	0.195753	2.981120		
1.700000	0.134944	0.200239	3.887575		
1.733333	0.135649	0.204749	4.872094		
1.766667	0.136356	0.209283	5.928284		
1.800000	0.137065	0.213840	7.050758		
1.833333	0.137775	0.218420	8.234797		
1.866667	0.138488	0.223025	9.476125		
1.900000	0.139202	0.227653	10.77077		
1.933333	0.139918	0.232305	12.11495		
1.966667	0.140636	0.236981	13.50502		
2.000000	0.141355	0.241681	14.93741		
2.033333	0.142077	0.246405	16.40858		
2.066667	0.142800	0.251153	17.91501		
2.100000	0.143525	0.255925	19.45316		
2.133333	0.144252	0.260721	21.01950		

2.166667	0.144981	0.265541	22.61043
2.200000	0.145712	0.270386	24.22235
2.233333	0.146444	0.275256	25.85162
2.266667	0.147178	0.280149	27.49455
2.300000	0.147915	0.285068	29.14745
2.333333	0.148653	0.290010	30.80659
2.366667	0.149392	0.294978	32.46823
2.400000	0.150134	0.299970	34.12864
2.433333	0.150878	0.304987	35.78410
2.466667	0.151623	0.310028	37.43087
2.500000	0.152370	0.315095	39.06530
2.533333	0.153119	0.320186	40.68375
2.566667	0.153870	0.325303	42.28265
2.600000	0.154623	0.330444	43.85853
2.633333	0.155377	0.335611	45.40799
2.666667	0.156134	0.340803	46.92776
2.700000	0.156892	0.346020	48.41470
2.733333	0.157652	0.351262	49.86583
2.766667	0.158414	0.356530	51.27834
2.800000	0.159178	0.361823	52.64961
2.833333	0.159943	0.367142	53.97724
2.866667	0.160711	0.372486	55.25908
2.900000	0.161480	0.377856	56.49323
2.933333	0.162251	0.383252	57.67808
2.966667	0.163024	0.388673	58.81232
3.000000	0.163798	0.394120	59.89499

END FTABLE 1
END FTABLES

EXT SOURCES

<-Volume->	<Member>	SsysSgap<--Mult-->	Tran	<-Target	vols>	<-Grp>	<-Member->	***
<Name>	#	<Name>	#	tem strg<-factor-->	strg	<Name>	#	#
WDM	2	PREC	ENGL	1.333	PERLND	1 999	EXTNL	PREC
WDM	2	PREC	ENGL	1.333	IMPLND	1 999	EXTNL	PREC
WDM	1	EVAP	ENGL	0.76	PERLND	1 999	EXTNL	PETINP
WDM	1	EVAP	ENGL	0.76	IMPLND	1 999	EXTNL	PETINP
WDM	2	PREC	ENGL	1.333	RCHRES	1	EXTNL	PREC
WDM	1	EVAP	ENGL	0.76	RCHRES	1	EXTNL	POTEV

END EXT SOURCES

EXT TARGETS

<-Volume->	<-Grp>	<-Member->	<--Mult-->	Tran	<-Volume->	<Member>	Tsys	Tgap	Amd	***
<Name>	#	<Name>	#	#<-factor-->	strg	<Name>	#	<Name>	tem strg	strg***
RCHRES	1	HYDR	RO	1 1	1	WDM	1000	FLOW	ENGL	REPL
RCHRES	1	HYDR	STAGE	1 1	1	WDM	1001	STAG	ENGL	REPL
COPY	1	OUTPUT	MEAN	1 1	48.4	WDM	701	FLOW	ENGL	REPL
COPY	501	OUTPUT	MEAN	1 1	48.4	WDM	801	FLOW	ENGL	REPL

END EXT TARGETS

MASS-LINK

<Volume>	<-Grp>	<-Member->	<--Mult-->	<Target>	<-Grp>	<-Member->	***
<Name>	#	<Name>	#	<-factor-->	<Name>	#	#
MASS-LINK	5						
IMPLND	IWATER	SURO	0.083333	RCHRES	INFLOW	IVOL	
END MASS-LINK	5						
MASS-LINK	15						
IMPLND	IWATER	SURO	0.083333	COPY	INPUT	MEAN	
END MASS-LINK	15						
MASS-LINK	16						
RCHRES	ROFLOW			COPY	INPUT	MEAN	
END MASS-LINK	16						

END MASS-LINK

END RUN

Disclaimer

Legal Notice

This program and accompanying documentation are provided 'as-is' without warranty of any kind. The entire risk regarding the performance and results of this program is assumed by End User. Clear Creek Solutions Inc. and the governmental licensee or sublicensees disclaim all warranties, either expressed or implied, including but not limited to implied warranties of program and accompanying documentation. In no event shall Clear Creek Solutions Inc. be liable for any damages whatsoever (including without limitation to damages for loss of business profits, loss of business information, business interruption, and the like) arising out of the use of, or inability to use this program even if Clear Creek Solutions Inc. or their authorized representatives have been advised of the possibility of such damages. Software Copyright © by : Clear Creek Solutions, Inc. 2005-2020; All Rights Reserved.

Clear Creek Solutions, Inc.
6200 Capitol Blvd. Ste F
Olympia, WA. 98501
Toll Free 1(866)943-0304
Local (360)943-0304

www.clearcreeksolutions.com

Appendix E

Drainage Plan

